


RESEARCH-LANDS
 Exchange with
 Parkline 6/1/68

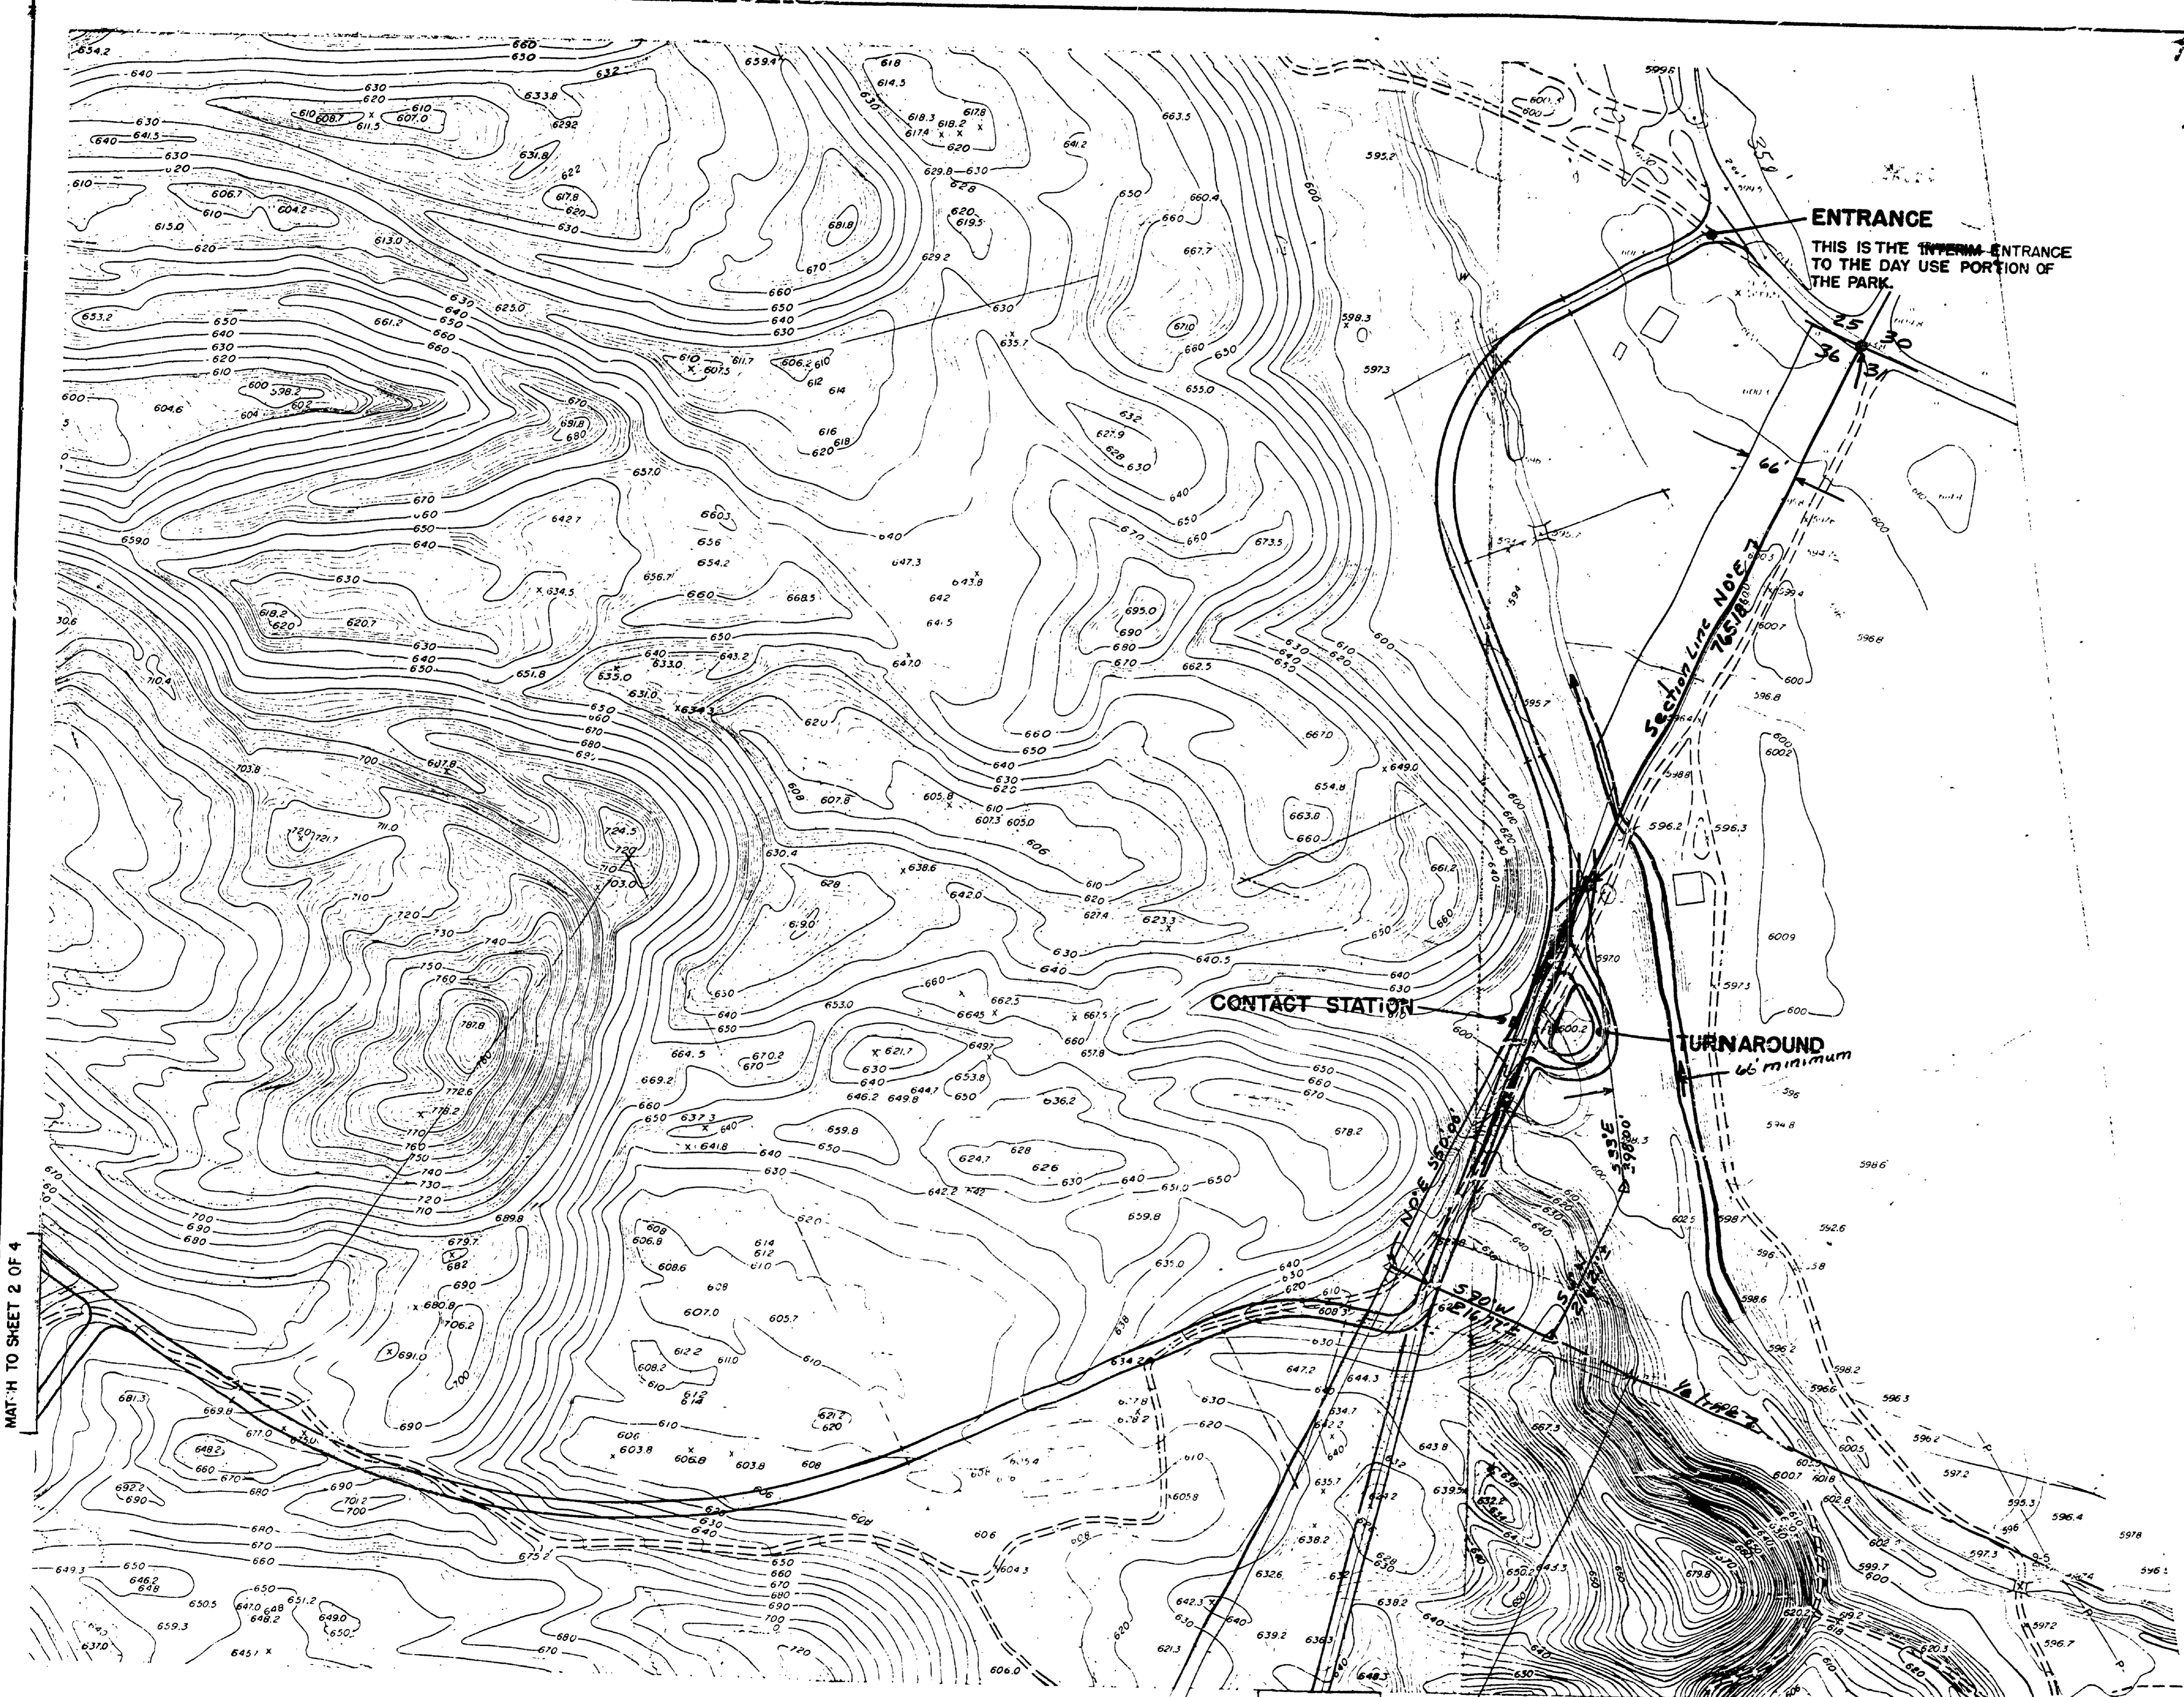

ENTRANCE
 THIS IS THE INTERIM ENTRANCE
 TO THE DAY USE PORTION OF
 THE PARK.


CONTACT STATION

TURNAROUND
 66 minimum

Section Line No. 27
 765

APPROVED: _____
 CHIEF, PARKS DIVISION DATE

REVIEWED: *James R. McLean*
 IN CHARGE, PARK DESIGN DATE

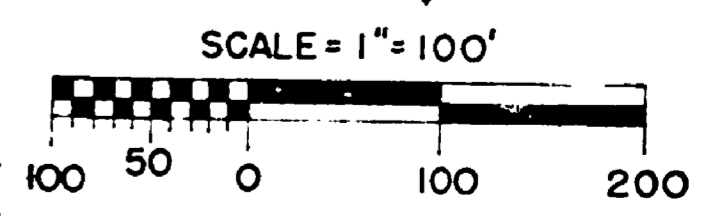

MATCH TO SHEET 2 OF 4

MATCH TO SHEET 2 OF 4

SURVEYED BY	DRAWN BY GEM	5 48	NO.	DATE	BY	REVISIONS
DESIGNED BY GEM	CHECKED BY EMC	5 48	1.	11 68	GEM	REALIGN ROADS - SHEETS 1,2,3,4
DATE		5 48	2.			

MICHIGAN
 DEPARTMENT OF CONSERVATION

P.J. HOFFMASTER S.P.

SHEET NO. _____ OF _____
 FOR PROJECT NO. _____

ENTRANCE ROAD ALIGNMENT
 SHEET 3 OF 4 PLAN NO. 1051

1051 R.T.