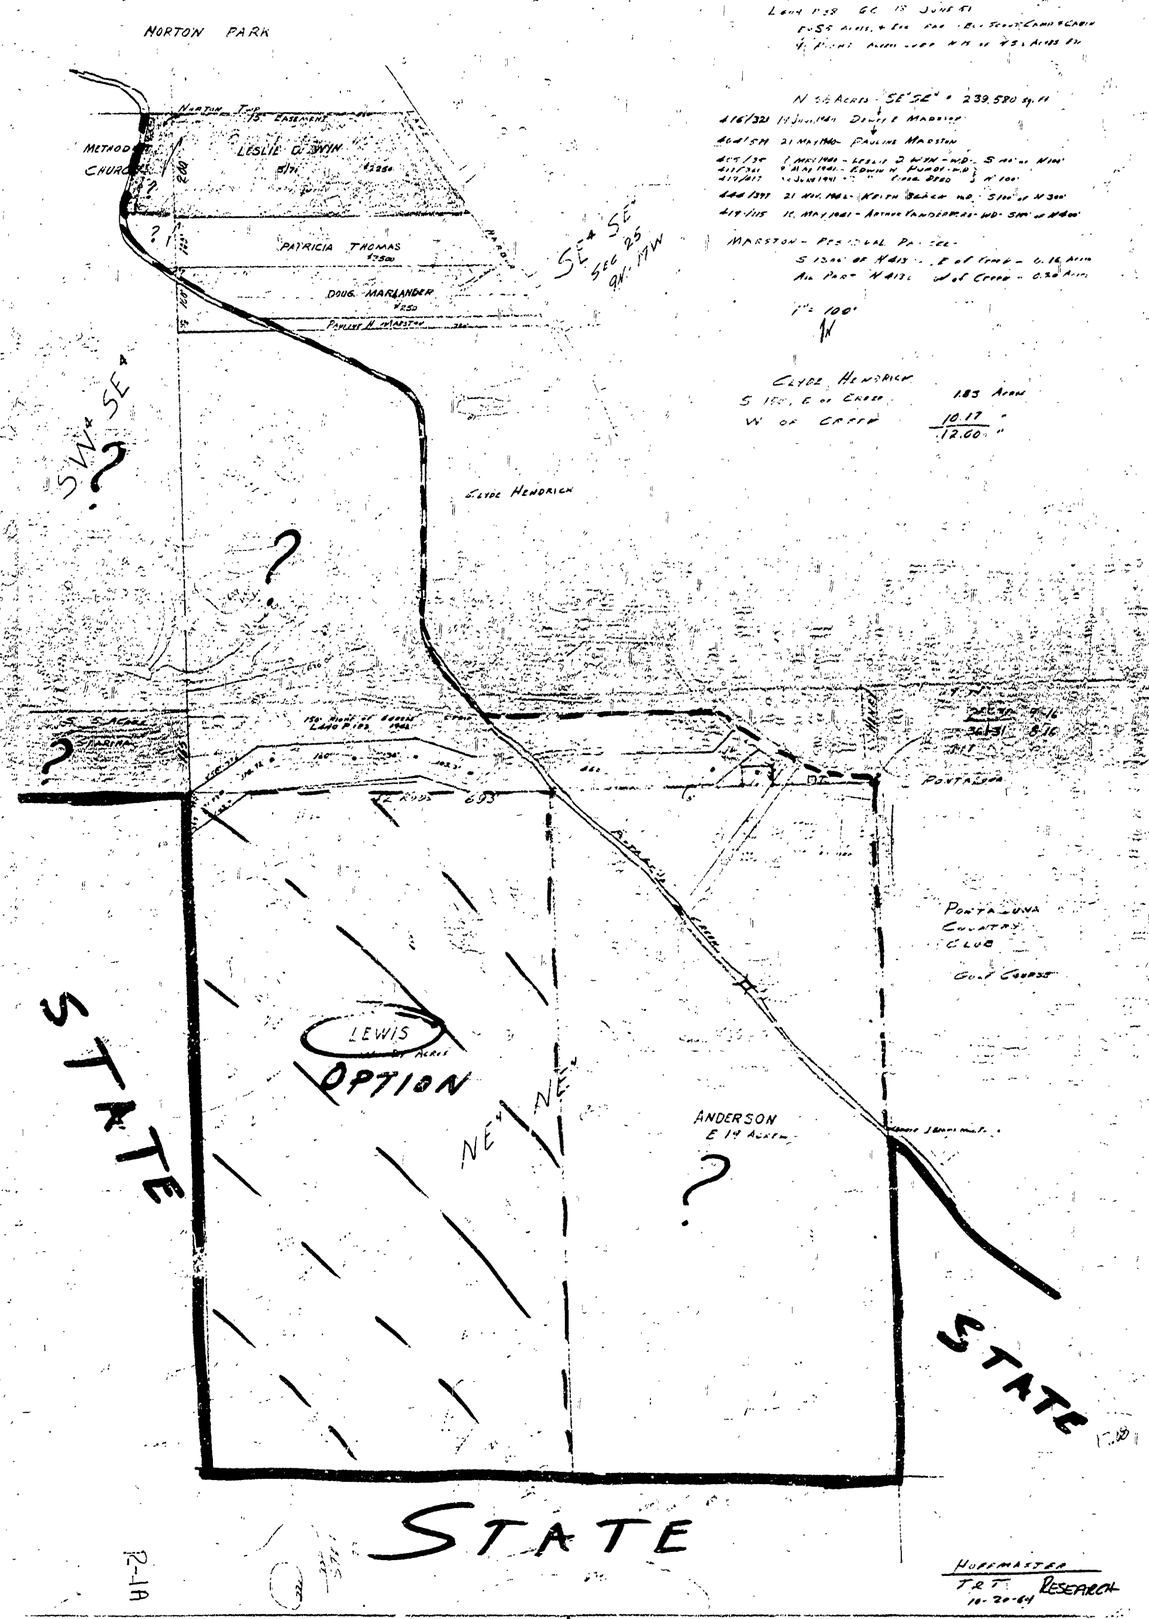
NORTON PARK
METHODIST CHURCH
LESLIE G. SWIN
PATRICIA THOMAS
DOUG. MARLANDER
PAULINE MARSTON
SE¼ SE¼
SEC 25
SW¼ SE¼
CLYDE HENDRICK
SW¼ SE¼
N ½ ACRES - SE¼ SE¼ = 239,580 sq. ft
MARSTON - PERSONAL PARCEL
1" = 100'
N
CLYDE HENDRICK
S 10 ACRES, E OF CREEK 1.83 ACRES
W OF CREEK 10.17
12.00
PORTAGUNA
PORTAGUNA COUNTRY CLUB
GOLF COURSE
LEWIS
OPTION
NE¼ NE¼
ANDERSON
E 14 ACRES
STATE
STATE
STATE
HUFFMASTER
T.R.T. RESEARCH
10-20-64

R-1A