



P. J. HOFFMASTER
State Park
TOTAL ACRAGE - 1063.56
STATE OWNED - 1043.08

■ VICINITY MAP ■

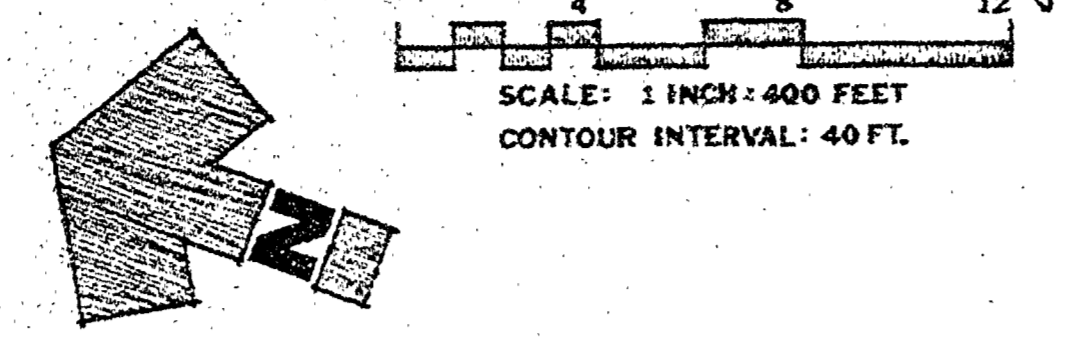

REVIEWED BY: James M. Hane, Park Design Section, 5-10-73, Date

APPROVED BY: O. J. Scherschligt, Chief, Parks Division, 5-10-73, Date

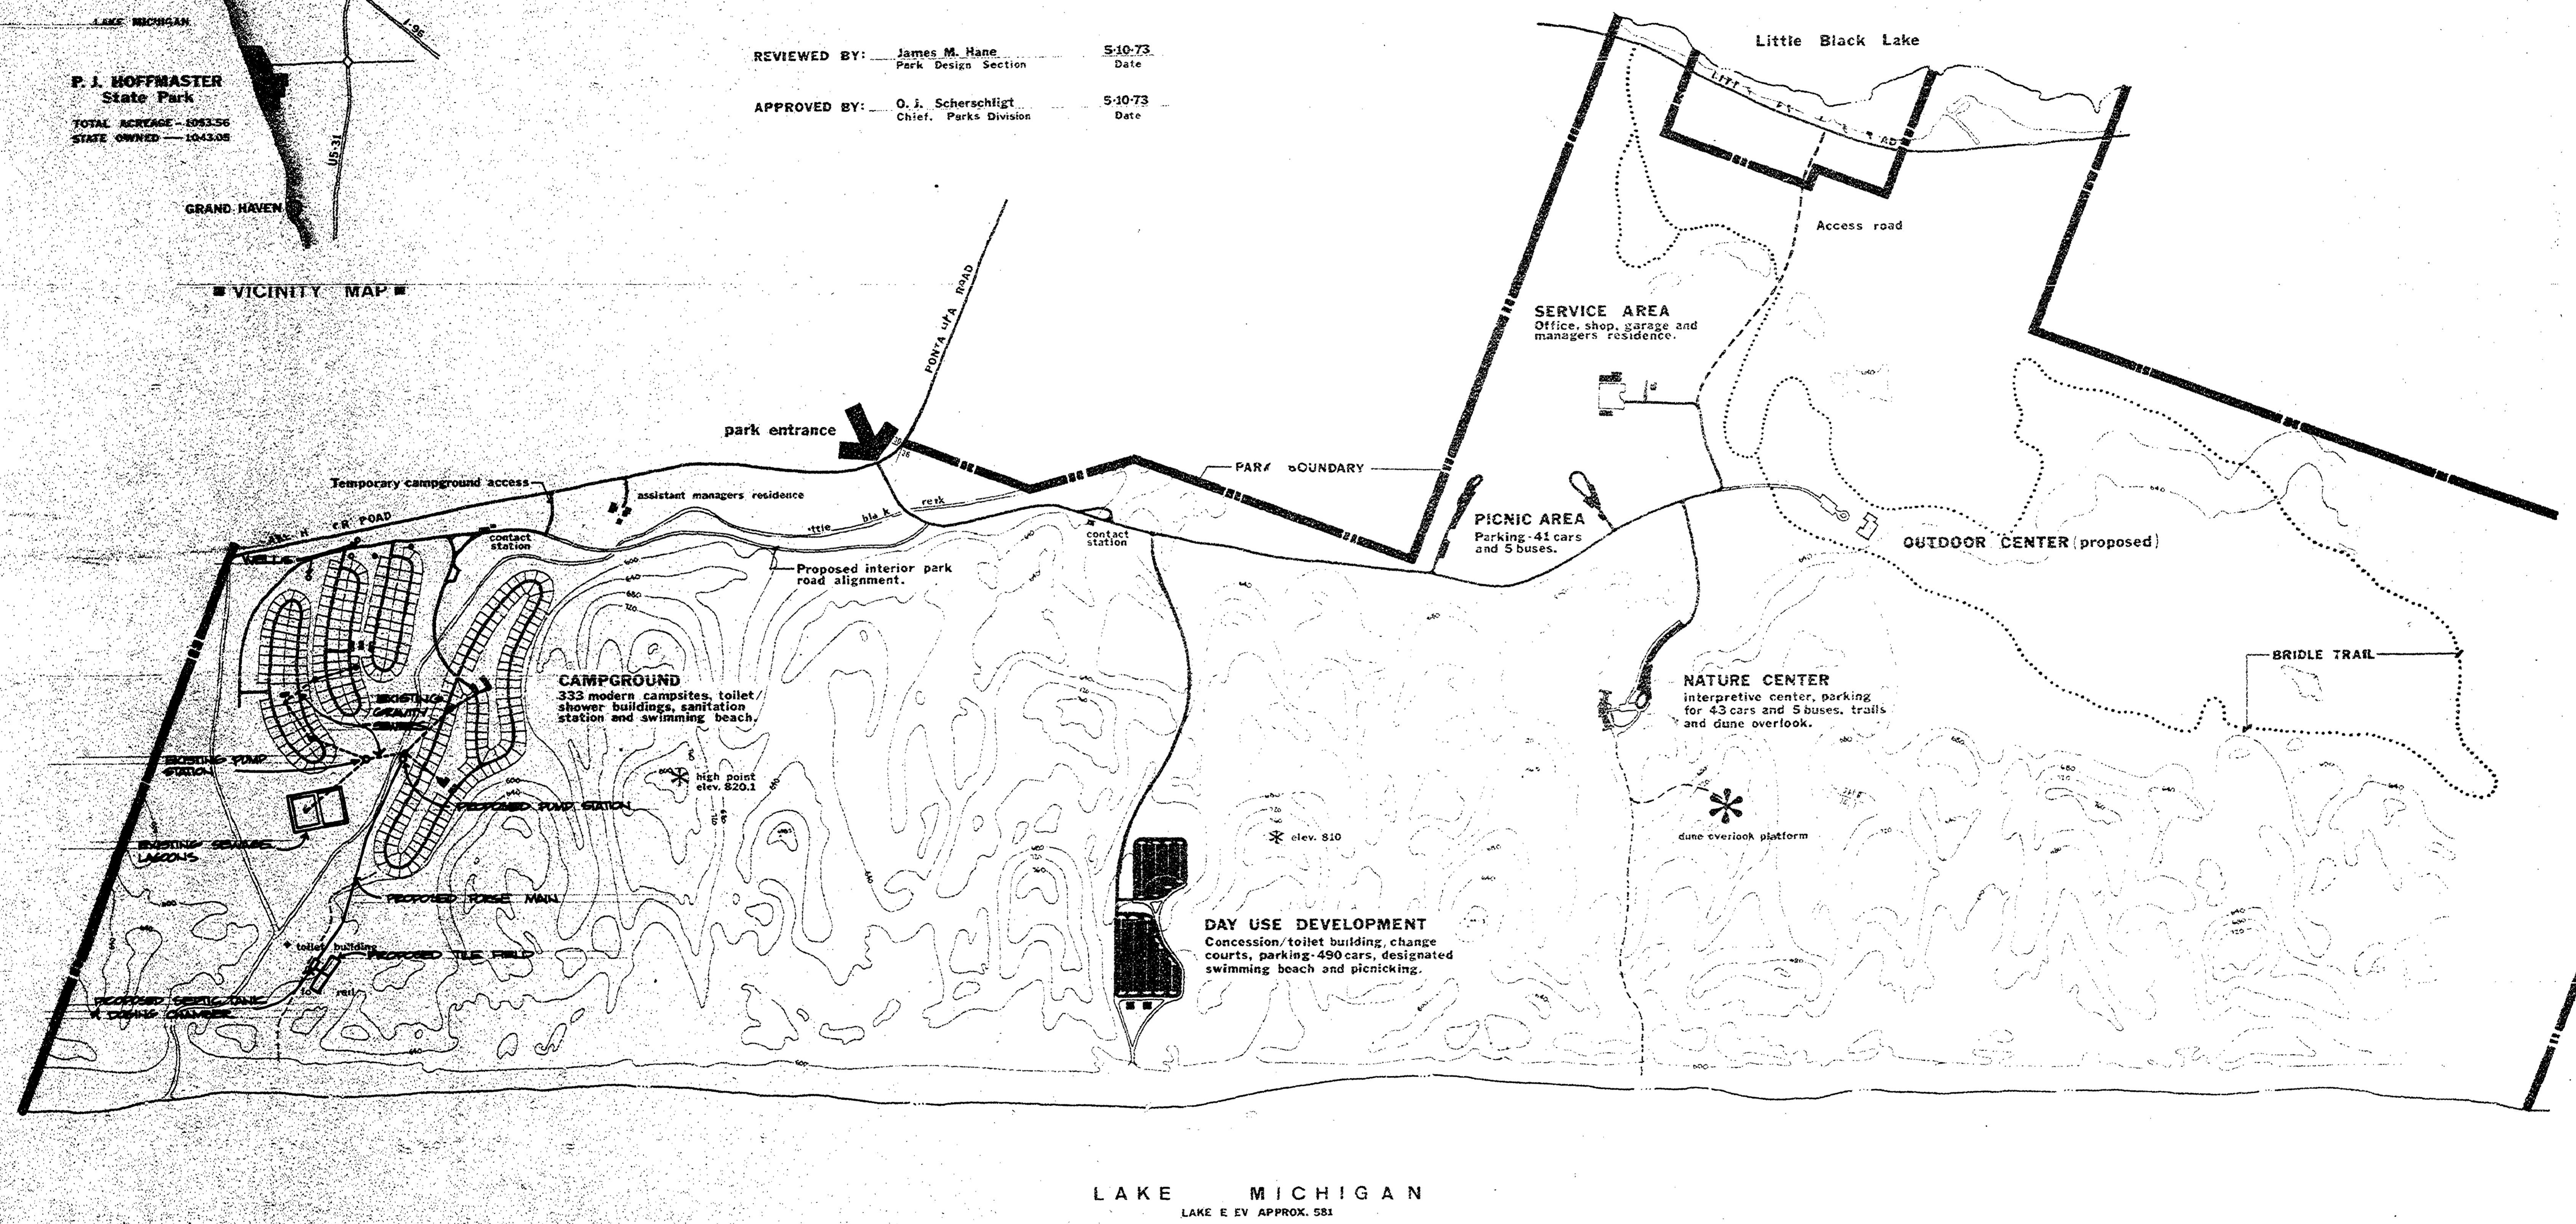

LAKE MICHIGAN
LAKE E LV APPROX. 581

DESIGNED BY: S.A.M.	DRAWN BY: S.A.M.	DATE: 5-28-73	NO. DATE BY	REVISIONS	NO. DATE BY	REVISIONS	MICHIGAN DEPARTMENT OF NATURAL RESOURCES	P. J. HOFFMASTER STATE PARK	PROJECT NO. 21-963
CHECKED BY: S.A.M.	CHECKED BY: S.A.M.	DATE: 11/8/73	1	SEWER SYSTEM ALTERATIONS	2				SHEET 1 OF 1 PLAN NO. L-117
			4						