


PRELIMINARY MAP OF PORCUPINE MTS.

AREA IN PROJECT
 WITHIN LEGISLATIVE BOUNDARY
 45,596.47 ACRES
 WITHIN EXTENDED BOUNDARY
 12,926.42 ACRES
 TOTAL 58,522.89 ACRES
 FROM GLO SURVEY

AREA

SCALE -
 APPROX. 1 1/8" = 1 MILE

- T = Timber
- S = Surface
- ⊙ = 1/2" contour - Top 24'

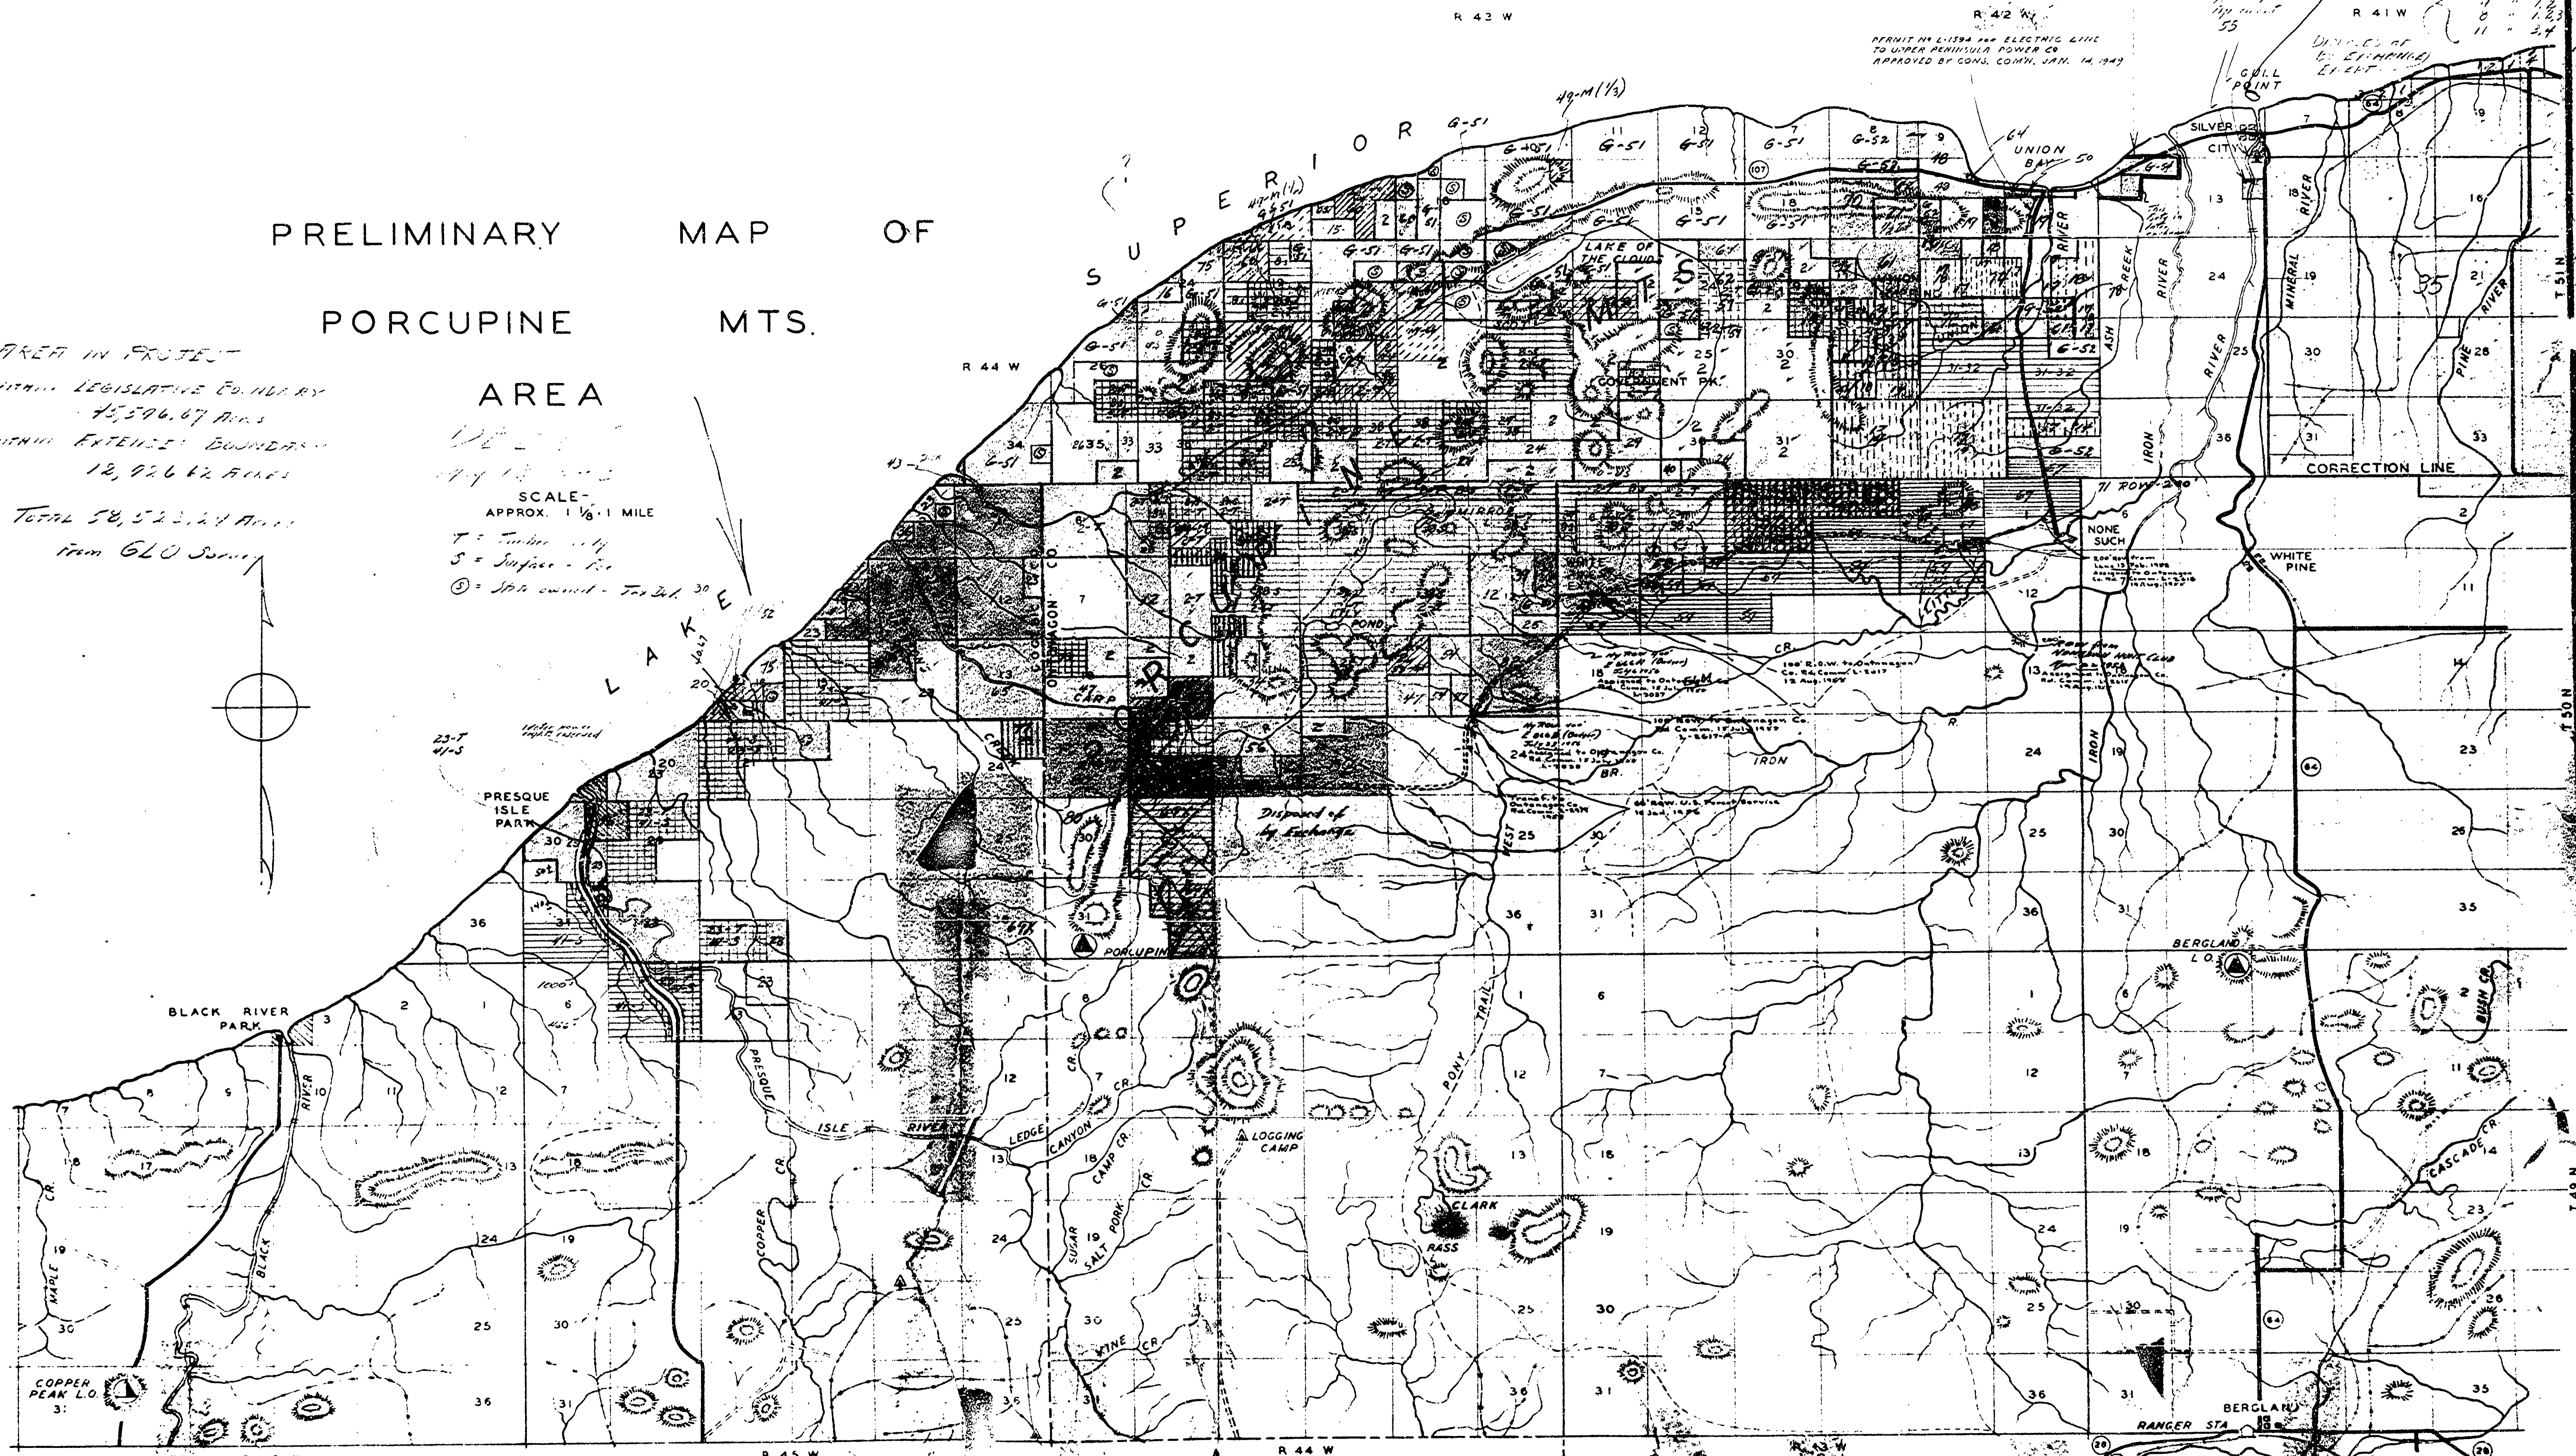

Boundary extended
 Feb 11, 1940

Permit L-2230
 TO WHITE PINE POWER CO
 FOR WATER GATE TUNNEL
 October 10, 1932

WEIG for E.L.
 1 - 1.7, 1.4
 8 - 1.23
 11 - 2.4

DEVELOPED BY
 ST. HENRI
 ELECT.

PERMIT NO. L-1594 FOR ELECTRIC LINE
 TO UPPER PENINSULA POWER CO
 APPROVED BY CONG. COM. JAN. 14, 1947