


MATCH SHEET 1

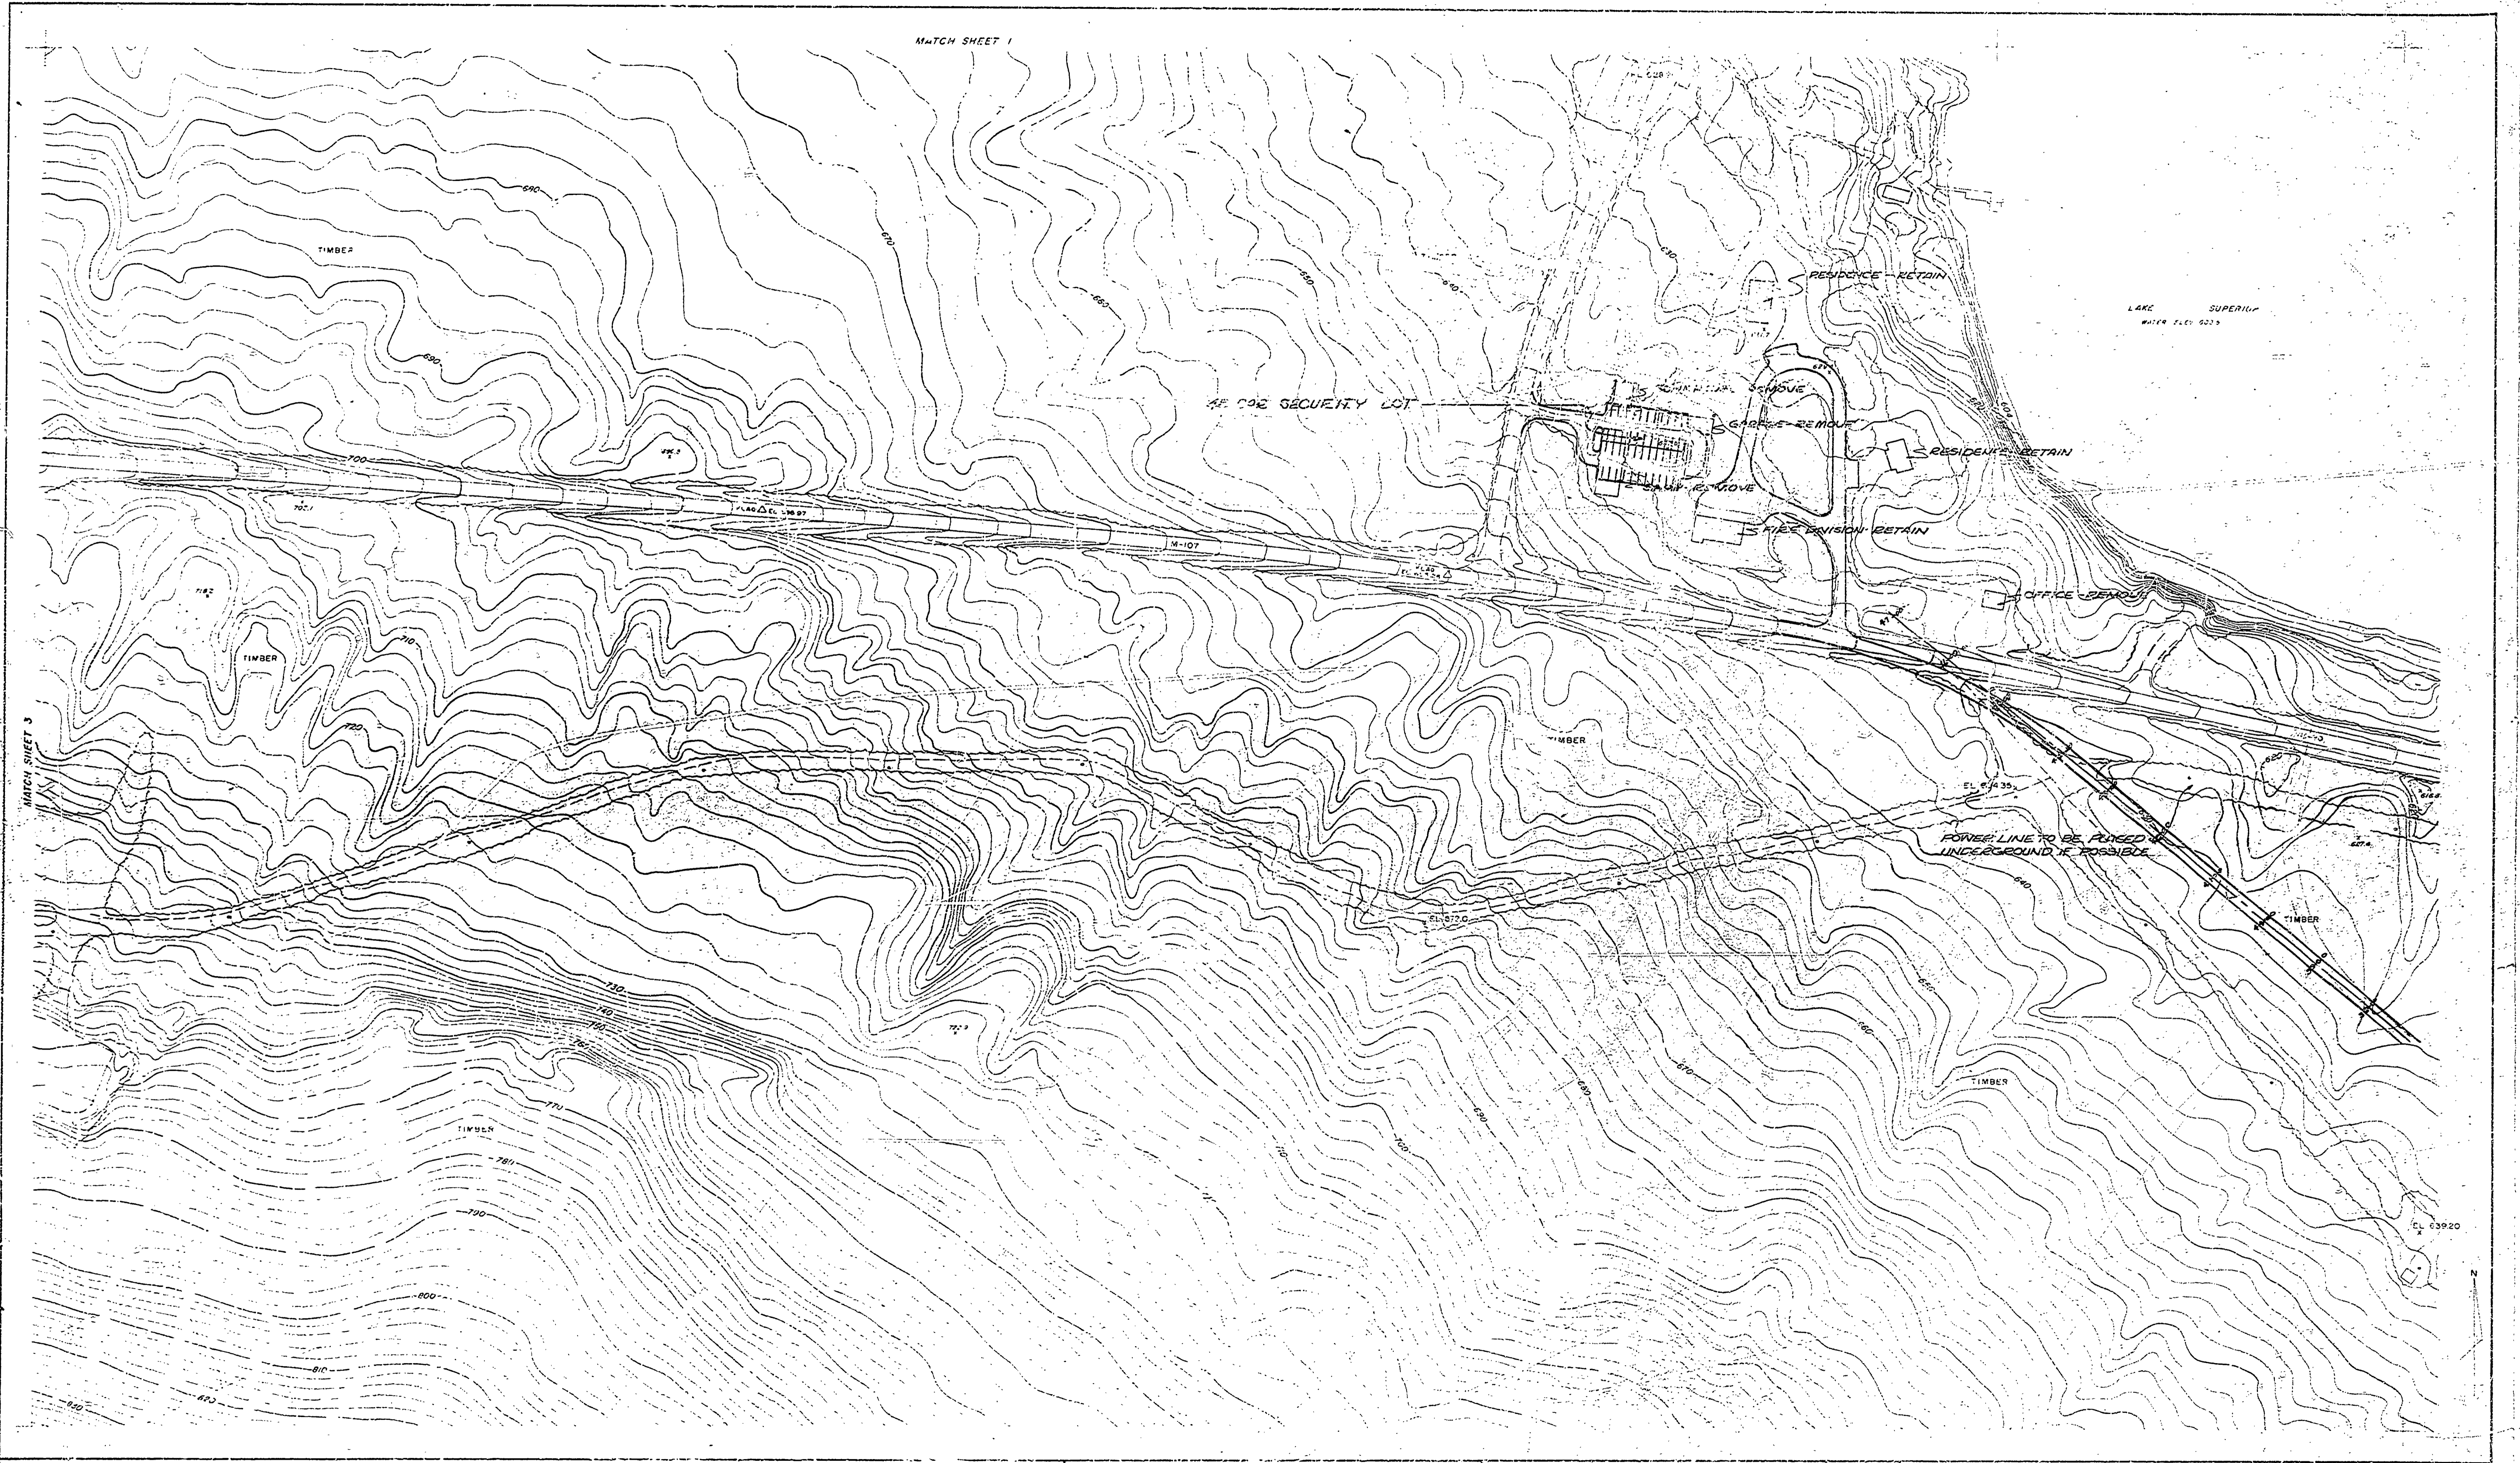

MATCH SHEET 3

M-107 SERVICE AREA  
RELOCATION

MICHIGAN  
DEPARTMENT OF NATURAL RESOURCES  
PARKS DIVISION

PORCUPINE MOUNTAINS  
WILDERNESS STATE PARK  
SCALE 1"=100'  
CONTOUR INTERVAL 2'

SHEET  
NO. 3  
OF 3

PLAN NO.  
R-116

R-29