R-1538 COMMERCIAL BLUEPRINT SERVICE 500 11-74 59602

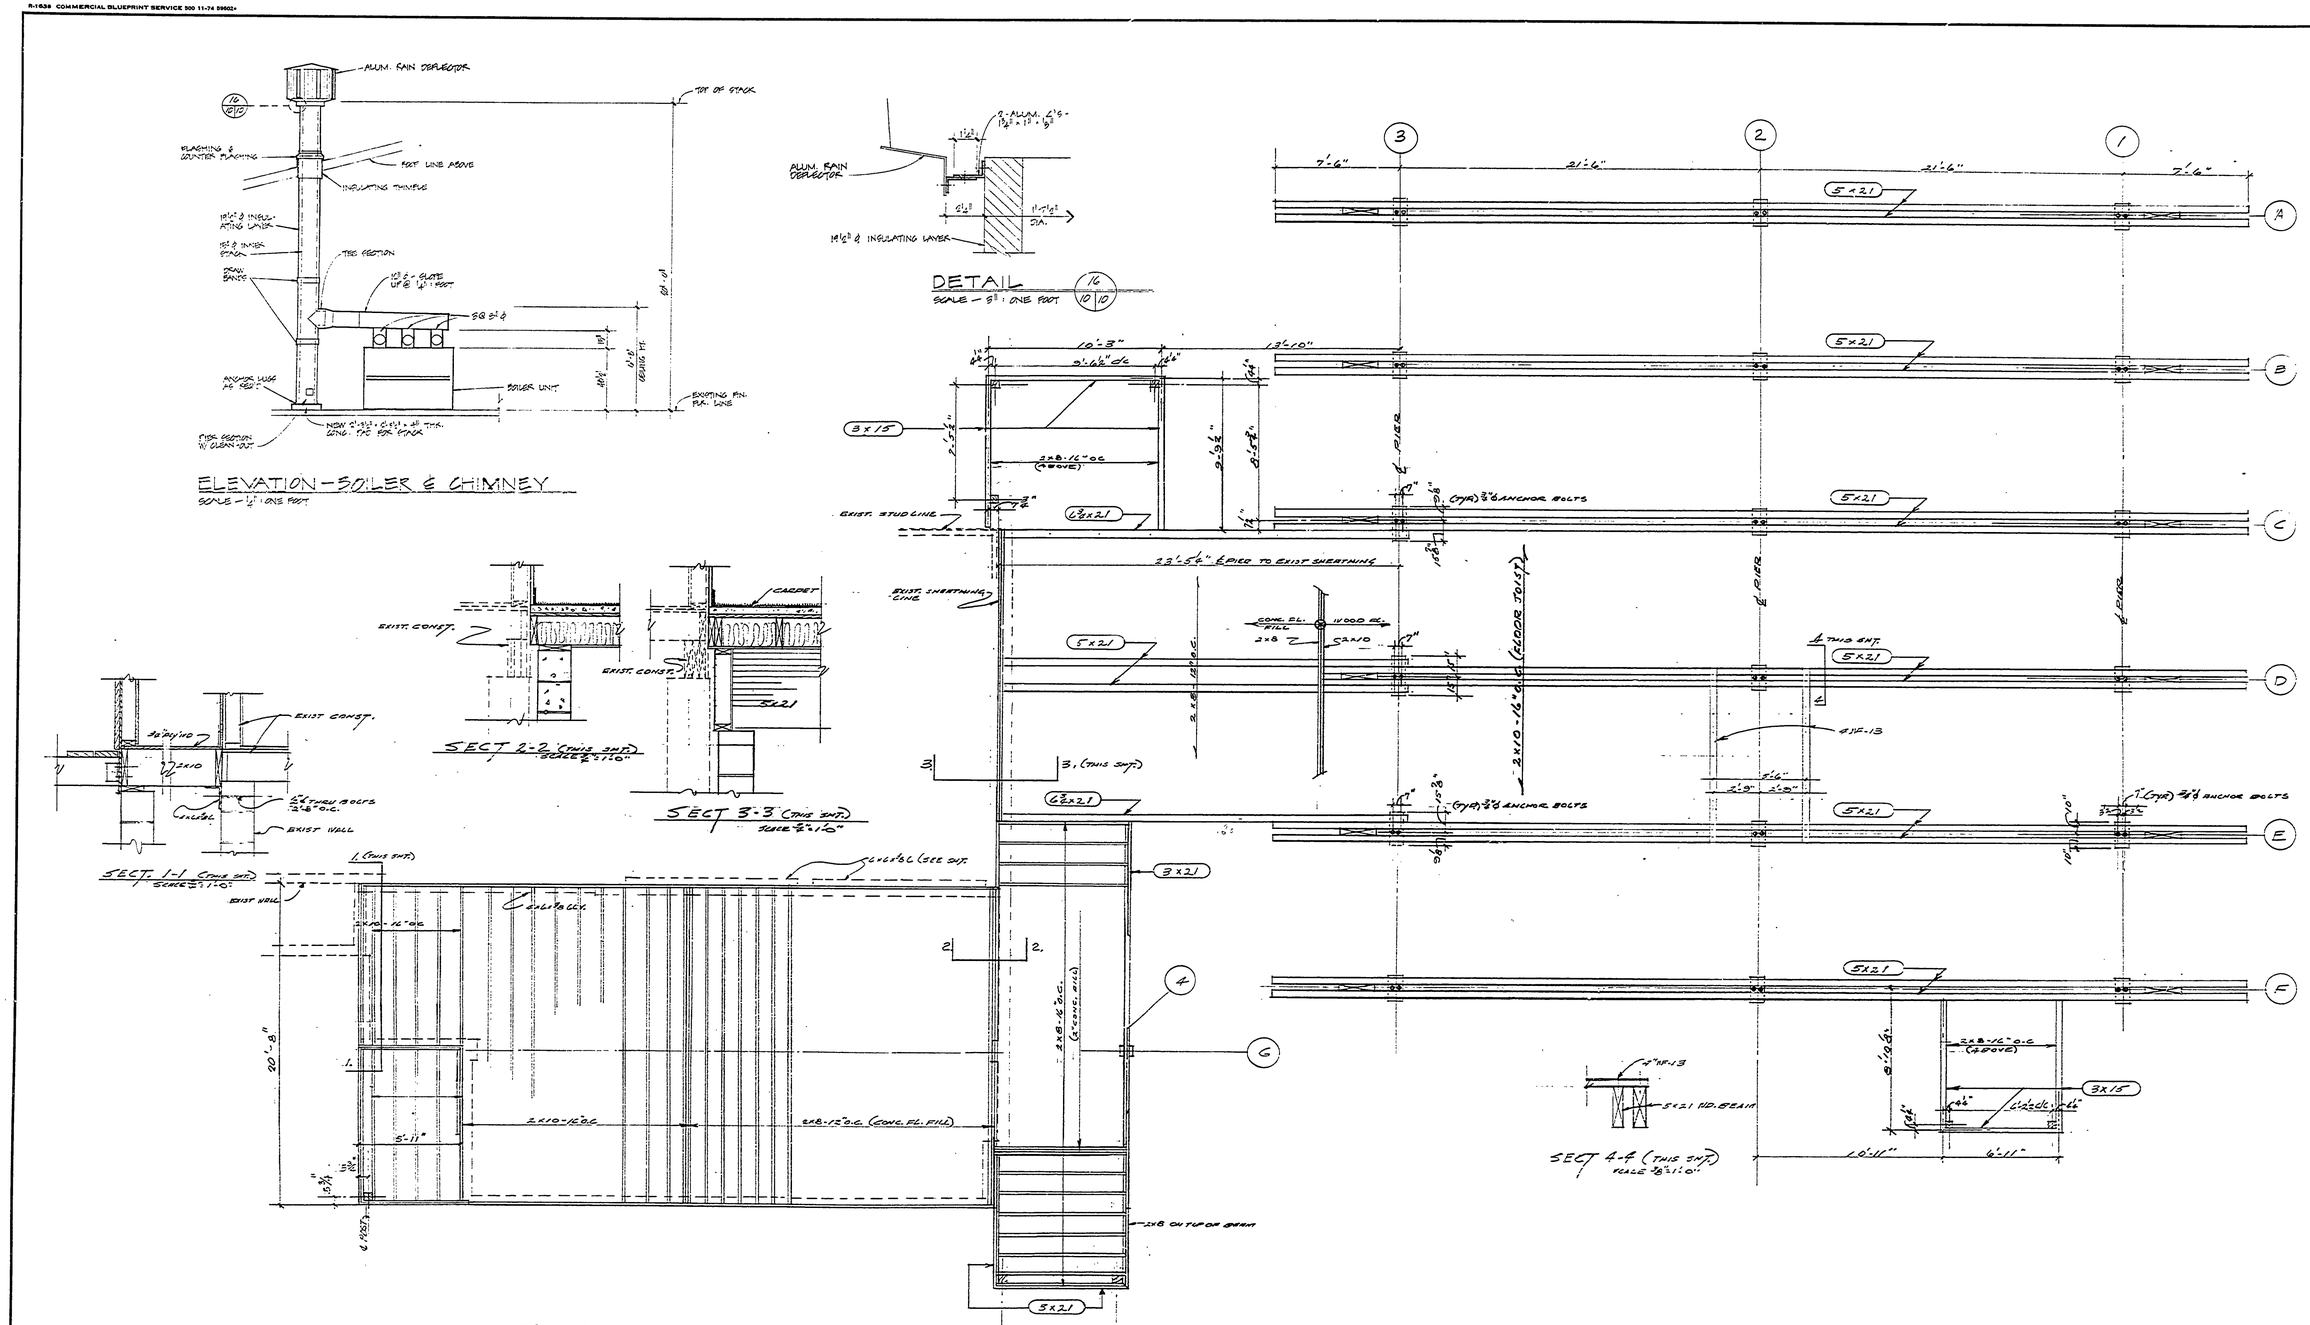

SURVEYED BY		DRAWN BY		NO.	DATE	BY	REVISIONS	NO.	DATE	BY	REVISIONS	MICHIGAN DEPARTMENT OF NATURAL RESOURCES	FLOOR FRAMING PLAN
DESIGNED BY	DATE	CHECKED BY	DATE	1.	8/20	DDP	REVISE SIZE OF CONCESSION OFFICE & DECK, ETC. TO COMPLY WITH EXIST. CONST.	3.					SHEET TITLE
				2.				4.					

PORCUPINE MOUNTAINS STATE PARK
AREA OR PARK

SKI CHALET ADDITION
PROJECT

PROJECT NO. 24-1424

SHEET 10 OF 15

PLAN NO. A-118