


NO.	DATE	BY	REVISIONS
1			
2			
3			
4			
5			
6			

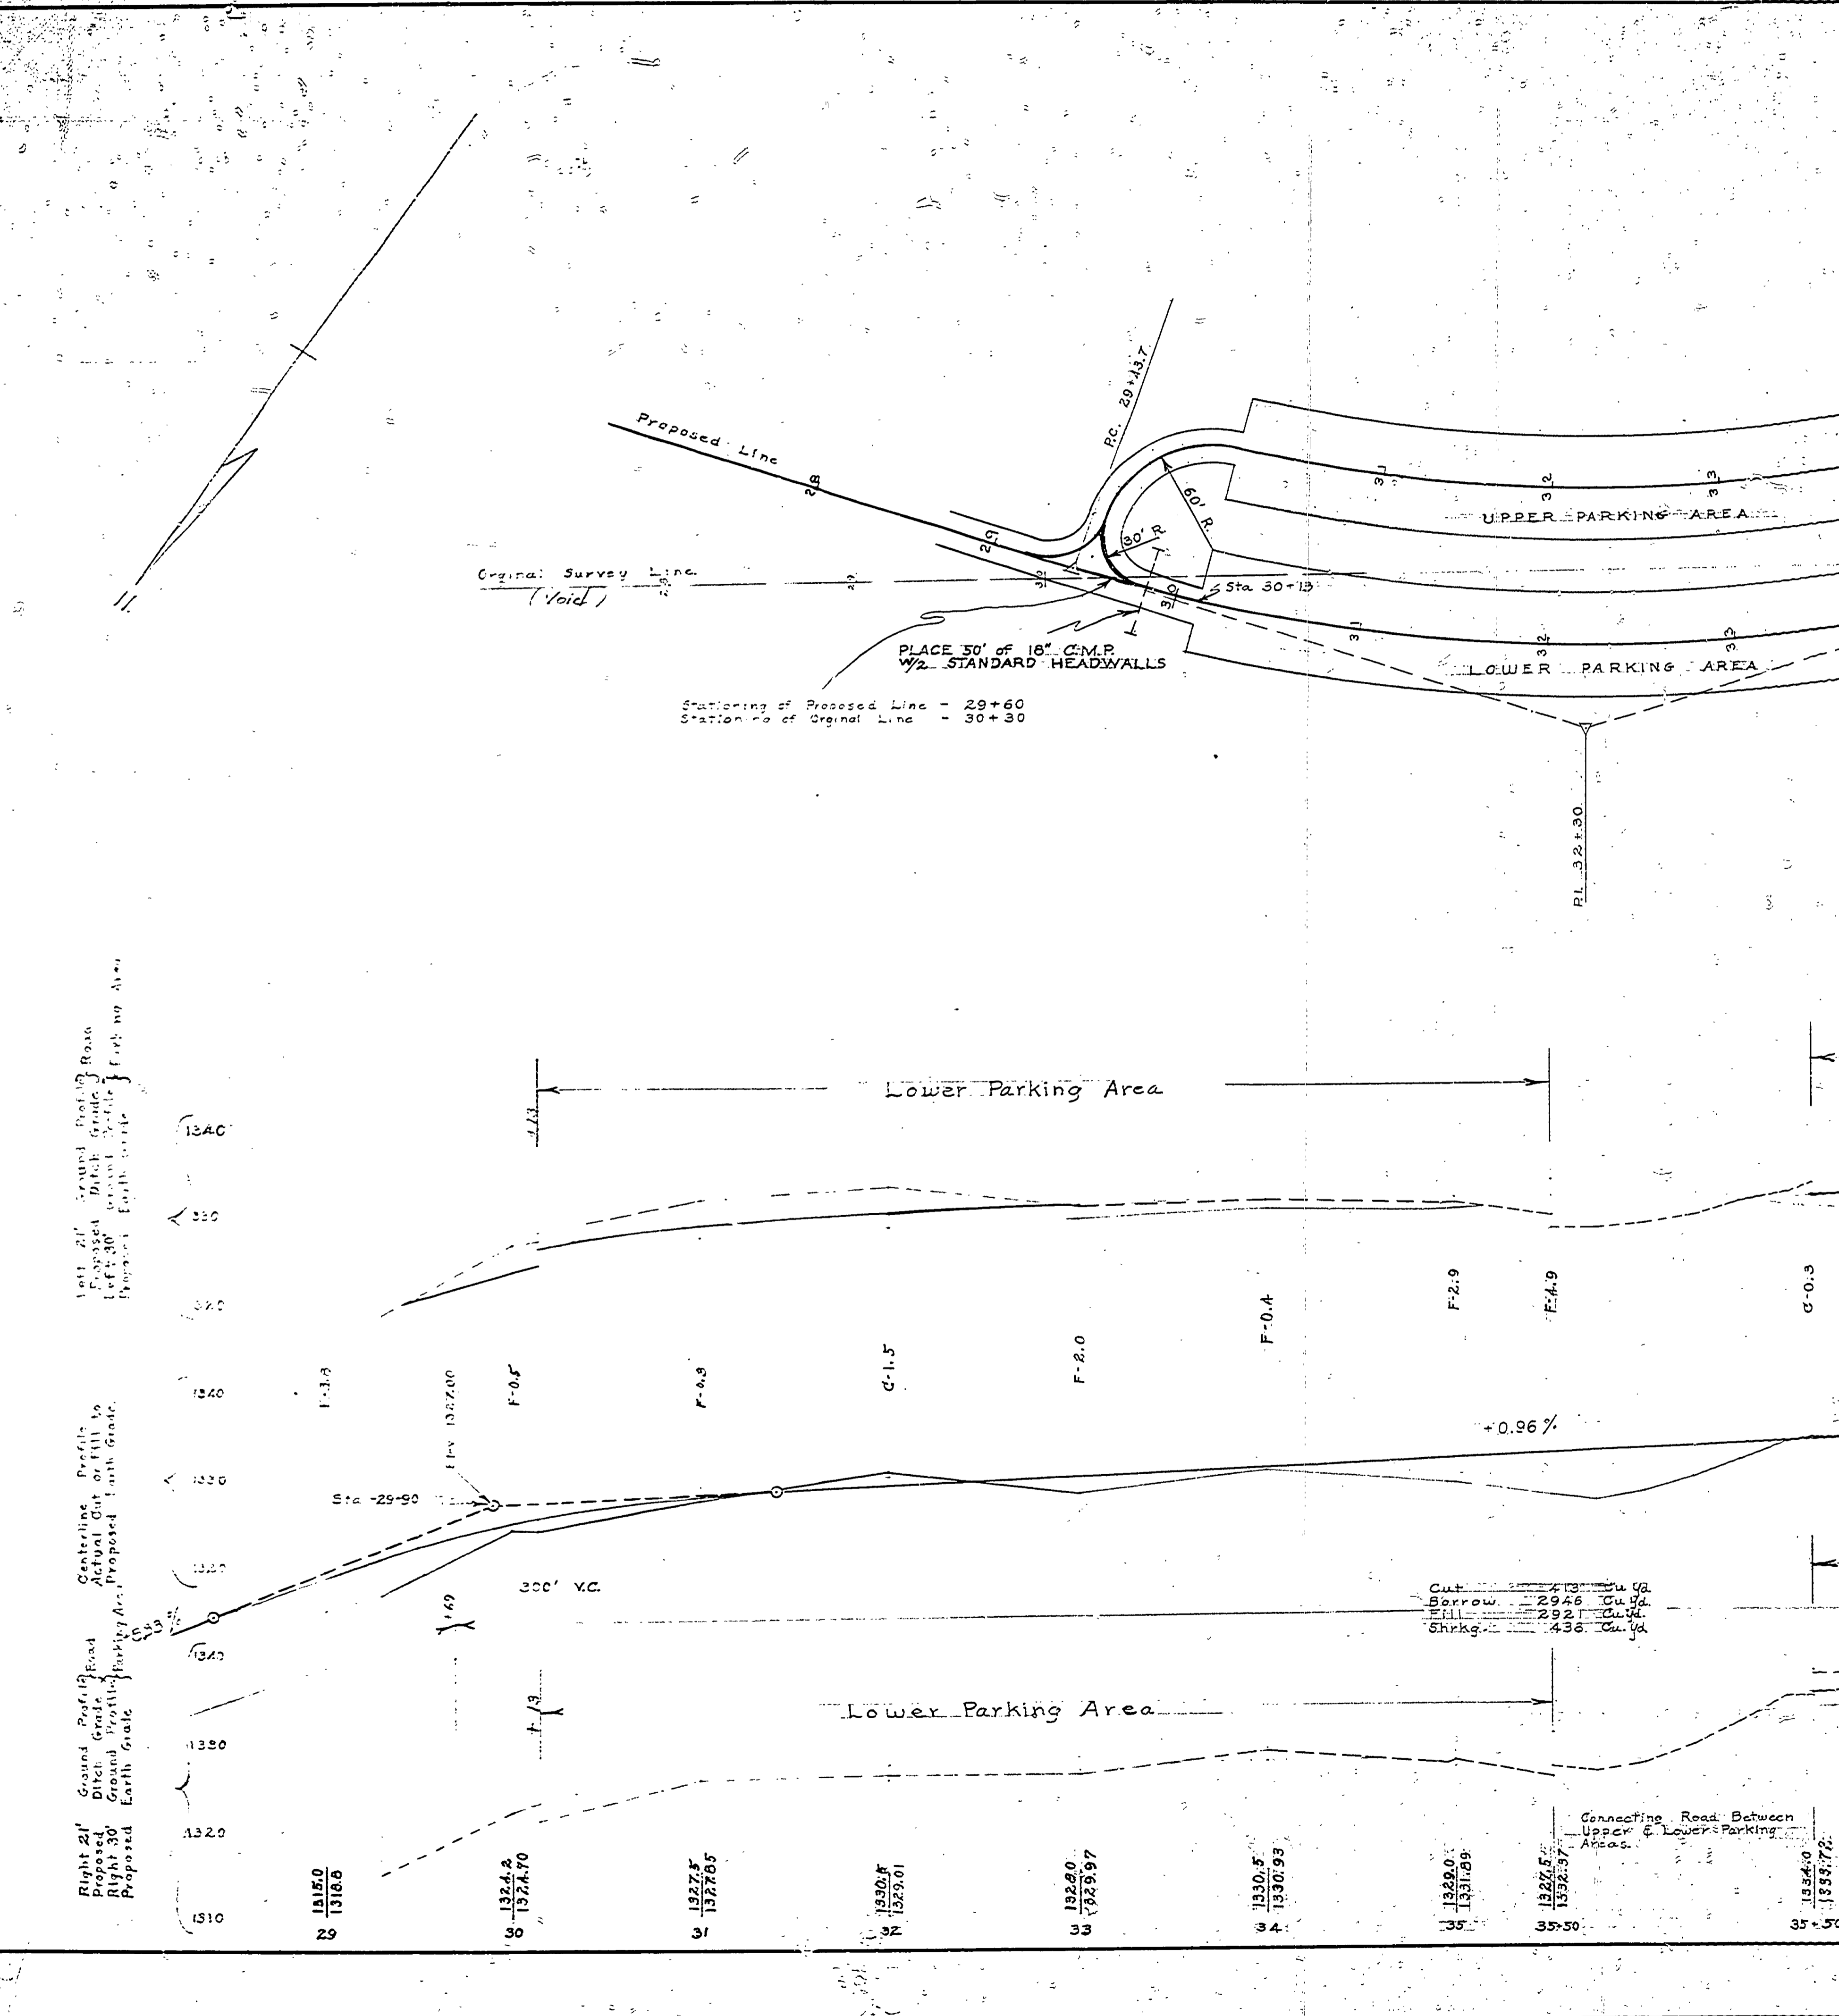

Curve Data to Be Staked on Const.

Δ = 37° 10'

D = 57.44'

T = 286.3'

L = 552.2'

R = 651.4'

PC = 29+43.7

PT = 32+30'

P.T. = 34-95.9

Right of Way Proposed Road  
Ditch Grade  
Ground Profile  
Proposed Road  
Proposed Earth Grade

Centerline Profile  
Actual Cut or Fill to Proposed Earth Grade

Left of Way Proposed Road  
Ditch Grade  
Ground Profile  
Proposed Road  
Proposed Earth Grade

