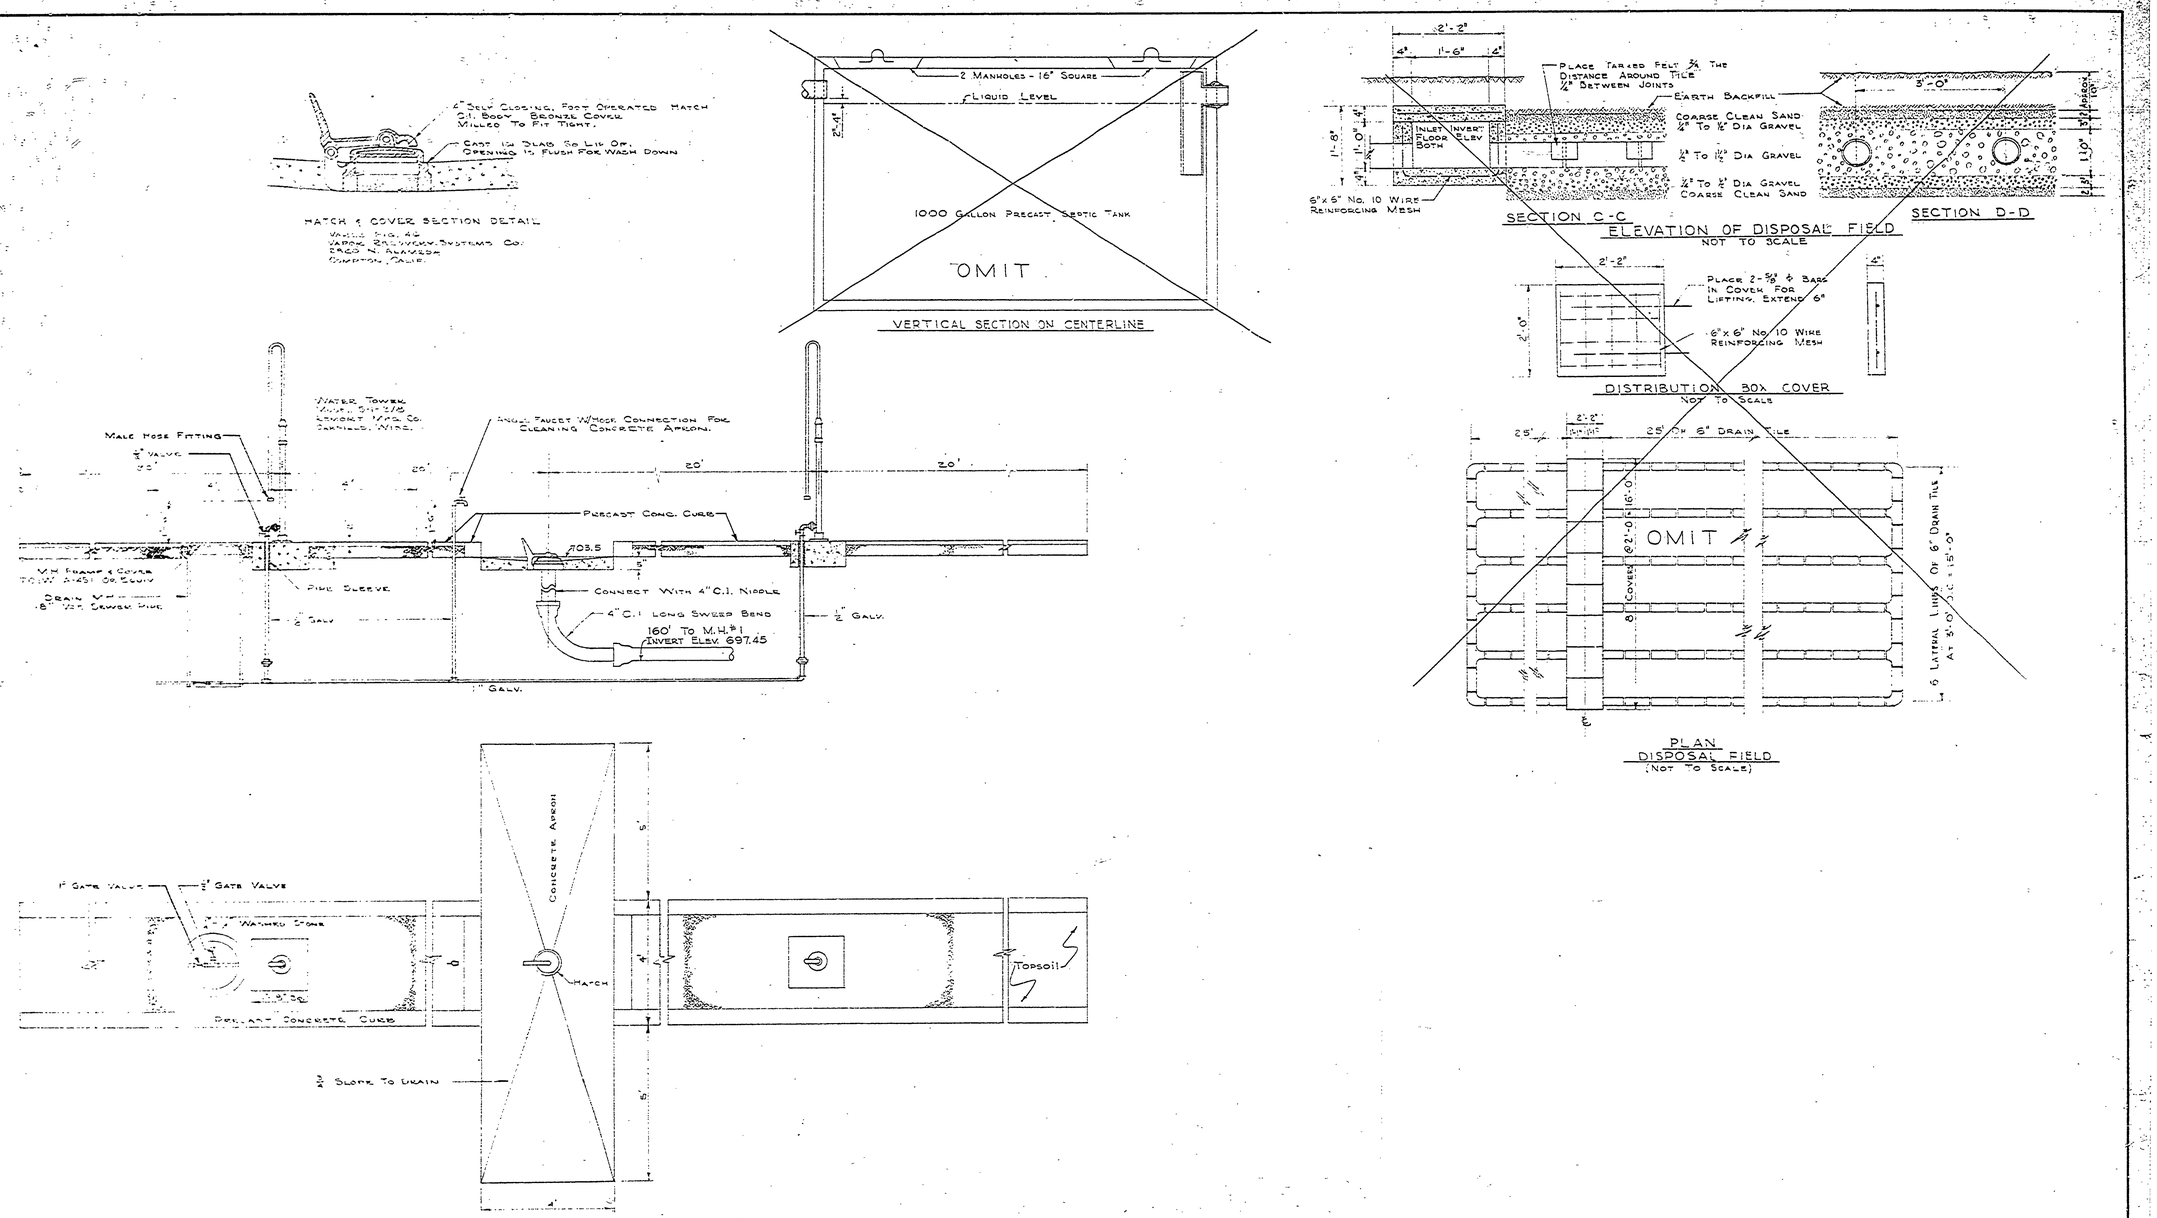

SANITATION STATION

DATE	NO.	DATE	BY
	1		
	2		
	3		
	4		
	5		
	6		

REVISIONS

		DATE
APPROVED		
REVIEWED	ARCHITECTURAL	3-11-64
	ENGINEERING	8-11-64
	LANDSCAPE	

		DATE
DESIGNED BY		
DRAWN BY	J.K. & D.M.C.	Dec '65
CHECKED BY	B.H.S.	Mar '64

MICHIGAN
DEPARTMENT OF CONSERVATION
PARKS AND RECREATION DIVISION

PORCUPINE MOUNTAINS STATE PARK
PRESQUE ISLE SECTION
CENTRAL SEWAGE DISPOSAL SYSTEM

SHEET NO. 3 OF 6

PLAN NO. E-117

PR56-999-976-002-C1

SHEET 9 OF 18