


DESIGNED BY	DATE	REVIEWED	DATE	APPROVED	DATE	NO.	DATE	BY	REVISIONS	DATE	BY
DRAWN BY S.S.	4-20-61	ARCHITECTURAL	ENGINEERING	LANDSCAPE	1	1			4		
					2	2			5		
					3	3			6		

Legend	
— W	Water Line
— S	Sewage Line
— M	Mains
○	Drinking Fountain
□	Stop, Waste & Drain Valve
□	Septic Tank
□	Dosing Chamber
○	Tile Field
— G.P.	Galvanized Pipe
— V.T.	Vertical Tile
— C.I.	Cast Iron Pipe



Campground Road

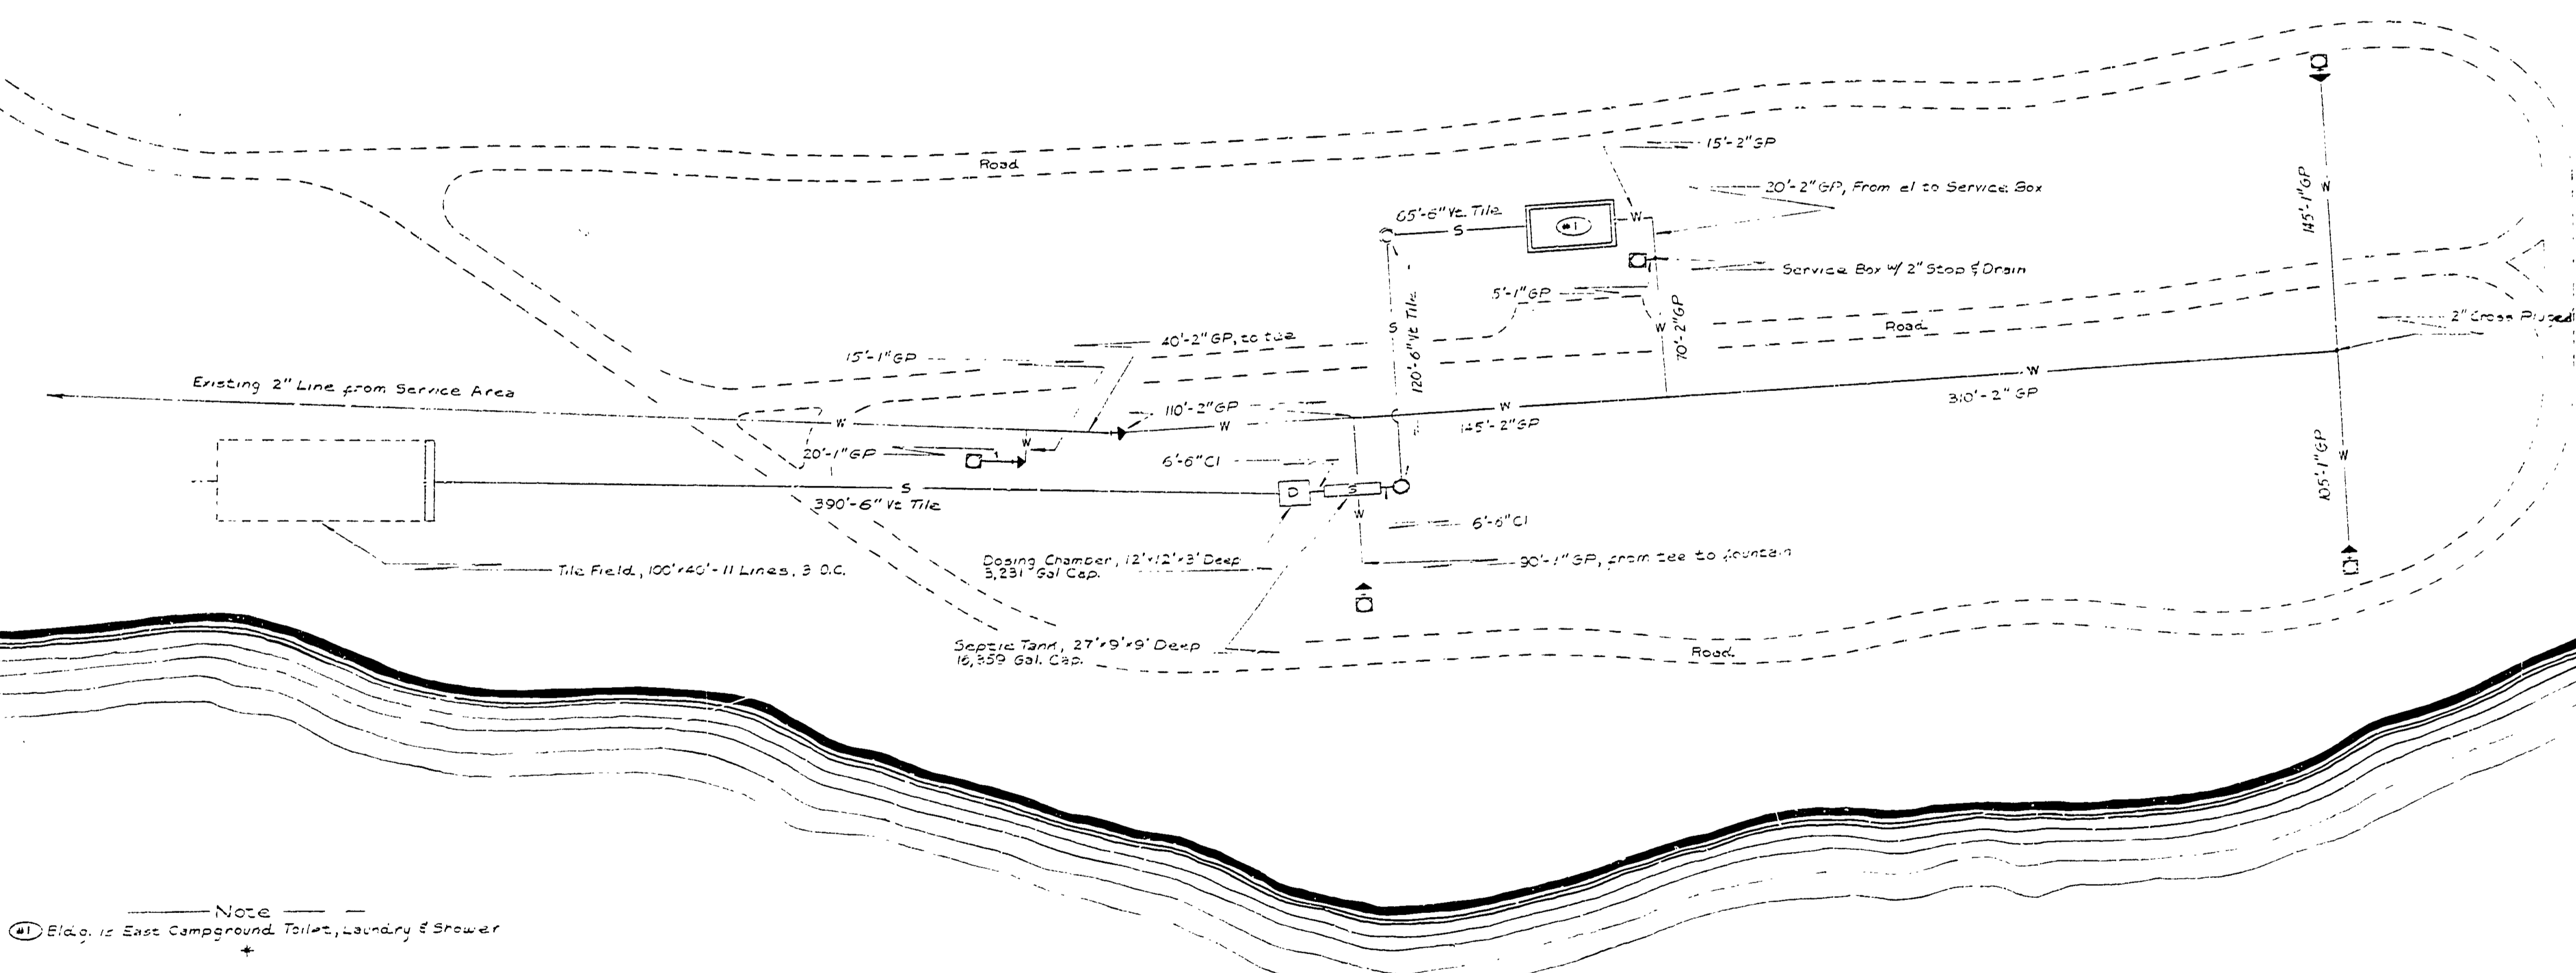

Note
 (1) Bldg. is East Campground Toilet, Laundry & Shower

Lake Superior

Porcupine Mountains State Park East Campground

Scale: 1"=50'

MICHIGAN
 DEPARTMENT OF CONSERVATION
 PARKS AND RECREATION DIVISION

Porcupine Mountains State Park
 Utility Map
 Water & Sewage Distribution System

SHEET		PLAN NO.	
NO. 2	OF 4	U-1	

PLATE NO. 2