
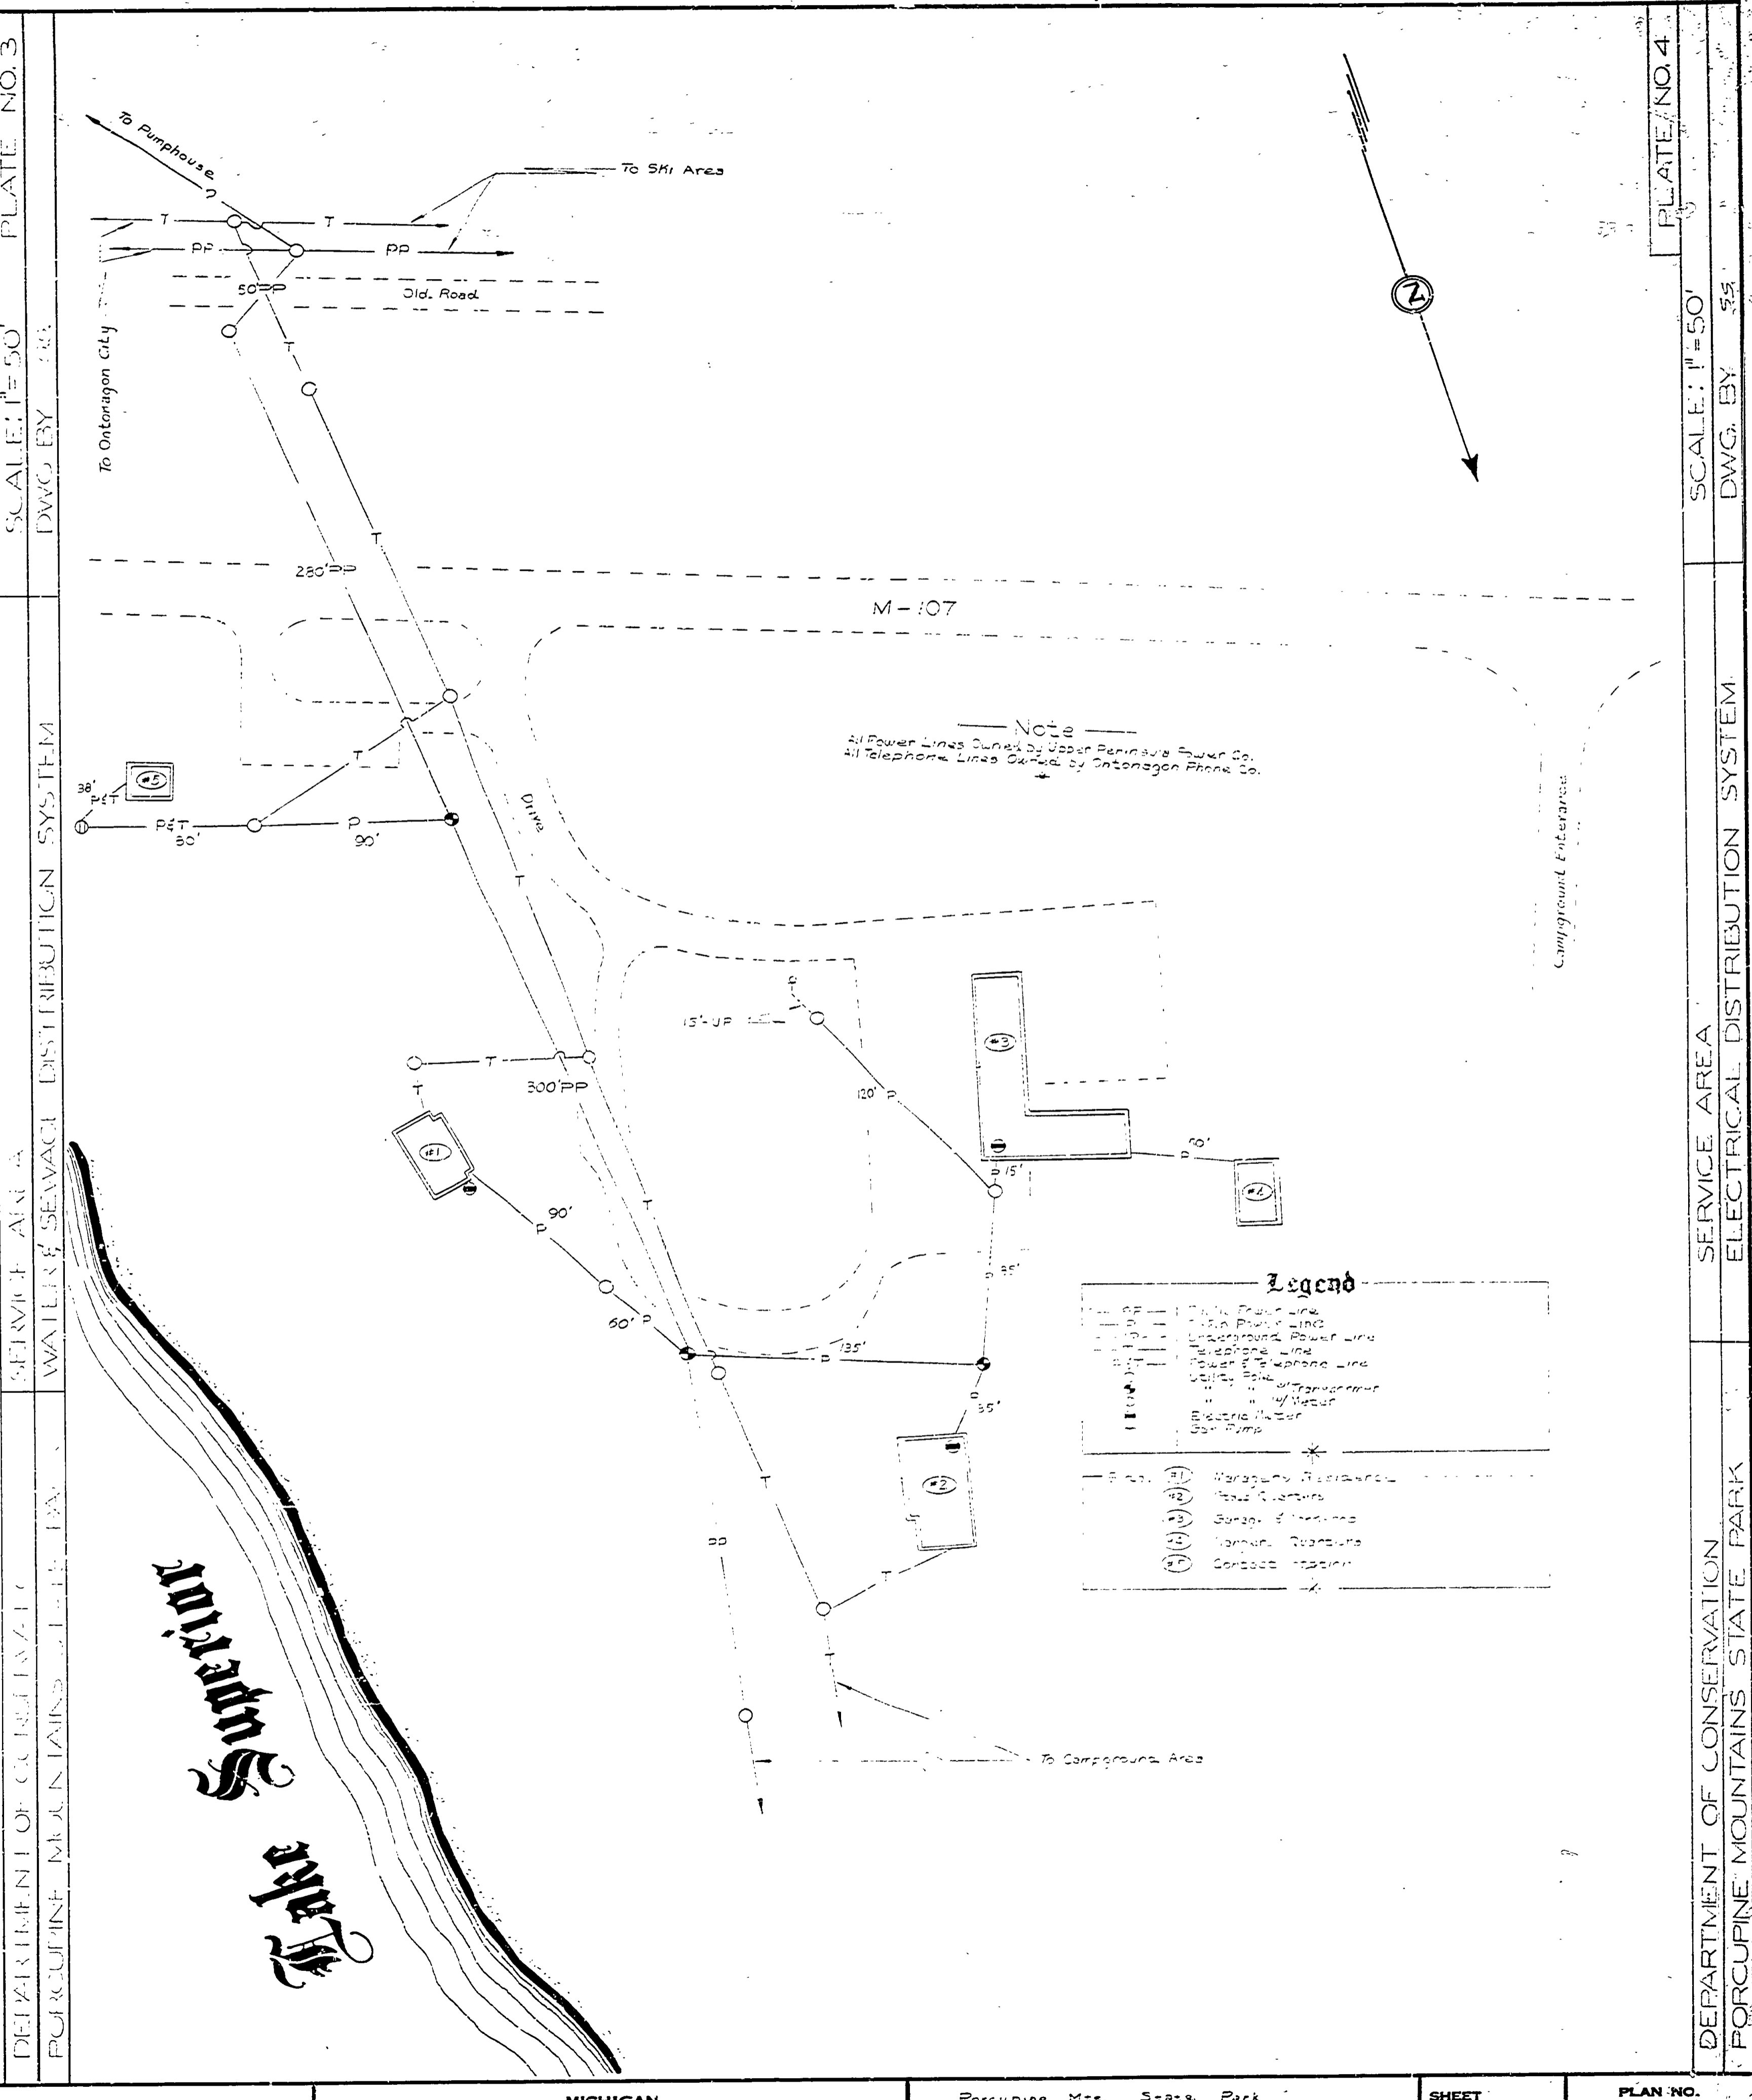


DESIGNED BY	DATE	REVIEWED	DATE	APPROVED	DATE	NO.	DATE	BY	REVISIONS	DATE	BY
ARCHITECTURAL		ARCHITECTURAL				1			4		
ENGINEERING		ENGINEERING				2			5		
LANDSCAPE		LANDSCAPE				3			6		

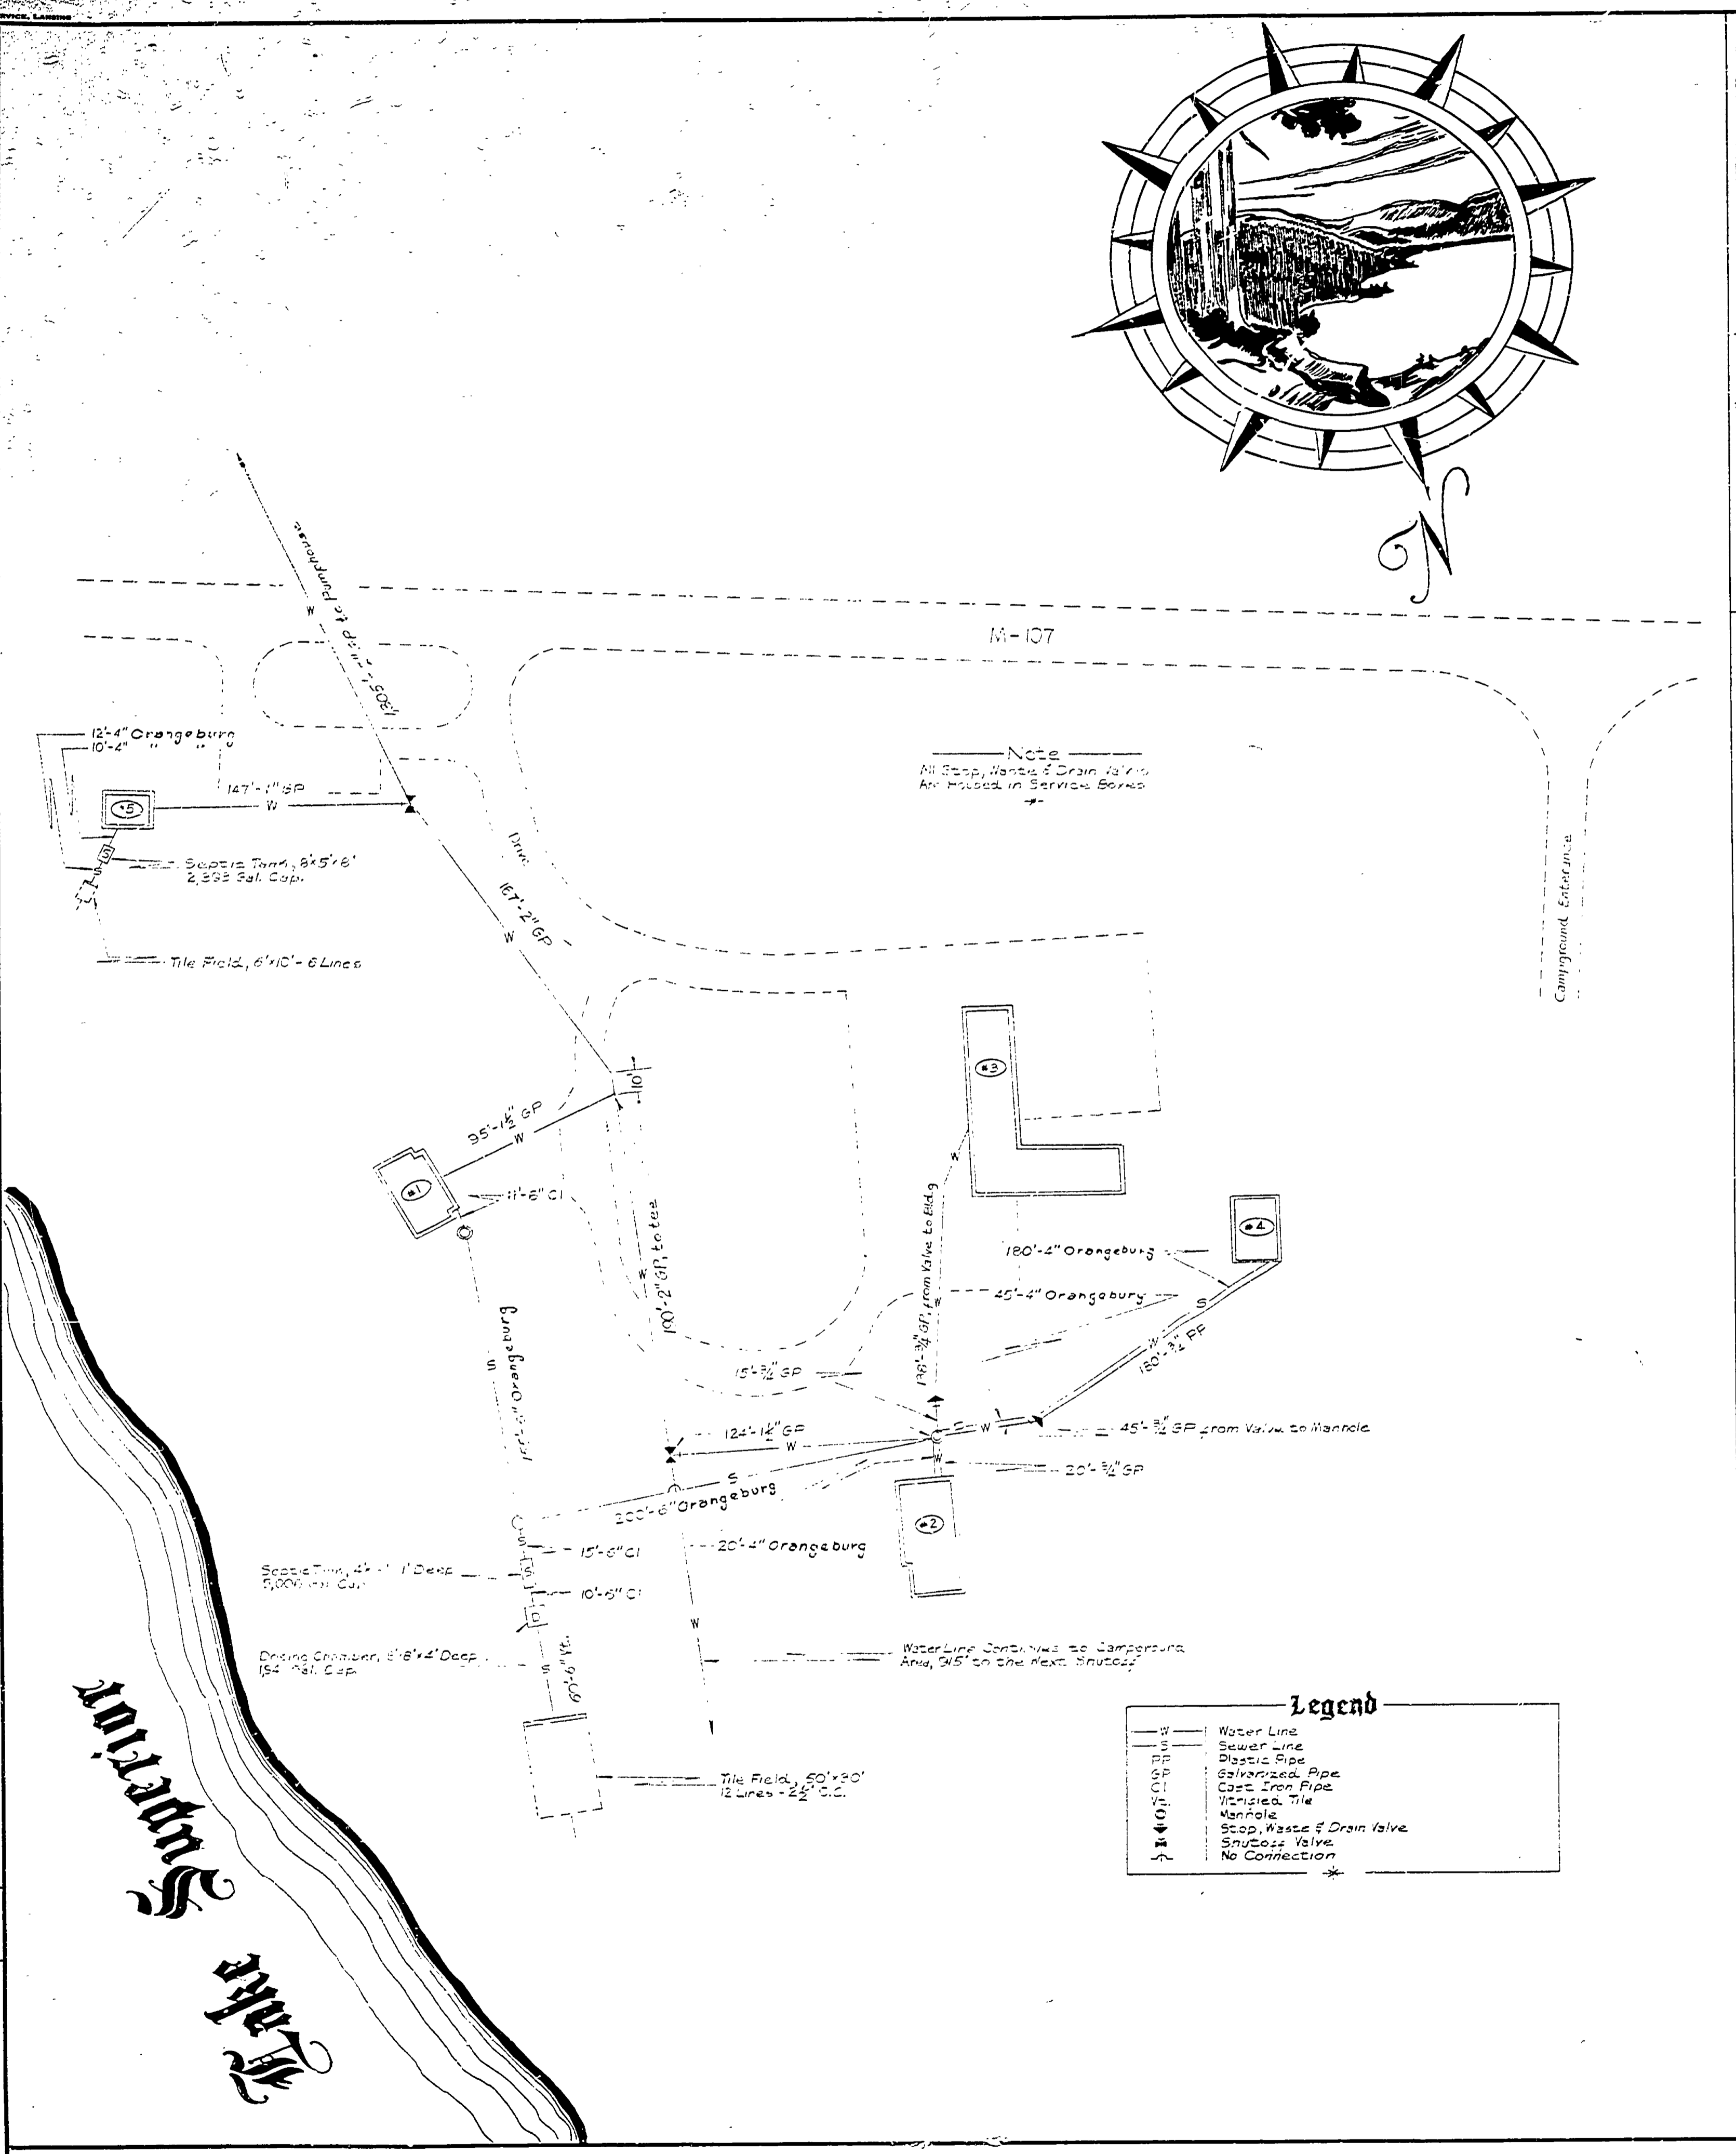

PORCUPINE MTS. STATE PARK - SERVICE AREA

DEPARTMENT OF CONSERVATION
 PORCUPINE MOUNTAINS STATE PARK
 SERVICE AREA
 ELECTRICAL DISTRIBUTION SYSTEM
 SCALE: 1" = 50'
 DWG. BY
 PLATE/NO. 4