MUSKALLONGE LAKE STATE PARK

CAMPGROUND WATER SYSTEM

CONTRACT NO. 975-8-C1

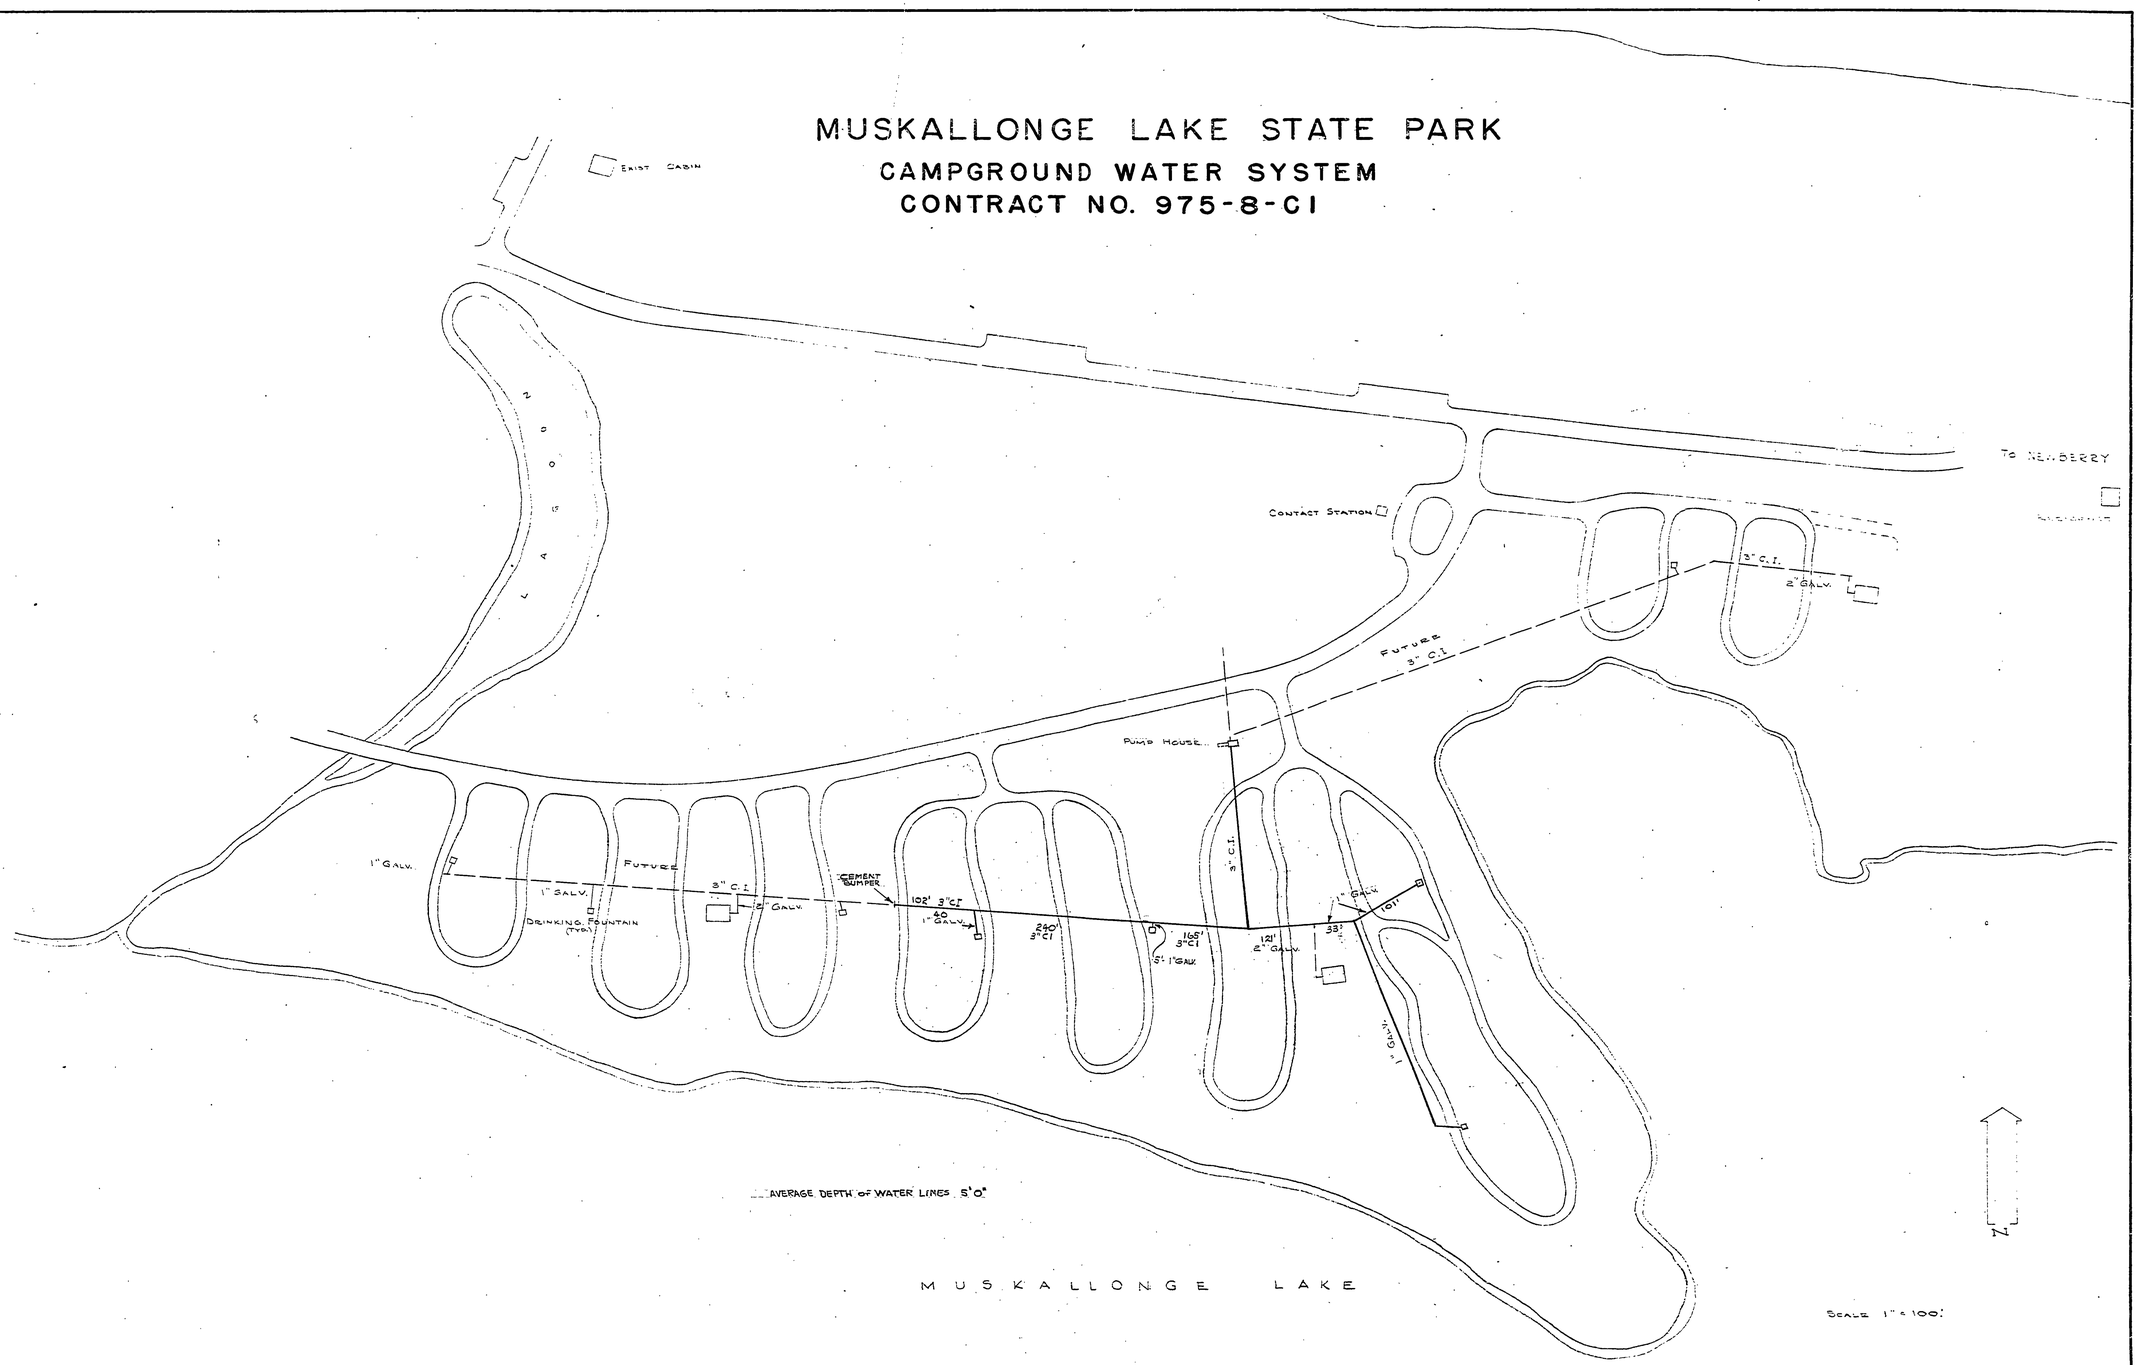

SEE L-103 FOR SHEETS 1-3

NO.	DATE	BY	REVISIONS
1	9-28-62	DEB	Brought up to date - dimensions
2			
3			
4			
5			
6			

	DATE	BY

		DATE
APPROVED		
Director, Department of Conservation		7-16-62
Chairman, State Parks and Recreation Commission		7-16-62

REVIEWED		DATE
ARCHITECTURAL	[illegible]	7-11-62
ENGINEERING	E. J. D.	7-12-62
LANDSCAPE	[illegible]	7-13-62

		DATE
DESIGNED BY		
DRAWN BY	J. TOMA	5-22-62
CHECKED BY	K.E.B.	7-11-62

MICHIGAN
DEPARTMENT OF CONSERVATION
PARKS AND RECREATION DIVISION

MUSKALLONGE LAKE STATE PARK
CAMPGROUND, SECTION 2
WATER DISTRIBUTION SYSTEM

SHEET NO. 4 OF 8

PLAN NO. E-102