OCE-ELLIOTT 2-72 49387

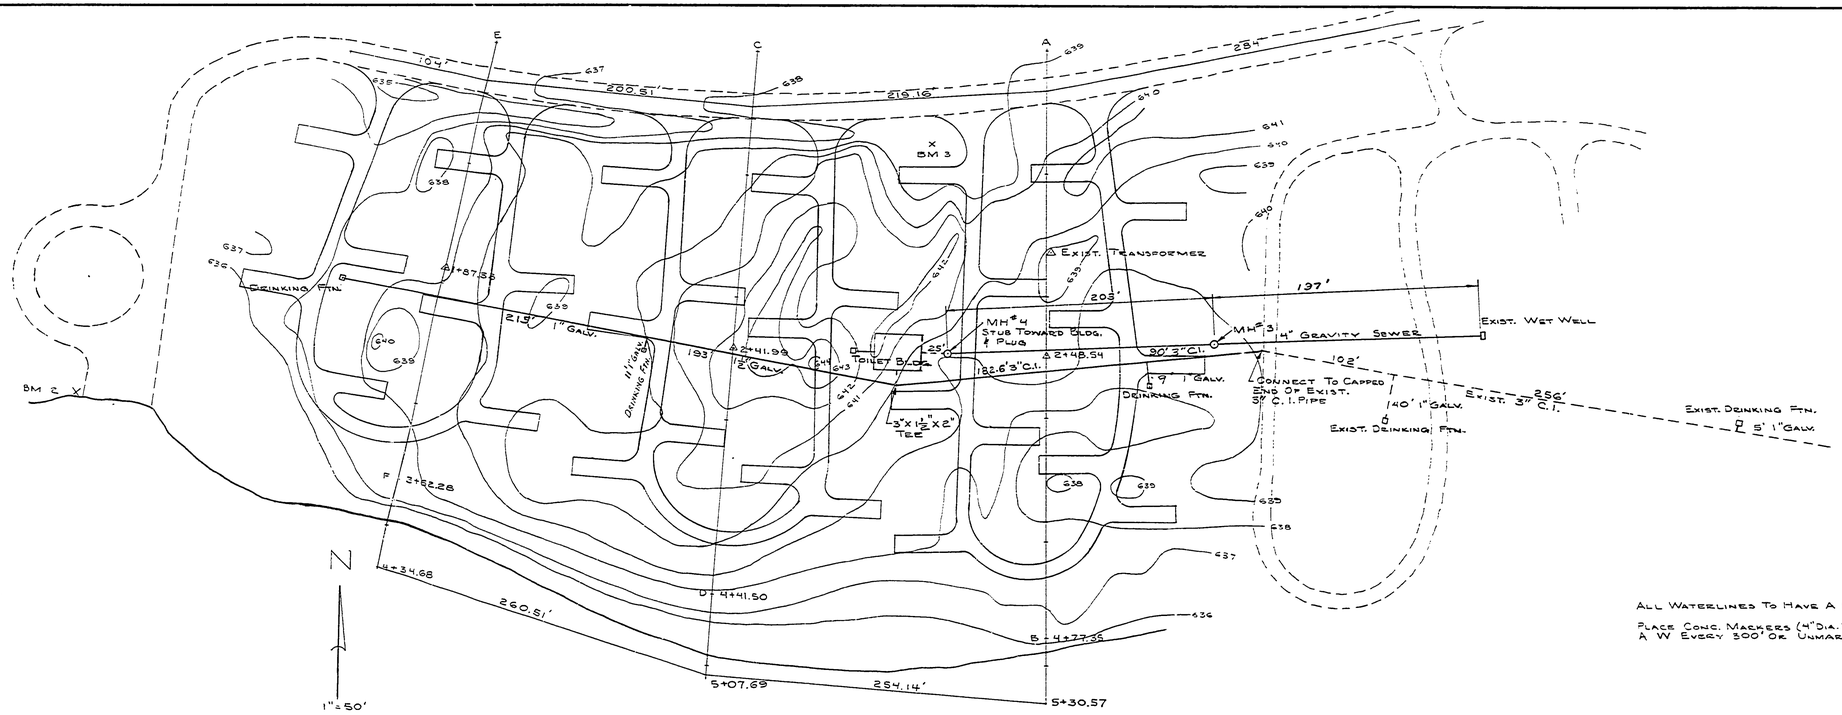

All Waterlines To Have A Minimum Of 4' Cover.

Place Conc. Markers (4" Dia. X 24" Long) Marked With A W Every 300' Or Unmarked Changes In Alignment.

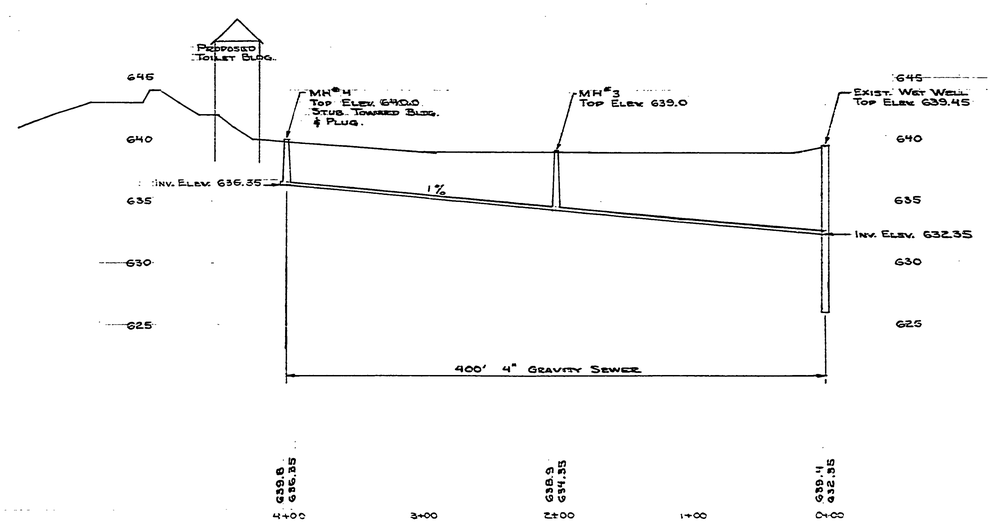

RE-[illegible]

SURVEYED BY		DRAWN BY J. YPMA	MAR. '74	NO.	DATE	BY	REVISIONS	NO.	DATE	BY	REVISIONS	MICHIGAN DEPARTMENT OF NATURAL RESOURCES	WATER & SEWAGE SYSTEMS
DESIGNED BY R. H. MERRILL	MAR. '74	CHECKED BY		1.	5-23-74	J.Y.	BOAT LAUNCH ADDED	3.	3/78	DDP	AS BUILT		
	DATE		DATE	2.	4-15-76	D.B.	MINOR	4.					

SHEET NO. 4 OF 6

FOR PROJECT NO. 34-1473

MUSKALLONGE LAKE STATE PARK

SHEET 4 OF 6 | PLAN NO. E-106