OCE-ELLIOTT 2-72 49871

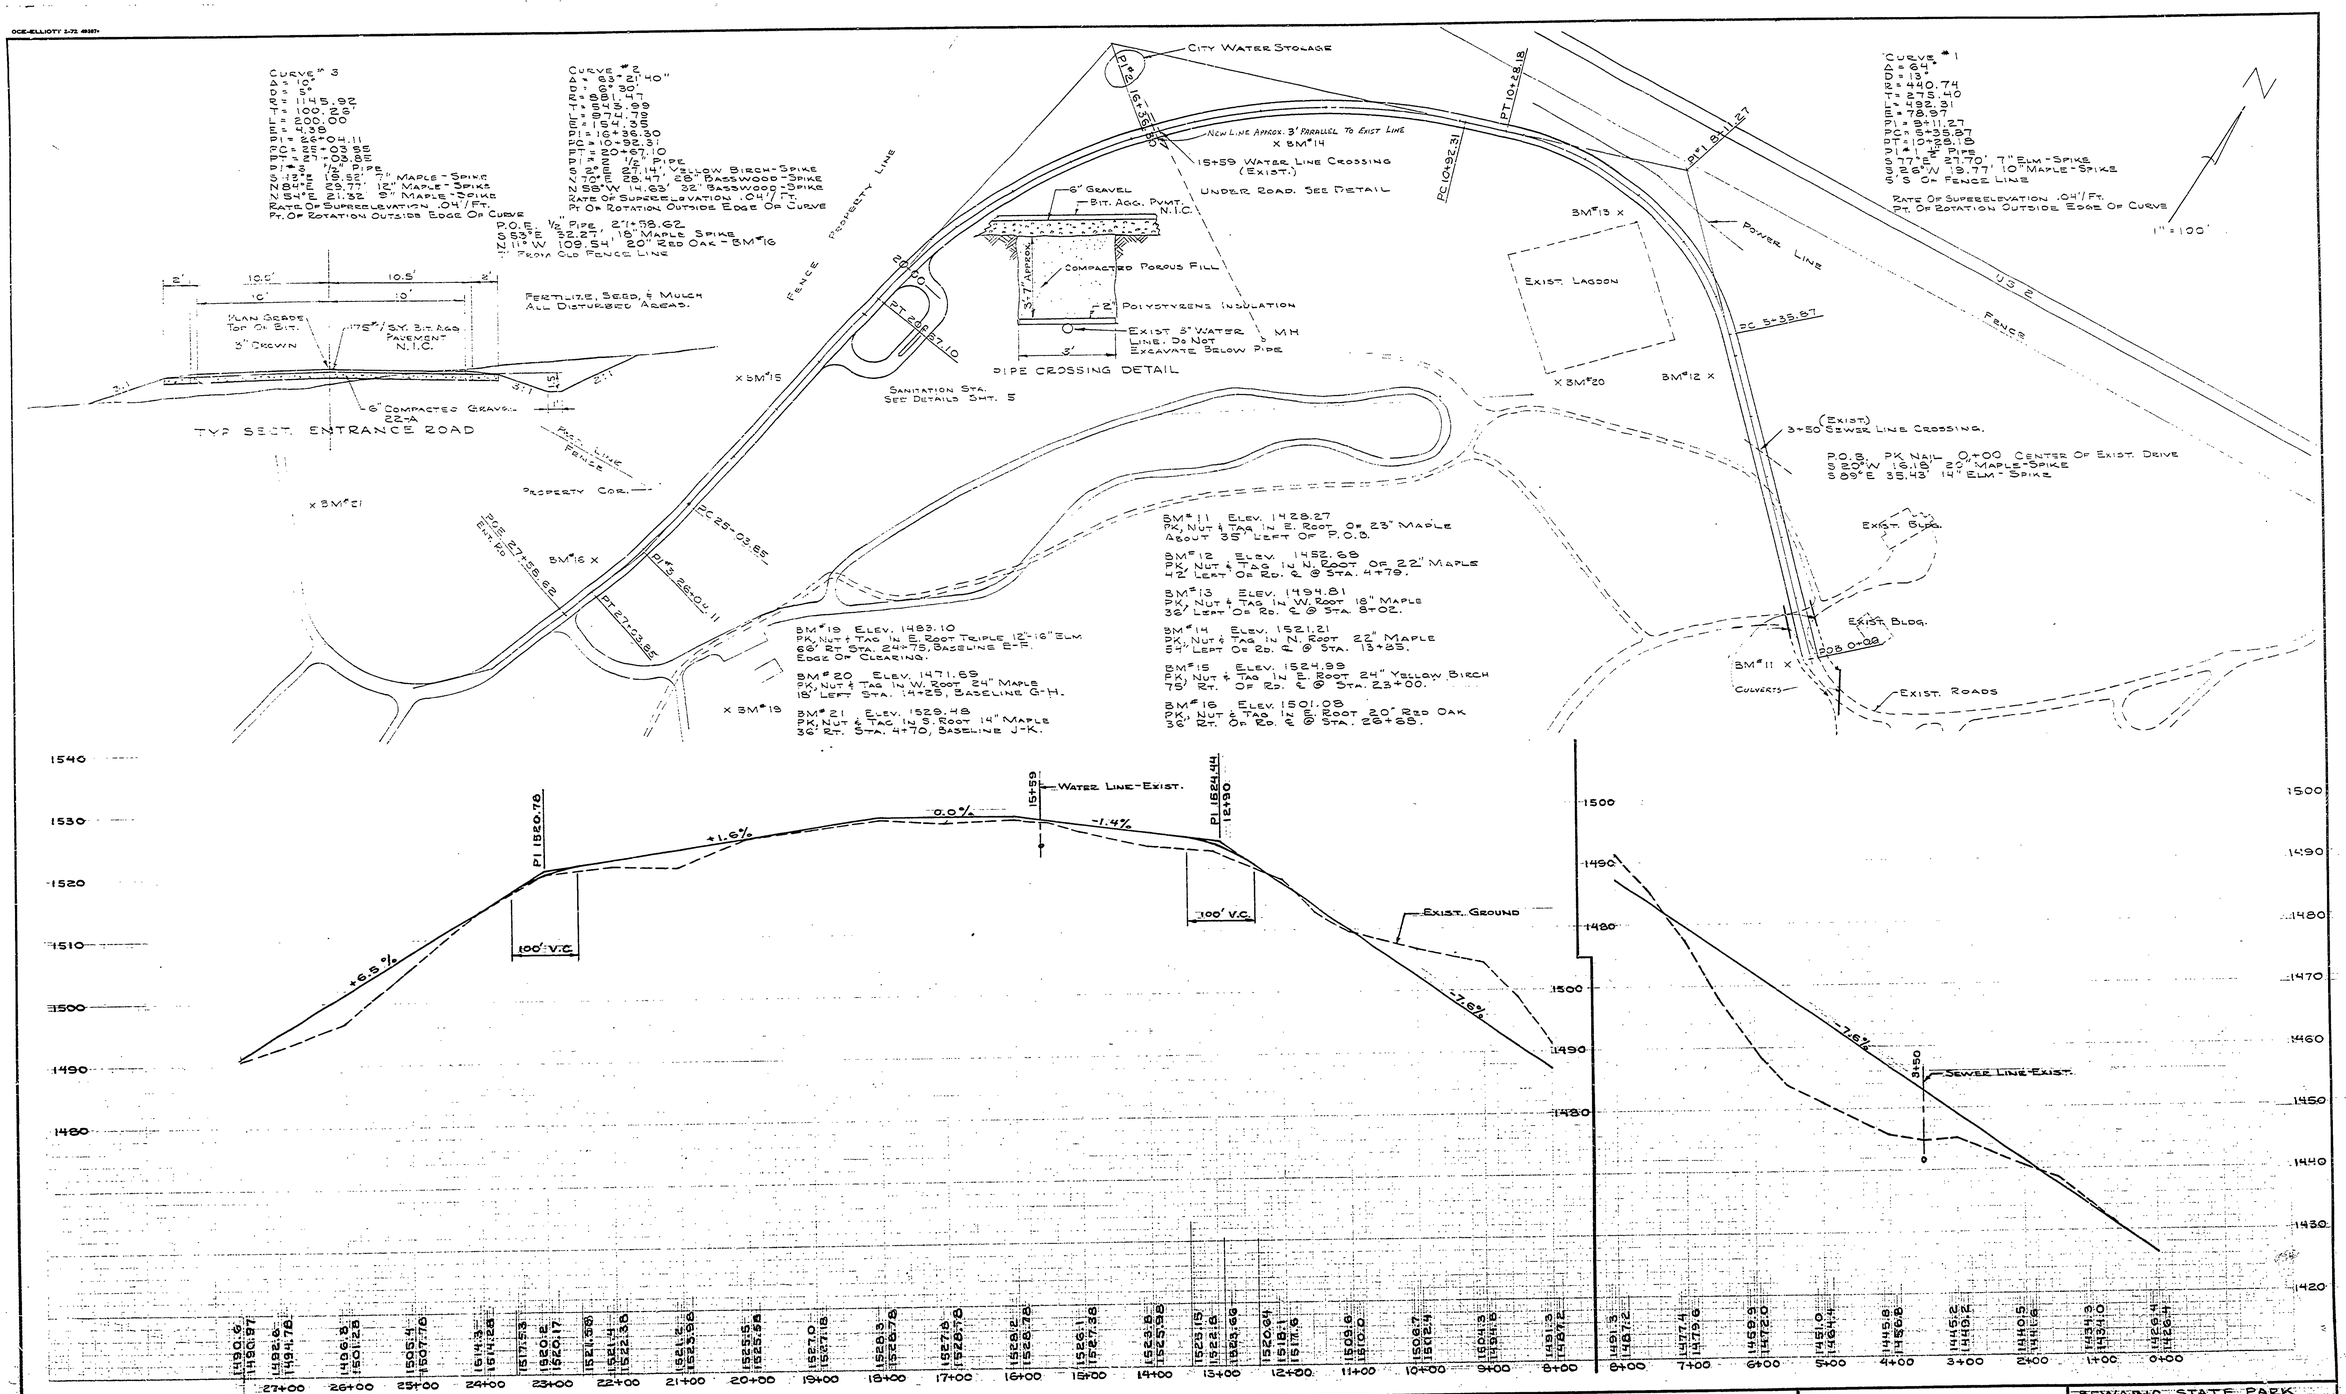

SURVEYED BY		DRAWN BY J. YPMA		NO.	DATE	BY	REVISIONS	NO.	DATE	BY	REVISIONS
DESIGNED BY R. H. MERRILL		CHECKED BY		1.	1-29-74	J.Y.	SAN. ST. MOVED TO STA. 20+00	3.			
	DATE		DATE	2.	5-5-76	D.B.	As Built	4.			

MICHIGAN
DEPARTMENT OF NATURAL RESOURCES

ENTRANCE ROAD

SHEET NO. ___ OF ___
FOR PROJECT NO. 24-1459

SEWABIC STATE PARK
SHEET 2 OF 9 PLAN NO. E-101