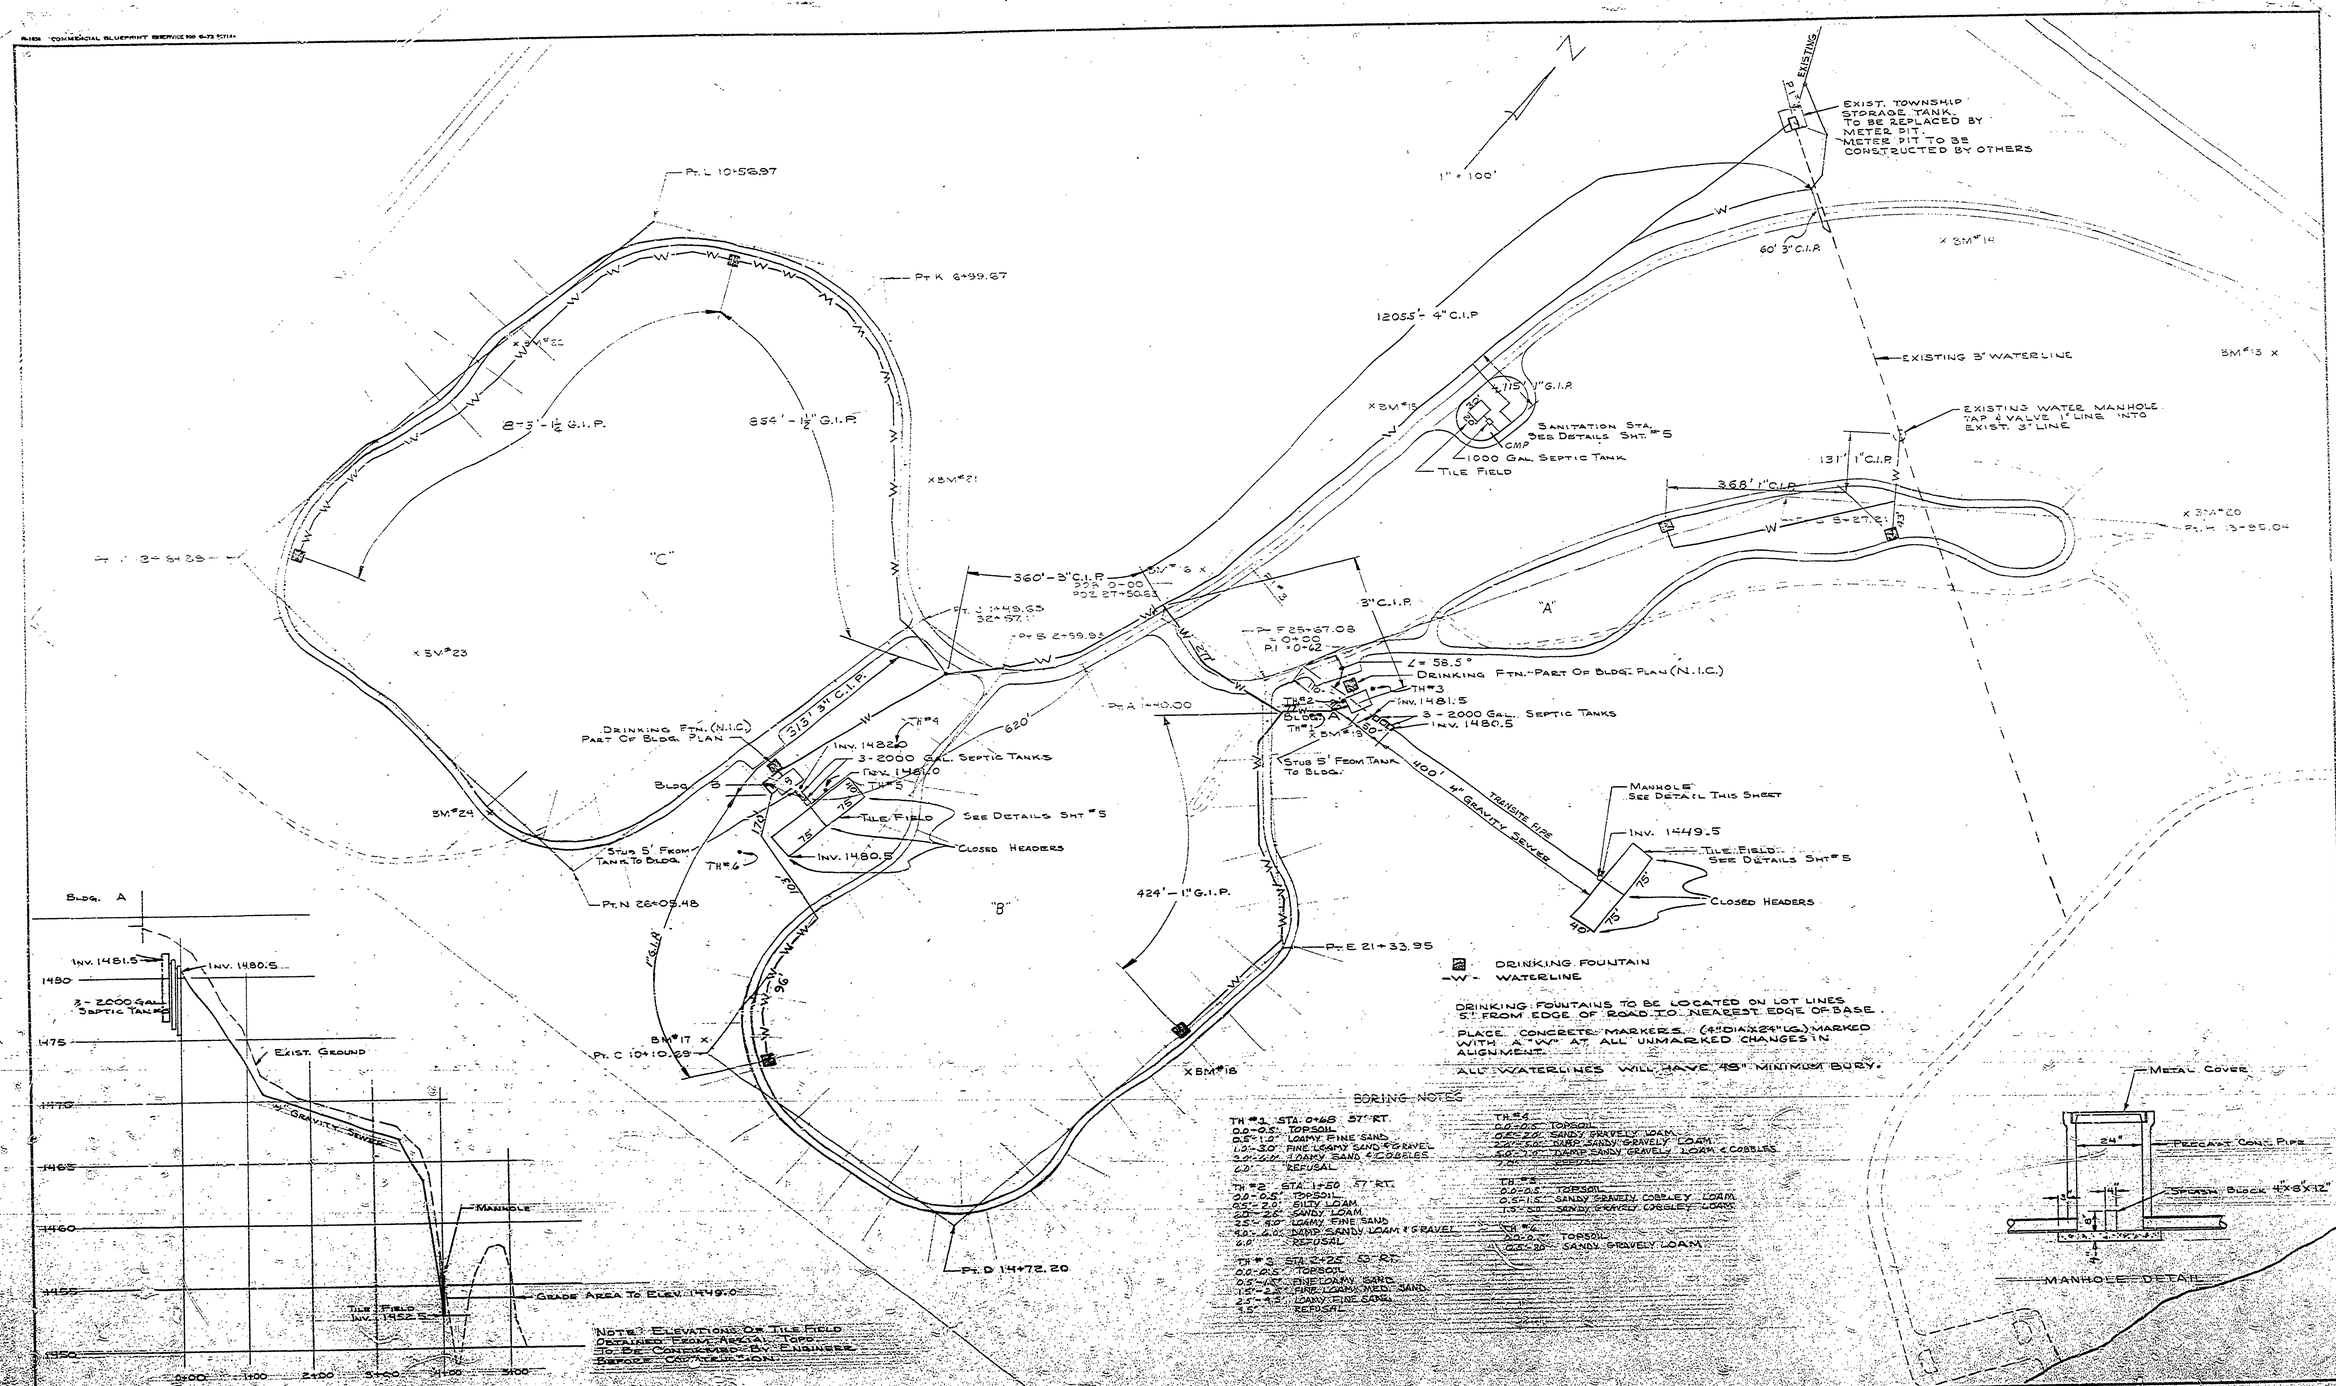

SURVEYED BY		DRAWN BY MITCH K.	9-21-76	NO.	DATE	BY	REVISIONS	NO.	DATE	BY	REVISIONS	MICHIGAN DEPARTMENT OF NATURAL RESOURCES	WATER SYSTEM + SEWAGE DISPOSAL SYSTEM	BEWABIC STATE PARK AREA OR PARK	PROJECT NO. 24-1959
DESIGNED BY H. MERRILL		CHECKED BY		1.	5-6-76	JRB	As Built	2.					SHEET TITLE	CAMPGROUND DEVELOPMENT PROJECT	SHEET 6 OF 9 PLAN NO. E-101
	DATE		DATE	3.				4.							