COMMERCIAL BLUEPRINT SERVICE 800 6-65

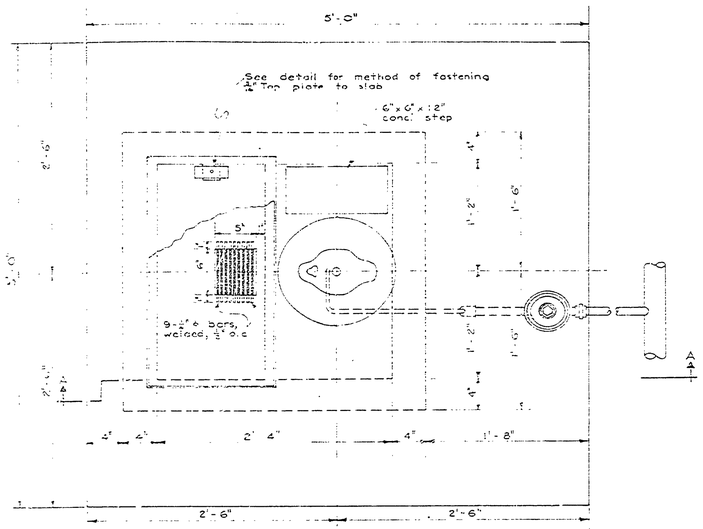

PLAN
1½" = 1'-0"

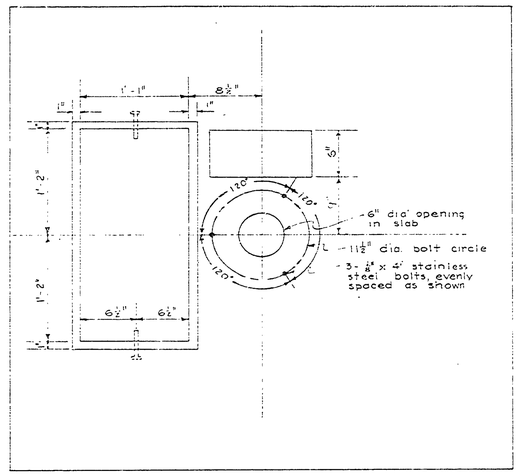

PLAN OF CONCRETE SLAB
1½" = 1'-0"

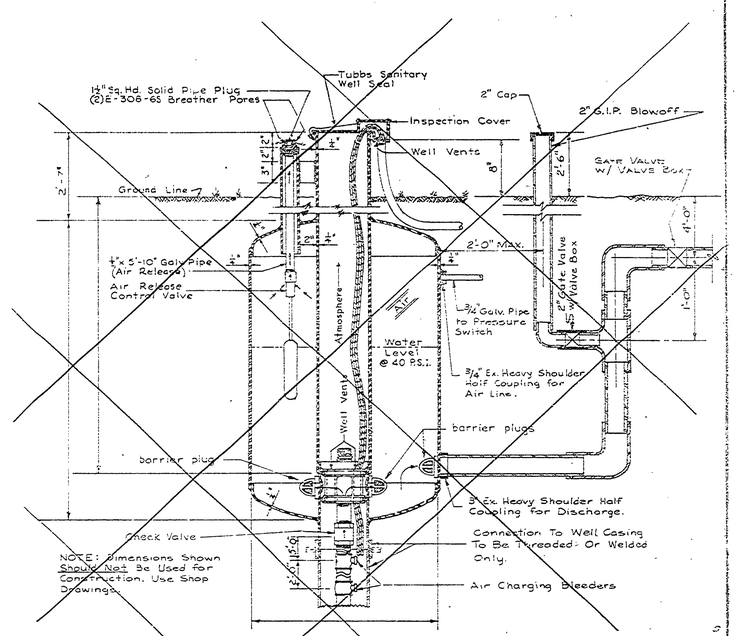

GALLON
PITLESS ADAPTER TANK
No Scale

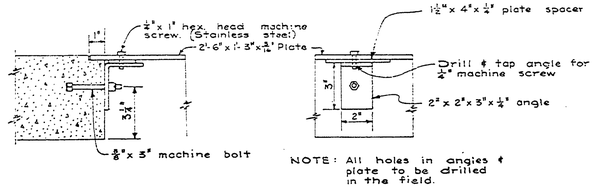

DETAIL FOR FASTENING GRATING TO CONCRETE SLAB
3" = 1'-0"

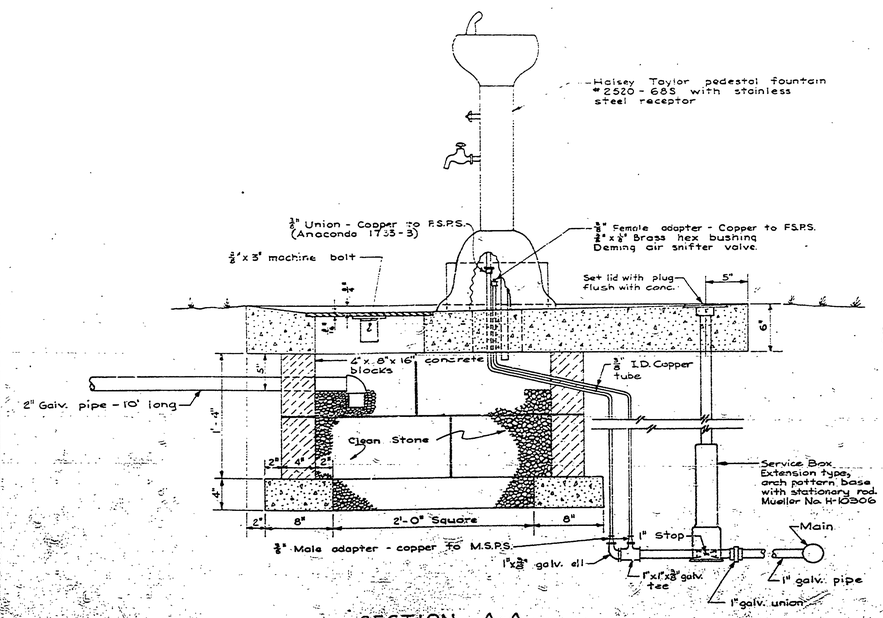

NOTE: Shut-off valve in service box. Open faucet on fountain and pump air through snifter valve for winter shut down.

SECTION A-A
1½" = 1'-0"

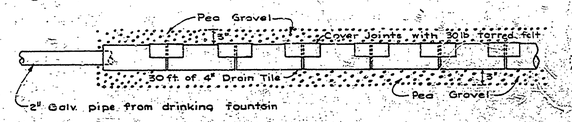

DETAIL OF TILE DRAIN

SURVEYED BY		DRAWN BY COTE	Sept '65	NO.	DATE	BY	REVISIONS	NO.	DATE	BY	REVISIONS	MICHIGAN DEPARTMENT OF CONSERVATION	DRINKING FOUNTAIN PLAN	SHEET NO. OF	BEWABIC STATE PARK
DESIGNED BY BARKER	Oct. '61	CHECKED BY W.H.E.	9-65	1.	6-69	H.L.R.	Extension Type Service Box in Slab	3.						FOR PROJECT NO. 29-1455	SHEET 7 OF 9 PROJ NO. E-101
	DATE		DATE	2.	6-69		Tank	4.							