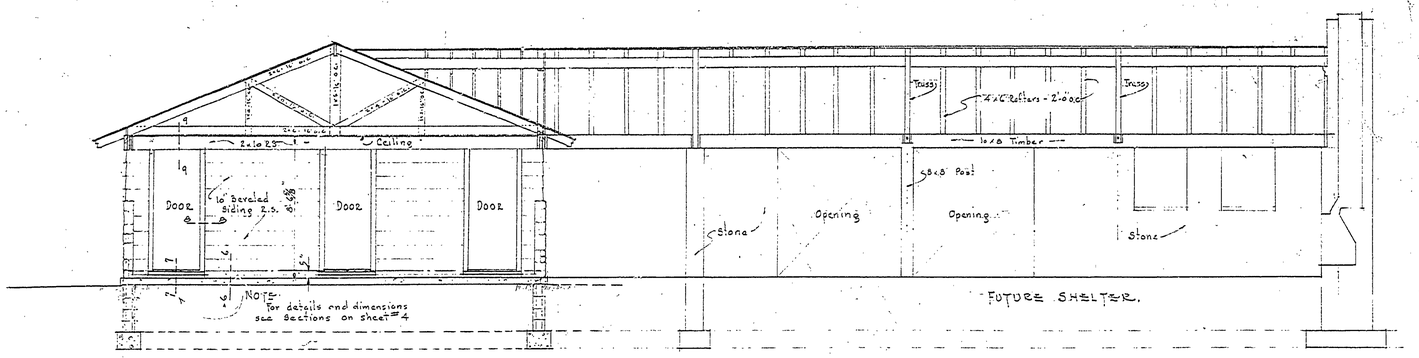

FUTURE SHELTER.

SECTION C-C
Scale 1/4" = 1'-0"

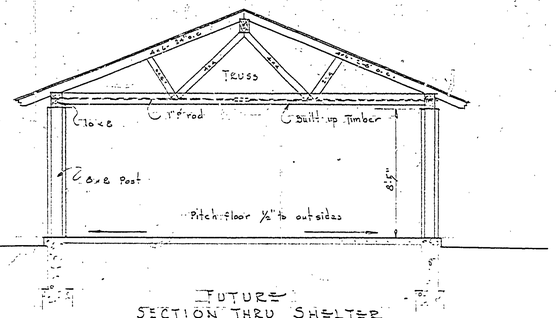

FUTURE
SECTION THRU SHELTER
Scale 1/4" = 1'-0"

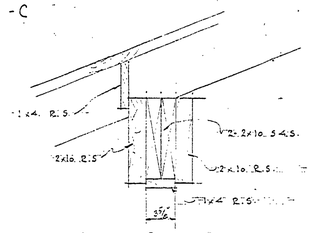

BEAM DETAIL
Scale 1 1/2" = 1'-0"

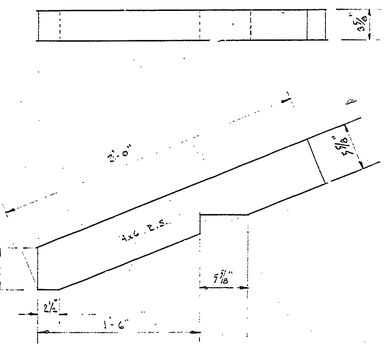

4x6 DUMMY RAFTER TAILS DETAIL
Scale 1 1/2" = 1'-0"

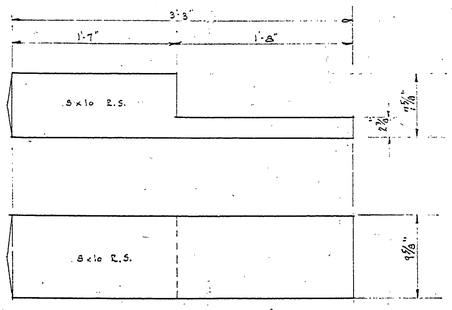

8 x 10 DUMMY LOOKOUT DETAIL
Scale 1 1/2" = 1'-0"

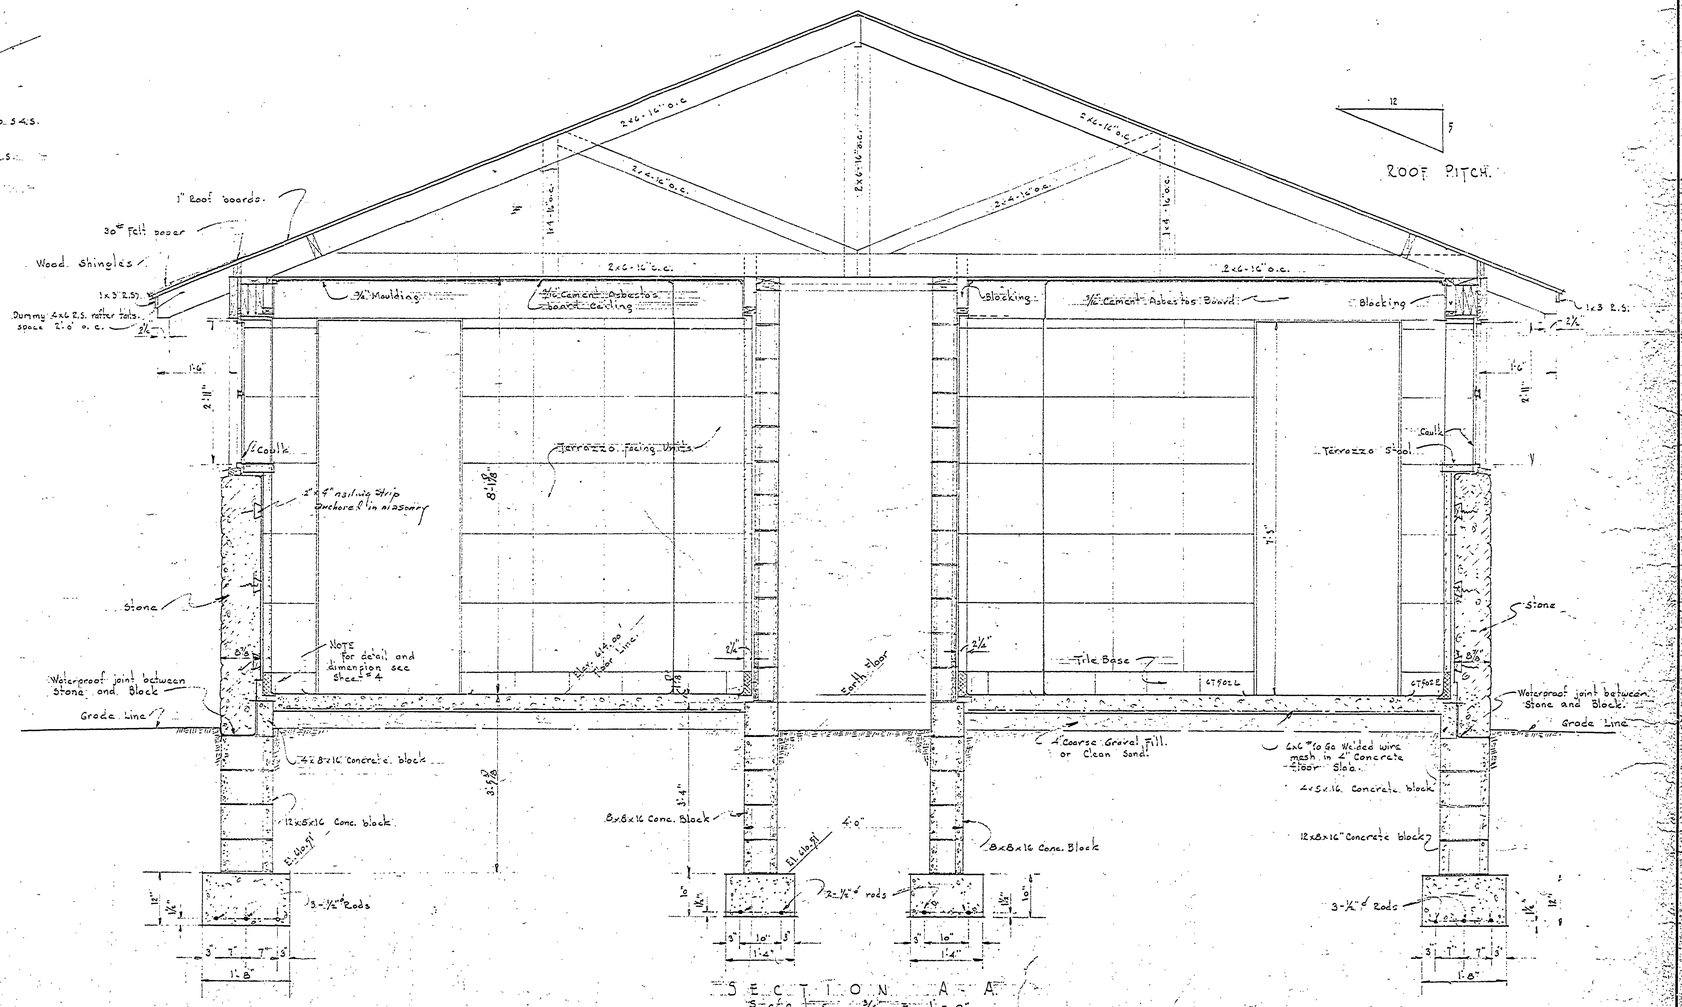

SECTION A-A
Scale 3/4" = 1'-0"

No.	DATE	BY	REVISIONS
1	2-3-54	J.T.R. J.W.F.	Change finish in toilet rooms from 3/4" Cement Asbestos Board to Terrazzo Facing Units
2			
3			
4			
5			
6			

		DATE	APPROVED BY	DATE
REVIEWED BY SECTIONS	ARCHITECTURAL	J.T.R. 1-21-53		
	ENGINEERING	H.C.M. 30 Jan 53	ASSISTANT CHIEF IN CHARGE OF DESIGN	5-22-53
	LANDSCAPE	J.T.R. 1-21-53		

DIVISION OF SUPERVISOR OF CREEK WORK
DRAWN BY J.W.F.
TRACED BY J.W.F.
CHECKED BY 1-20-53
DATE

MICHIGAN
DEPARTMENT OF CONSERVATION
PARKS AND RECREATION DIVISION

DRIMLEY STATE PARK
SHELTER, TOILET AND DRESSING COURTS.

SHEET NO. 4 OF 7

PLAN NO. A-103