
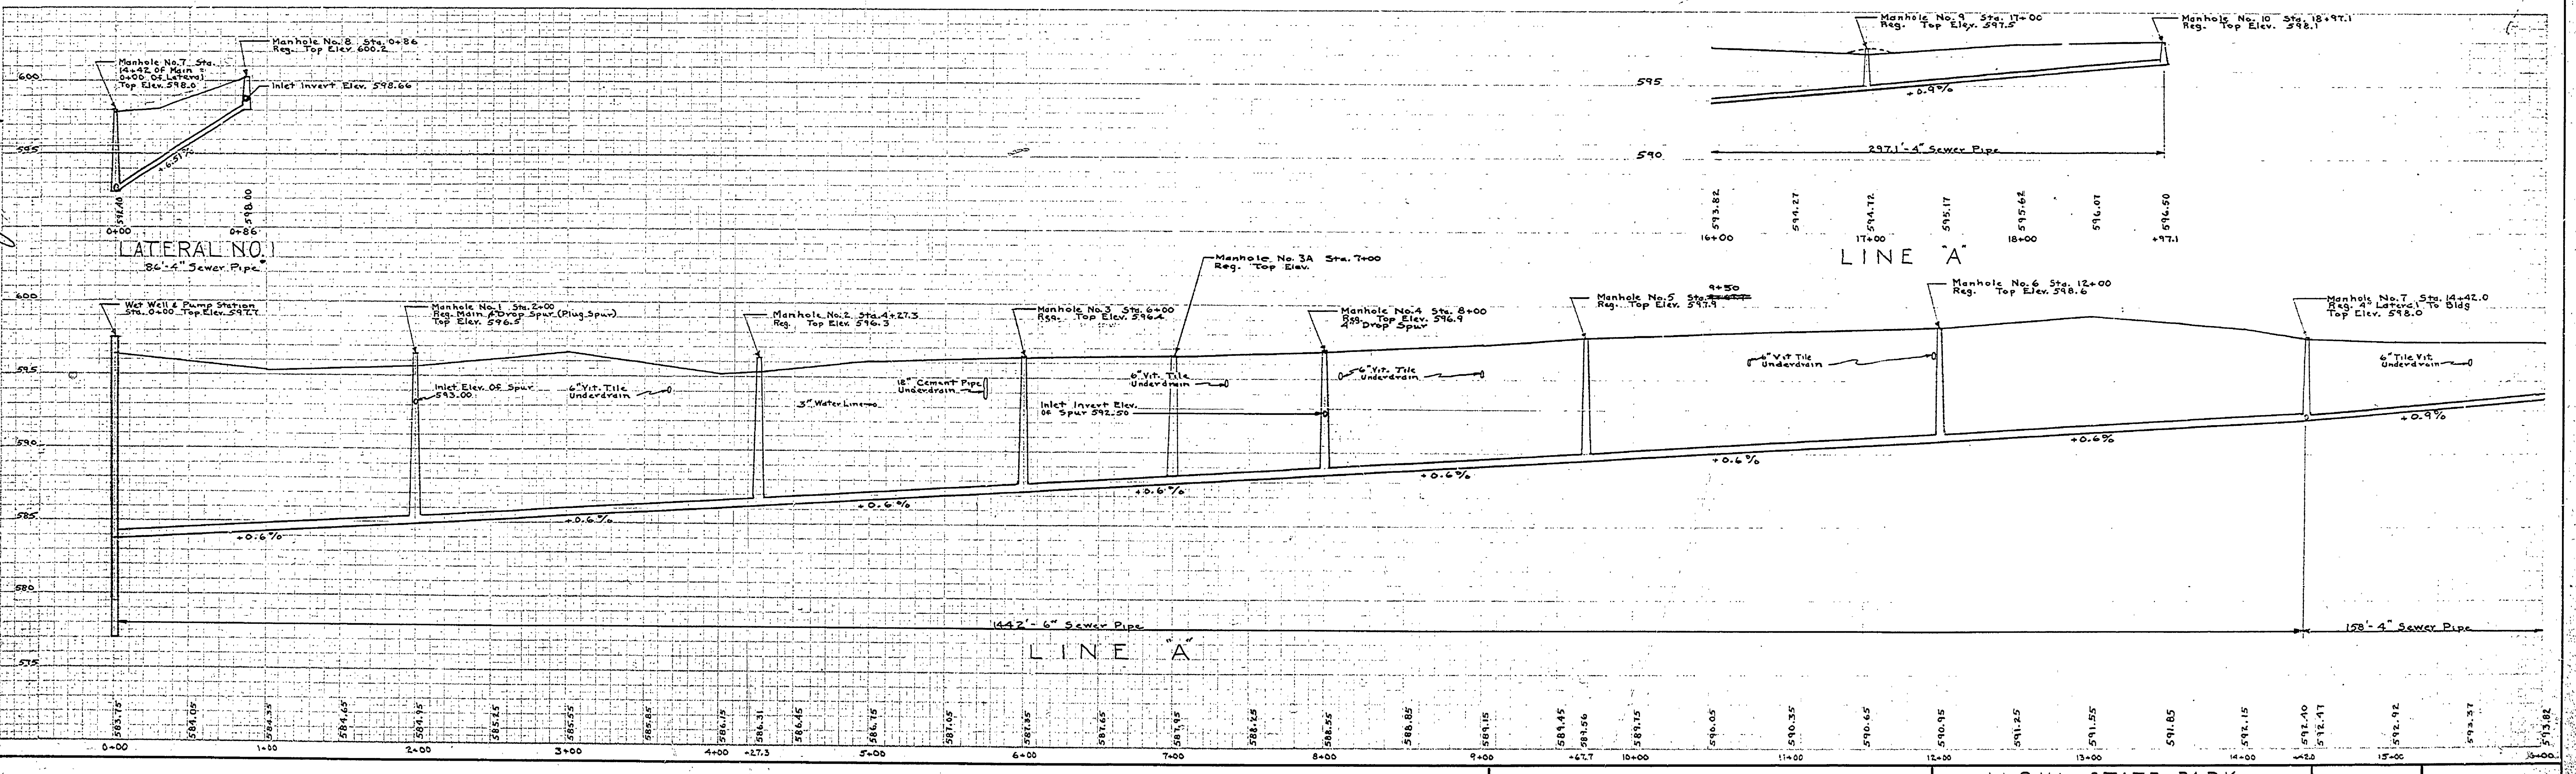


DESIGNED BY	B.H.G.	DATE	12-23-41	APPROVED	<i>[Signature]</i>
DRAWN BY	B.H.G.	REVIEWED	12-23-41	ARCHITECTURAL	<i>[Signature]</i>
CHECKED BY	E.V.P.	DATE	12-23-41	ENGINEERING	<i>[Signature]</i>
		DATE	12-23-41	LANDSCAPE	<i>[Signature]</i>

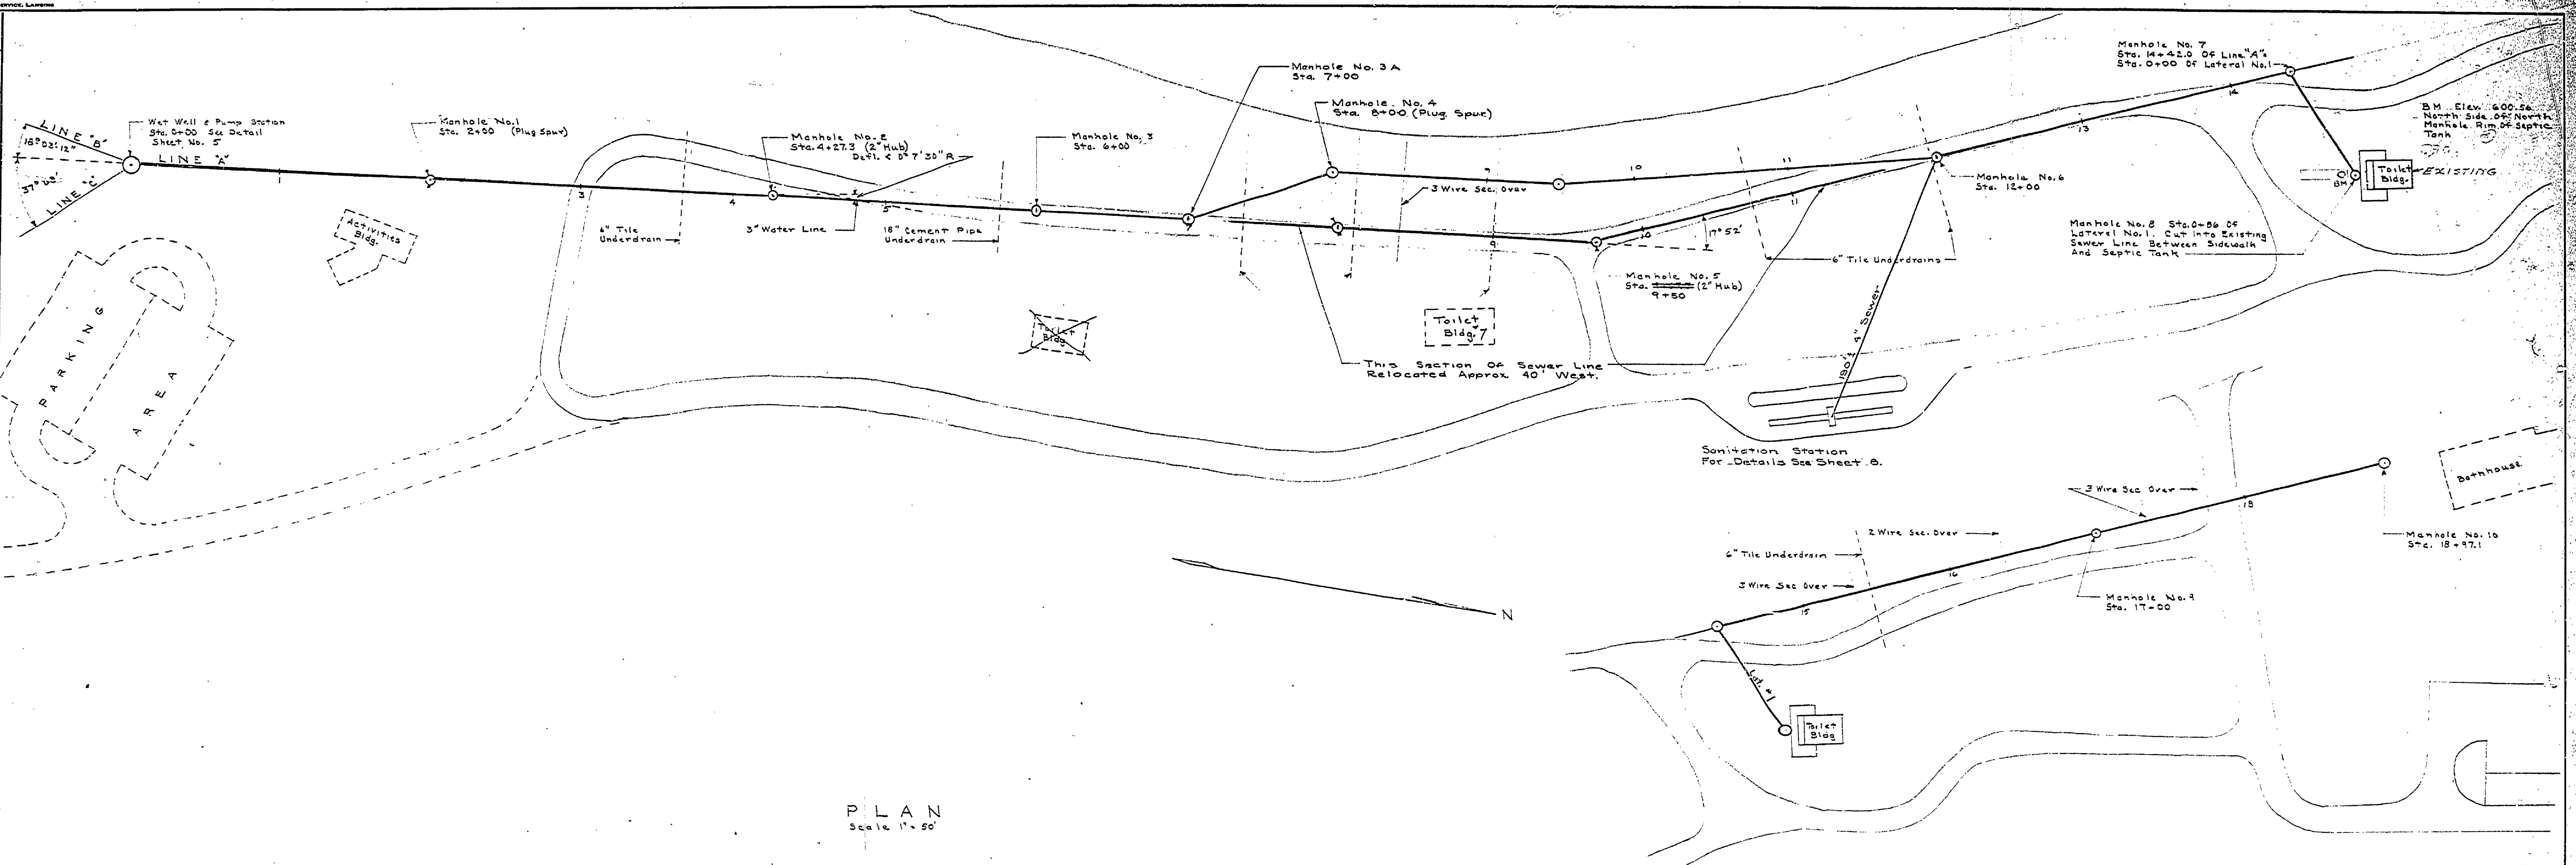

LINE A & LATERAL NO. 1
Scale: Hor. 1" = 50' Ver. 1" = 5'