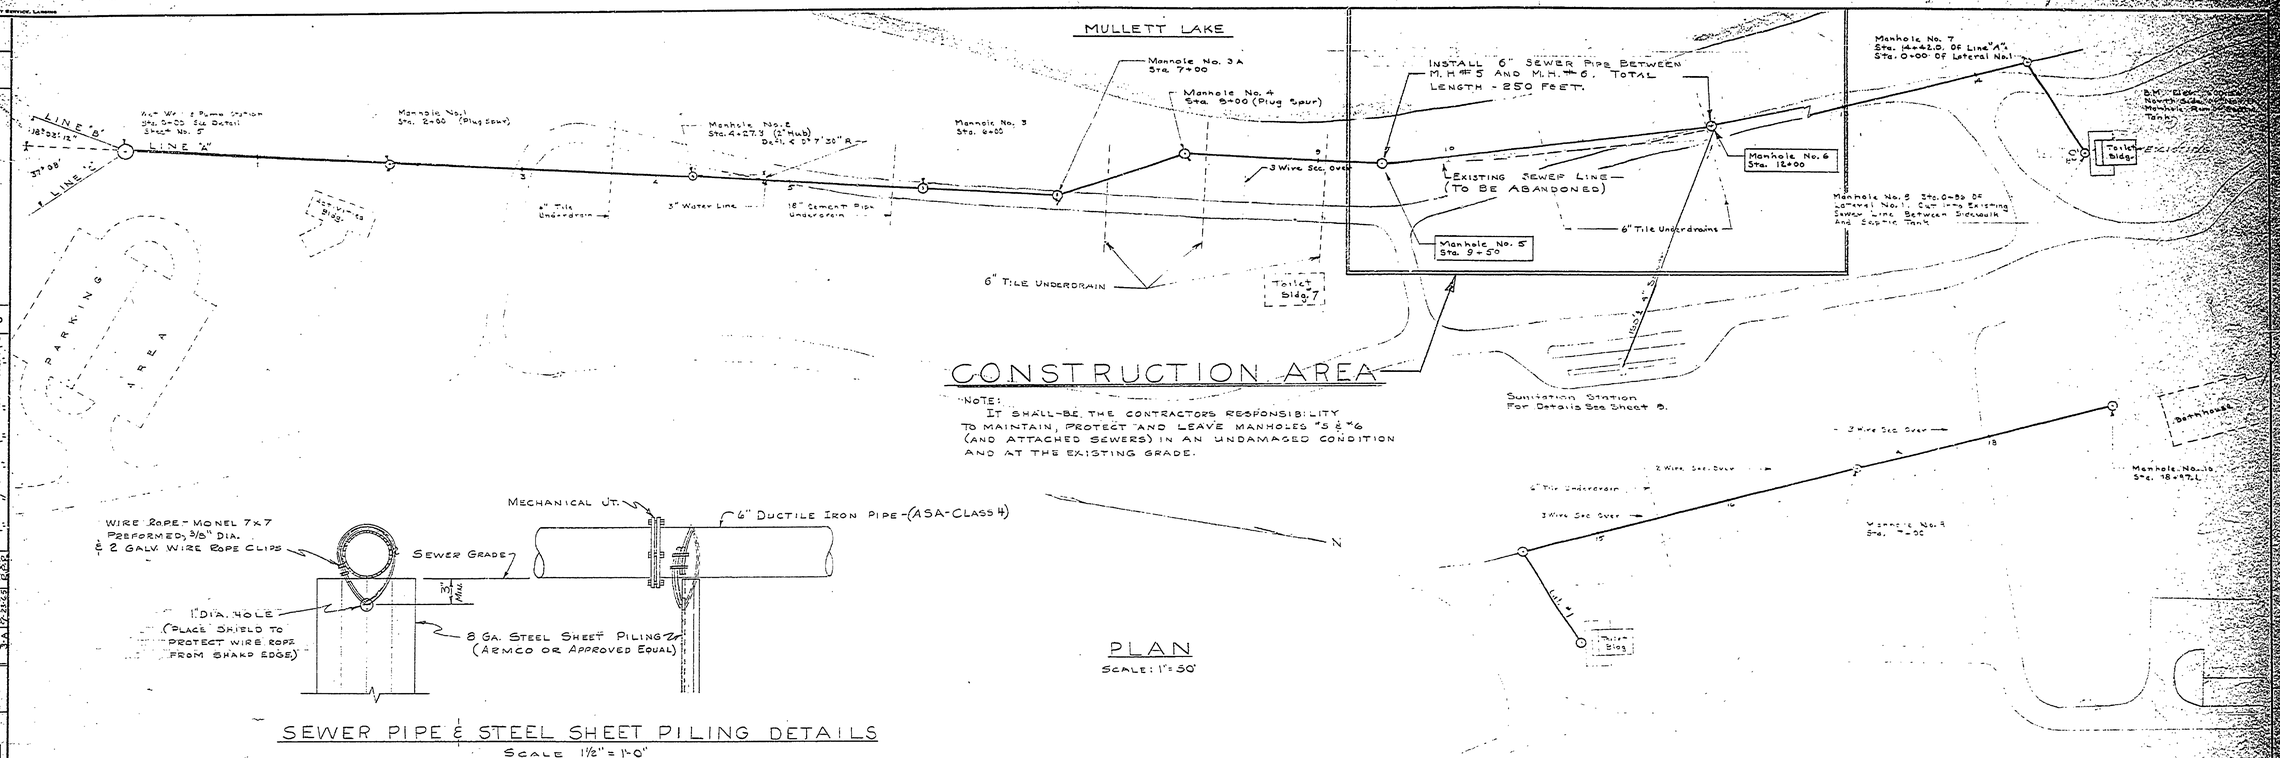

LINE "A" & LATERAL NO. 1
Scale: Hor. 1" = 50' Ver. 1" = 5'

MICHIGAN
DEPARTMENT OF CONSERVATION
PARKS AND RECREATION DIVISION

ALOHA STATE PARK
CENTRAL SEWAGE DISPOSAL SYSTEM
Scale: Hor. 1" = 50' Ver. 1" = 5'

SHEET NO. 2 OF 2

PLAN NO. 5-1904-2

REVISIONS

DATE	NO.	DATE	BY	
	1	10-21-64	J.Y.	Sewer Line Relocated
	2	1-23-64	J.Y.	Sanitation Station Added
	3	4-5-65	W.A.P.	Replace 6" Sewer Pipe Between M.H.'s #5 & #6
	3A	4-5-65	W.A.P.	
	4			
	5			
	6			

	DATE	
DESIGNED BY		
DRAWN BY		
CHECKED BY		
APPROVED		
REVIEWED	DATE	
ARCHITECTURAL		
ENGINEERING	9-23-63	A. G. Hansen
LANDSCAPE		
DATE	10/23/63	