FREDERICK POST CO. 173 300 12-55

1	WLP	8/14/57
2	TBP	9/13/57
3	TBP	9/11/57
4	TBP	9/11/57
5	TBP	9/11/57
6	WLP	9/11/57
7	TBP	9/11/57

Witnesses For Survey Points

(1) Found 3/4" pipe, 20" below pavement.
Set 3/4"x20" iron pipe over old pipe, even with surface.
S. 4°45'E., 33.03', 14" sq. conc. post, E edge, a chiseled arrow.
N. 55°15'W., 70.12', 14" sq. conc. post, SE edge, a chiseled arrow.
S. 66°E., 73.60', 20" Maple, SW. root, a vert. spike.

(33) Found 1/2" pipe at ℄ of Third St. as shown.

(18) Found 3/4" pipe at pavement surface.
S. 42°W., 47.78', N.W. corner cottage foundation.
N. 47°15'W., 79.61 S.E. corner cottage foundation.
N. 14°E., 19.26', power pole, E. side, horiz. spike.

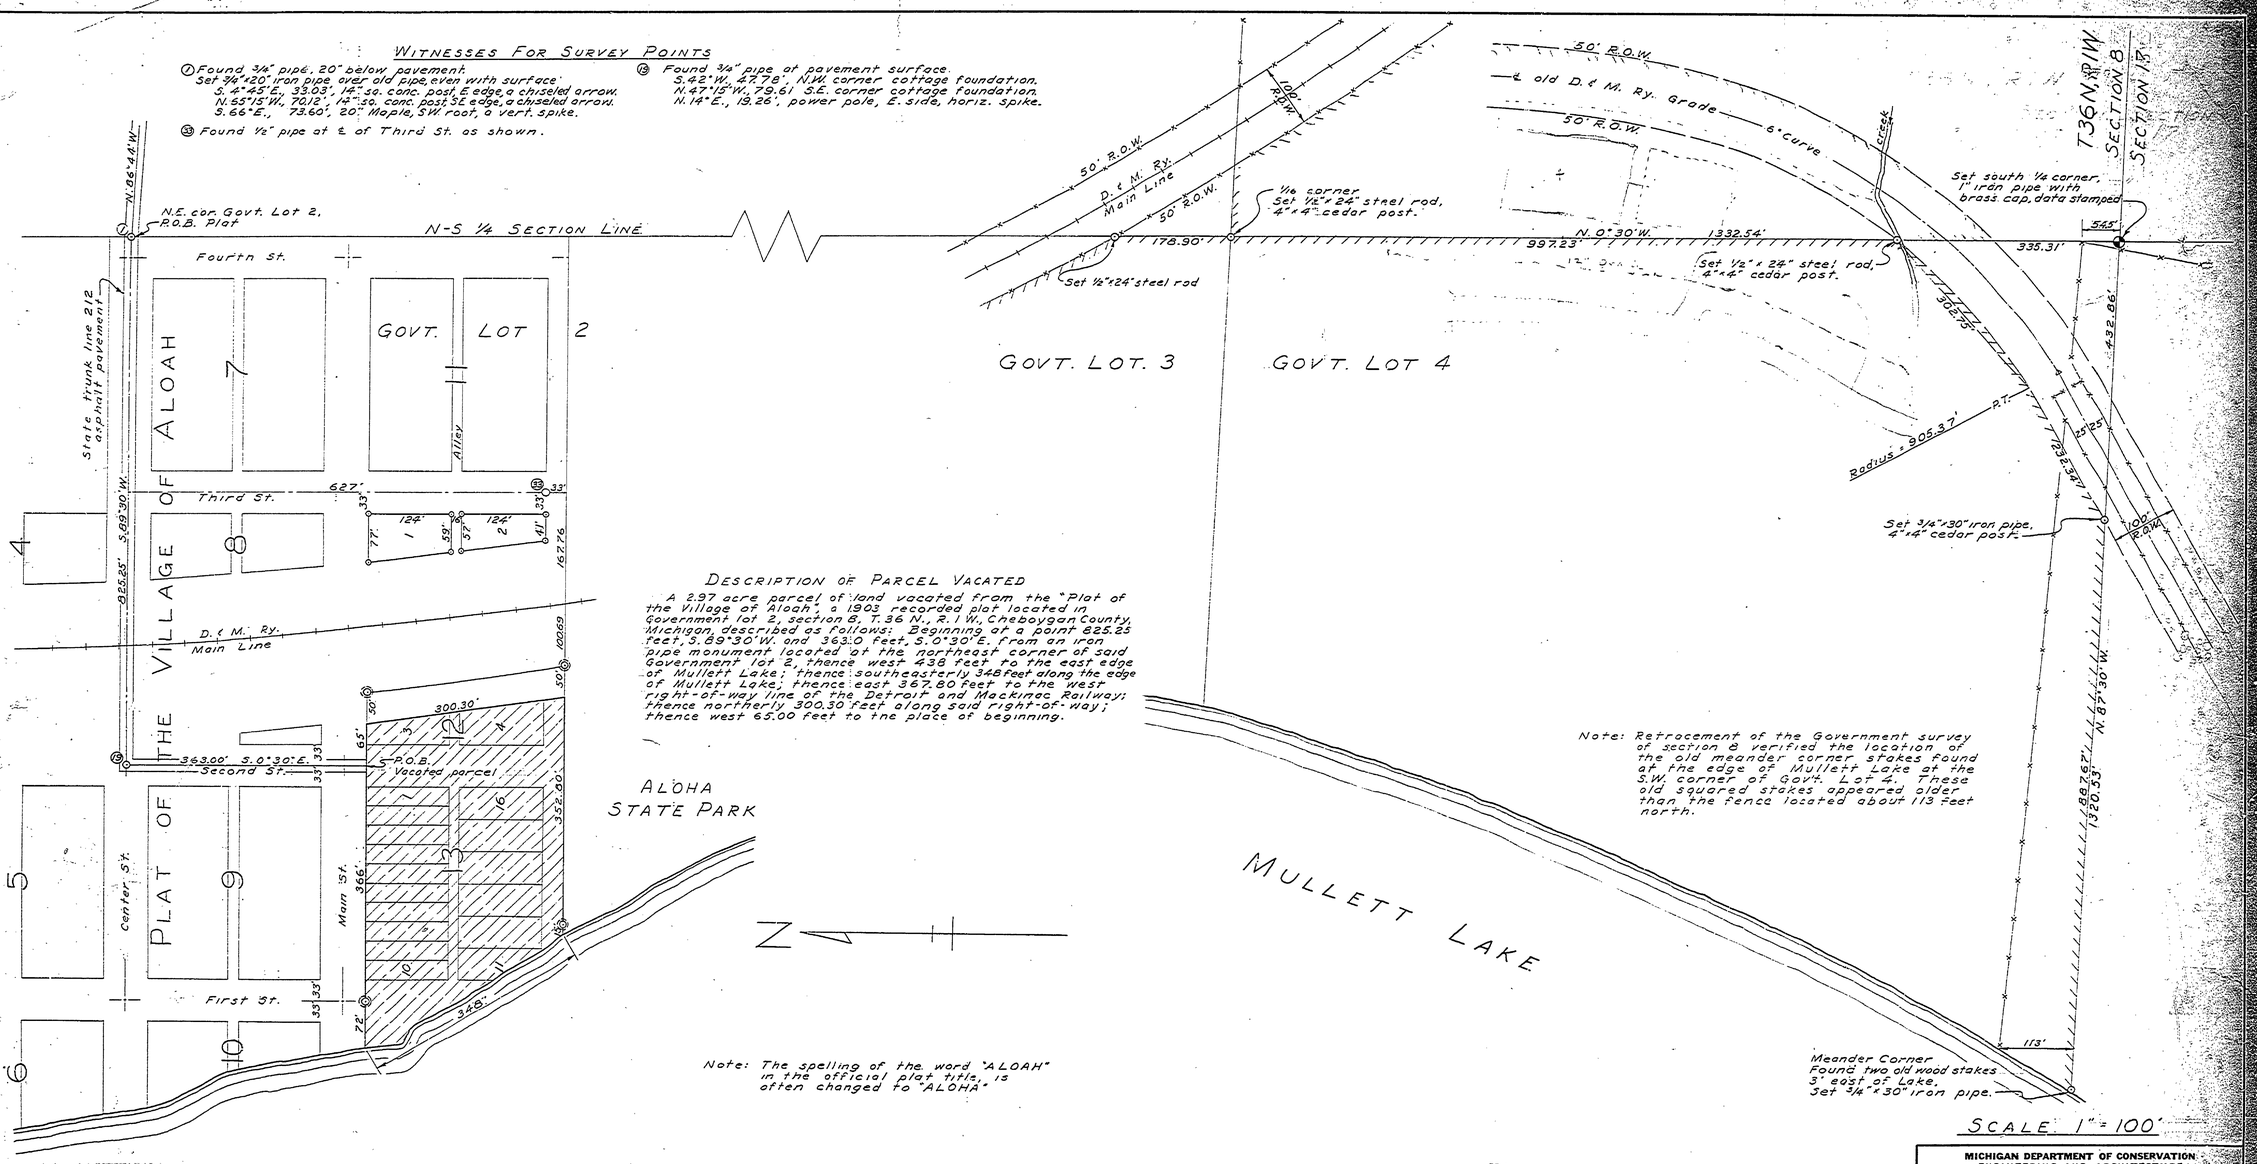

Description of Parcel Vacated

A 2.97 acre parcel of land vacated from the "Plat of the Village of Aloah", a 1903 recorded plat located in Government lot 2, section 8, T. 36 N., R. 1 W., Cheboygan County, Michigan, described as follows: Beginning at a point 825.25 feet, S. 89°30' W. and 363.0 feet, S. 0°30' E. from an iron pipe monument located at the northeast corner of said Government lot 2, thence west 438 feet to the east edge of Mullett Lake; thence southeasterly 348 feet along the edge of Mullett Lake; thence east 367.80 feet to the west right-of-way line of the Detroit and Mackinac Railway; thence northerly 300.30 feet along said right-of-way; thence west 65.00 feet to the place of beginning.

Note: The spelling of the word "ALOAH" in the official plat title, is often changed to "ALOHA"

Note: Retracement of the Government survey of section 8 verified the location of the old meander corner stakes found at the edge of Mullett Lake at the S.W. corner of Govt. Lot 4. These old squared stakes appeared older than the fence located about 113 feet north.

SCALE: 1" = 100'

Legend

- 1/4 section corner
- fence line
- edge of lake
- stream
- state owned land
- iron stake
- iron stake set in concrete

Witnesses For Survey Points

S. 1/4 Corner
Set 1" pipe with brass cap
N. 4° W., 6.45', 8" Aspen.
S. 86° E., 6.35', 3" Spruce.

Meander Corner, S.W. cor. Govt. Lot 4
Found two old wood stakes
Set 3/4" x 30" iron pipe
N. 75° E., 4.84', 10" Cedar, blaze.
S. 11° W., 7.94', 14" Spruce, blaze.
S. 36° E., 5.55', 14" Spruce, blaze.

This is to certify that in July, 1957, I made a survey of the tract delineated hereon and that it is drawn in accordance with the field notes of said survey.

Wilson Paddison
Registered Land Surveyor

MICHIGAN DEPARTMENT OF CONSERVATION
ENGINEERING AND ARCHITECTURE
ADMINISTRATIVE SERVICES

ALOHA STATE PARK BOUNDRY SURVEY
SURVEY MAP
PARKS DIVISION — CHEBOYGAN COUNTY

APPROVED	W. T. Davis 9-23-57 (ENGINEER IN CHARGE, DATE)		PLAN X-16A-1
APPROVED	(CHIEF OF SPONSORING DIVISION, DATE)		SHEET 1 OF 1
APPROVED	Anthony J. Hermes 9/23/57 (REG. PROF. ENGINEER SPONSORING, DATE)		
SURVEYED BY	W.L. PADDISON	7-57	REVISED
DESIGNED BY			
DRAWN BY	E.V. McCANN	8-57	
CHECKED BY	(NAME, DATE)		

X-16A

E-106