


DESIGNED BY	DATE	REVIEWED	DATE	APPROVED	DATE	NO.	DATE	BY	REVISIONS	DATE	BY
Y.P.M.A. & E.M.S.	6-65	ARCHITECTURAL				1			4		
CHECKED BY		ENGINEERING				2			5		
		LANDSCAPE				3			6		

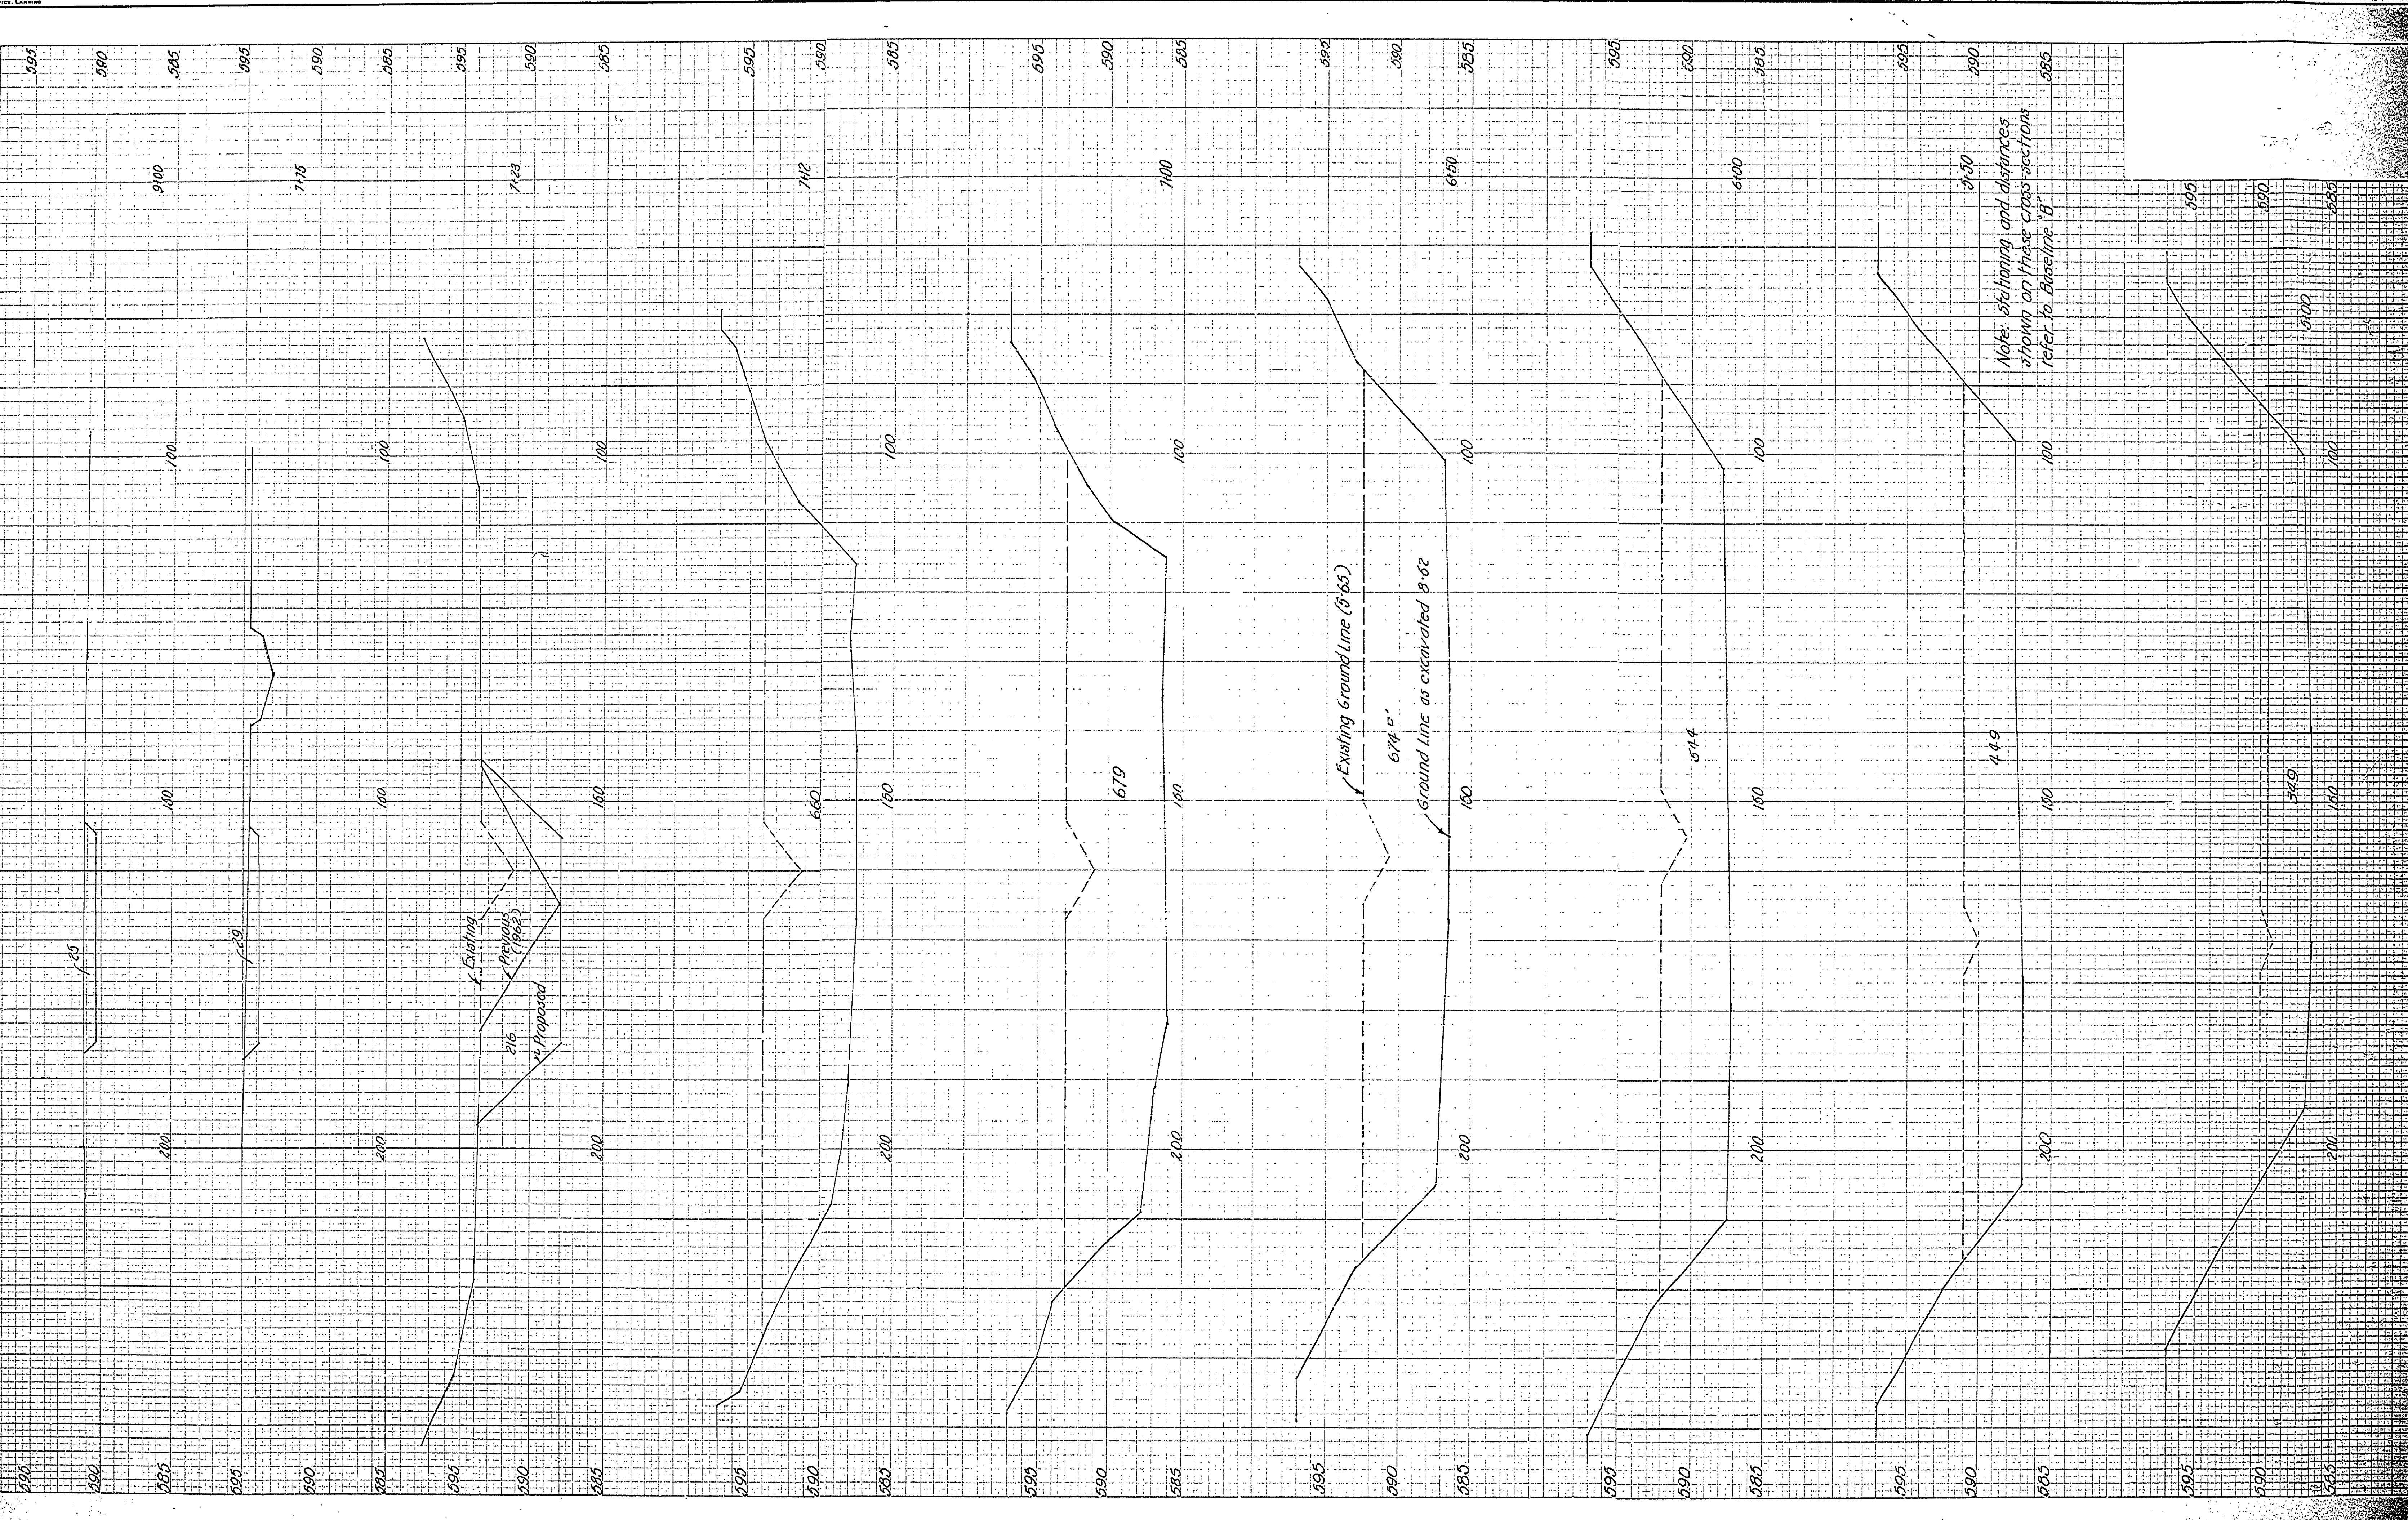

MICHIGAN
DEPARTMENT OF CONSERVATION
PARKS AND RECREATION DIVISION

ALOHA STATE PARK
BOATING FACILITIES
CROSS-SECTIONS OF BOAT BASIN

SHEET
NO. 4
OF 4

PLANNING
JUL 67