


DESIGNED BY	DATE	REVIEWED	DATE	APPROVED	DATE	NO.	DATE	BY
DRAWN BY		ARCHITECTURAL				1		
CHECKED BY		ENGINEERING				2		
		LANDSCAPE				3		
						4		
						5		
						6		

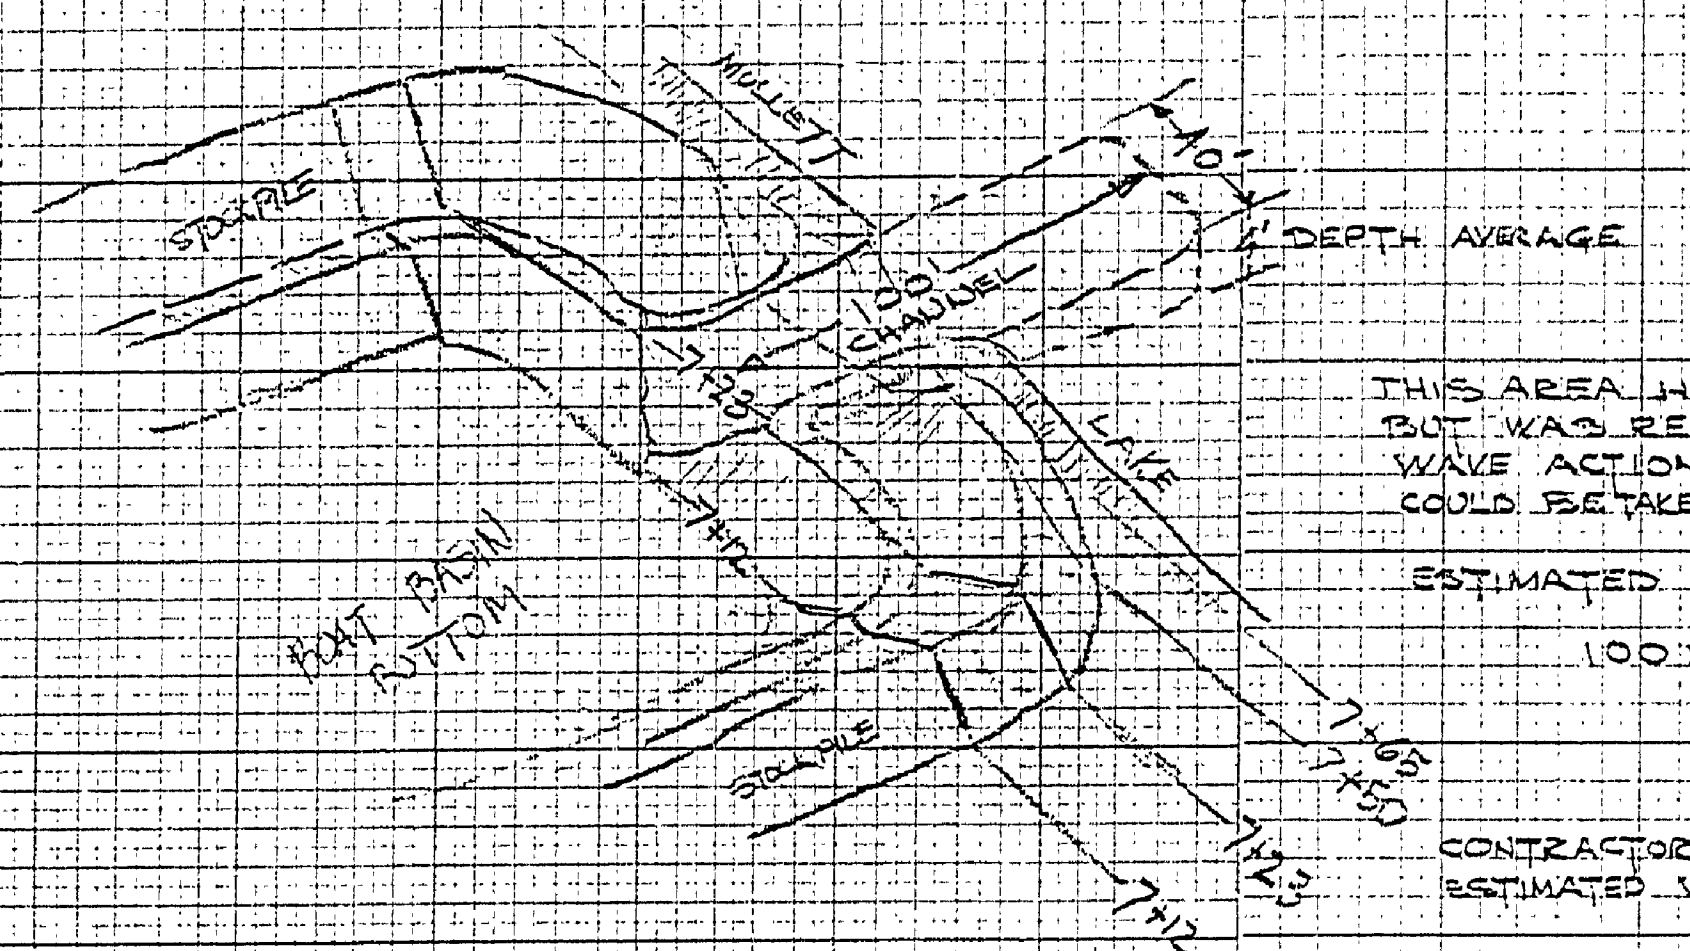

ESTIMATED VOLUME FOR CHANNEL
 $100 \times 4.0 \times 4' = 16,000 \text{ SQ FT}$
 $\frac{16,000}{27} = 593 \text{ CORDS}$
 CONTRACTOR MEAD AGREED WITH ESTIMATED VOLUME FIGURES

