


DESIGNED BY	E. J. V.
DRAWN BY	E. J. V.
CHECKED BY	
DATE	
REVIEWED	ARCHITECTURAL ENGINEERING LANDSCAPE
DATE	
APPROVED	
DATE	
NO.	1
DATE	
NO.	2
DATE	
NO.	3
DATE	
NO.	4
DATE	
NO.	5
DATE	
NO.	6
DATE	

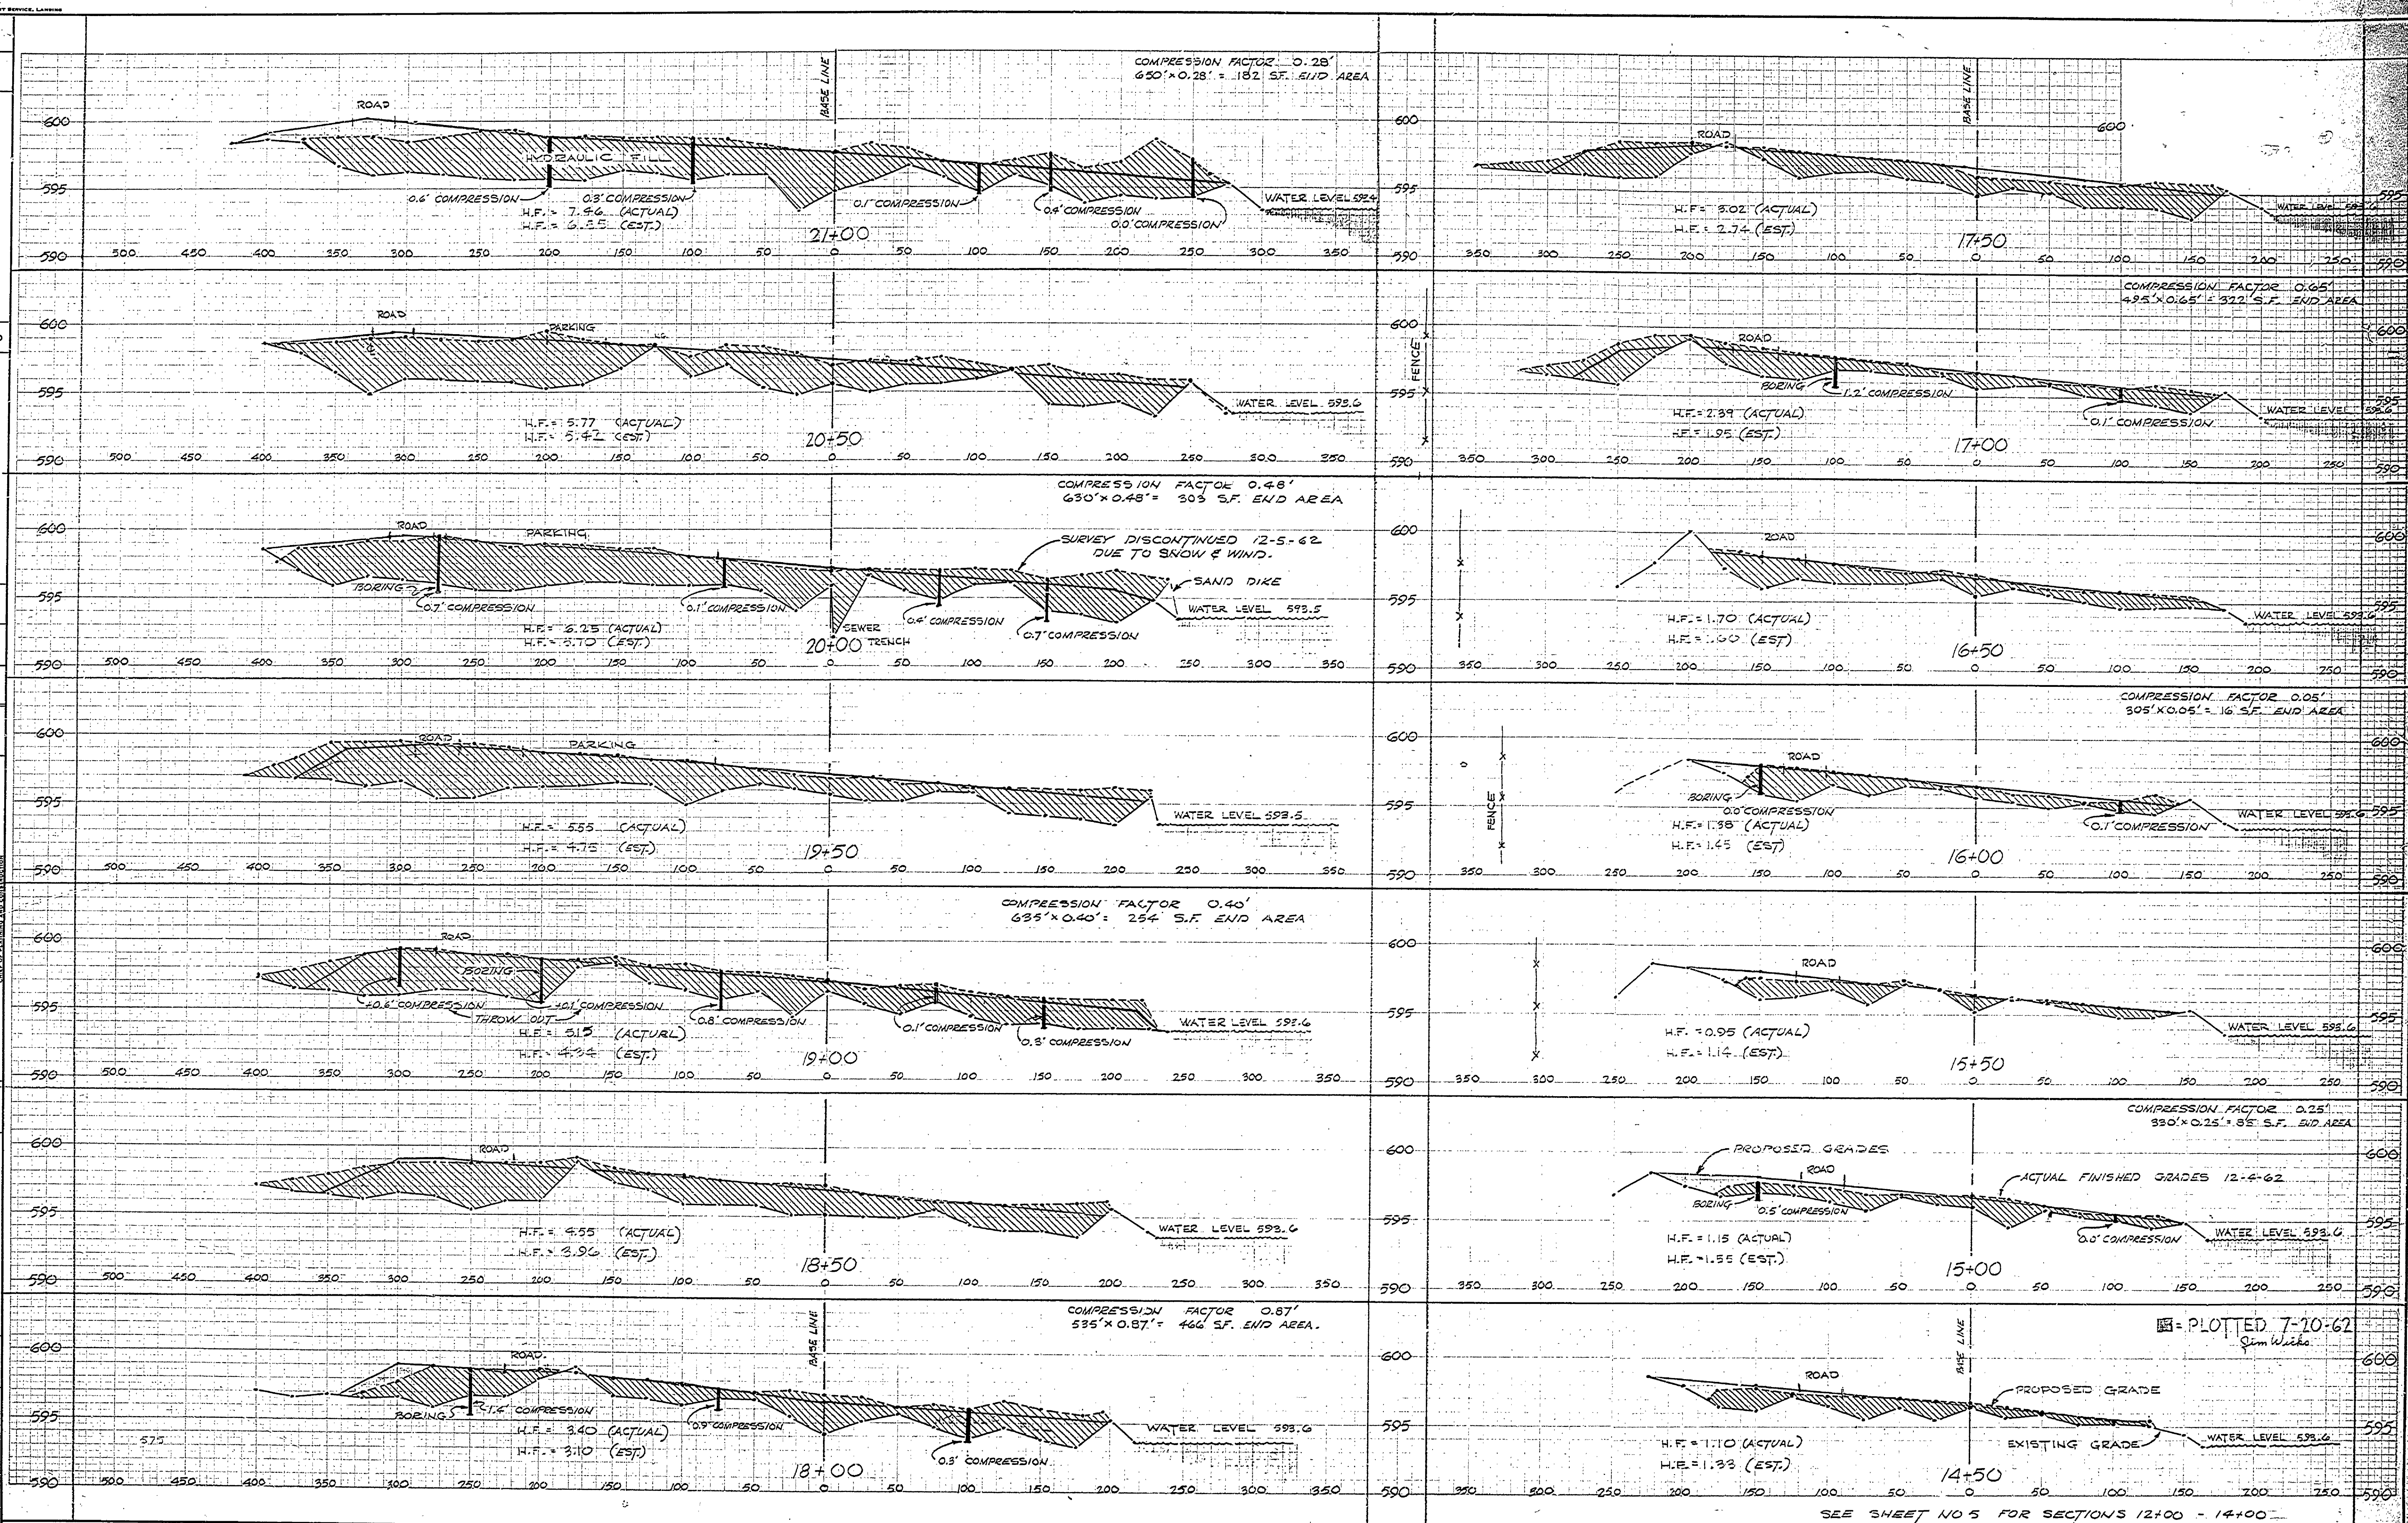

SCALE
VERT. 1" = 5'
HORIZ. 1" = 50'

MICHIGAN
DEPARTMENT OF CONSERVATION
PARKS AND RECREATION DIVISION

ALOHA STATE PARK
HYDRAULIC EXCAVATION MEASUREMENT
CAMPGROUND CROSS SECTIONS

SHEET NO. 1
OF 5
PLAN NO. WORK SHEET