


DESIGNED BY	F. J. W.
DRAWN BY	F. J. W.
CHECKED BY	
REVIEWED	ARCHITECTURAL ENGINEERING LANDSCAPE
DATE	
APPROVED	
DATE	
NO.	1
DATE	
NO.	2
DATE	
NO.	3
DATE	
NO.	4
DATE	
NO.	5
DATE	
NO.	6
DATE	

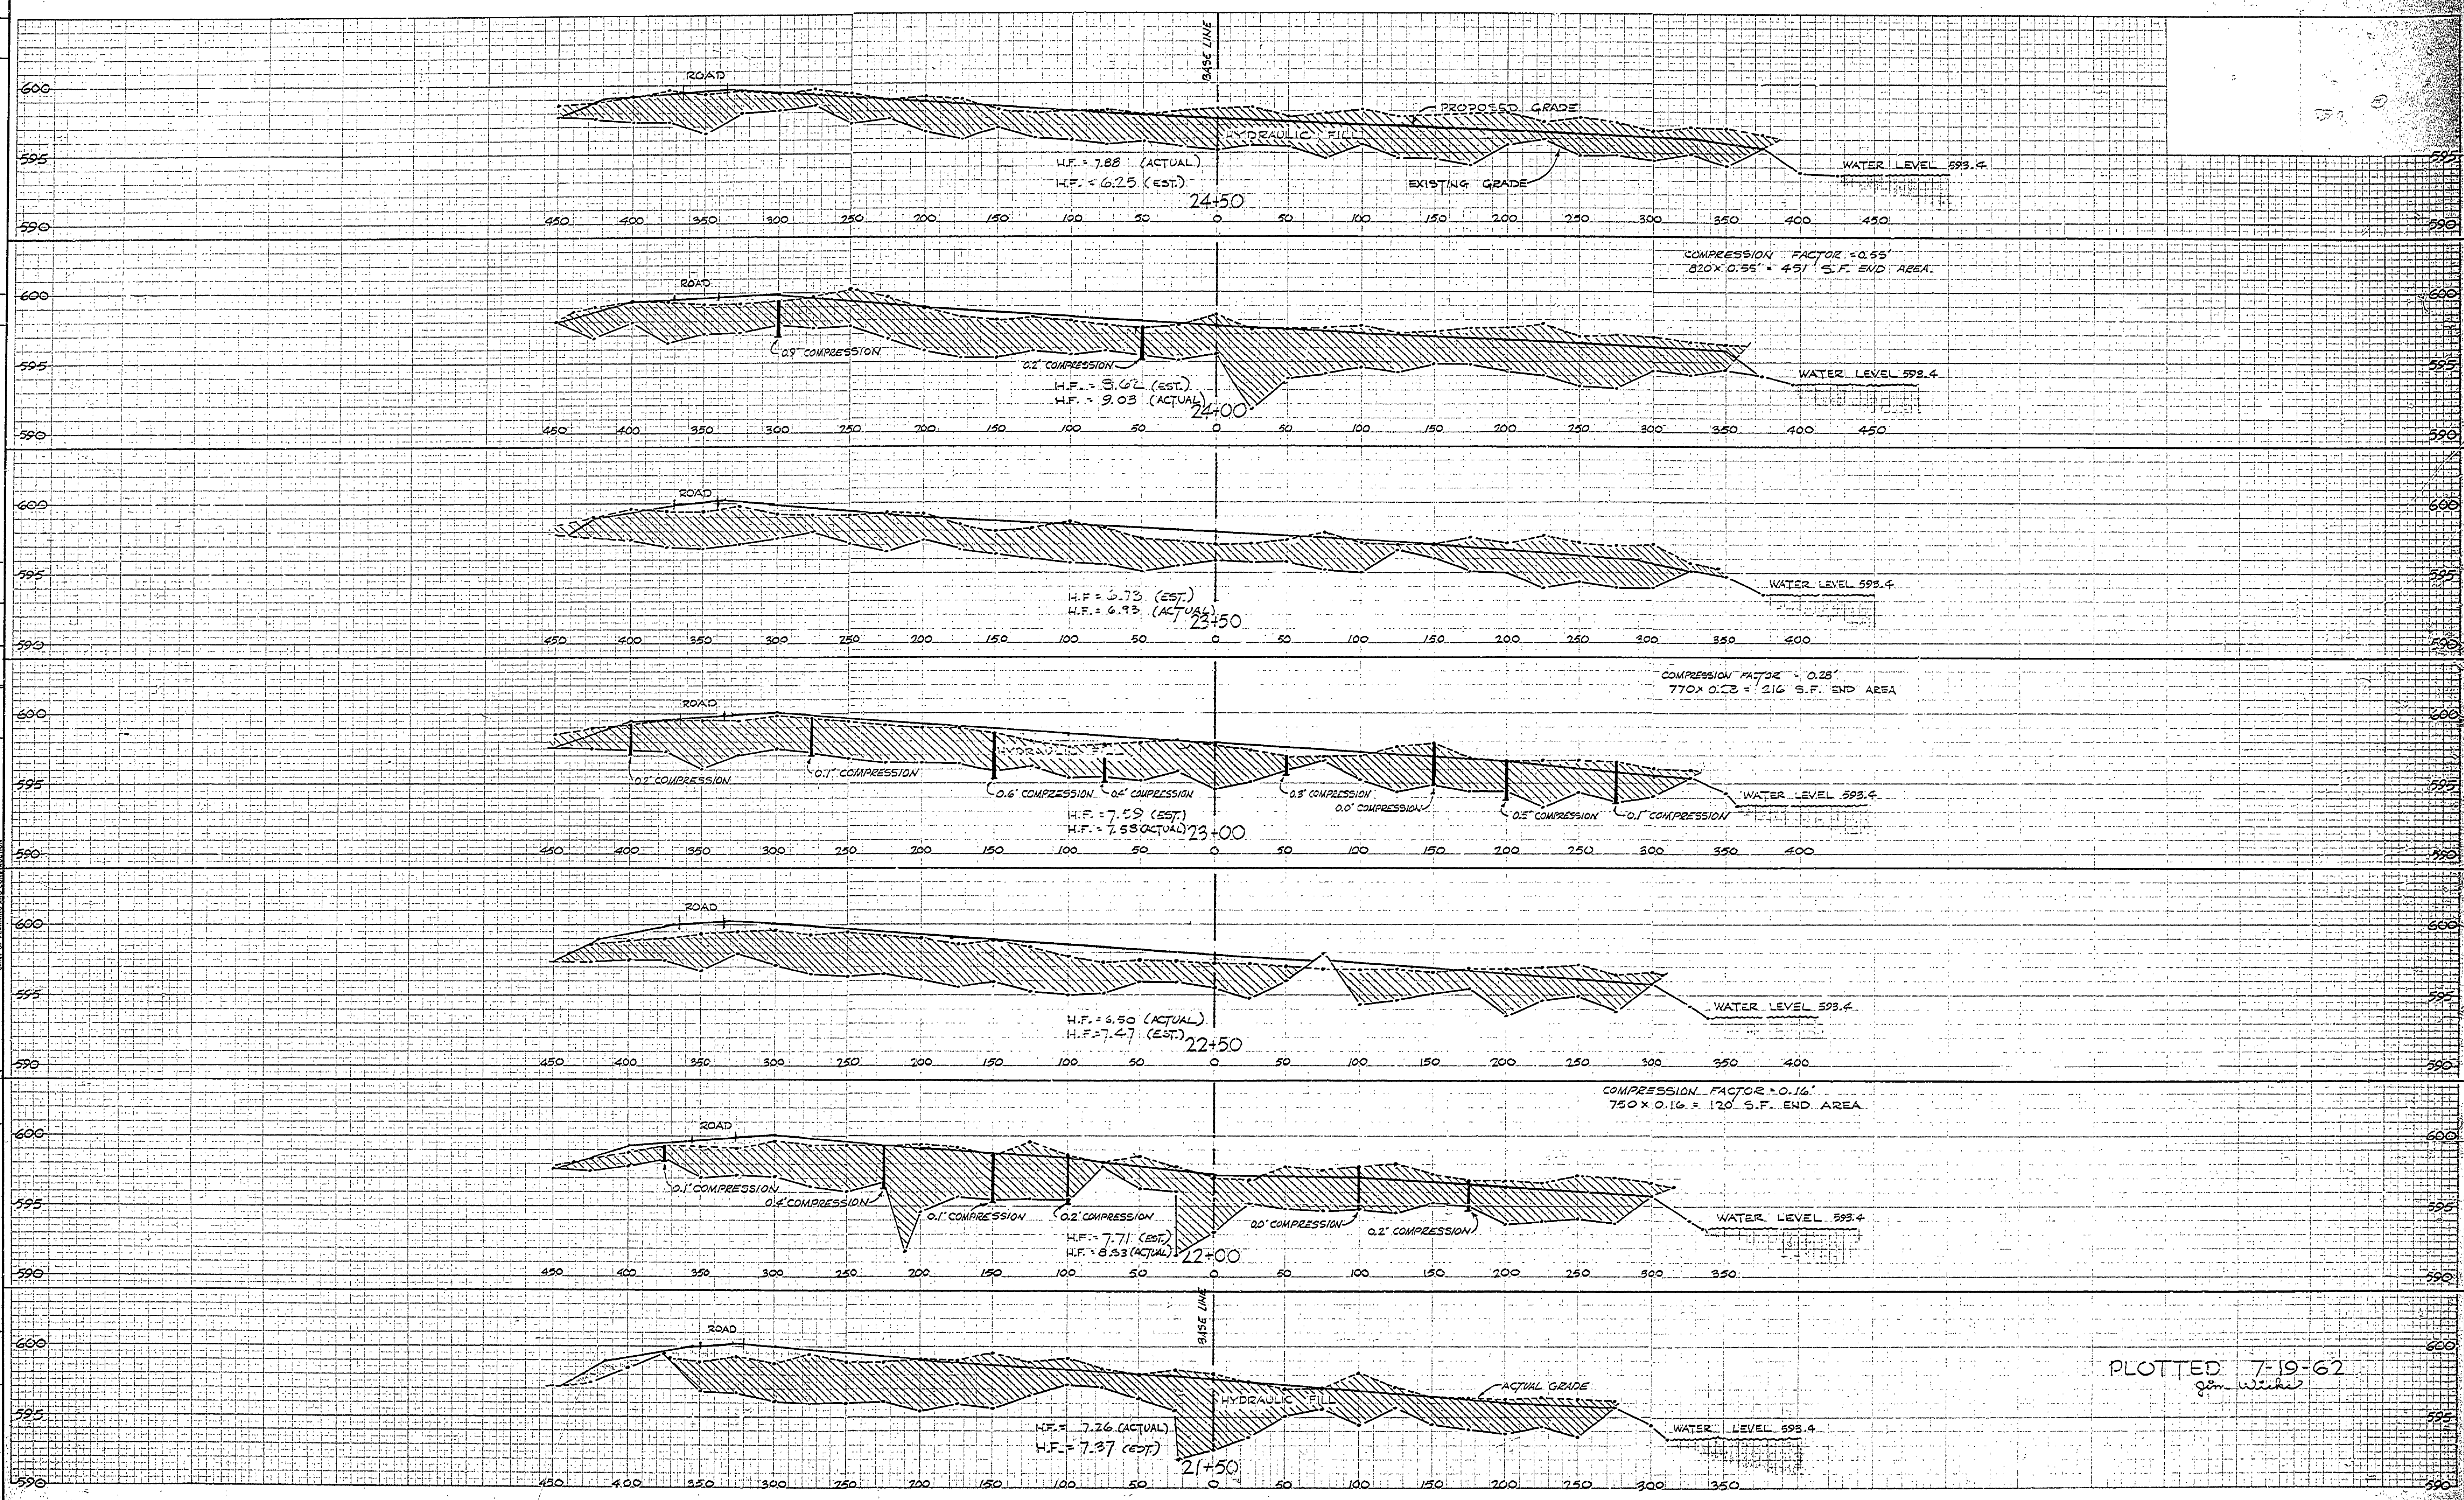

PLOTTED 7-19-62
Jim Weikel

SCALE
VERT. 1" = 5'
HORIZ. 1" = 50'

MICHIGAN
DEPARTMENT OF CONSERVATION
PARKS AND RECREATION DIVISION

ALOHA STATE PARK
HYDRAULIC EXCAVATION MEASUREMENT
CAMPGROUND CROSS SECTIONS

SHEET NO. 2 OF 5
PLAN NO. 109