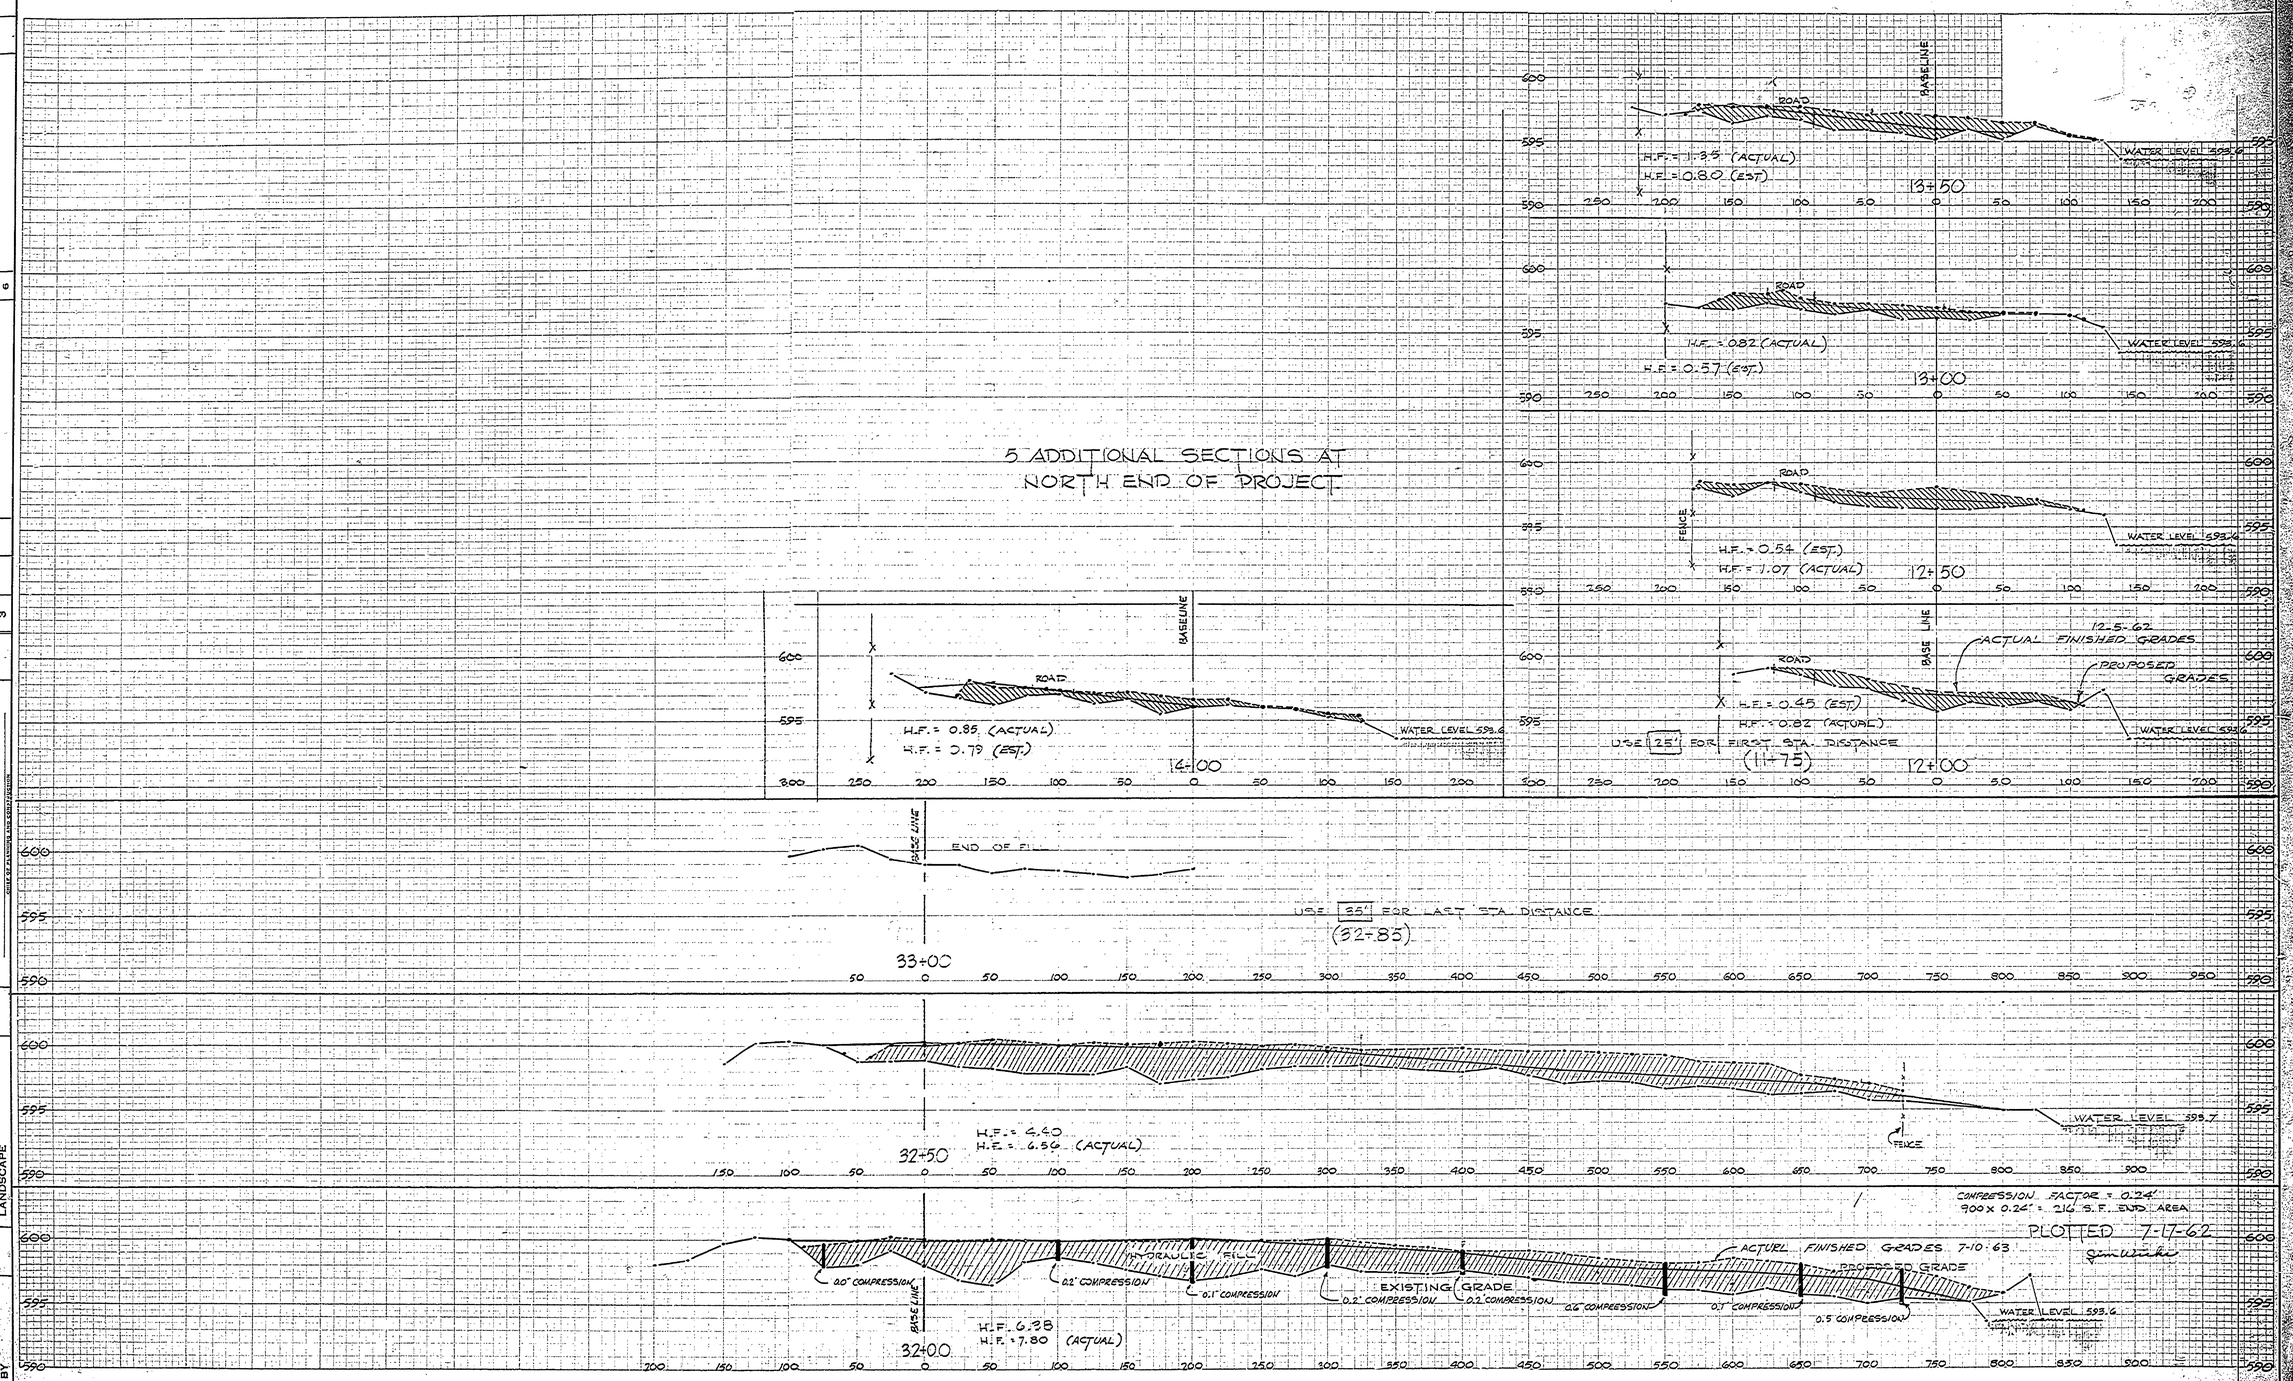

DATE	NO.	DATE	BY
	1		
	2		
	3		

REVISIONS

4			
5			
6			

DATE	BY

APPROVED

CHIEF OF DIVISION

STATE CHIEF OF DIVISION

CHIEF OF PLANNING & DEVELOPMENT DIVISION

DATE	REVIEWED
	ARCHITECTURAL
	ENGINEERING
	LANDSCAPE

DESIGNED BY

DRAWN BY F.J.W.

CHECKED BY

SCALE
VERT. 1" = 9'
HORZ. 1" = 50'

MICHIGAN
DEPARTMENT OF CONSERVATION
PARKS AND RECREATION DIVISION

ALOHA STATE PARK
HYDRAULIC EXCAVATION MEASUREMENT
CAMPGROUND CROSS SECTIONS

SHEET NO. 5 OF 5

PLAN NO. WORK SHEET

E-109