


DESIGNED BY	DRAWN BY	CHECKED BY	DATE	REVIEWED	DATE	APPROVED	NO.	DATE	REVISIONS	DATE	BY
W. H. DOLAN	M. H. DOLAN		2-1-62	ARCHITECTURAL	7-10-63	<i>[Signature]</i>	1	7-10-63	1		
			2-1-62	ENGINEERING	7-11-63	<i>[Signature]</i>	2		2		
				LANDSCAPE	7-11-63	<i>[Signature]</i>	3	7-11-63	3		
							4		4		
							5		5		
							6		6		

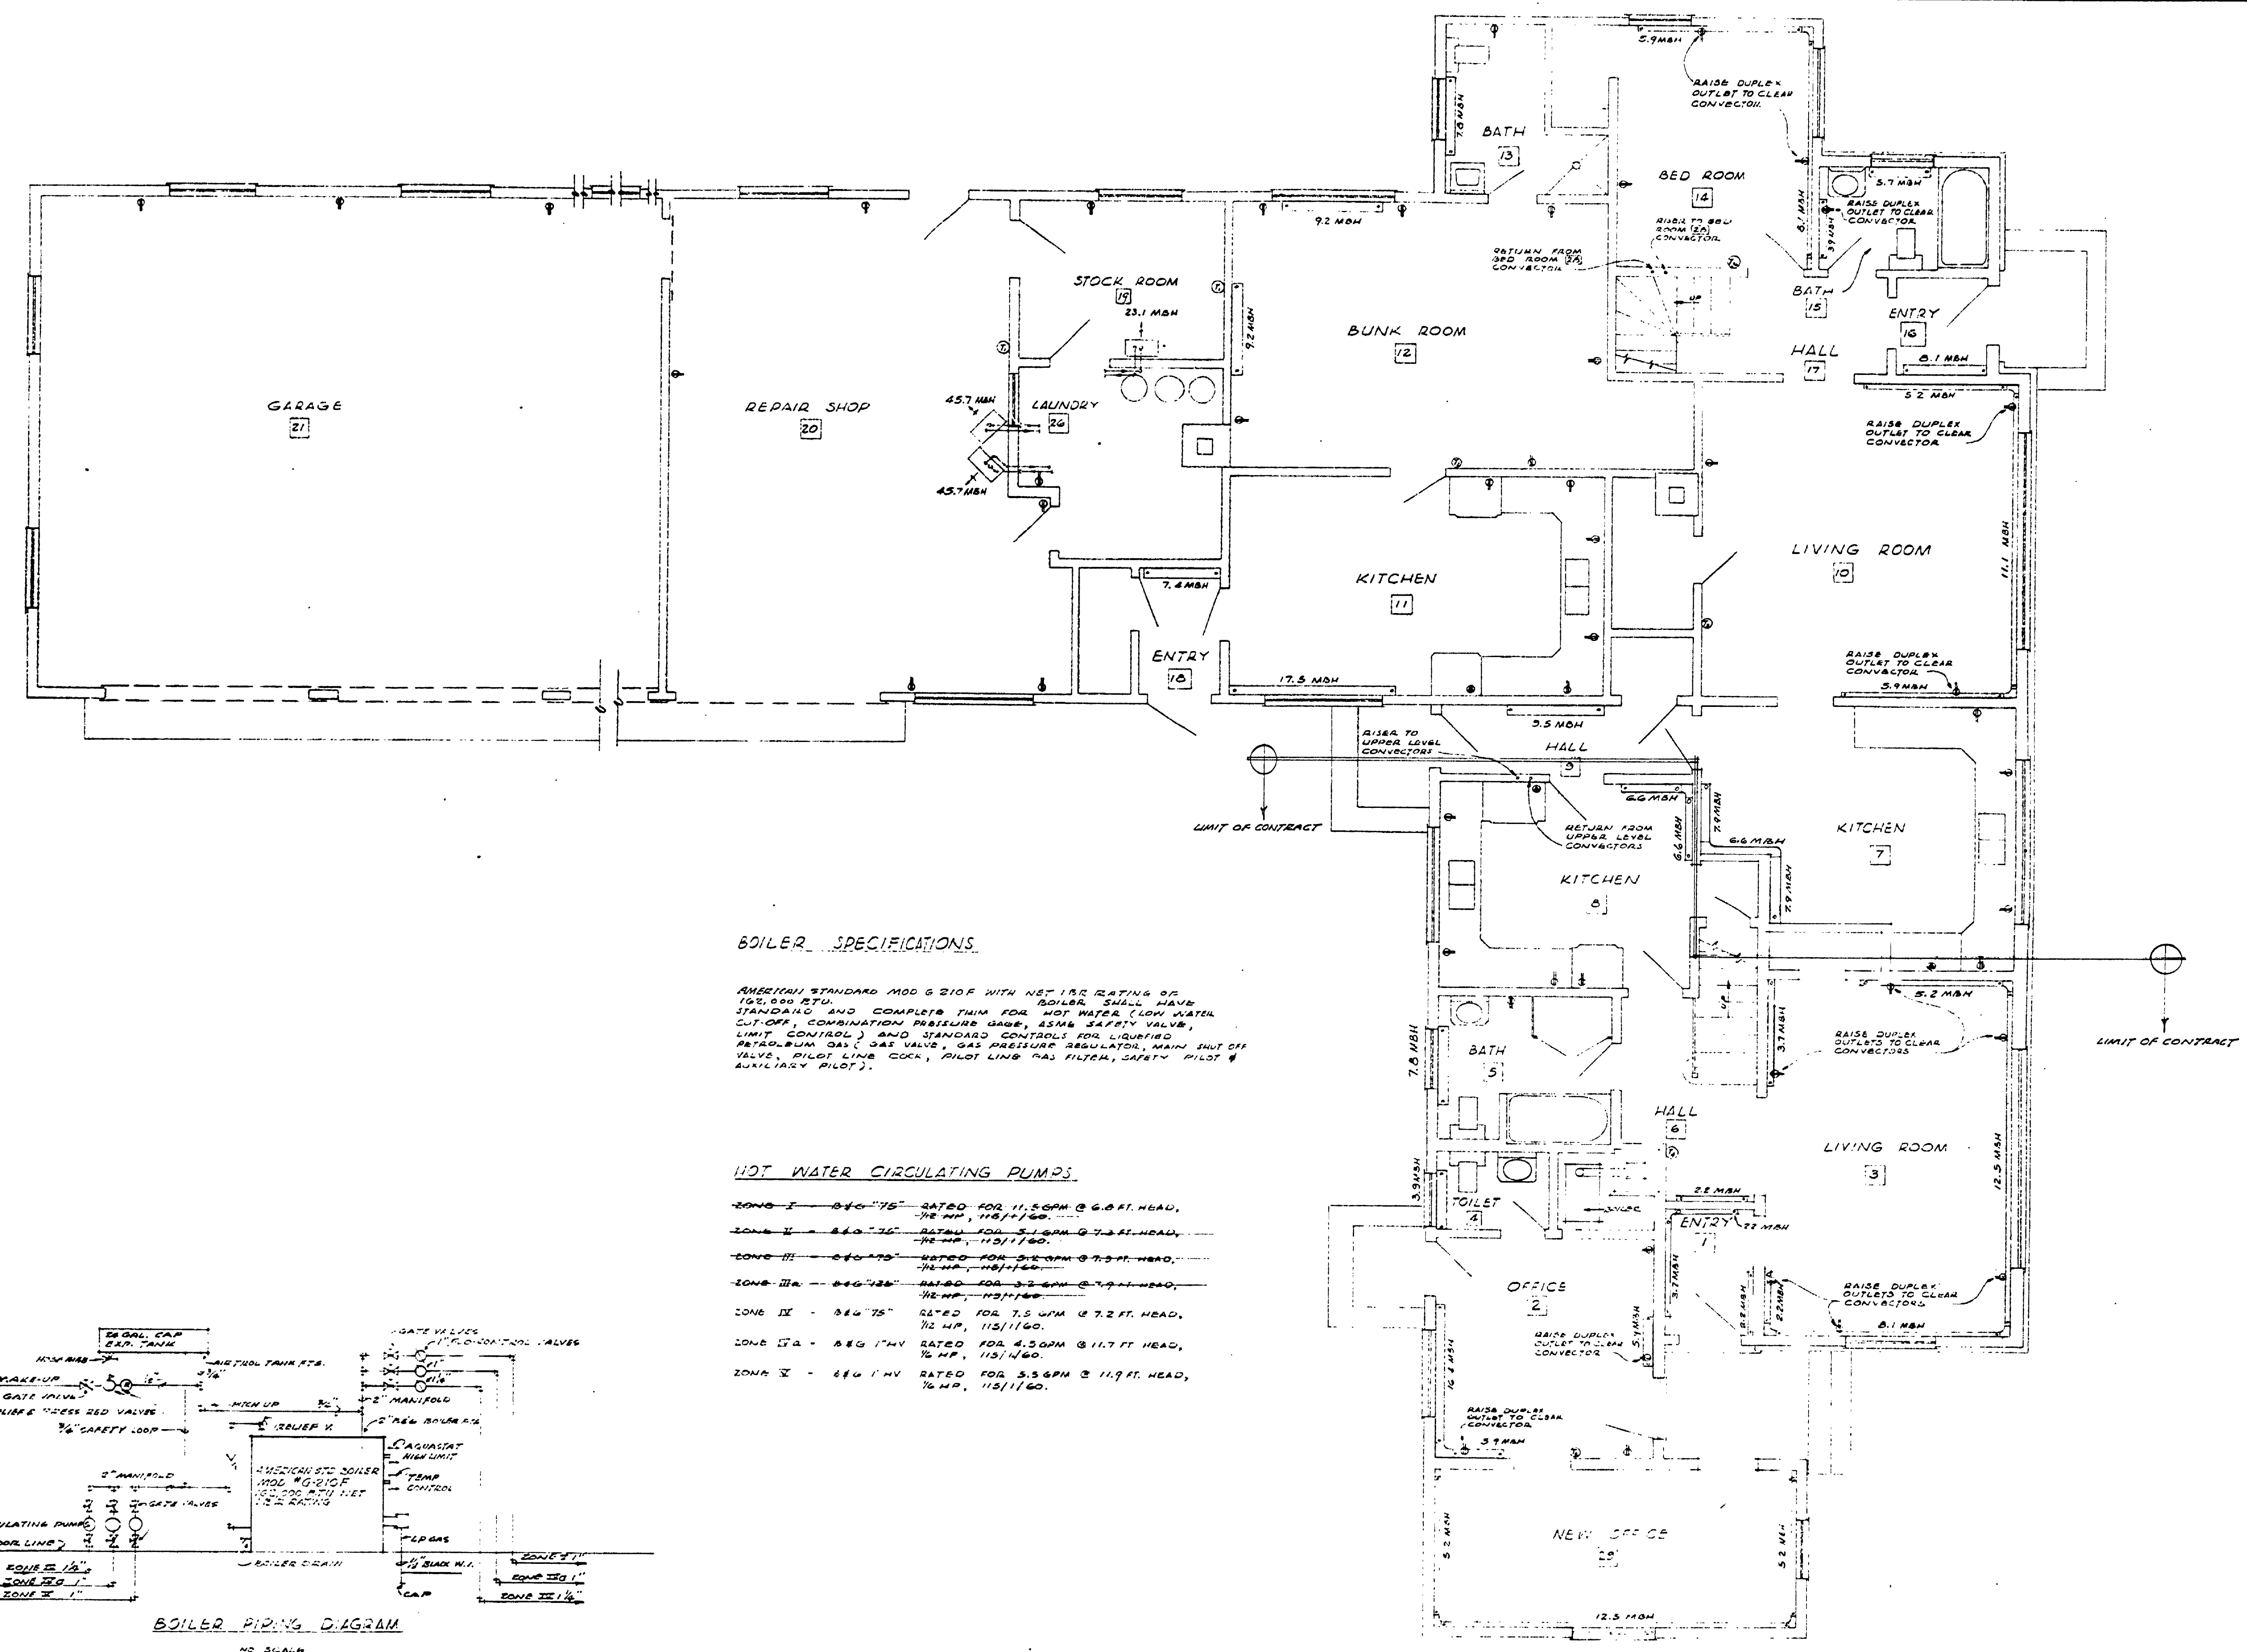


**BOILER SPECIFICATIONS**


**HOT WATER CIRCULATING PUMPS**


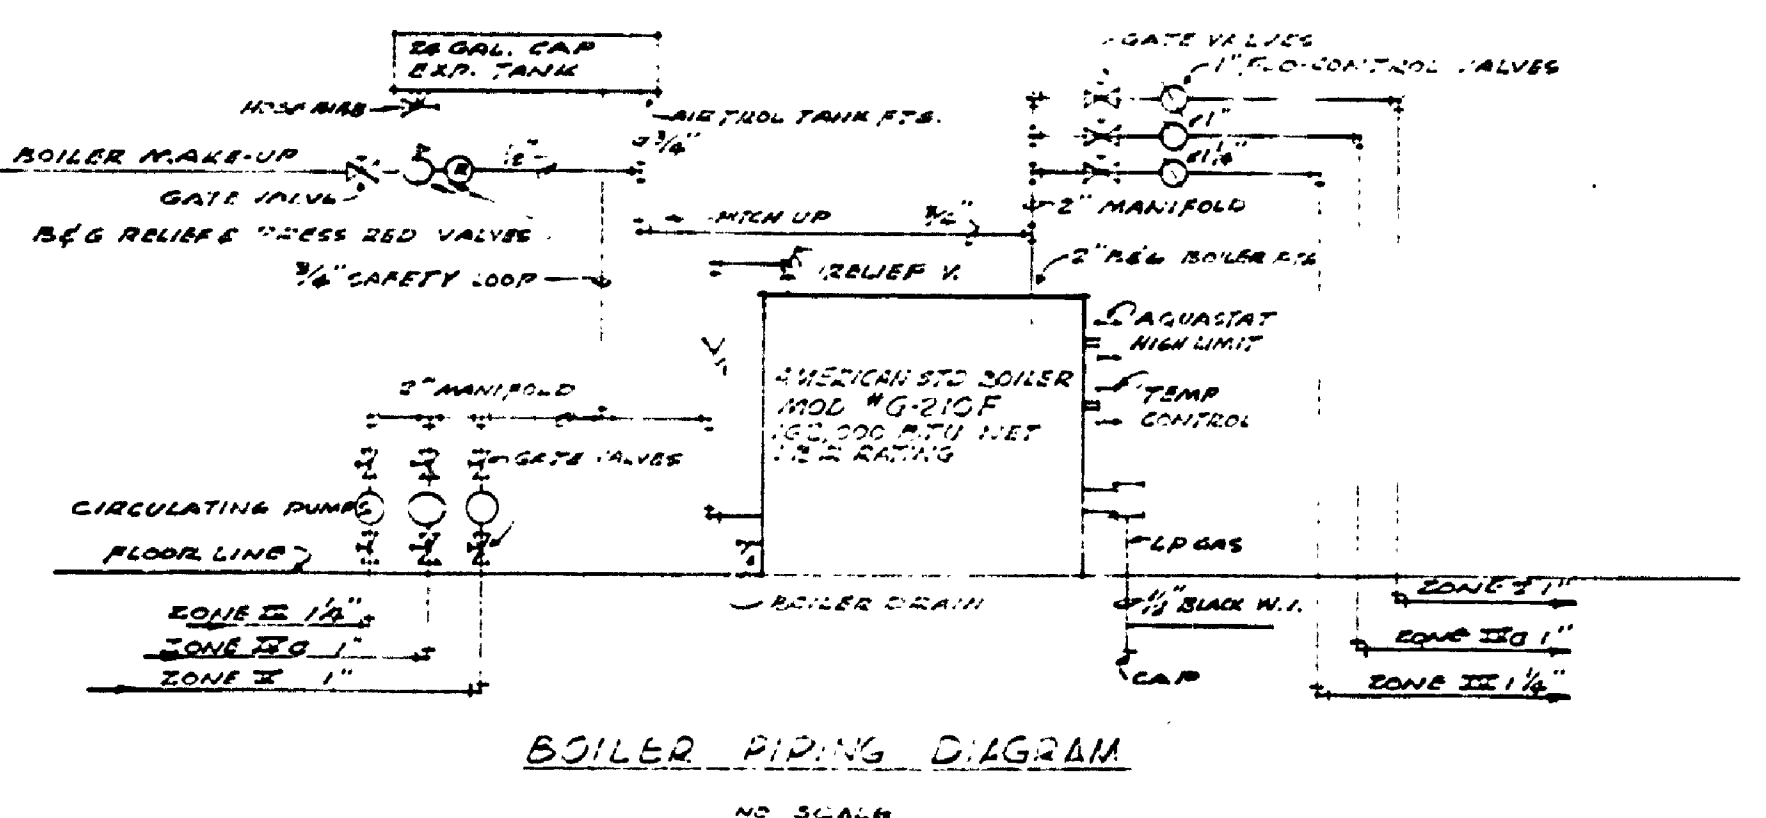

FIRST FLOOR PLAN  
SCALE 1/4" = 1'-0"