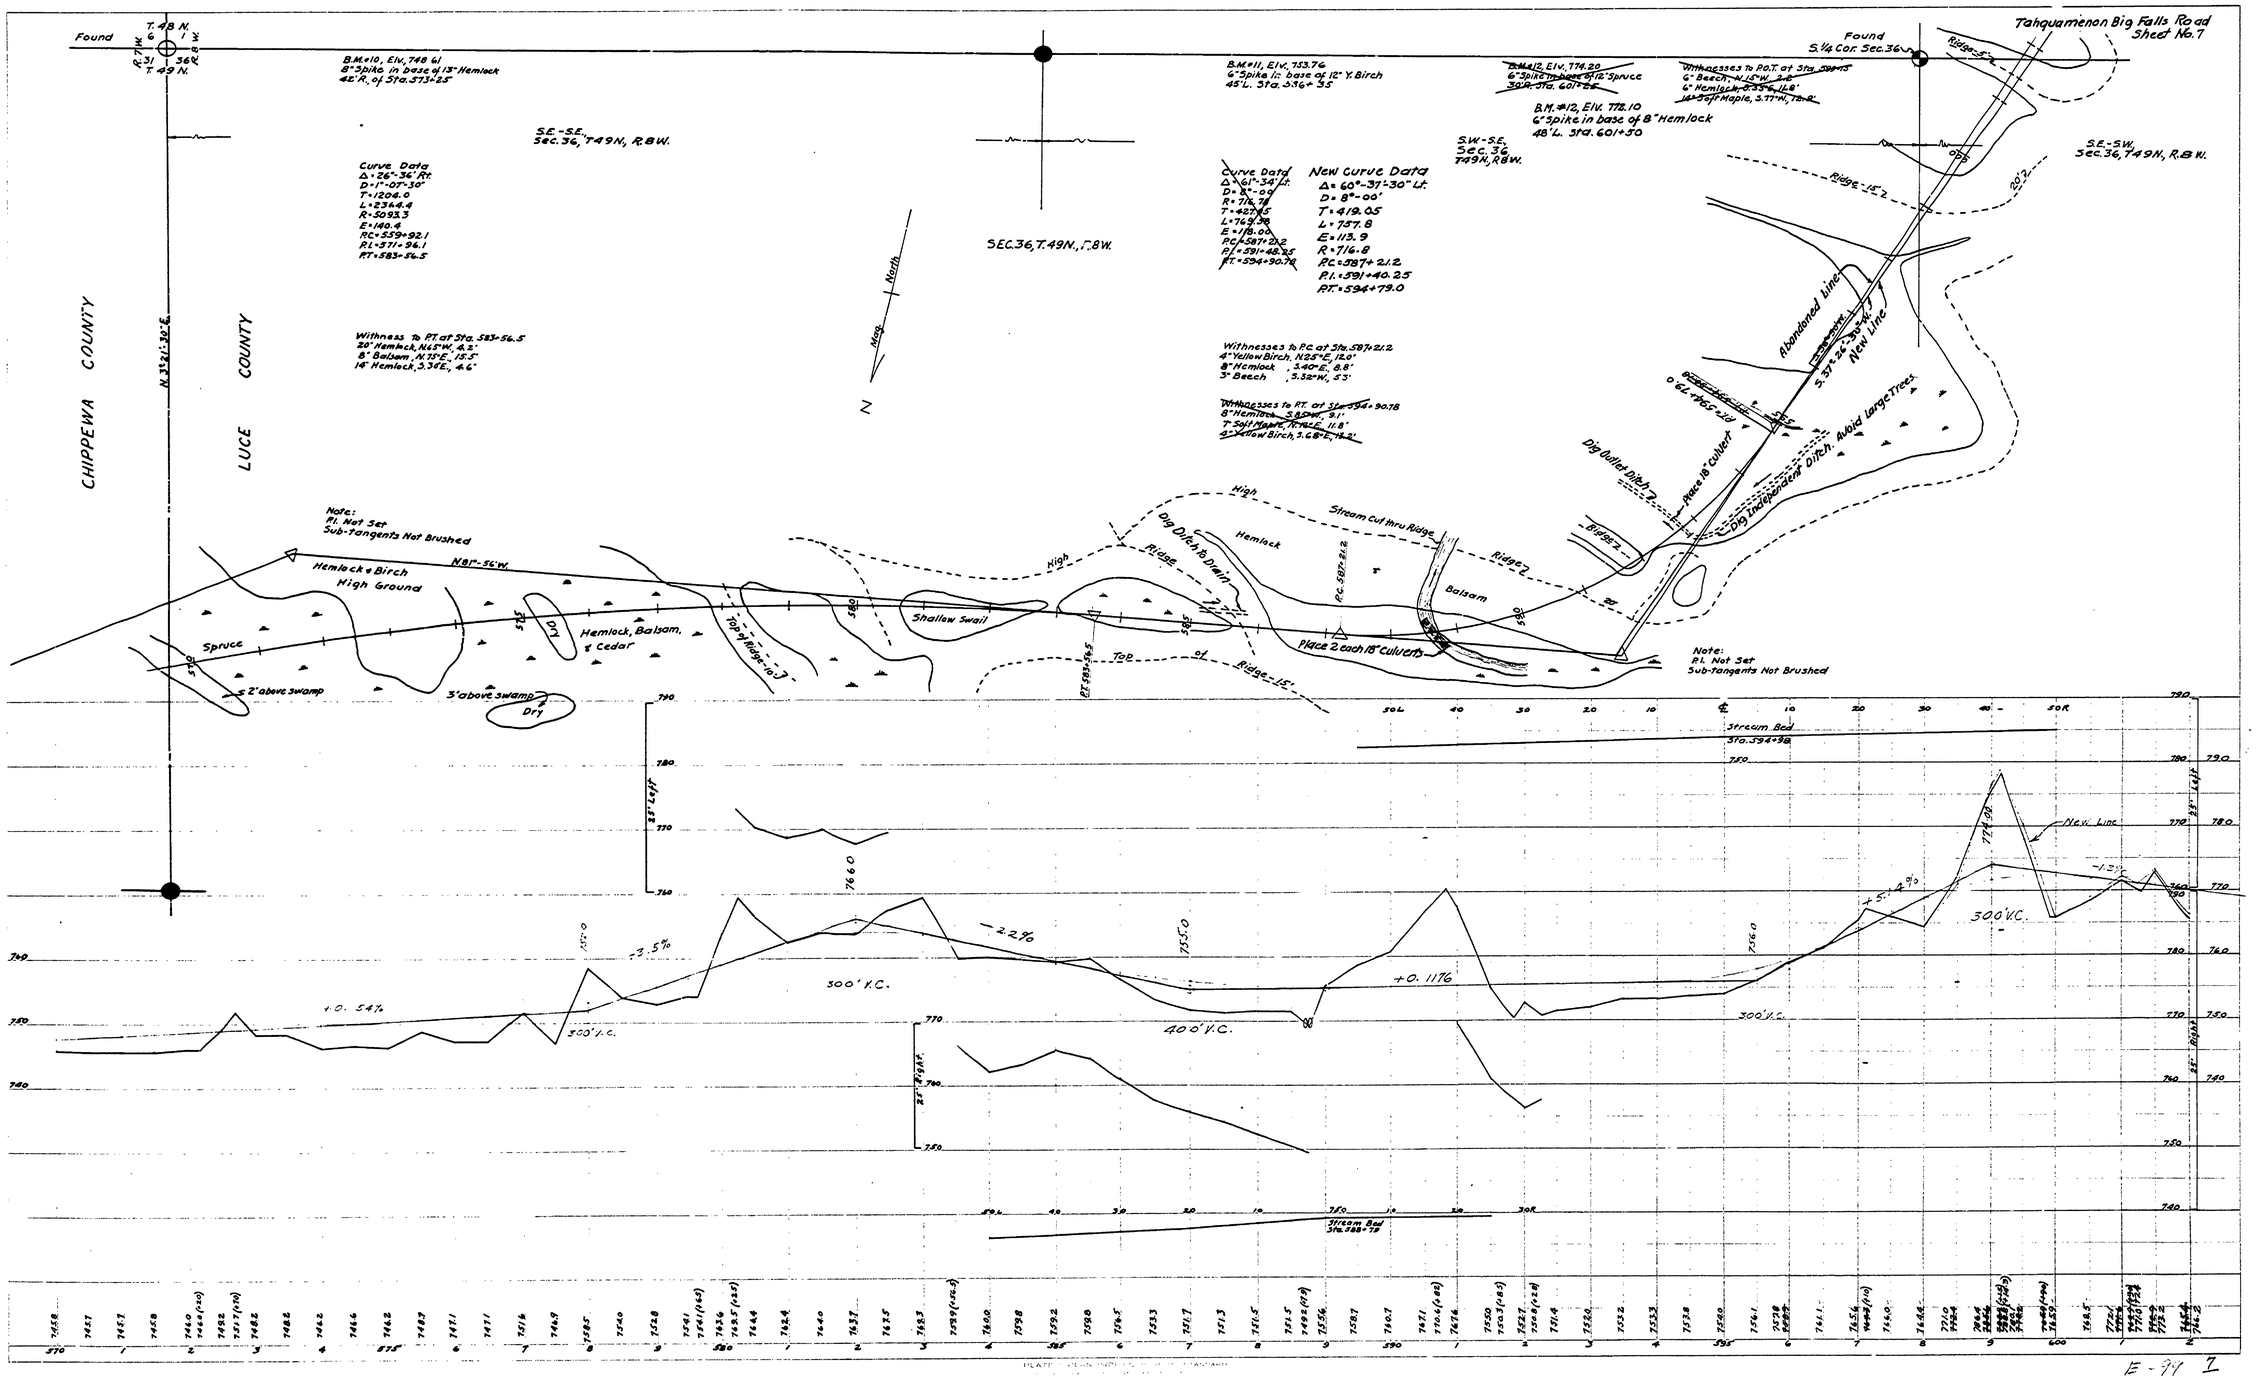
Tahquamenon Big Falls Road
Sheet No. 7
Found
T. 48 N.
T. 49 N.
R. 7 W.
R. 8 W.
31
36
Found
S. 1/4 Cor. Sec. 36
B.M. #10, Elv. 748.61
8" Spike in base of 13" Hemlock
42' R. of Sta. 573+25
S.E.-S.E.
Sec. 36, T.49N., R.8W.
Curve Data
Δ = 26°-36' Rt.
D = 1°-07'-30"
T = 1204.0
L = 2344.4
R = 5093.3
E = 140.4
P.C. = 559+92.1
P.I. = 571+96.1
P.T. = 583+36.5
Witness To P.T. at Sta. 583+56.5
20" Hemlock, N.6°W., 4.2'
8" Balsam, N.35°E., 15.5'
14" Hemlock, 3.36°E., 4.6'
Note:
P.I. Not Set
Sub-Tangents Not Brushed
N.81°-56'W.
Hemlock & Birch
High Ground
Spruce
2' above swamp
3' above swamp
Dry
Hemlock, Balsam, & Cedar
Top of Ridge-10'
Shallow Swail
Dig Ditch to Drain
Ridge
High
Hemlock
Stream Cut thru Ridge
Ridge-2'
Balsam
Place 2 each 18" culverts
Top of Ridge-15'
Note:
P.I. Not Set
Sub-Tangents Not Brushed
CHIPPEWA COUNTY
LUCE COUNTY
N. 35°-41'-30"-E.
SEC. 36, T.49N., R.8W.
Mag. North
N
B.M. #11, Elv. 753.74
6" Spike in base of 12" Y. Birch
45' L. Sta. 536+35
B.M. #12, Elv. 774.20
6" Spike in base of 18" Spruce
30' R. Sta. 601+25
B.M. #12, Elv. 772.10
6" Spike in base of 8" Hemlock
48' L. Sta. 601+30
S.W.-S.E.
Sec. 36,
T.49N., R.8W.
S.E.-S.W.
Sec. 36, T.49N., R.8W.
Curve Data
Δ = 61°-34' Lt.
D = 8°-00'
R = 716.78
T = 427.65
L = 769.98
E = 118.00
P.C. = 587+21.2
P.I. = 591+48.25
P.T. = 594+90.78
New Curve Data
Δ = 60°-37'-30" Lt.
D = 8°-00'
T = 419.05
L = 757.8
E = 113.9
R = 716.8
P.C. = 587+21.2
P.I. = 591+40.25
P.T. = 594+79.0
Witnesses To P.C. at Sta. 587+21.2
4" Yellow Birch, N.25°E., 12.0'
8" Hemlock, 2.40°E., 8.8'
3" Beech, 3.52°W., 5.3'
Witnesses To P.T. at Sta. 594+90.78
8" Hemlock, 3.8°W., 9.1'
7" Soft Maple, N.7°E., 11.8'
4" Yellow Birch, 3.68°E., 18.2'
Abandoned line
New Line
S. 52°-26'-30" E.
0°-59'-29" E.
Dig Outlet Ditch
Place 18" culvert
Dig Independent Ditch. Avoid large trees.
Ridge-15'
20'
Stream Bed
Sta. 594+98
Stream Bed
Sta. 588+78
25' Left
25' Right
-2.2%
+0.1176
300' V.C.
400' V.C.
+0.54%
-3.5%
+5.4%
-1.2%
New Line
774.00
755.0
756.0
760.0
E-94 I