



CAMP SITE PLAN
SCALE 1" = 10'

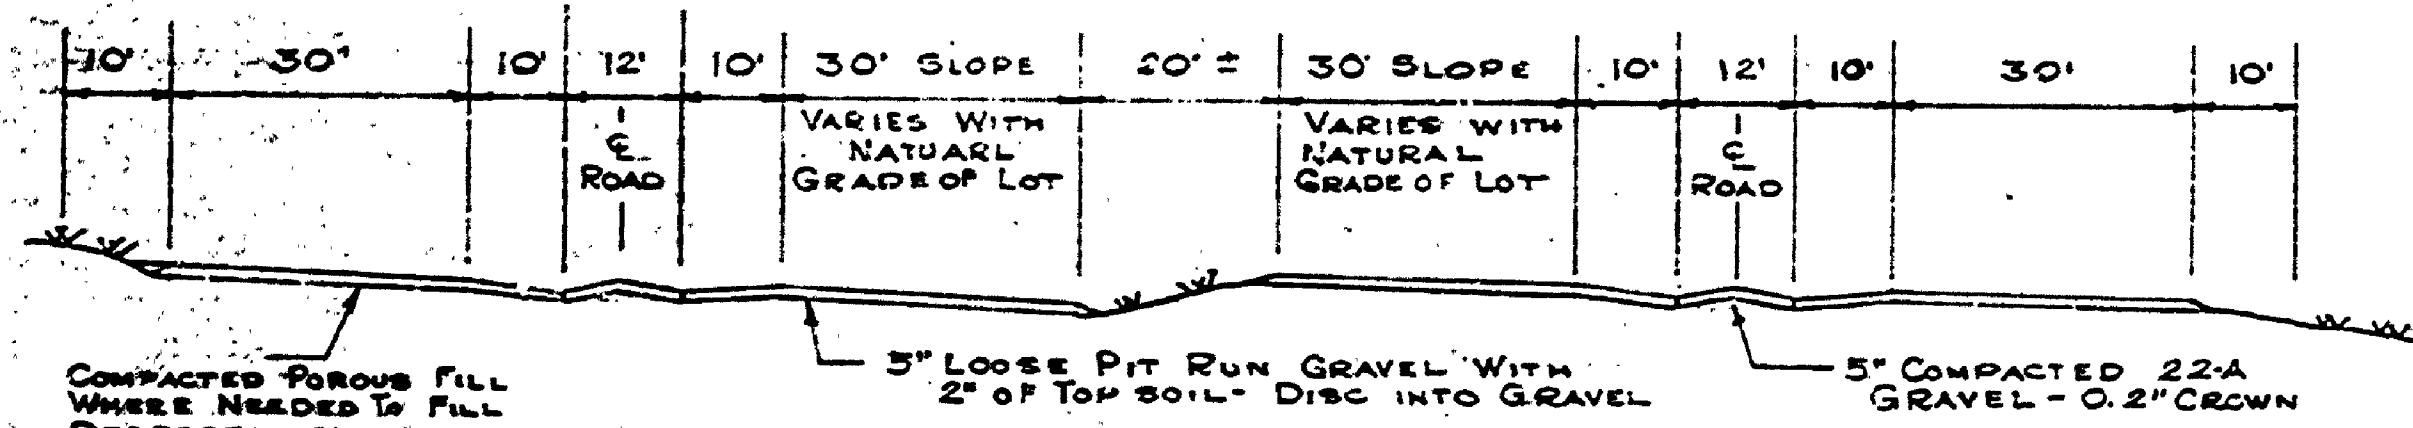


TYPICAL SECTION
OF
CAMPGROUND ROAD & CAMPSITE
NO SCALE

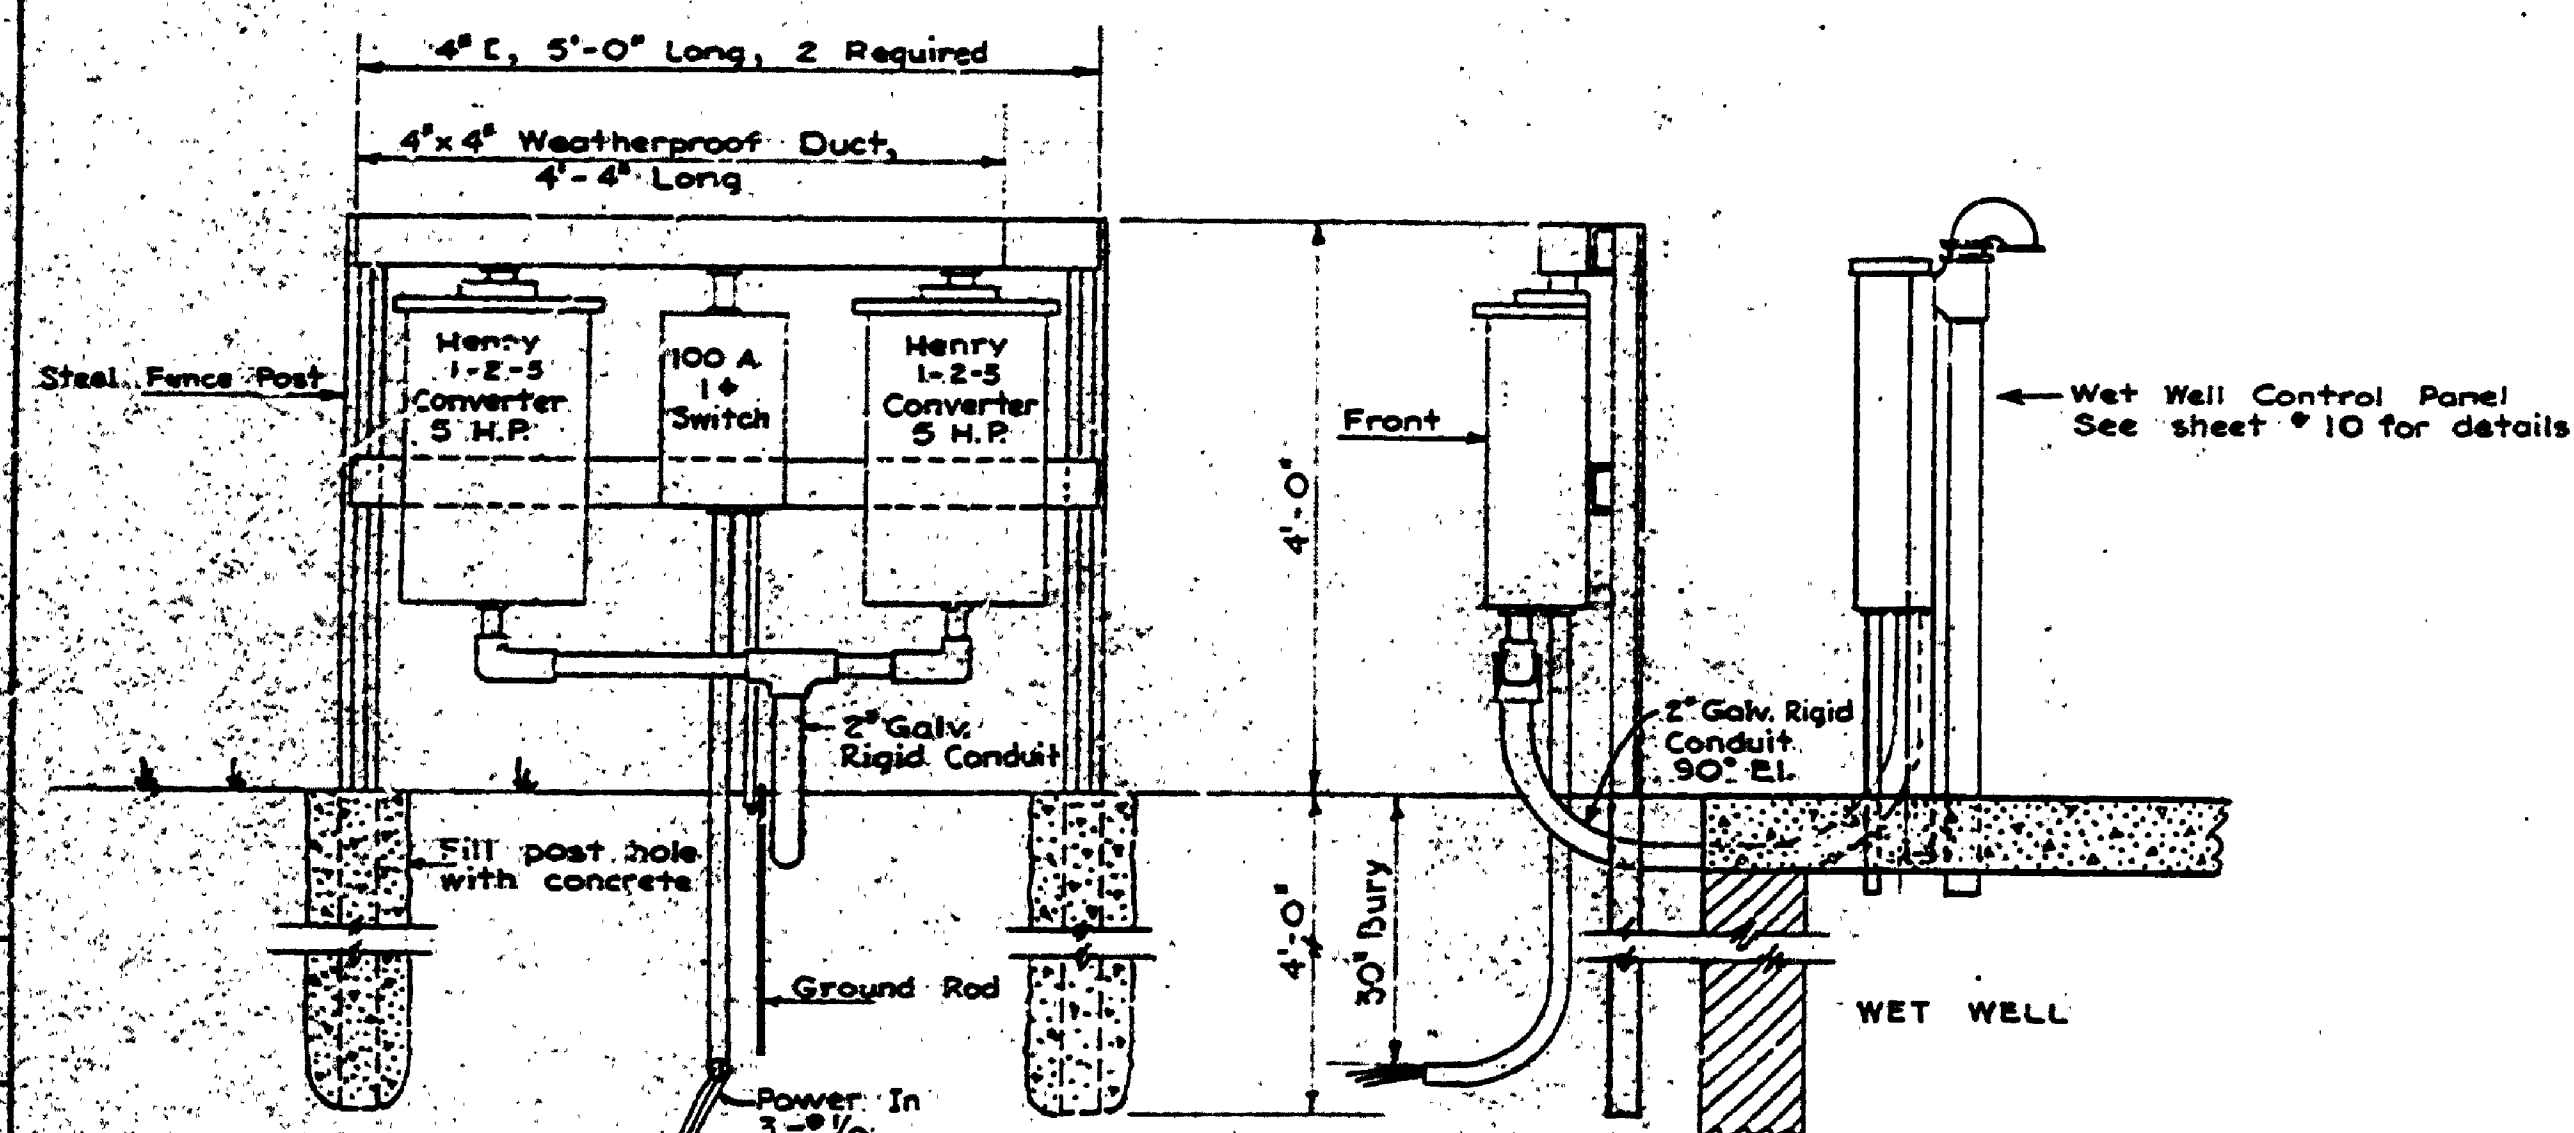


FRONT ELEVATION SIDE ELEVATION
PHASE CONVERTER RACK
SCALE 1" = 1'-0"


- NOTES
- Concrete pad to be placed on 12" of compacted gravel.
 - Concrete to have 3000 P.S.I. compressive strength at 28 days.

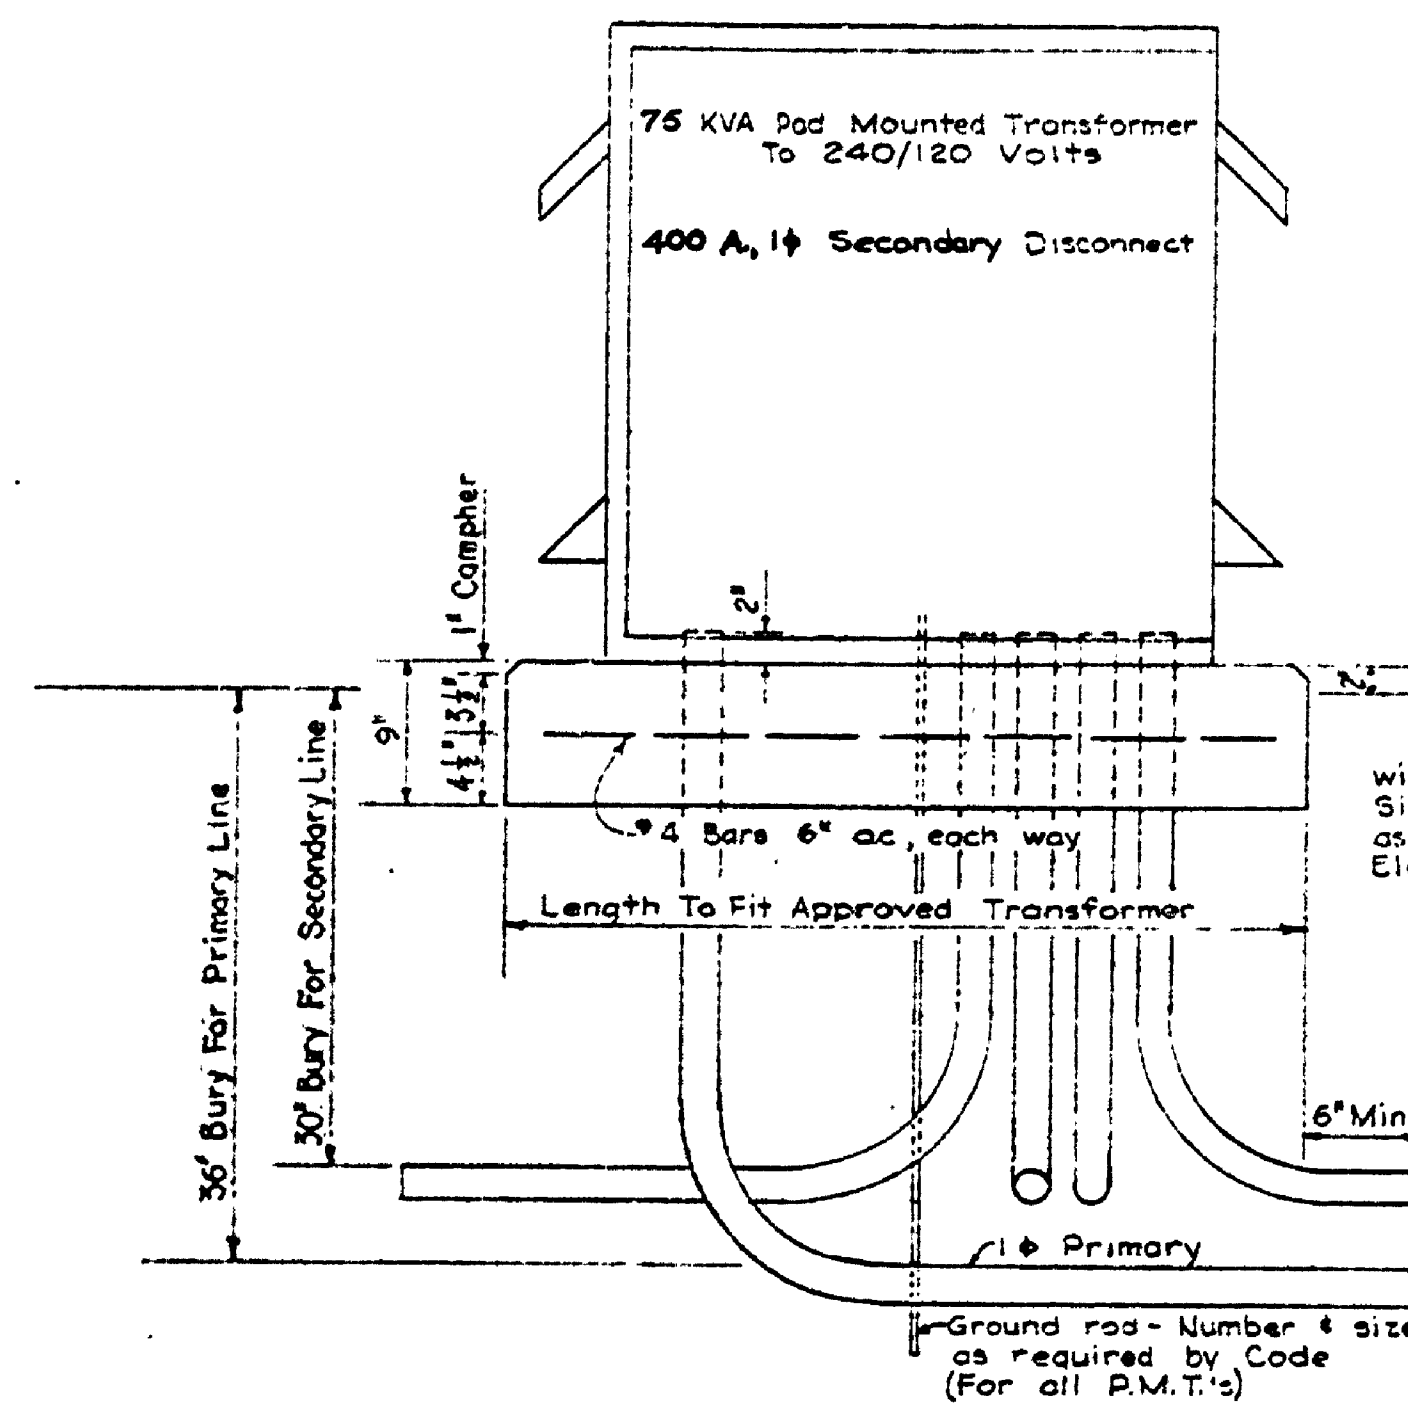

ELEVATION
TRANSFORMER UNIT No. 1

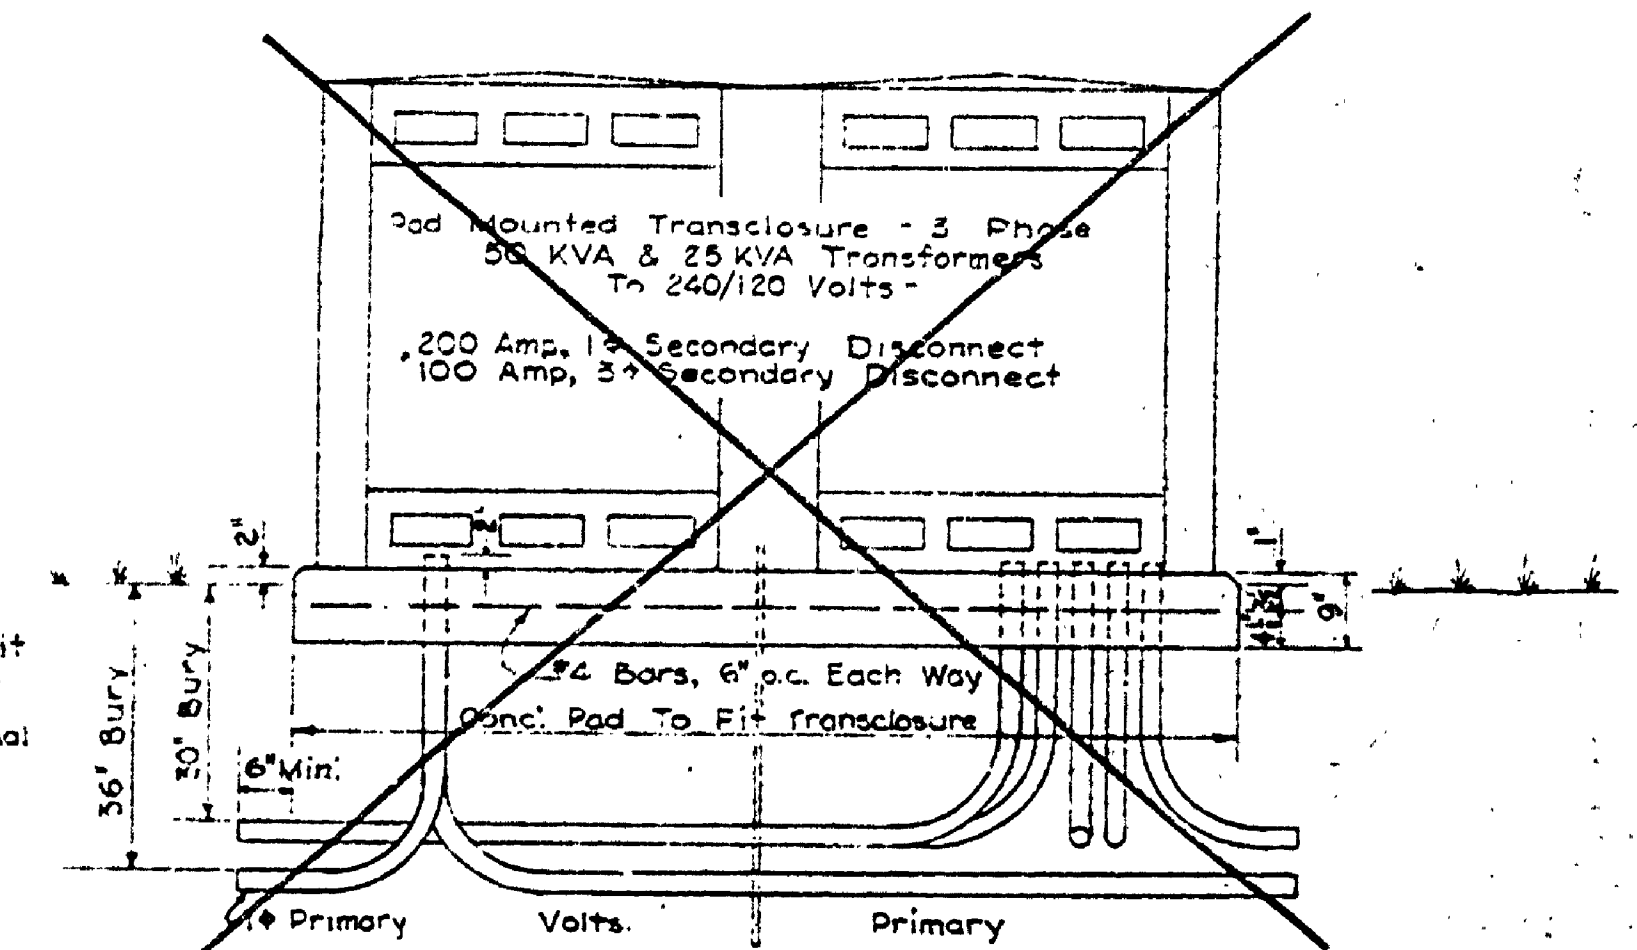

ELEVATION

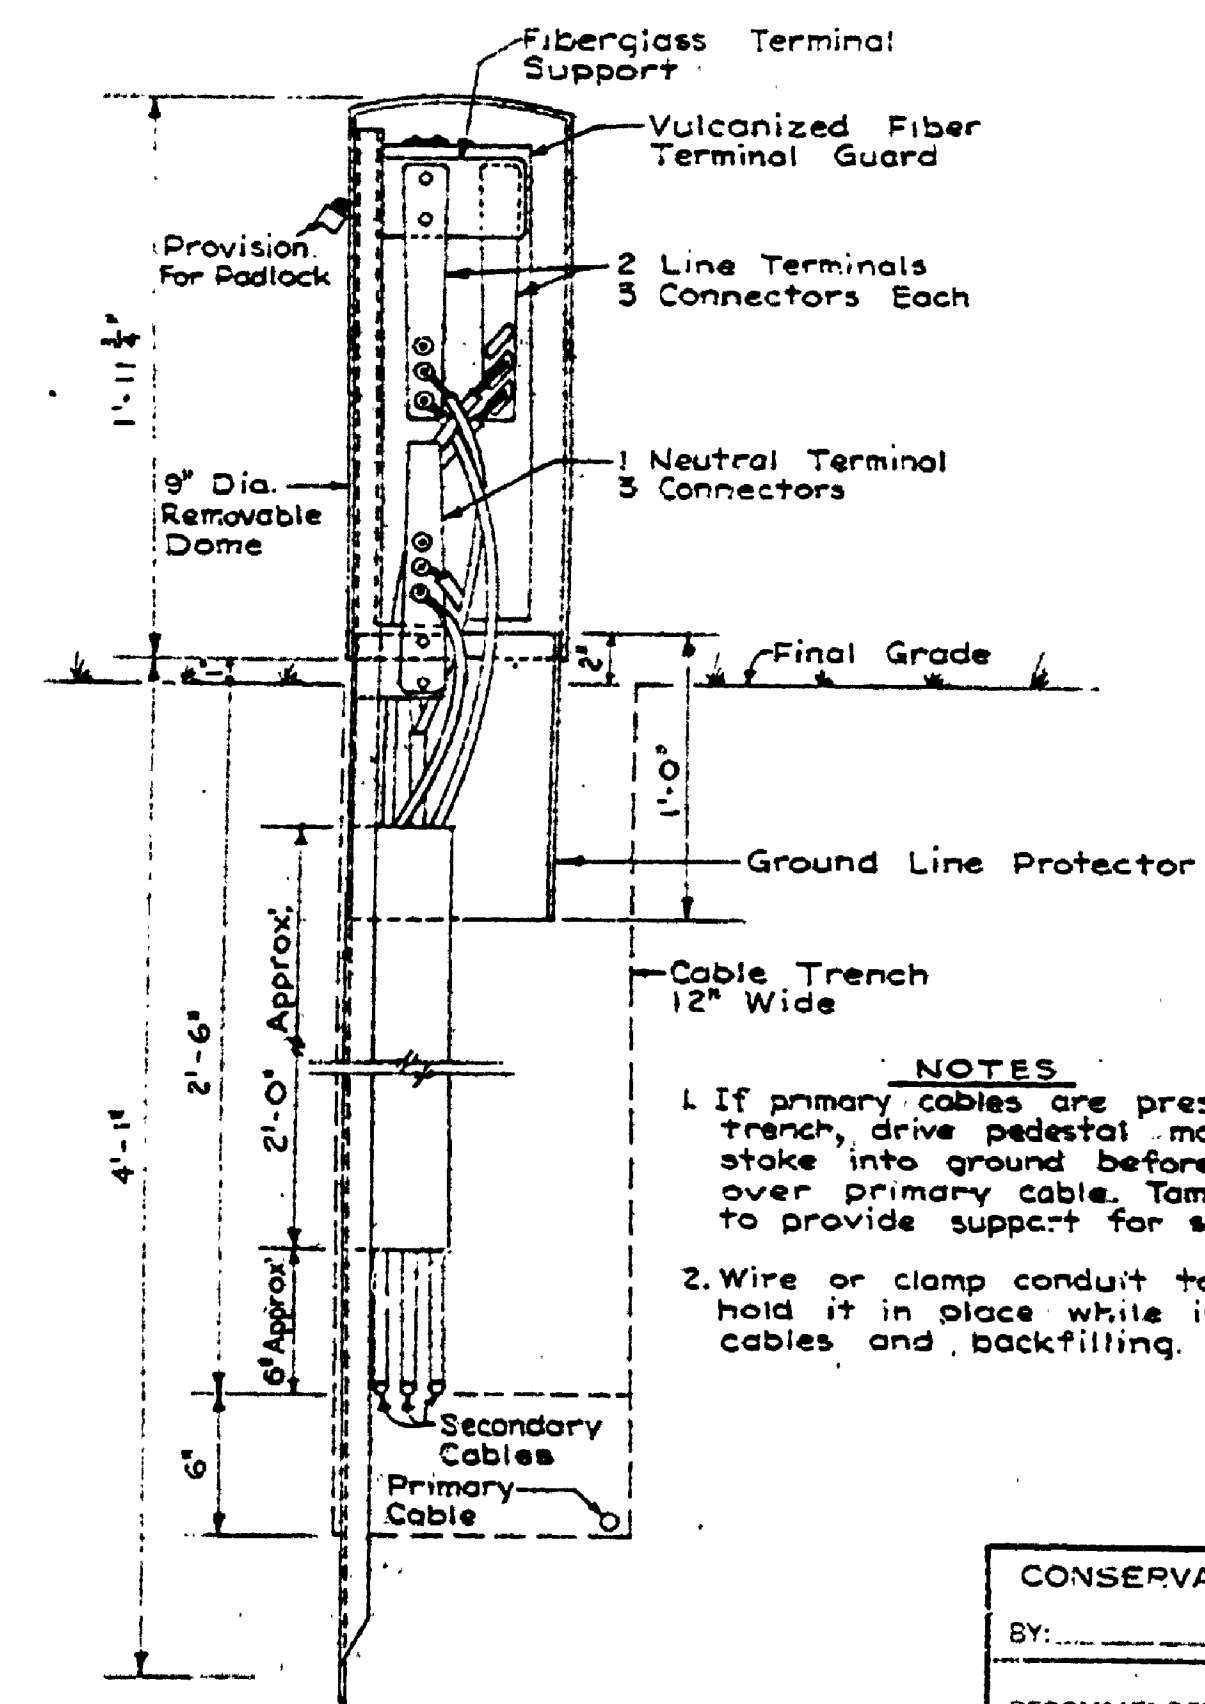

- NOTES
- If primary cables are present in trench, drive pedestal mounting stake into ground before backfilling over primary cable. Tamp backfill to provide support for stake.
 - Wire or clamp conduit to stake to hold it in place while installing cables and backfilling.

POWER PEDESTAL

CONSERVATION COMMISSION APPROVAL		
BY: _____	DESIGNER	DATE: _____
RECOMMENDED FOR APPROVAL: _____	DESIGNER	DATE: _____
RECOMMENDED FOR APPROVAL: _____	IN CHARGE OF DESIGN	DATE: _____
SECTION APPROVAL		
BY: _____	SUPV. CHIEF	DATE: _____
MICHIGAN DEPARTMENT OF CONSERVATION		
APPROVED: _____	CHIEF ENGINEER	DATE: _____
PLAN No. _____	PROJECT NUMBER _____	SHEET _____ OF _____

TAHQUAMENON FALLS STATE PARK
LOWER FALLS CAMPGROUND
DETAIL SHEET

SHEET NO. 18 OF 19
PLAN NO. E-717

DATE	APRIL 88
DESIGNED BY: POYET	
DRAWN BY: COYE	
CHECKED BY:	