

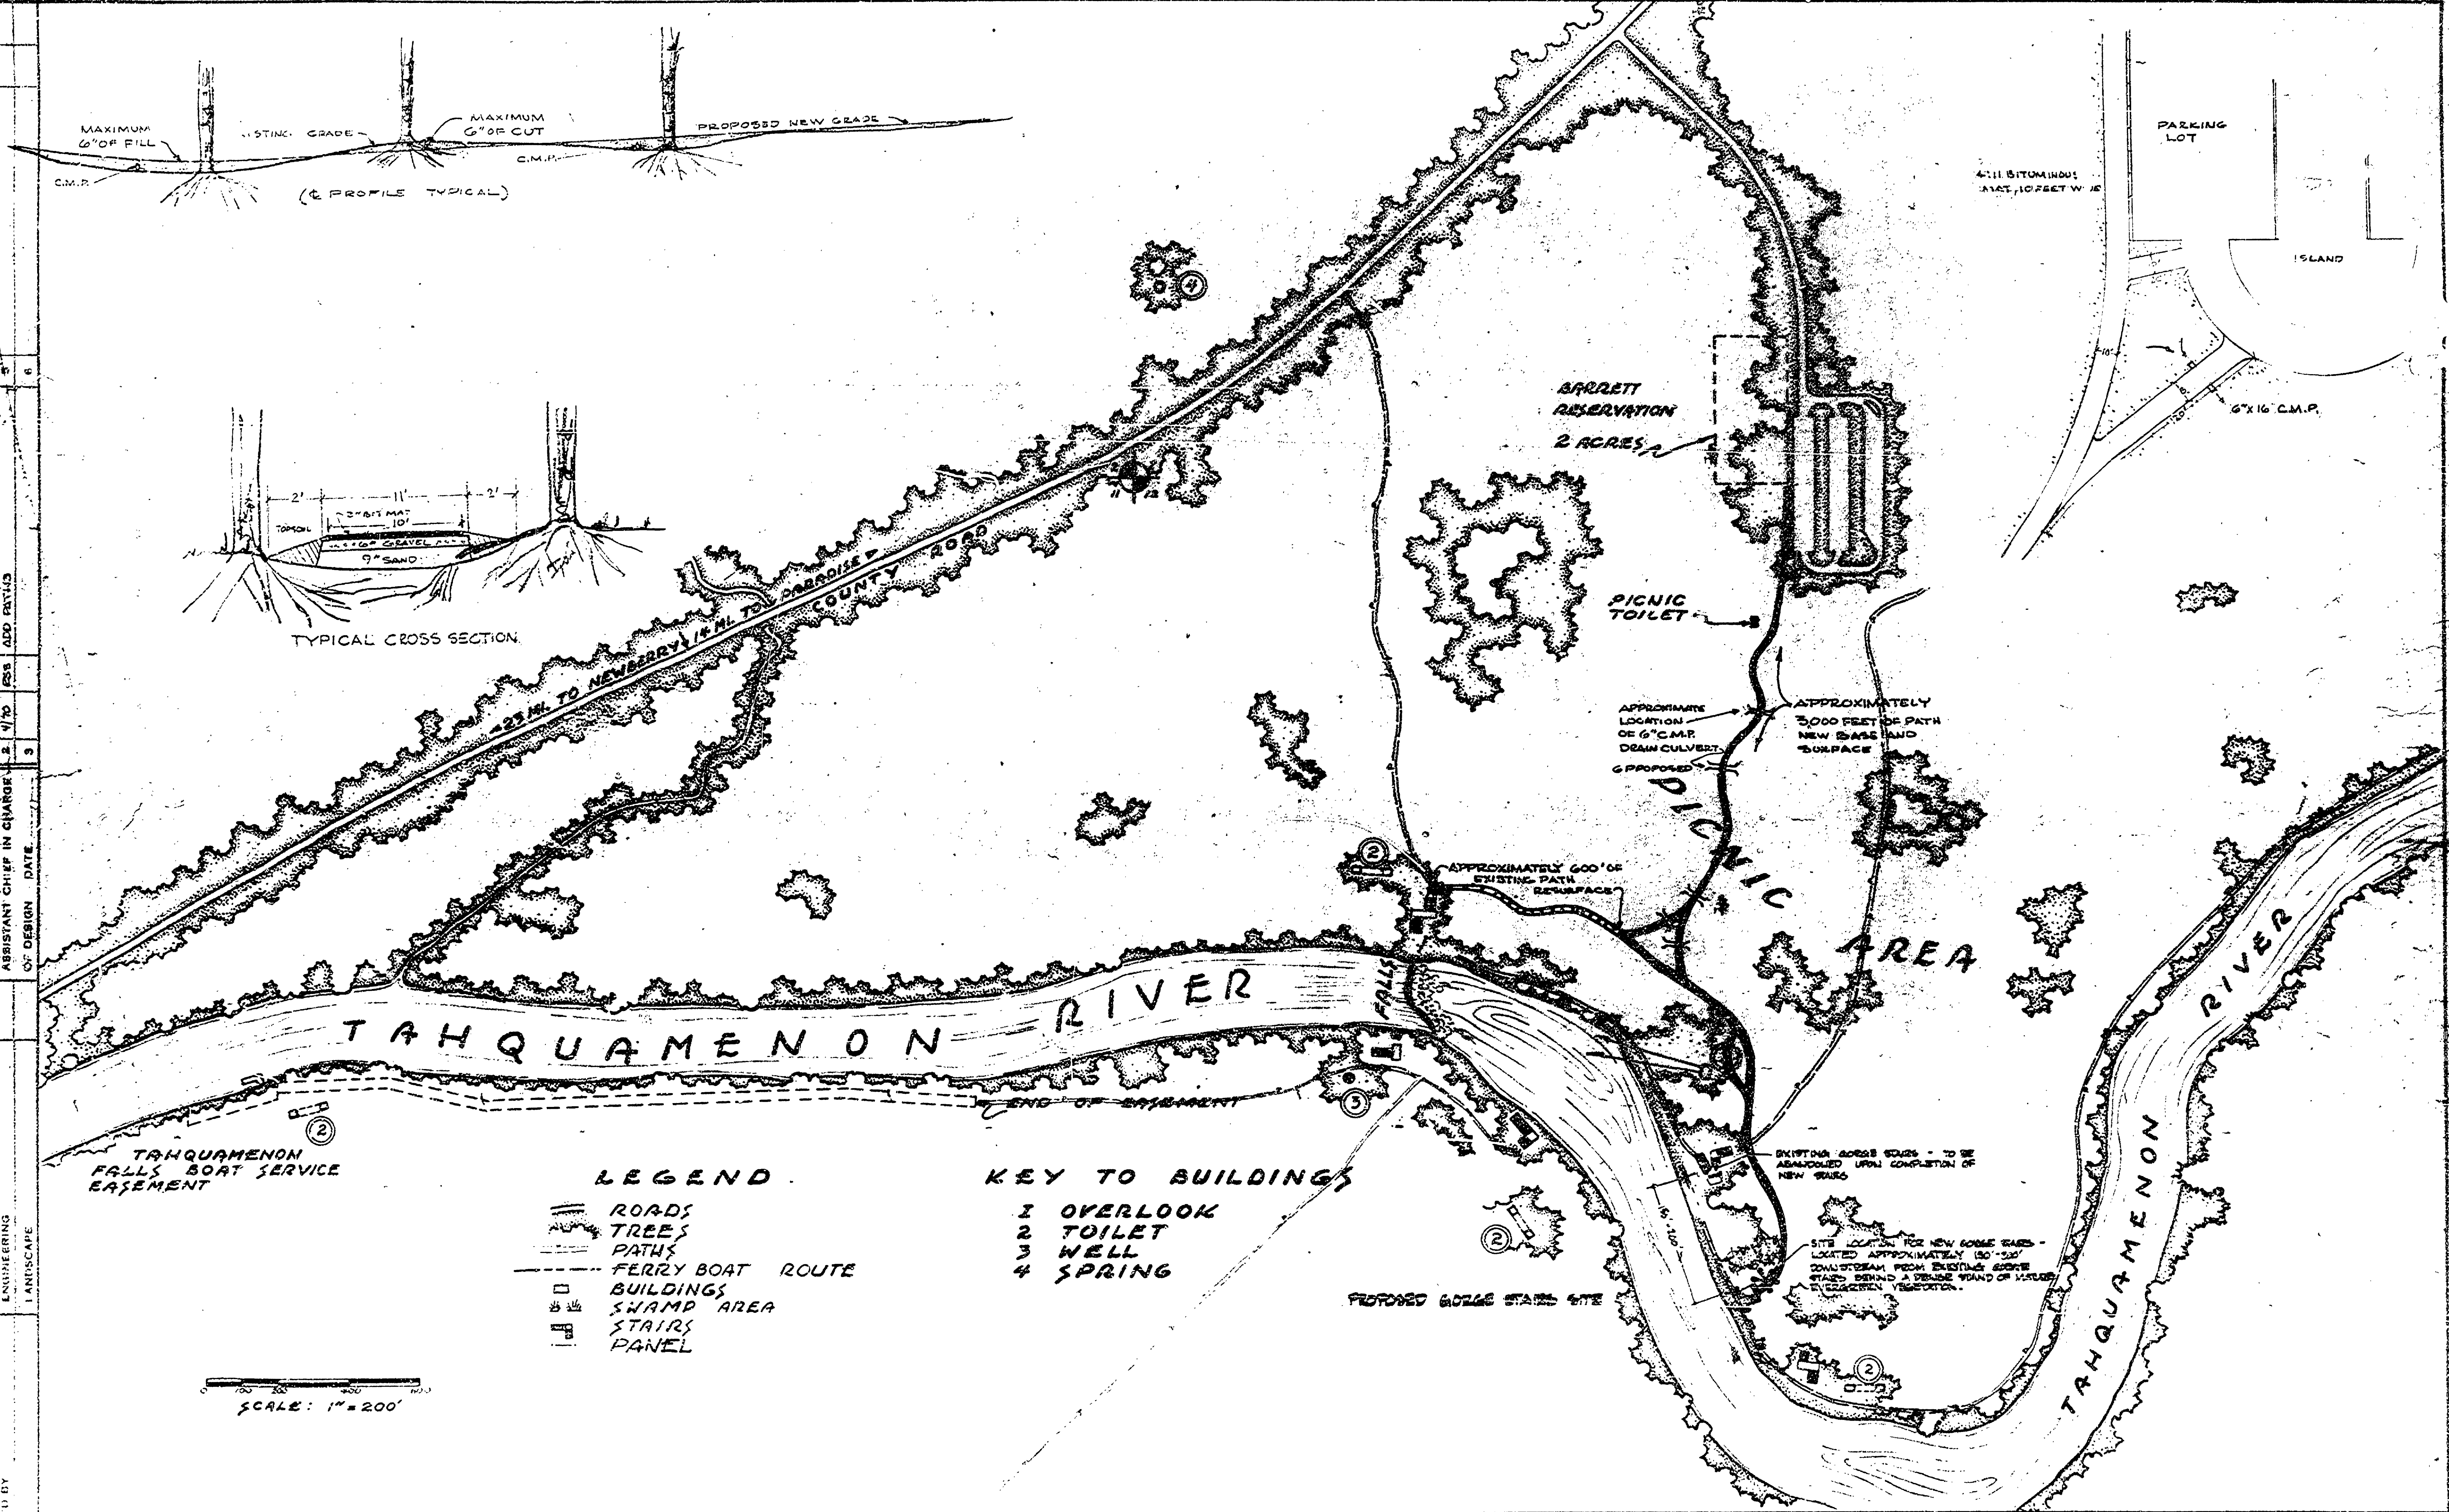
REVISIONS	NO.	DATE	BY	DESCRIPTION
	1	7/15/97	GEN	ADD PATHS
	2	4/10	ESS	ADD PATHS
	3			

APPROVED BY	DATE	REVIEWED BY SECTIONS
ASSISTANT CHIEF IN CHARGE		ARCHITECTURAL ENGINEERING LANDSCAPE

DRAWN BY	TRACED BY	CHECKED BY	DATE



- LEGEND**
- ROADS
  - TREES
  - PATHS
  - - - FERRY BOAT ROUTE
  - BUILDINGS
  - SWAMP AREA
  - STAIRS
  - PANEL
- KEY TO BUILDINGS**
- 1 OVERLOOK
  - 2 TOILET
  - 3 WELL
  - 4 SPRING

SCALE: 1" = 200'