



DESIGNED BY	DATE	REVIEWED	DATE	APPROVED	DATE	NO.	DATE	BY	REVISIONS	DATE	BY
DRIVEN BY	8/1/62	ARCHITECTURAL				1			4		
CHECKED BY	8/1/62	ENGINEERING				2			5		
		LANDSCAPE				3			6		

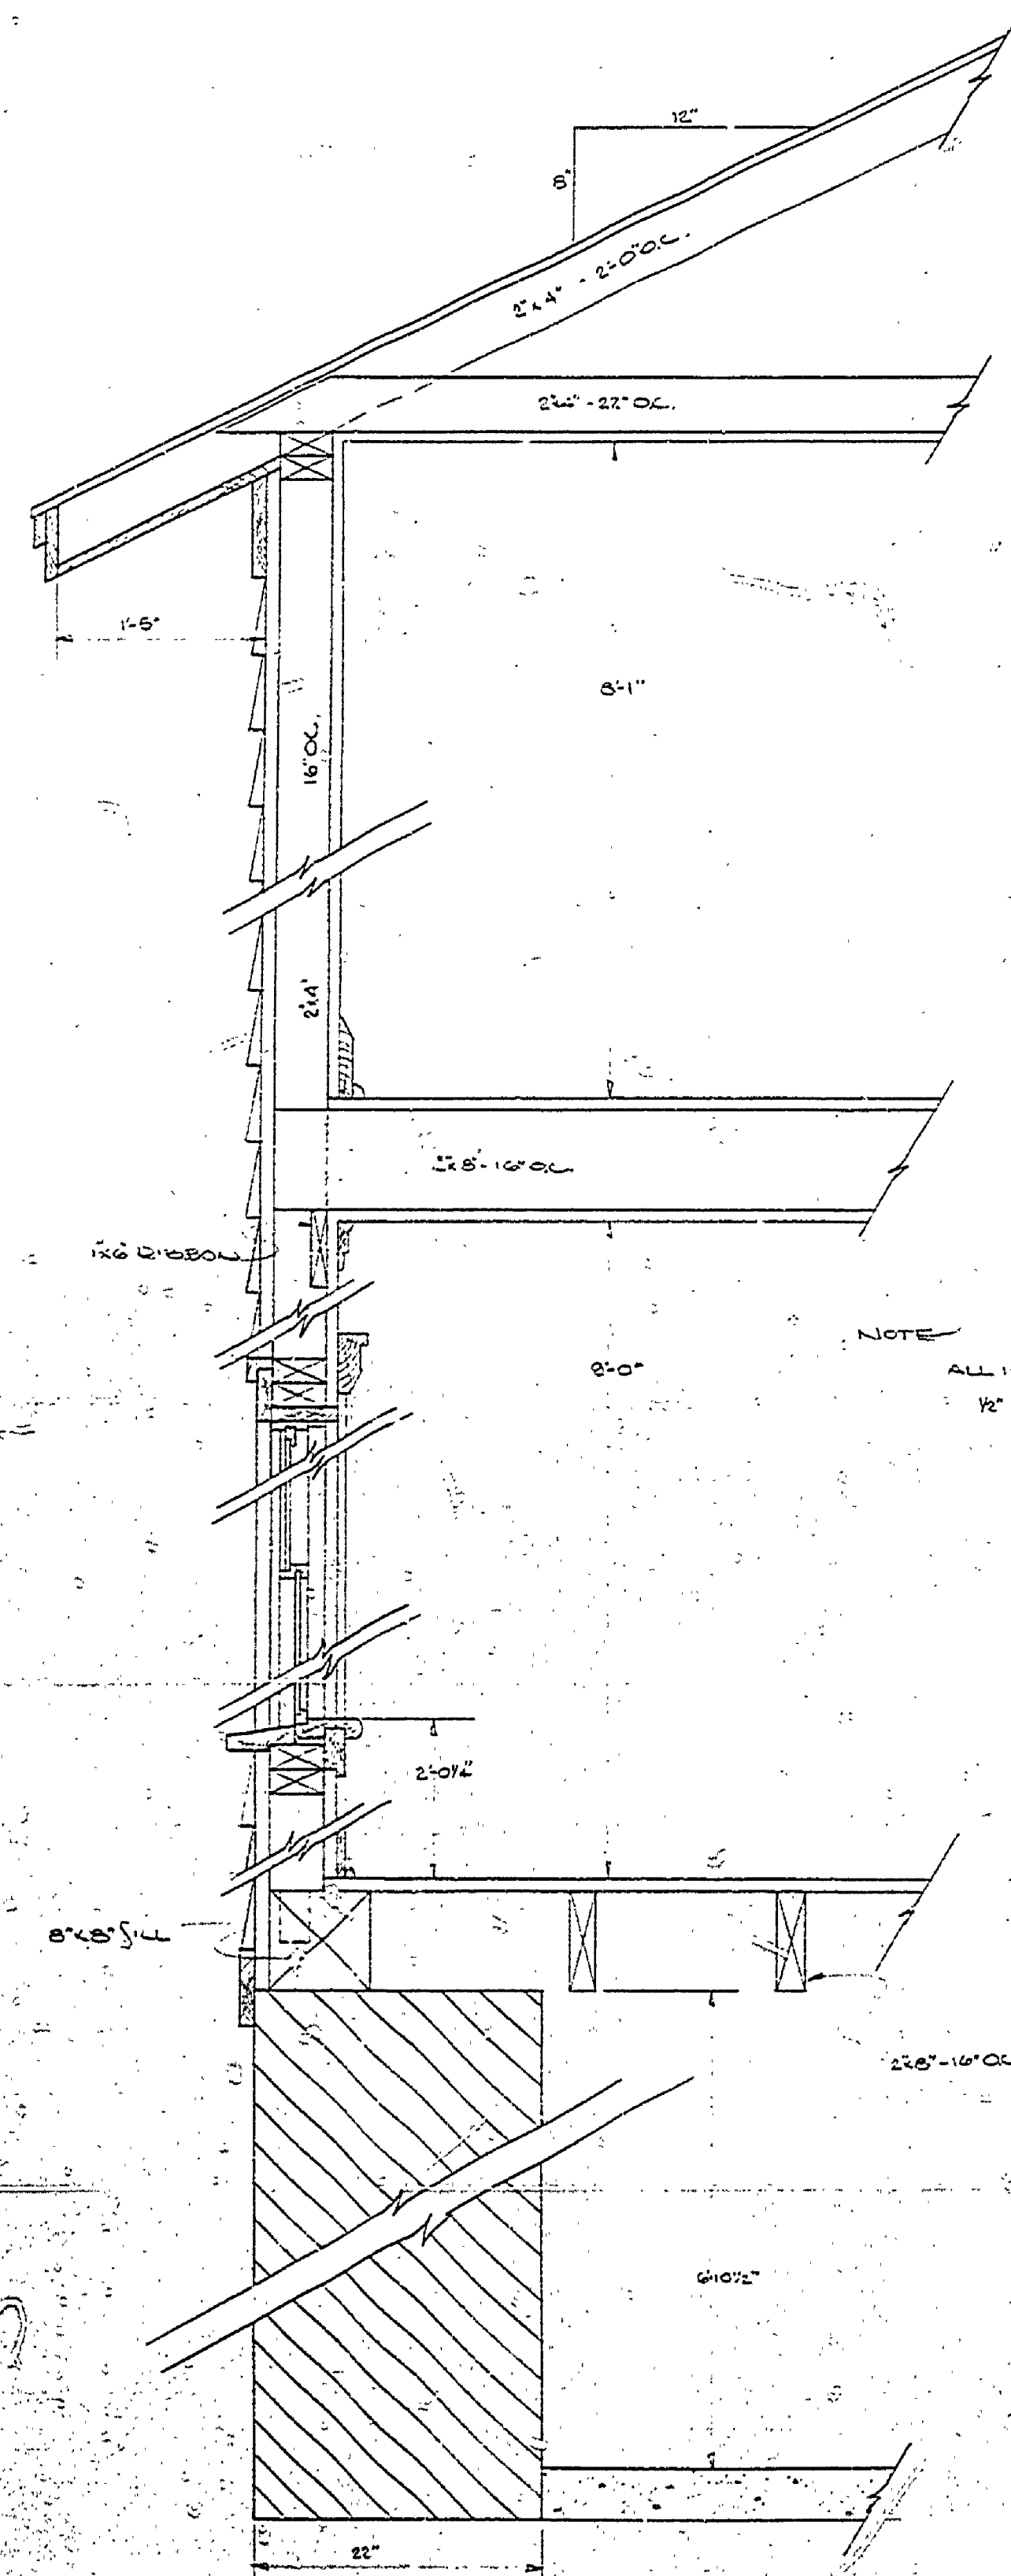


SECTION 'A-A'

NOTE  
ALL INTERIOR WALLS ARE OF  
1/2\"/>

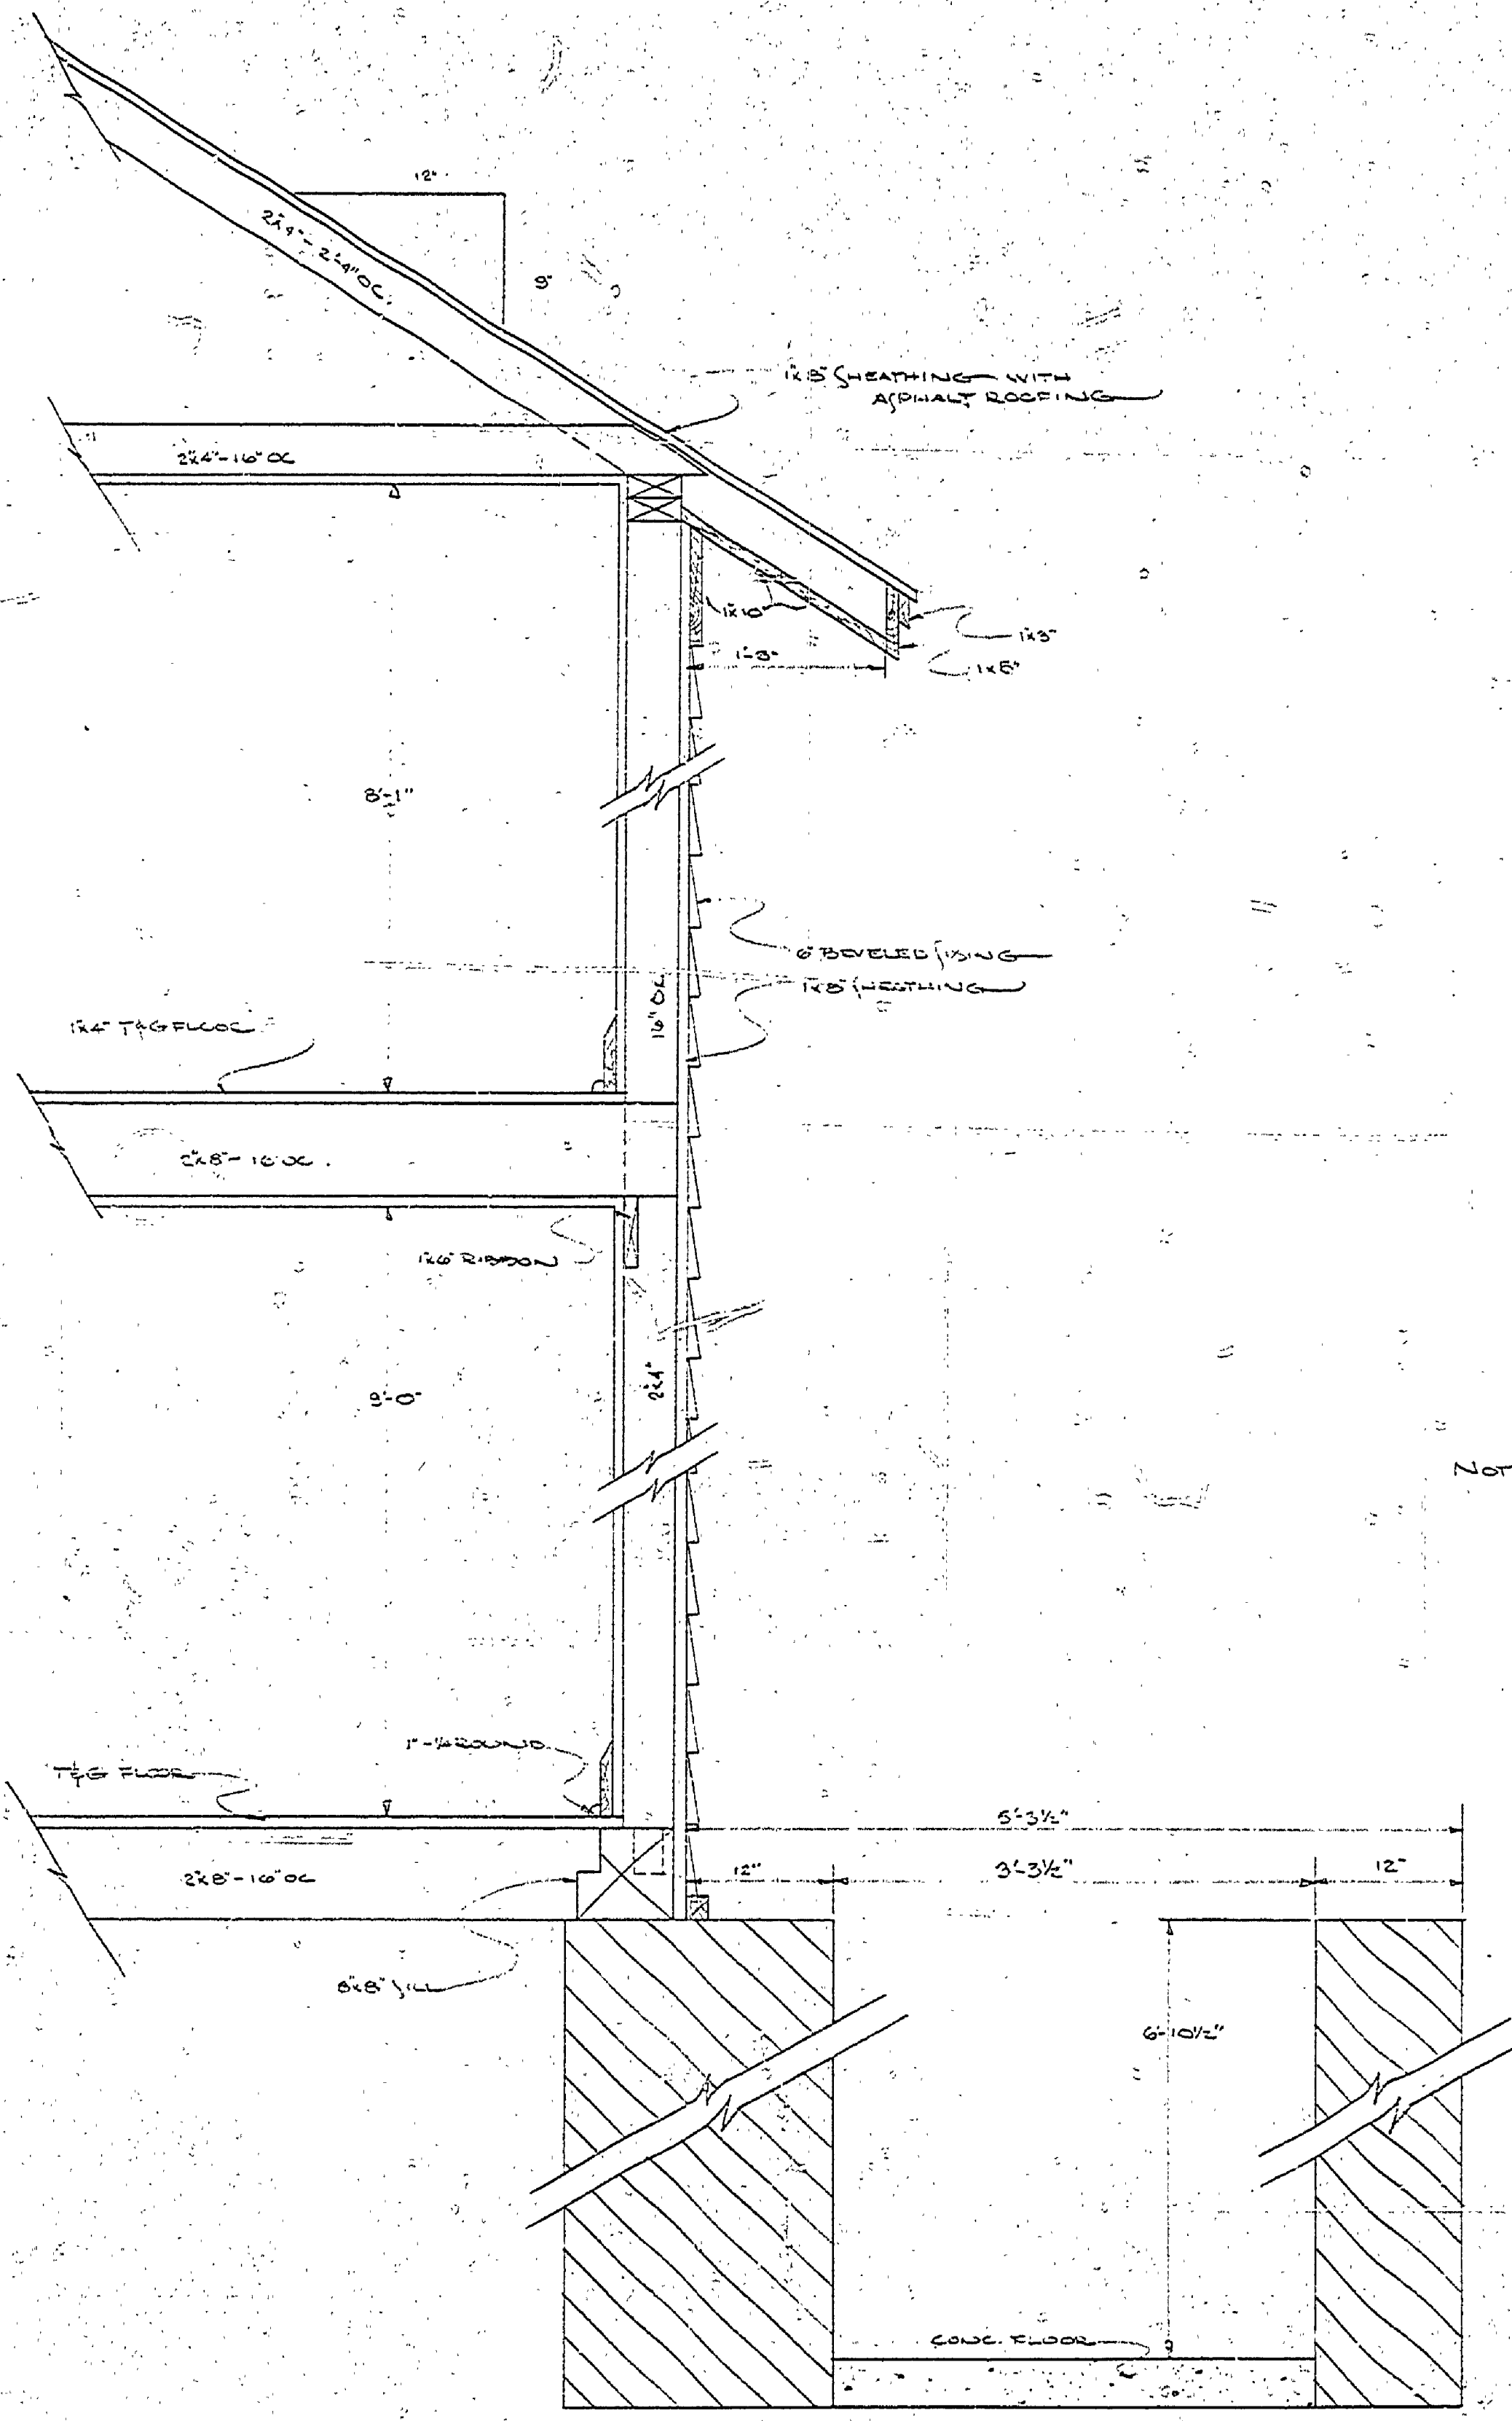

SECTION 'B-B'

SCALE 1/4\"/>

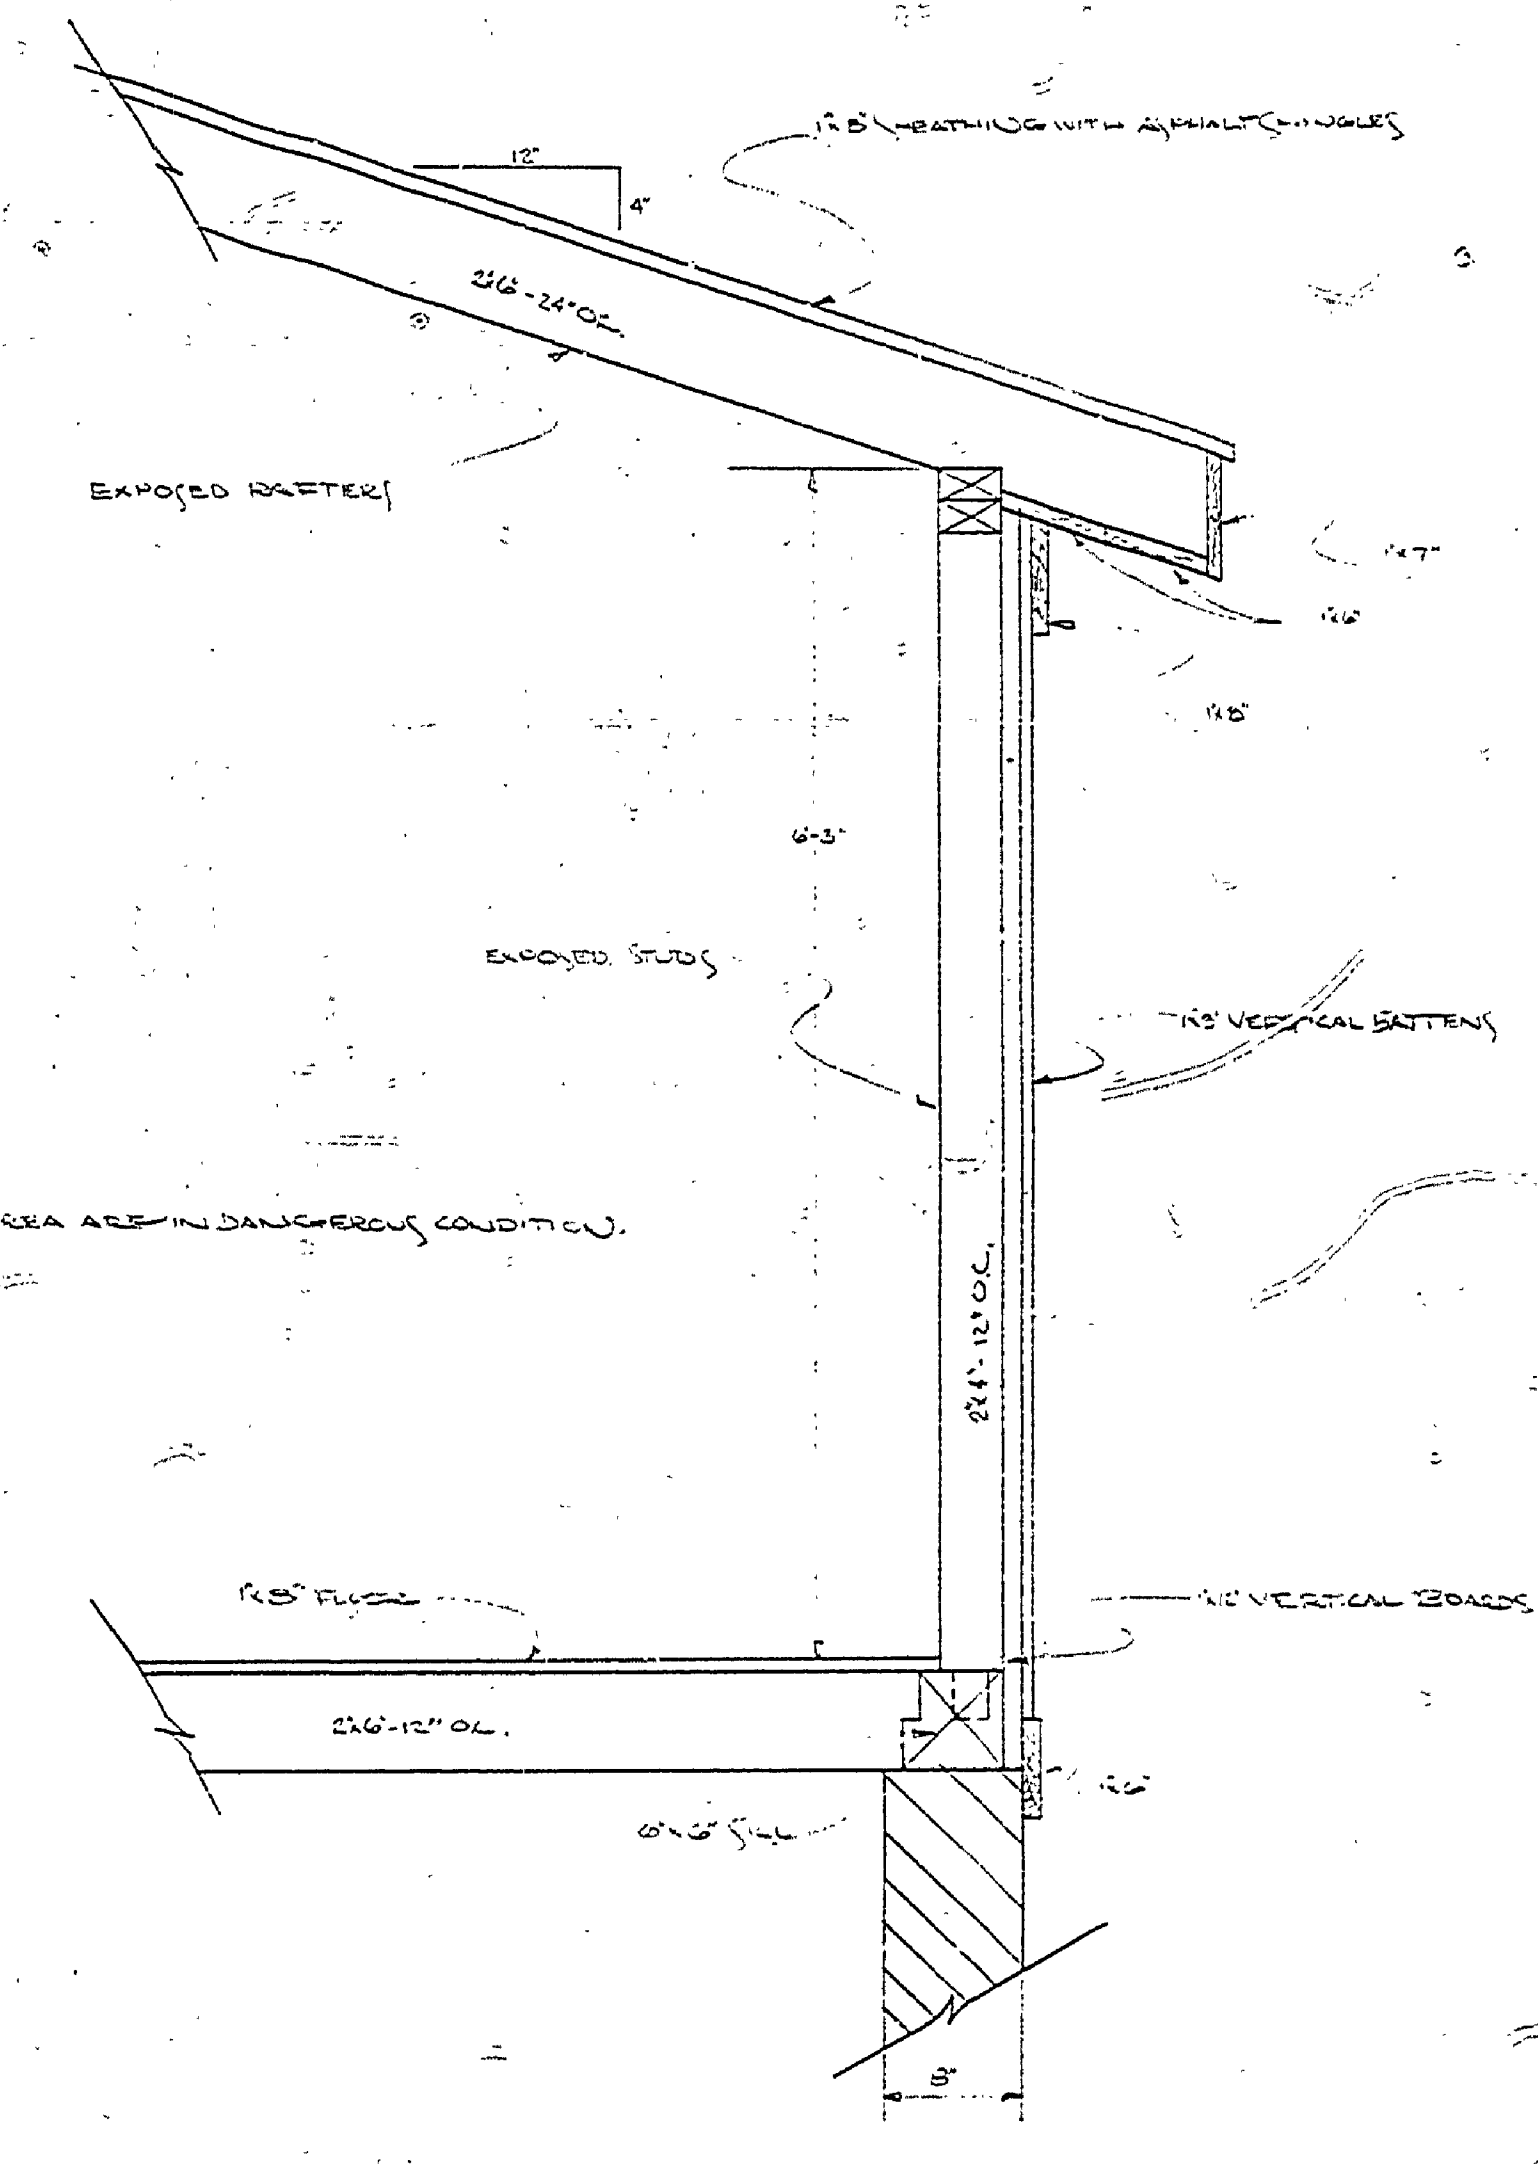

SECTION 'C-C'

NOTE  
FLOOR & FLOOR JOISTS IN THIS AREA ARE IN DANGEROUS CONDITION.

BUILDING # 1

MICHIGAN  
DEPARTMENT OF CONSERVATION  
PARKS AND RECREATION DIVISION

MEASURED DRAWING  
FAYETTE HISTORICAL TOWNSITE  
FAYETTE STATE PARK

SHEET  
NO. 4  
OF 5  
PLAN NO.  
A-1