




DESIGNED BY	DATE	REVIEWED	DATE	APPROVED	DATE NO.	DATE BY	REVISIONS	DATE BY
DR	2/27/74	ARCHITECTURAL			1		4	
DRAWN BY	2/27/74	ENGINEERING			2		5	
CHECKED BY		LANDSCAPE			3		6	

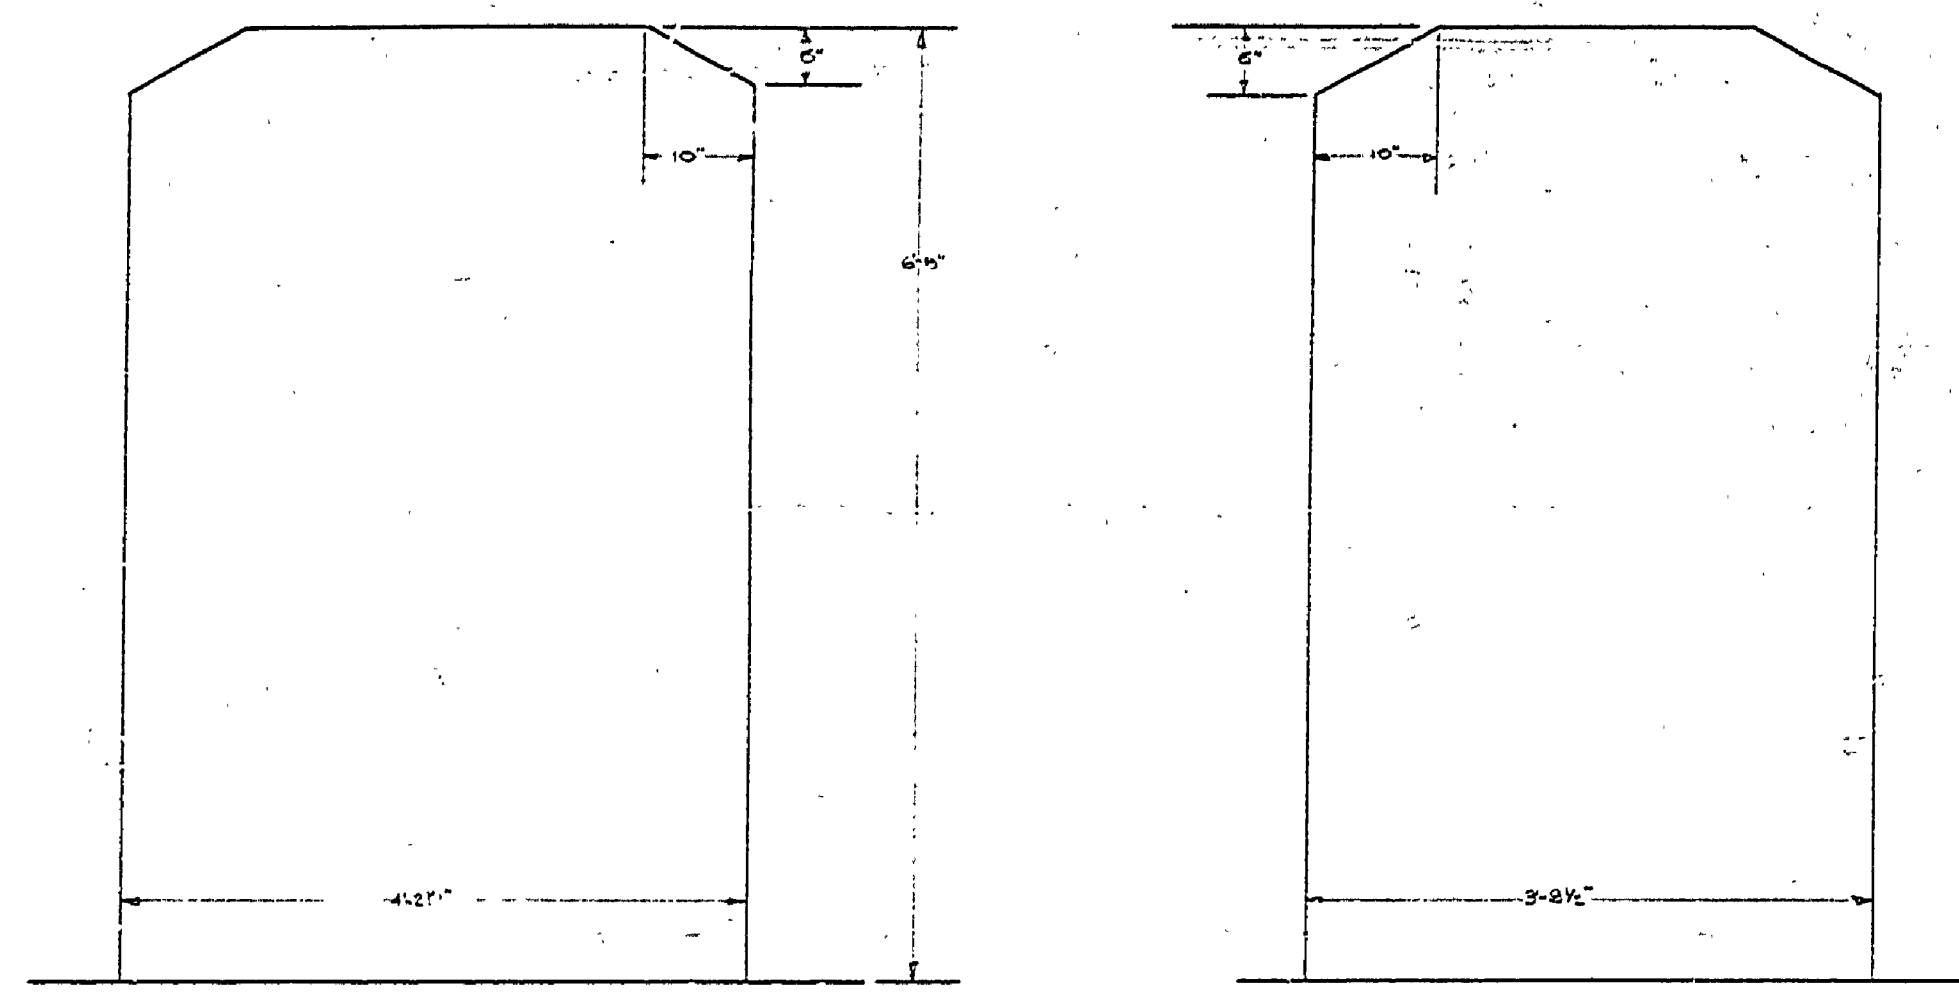


SCALE 3/4"=1'-0"

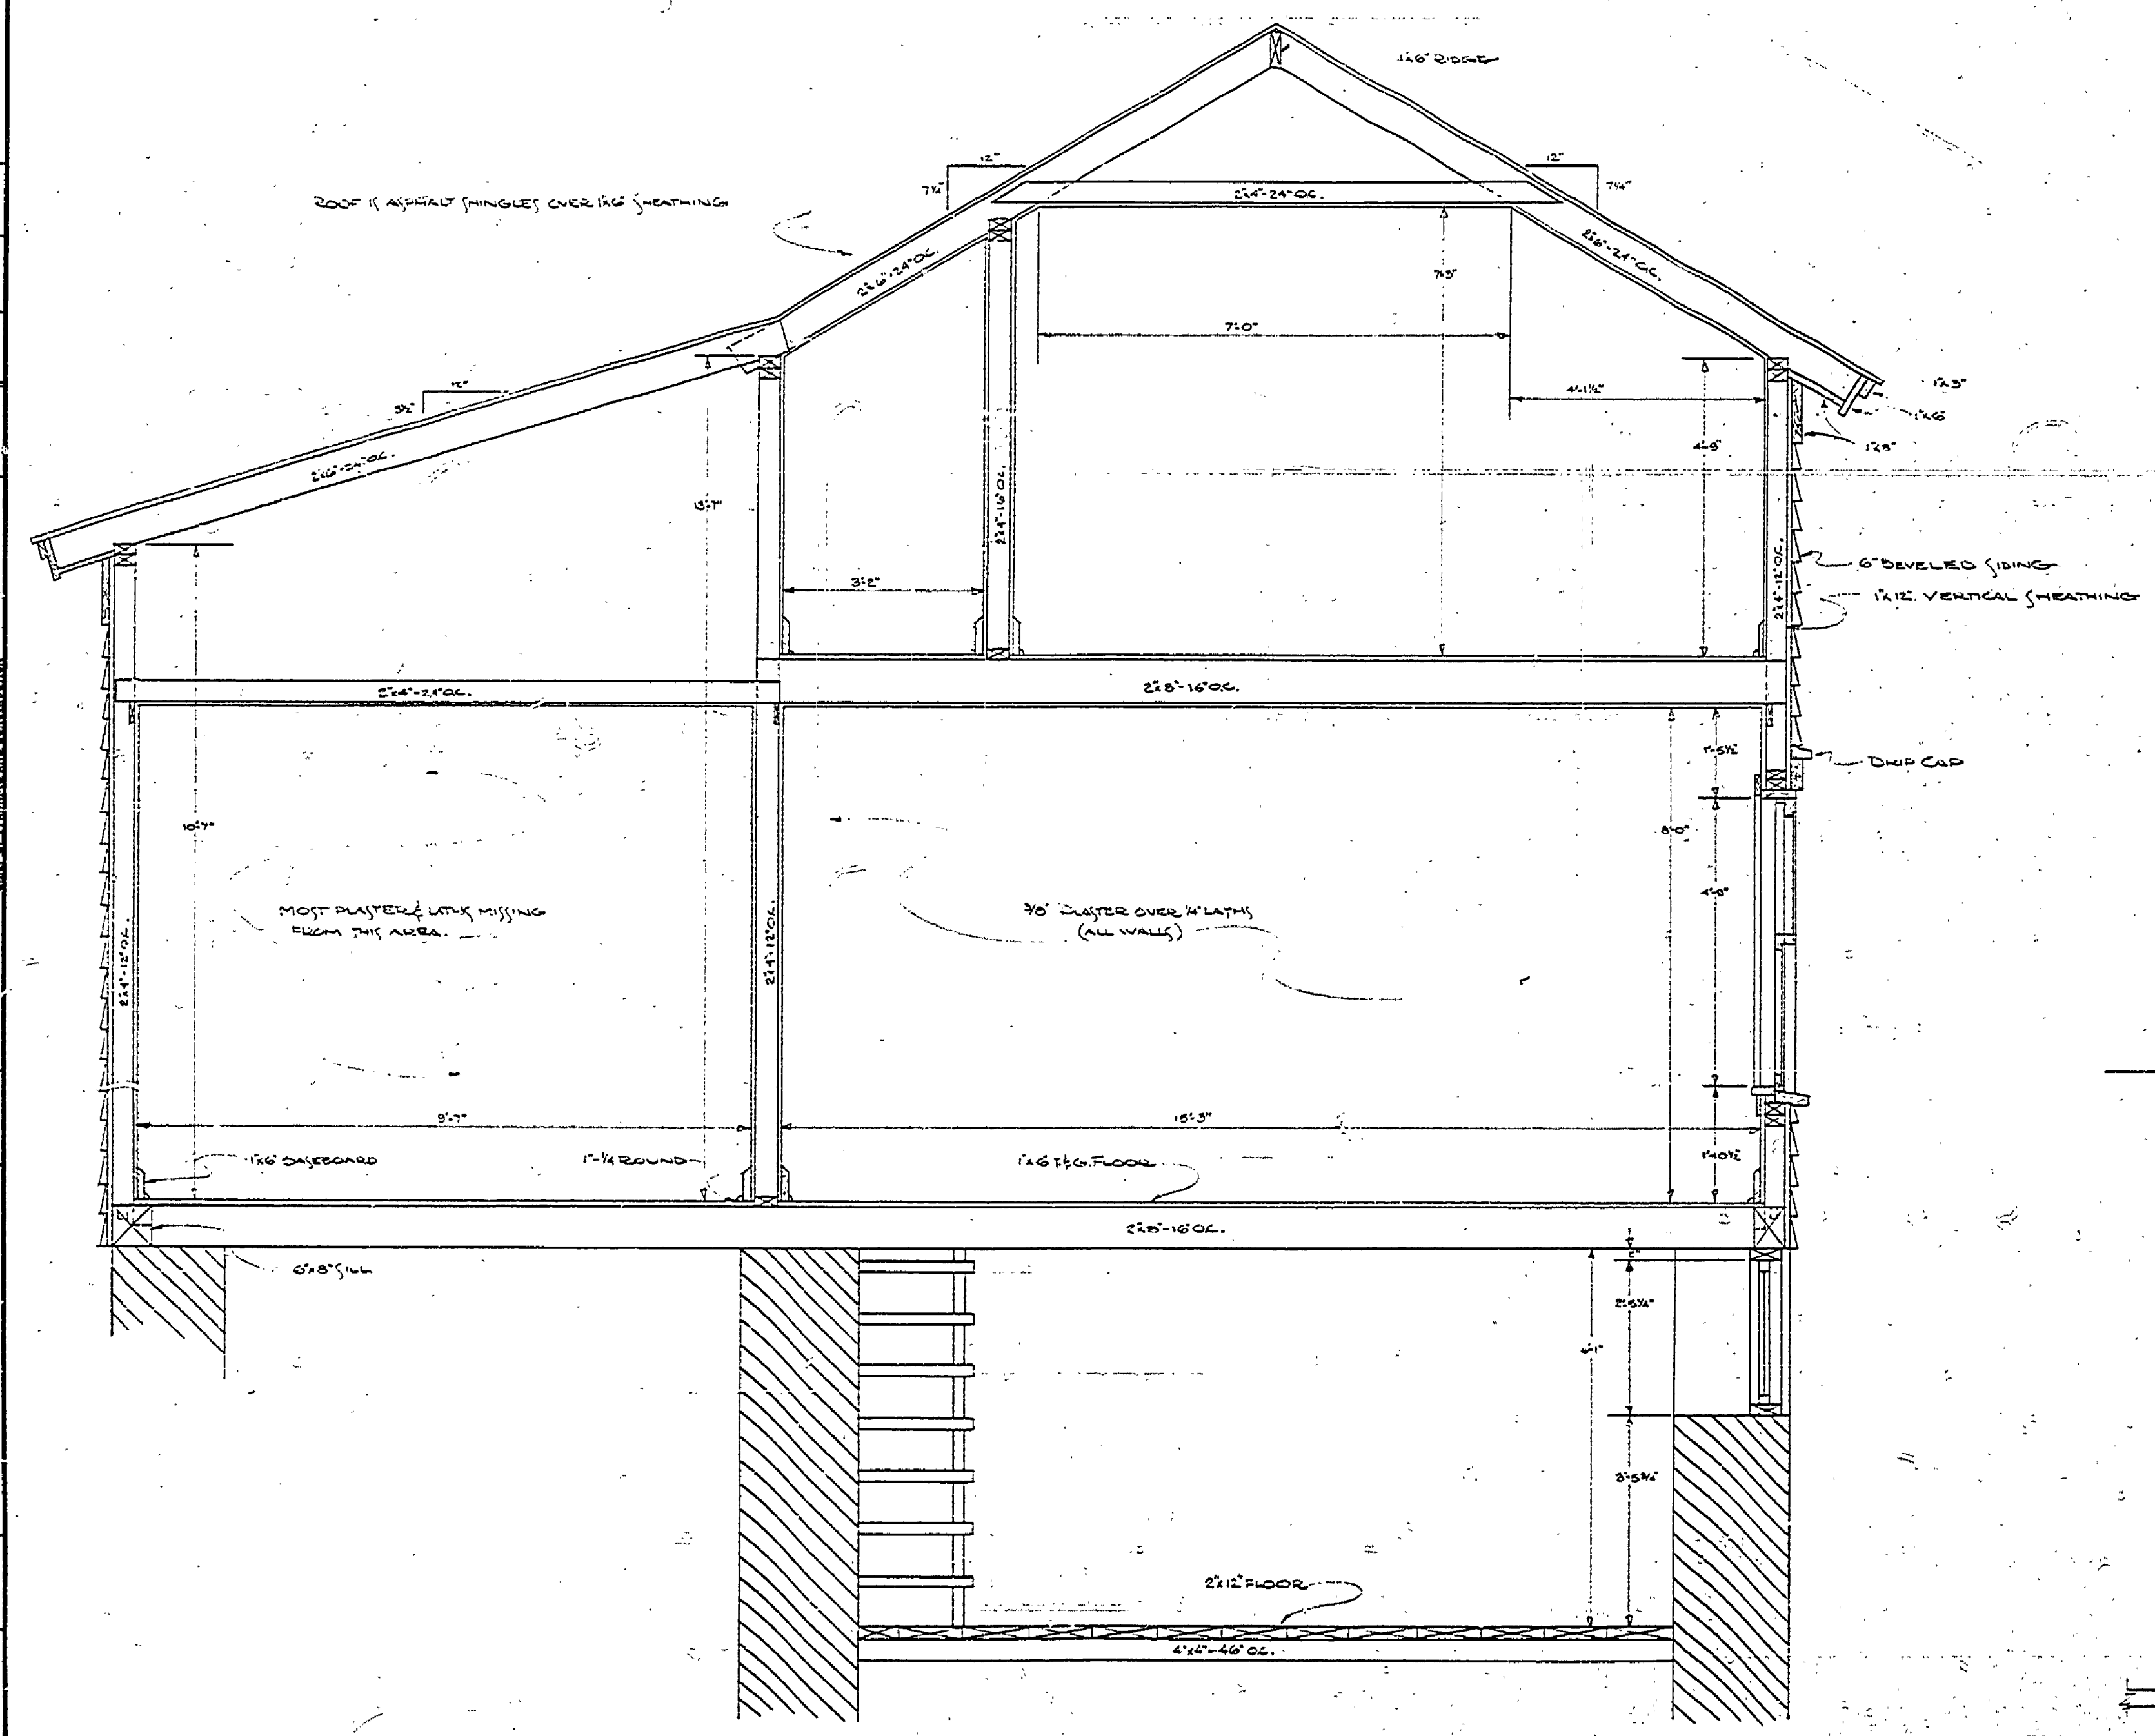


SECTION "A-A"  
SCALE 1/2"=1'-0"

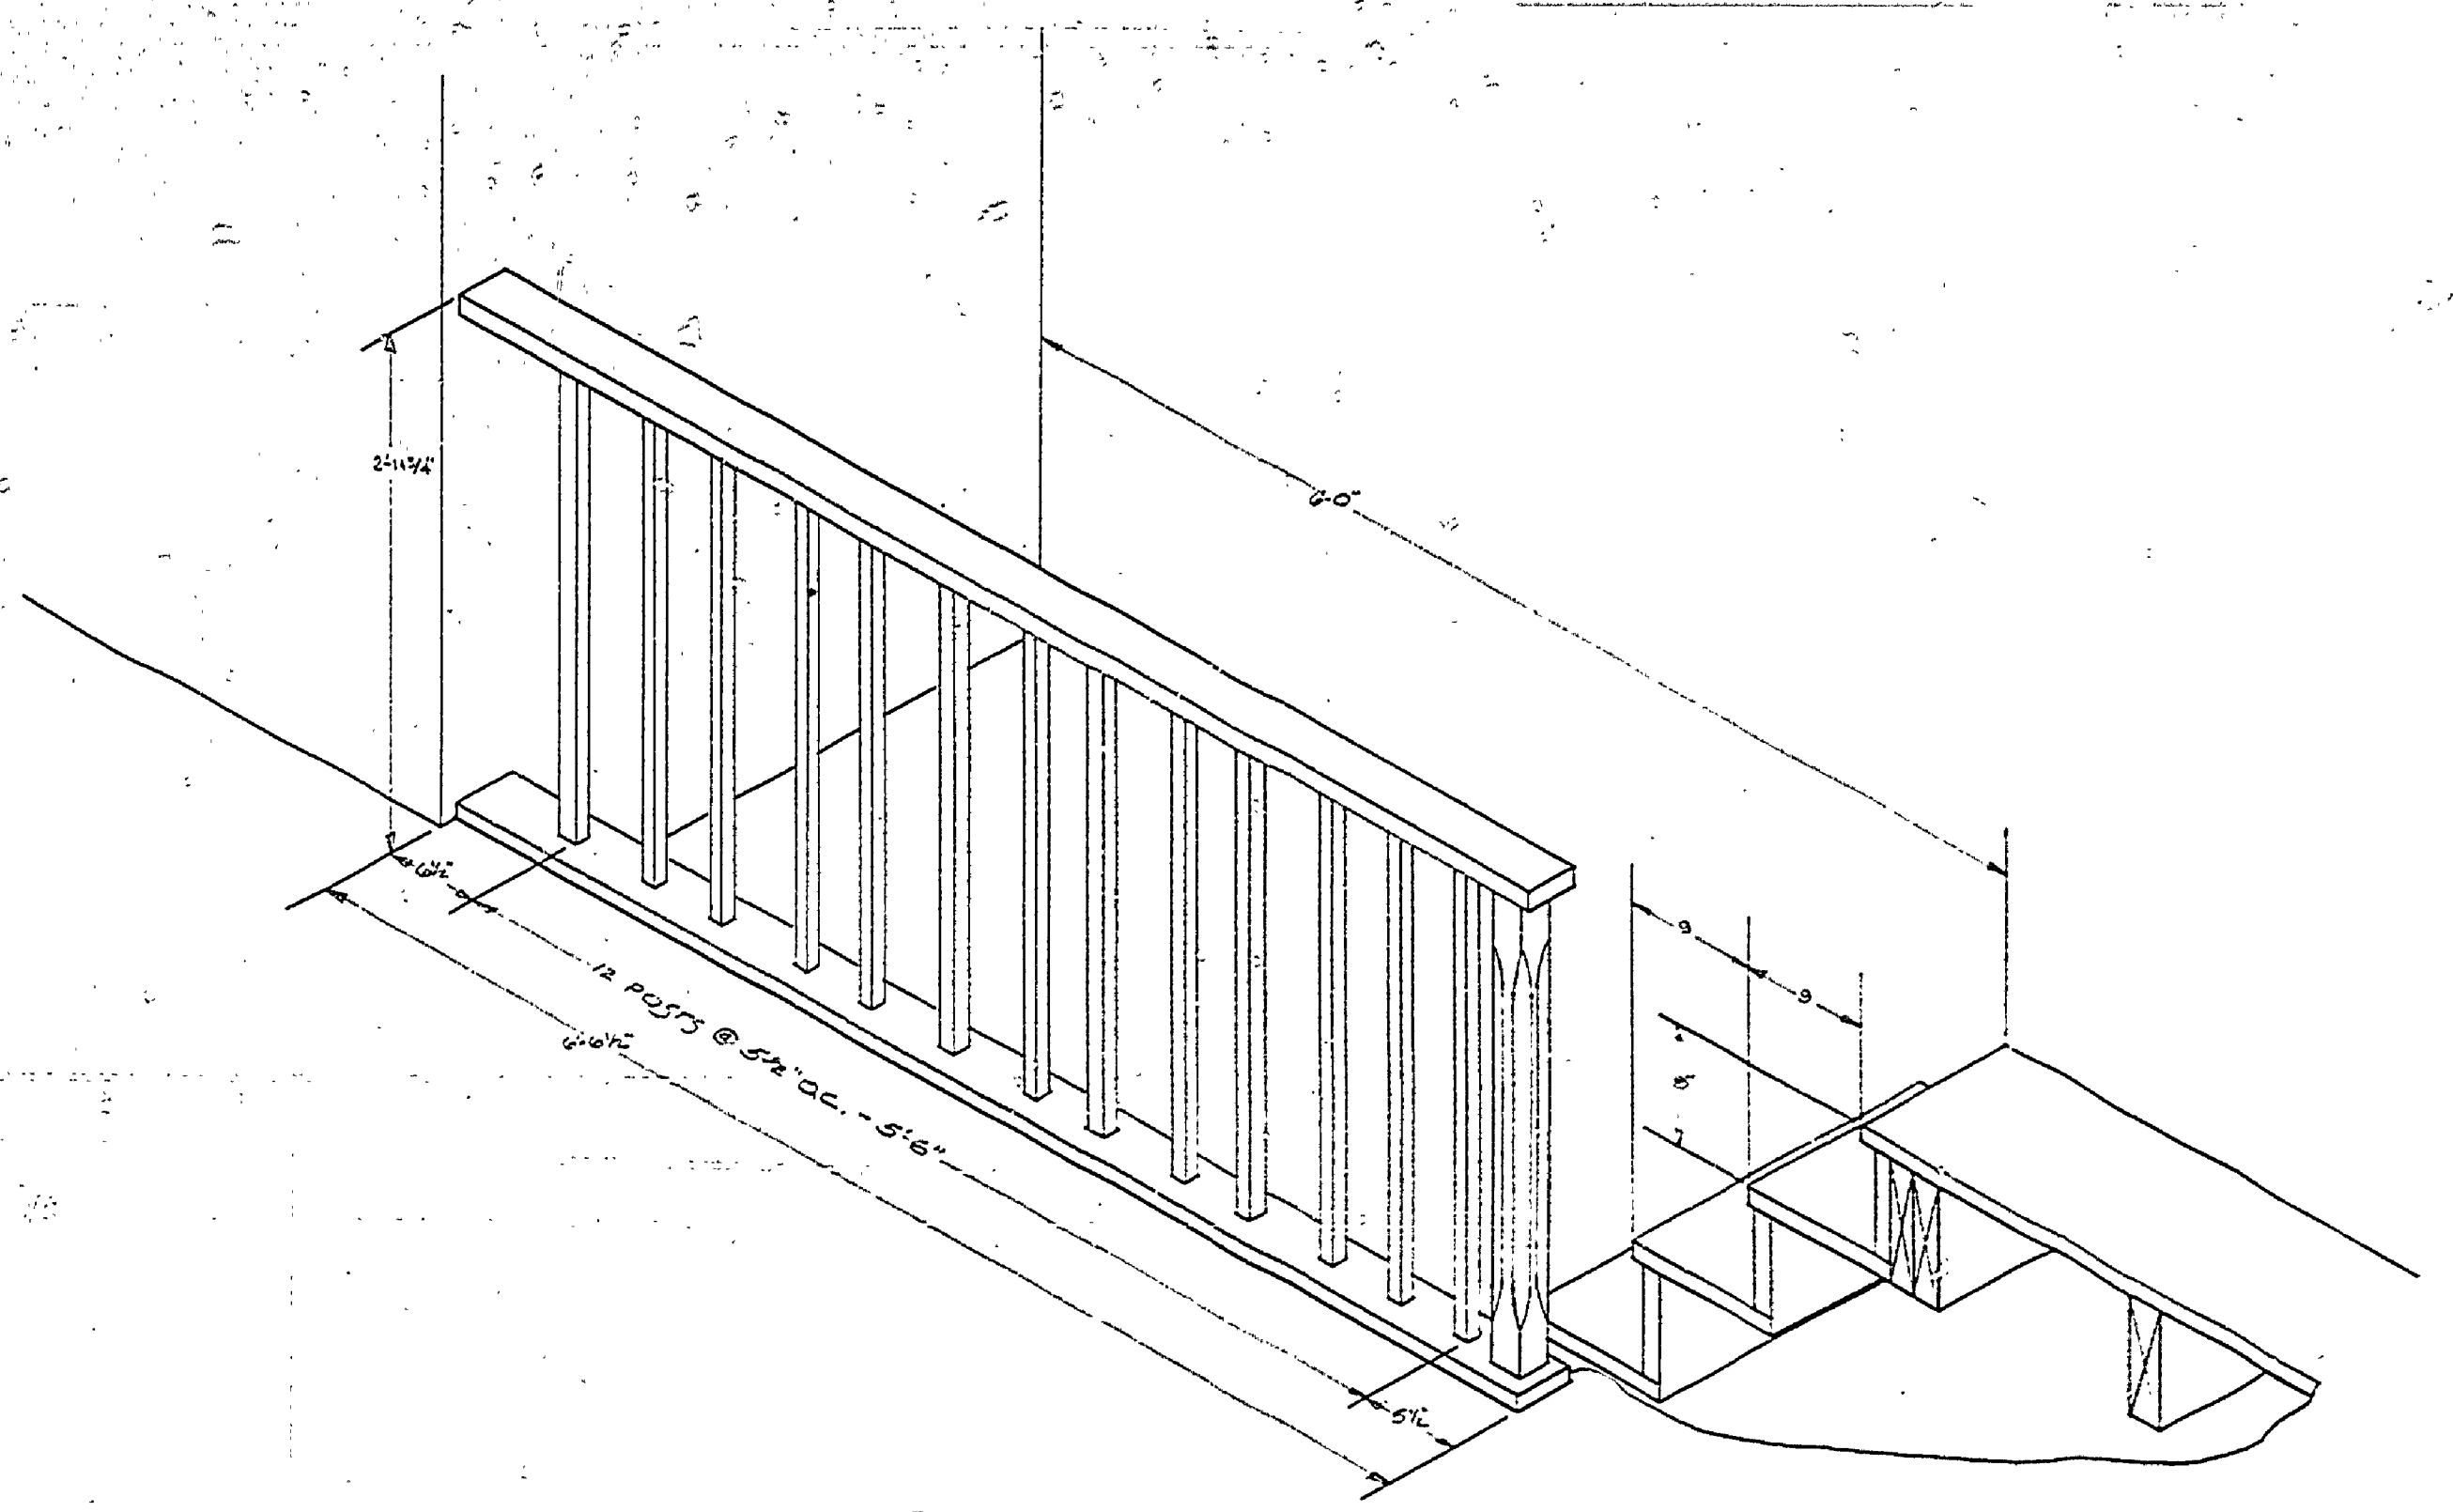

PERSPECTIVE DETAIL OF MAIN STAIRWAY & SAFETY RAIL  
SCALE 1/4"=1'-0"

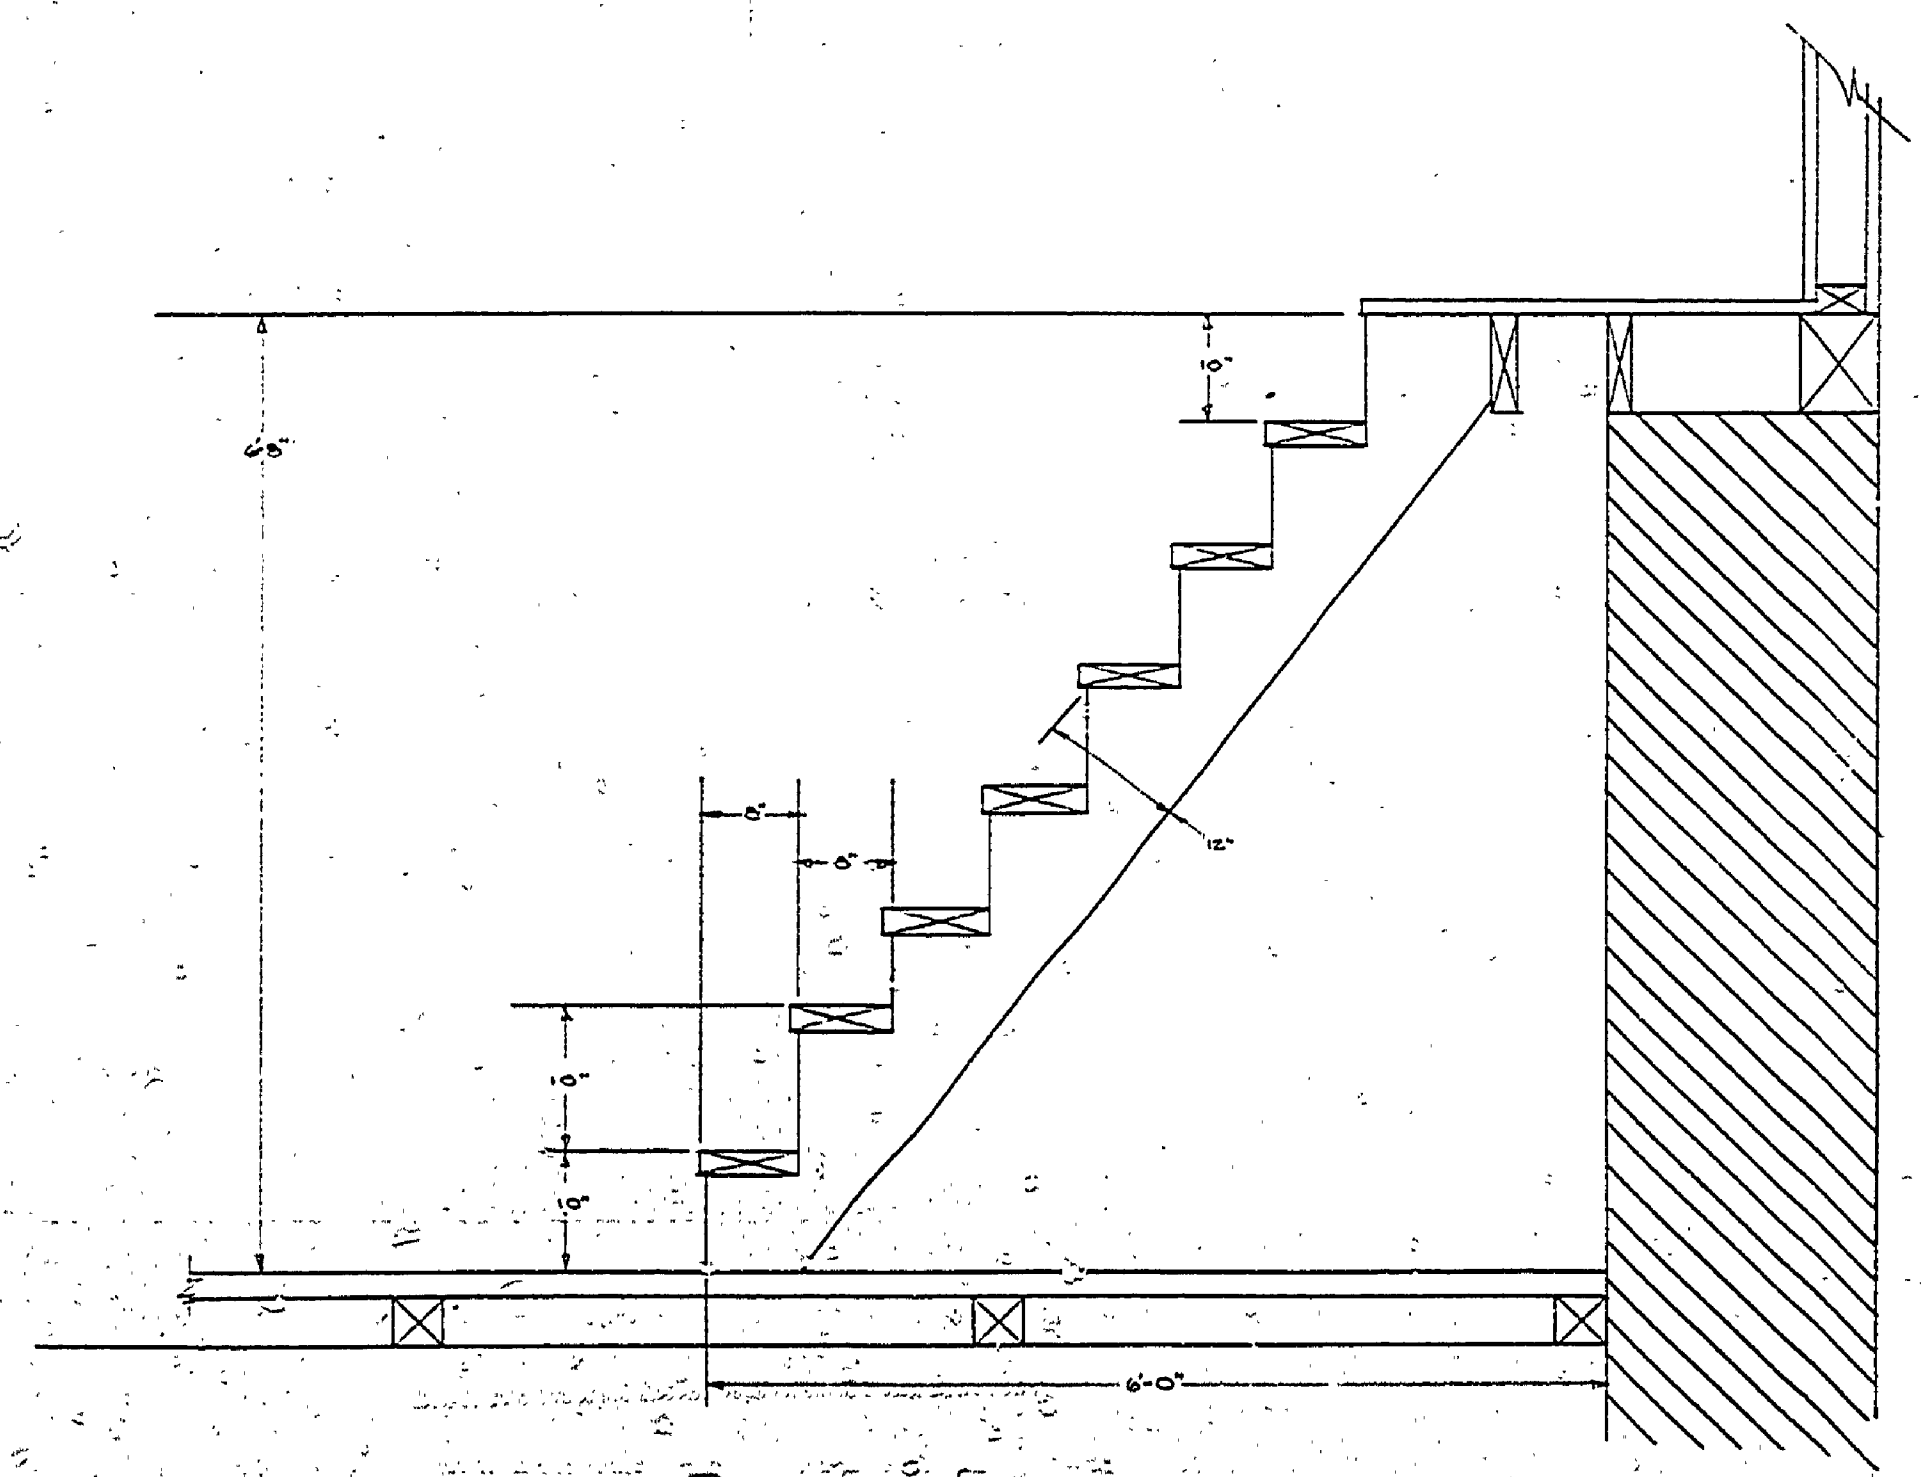

BASEMENT STAIR DETAIL  
SCALE 3/4"=1'-0"

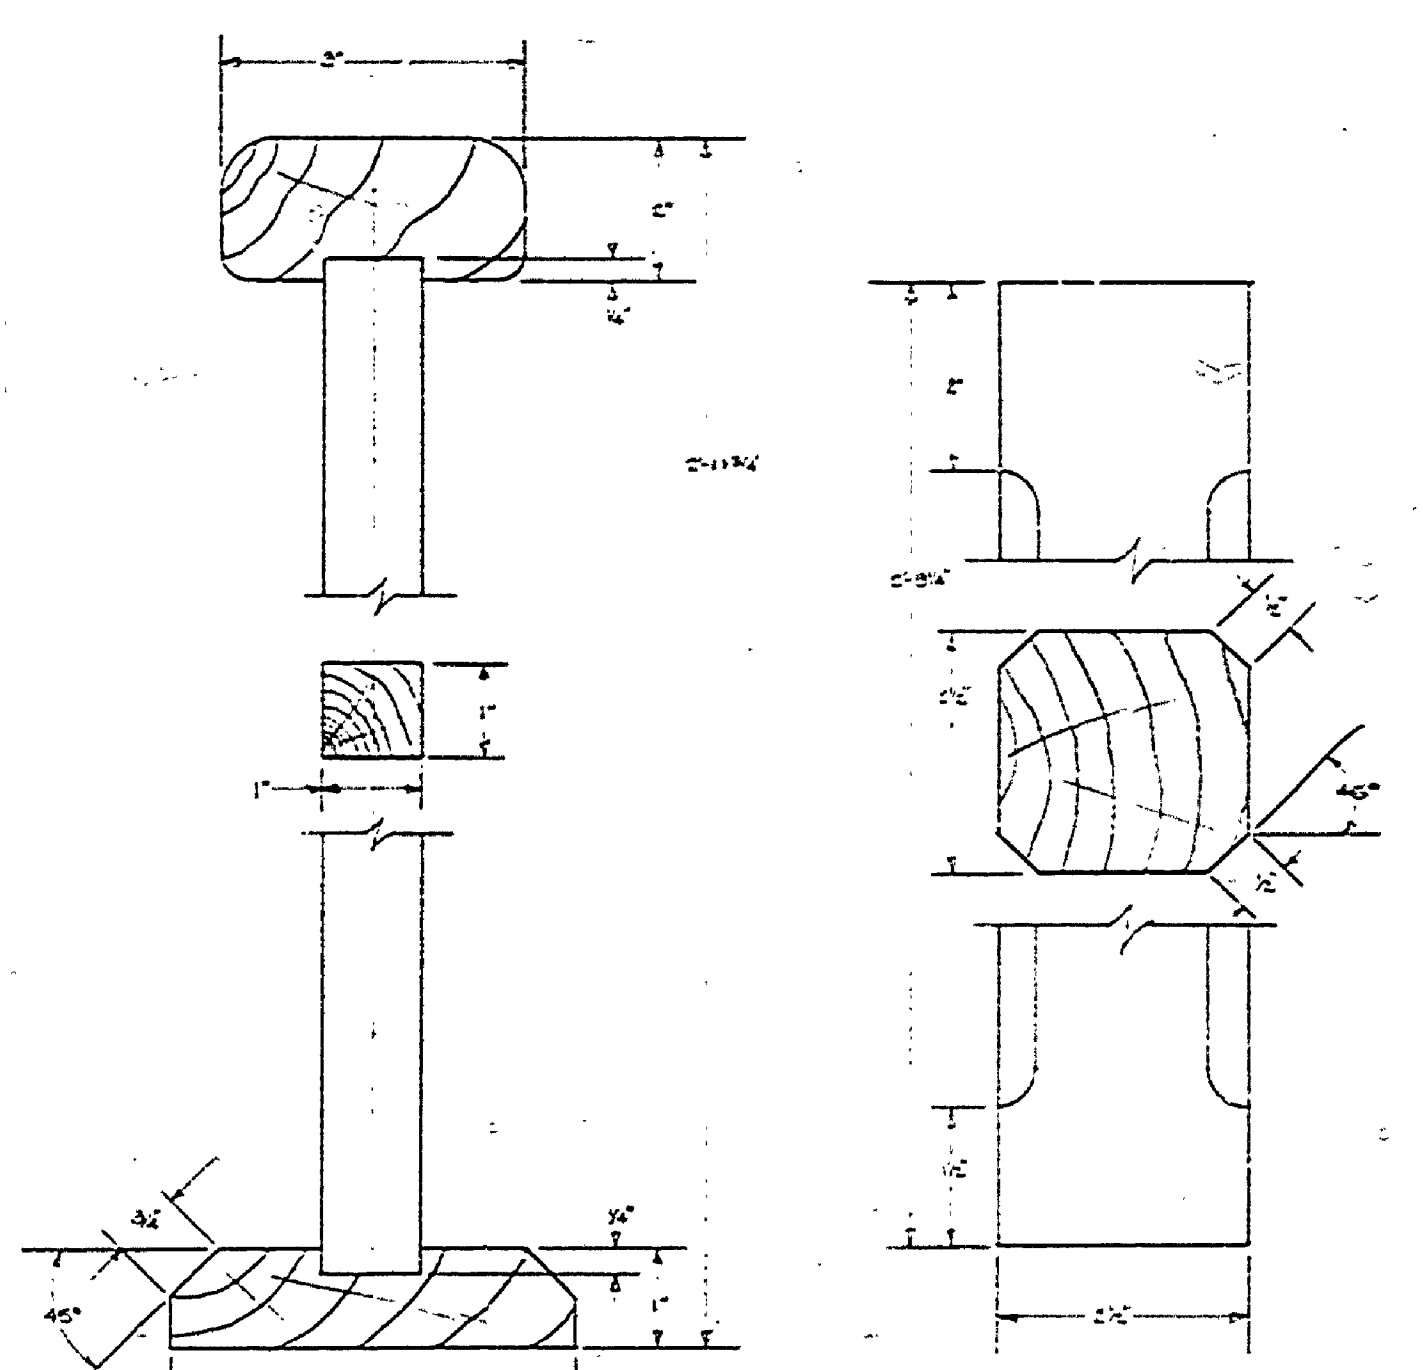

CROSS SECTION MAIN STAIR SAFETY RAIL  
SCALE 1/2"=1'-0"

BUILDING #3

MICHIGAN  
DEPARTMENT OF CONSERVATION  
PARKS AND RECREATION DIVISION

MEASURED DRAWING  
FAYETTE HISTORICAL TOWN SITE  
FAYETTE STATE PARK

SHEET  
NO. 2  
OF 2

PLAN NO.  
A-3