
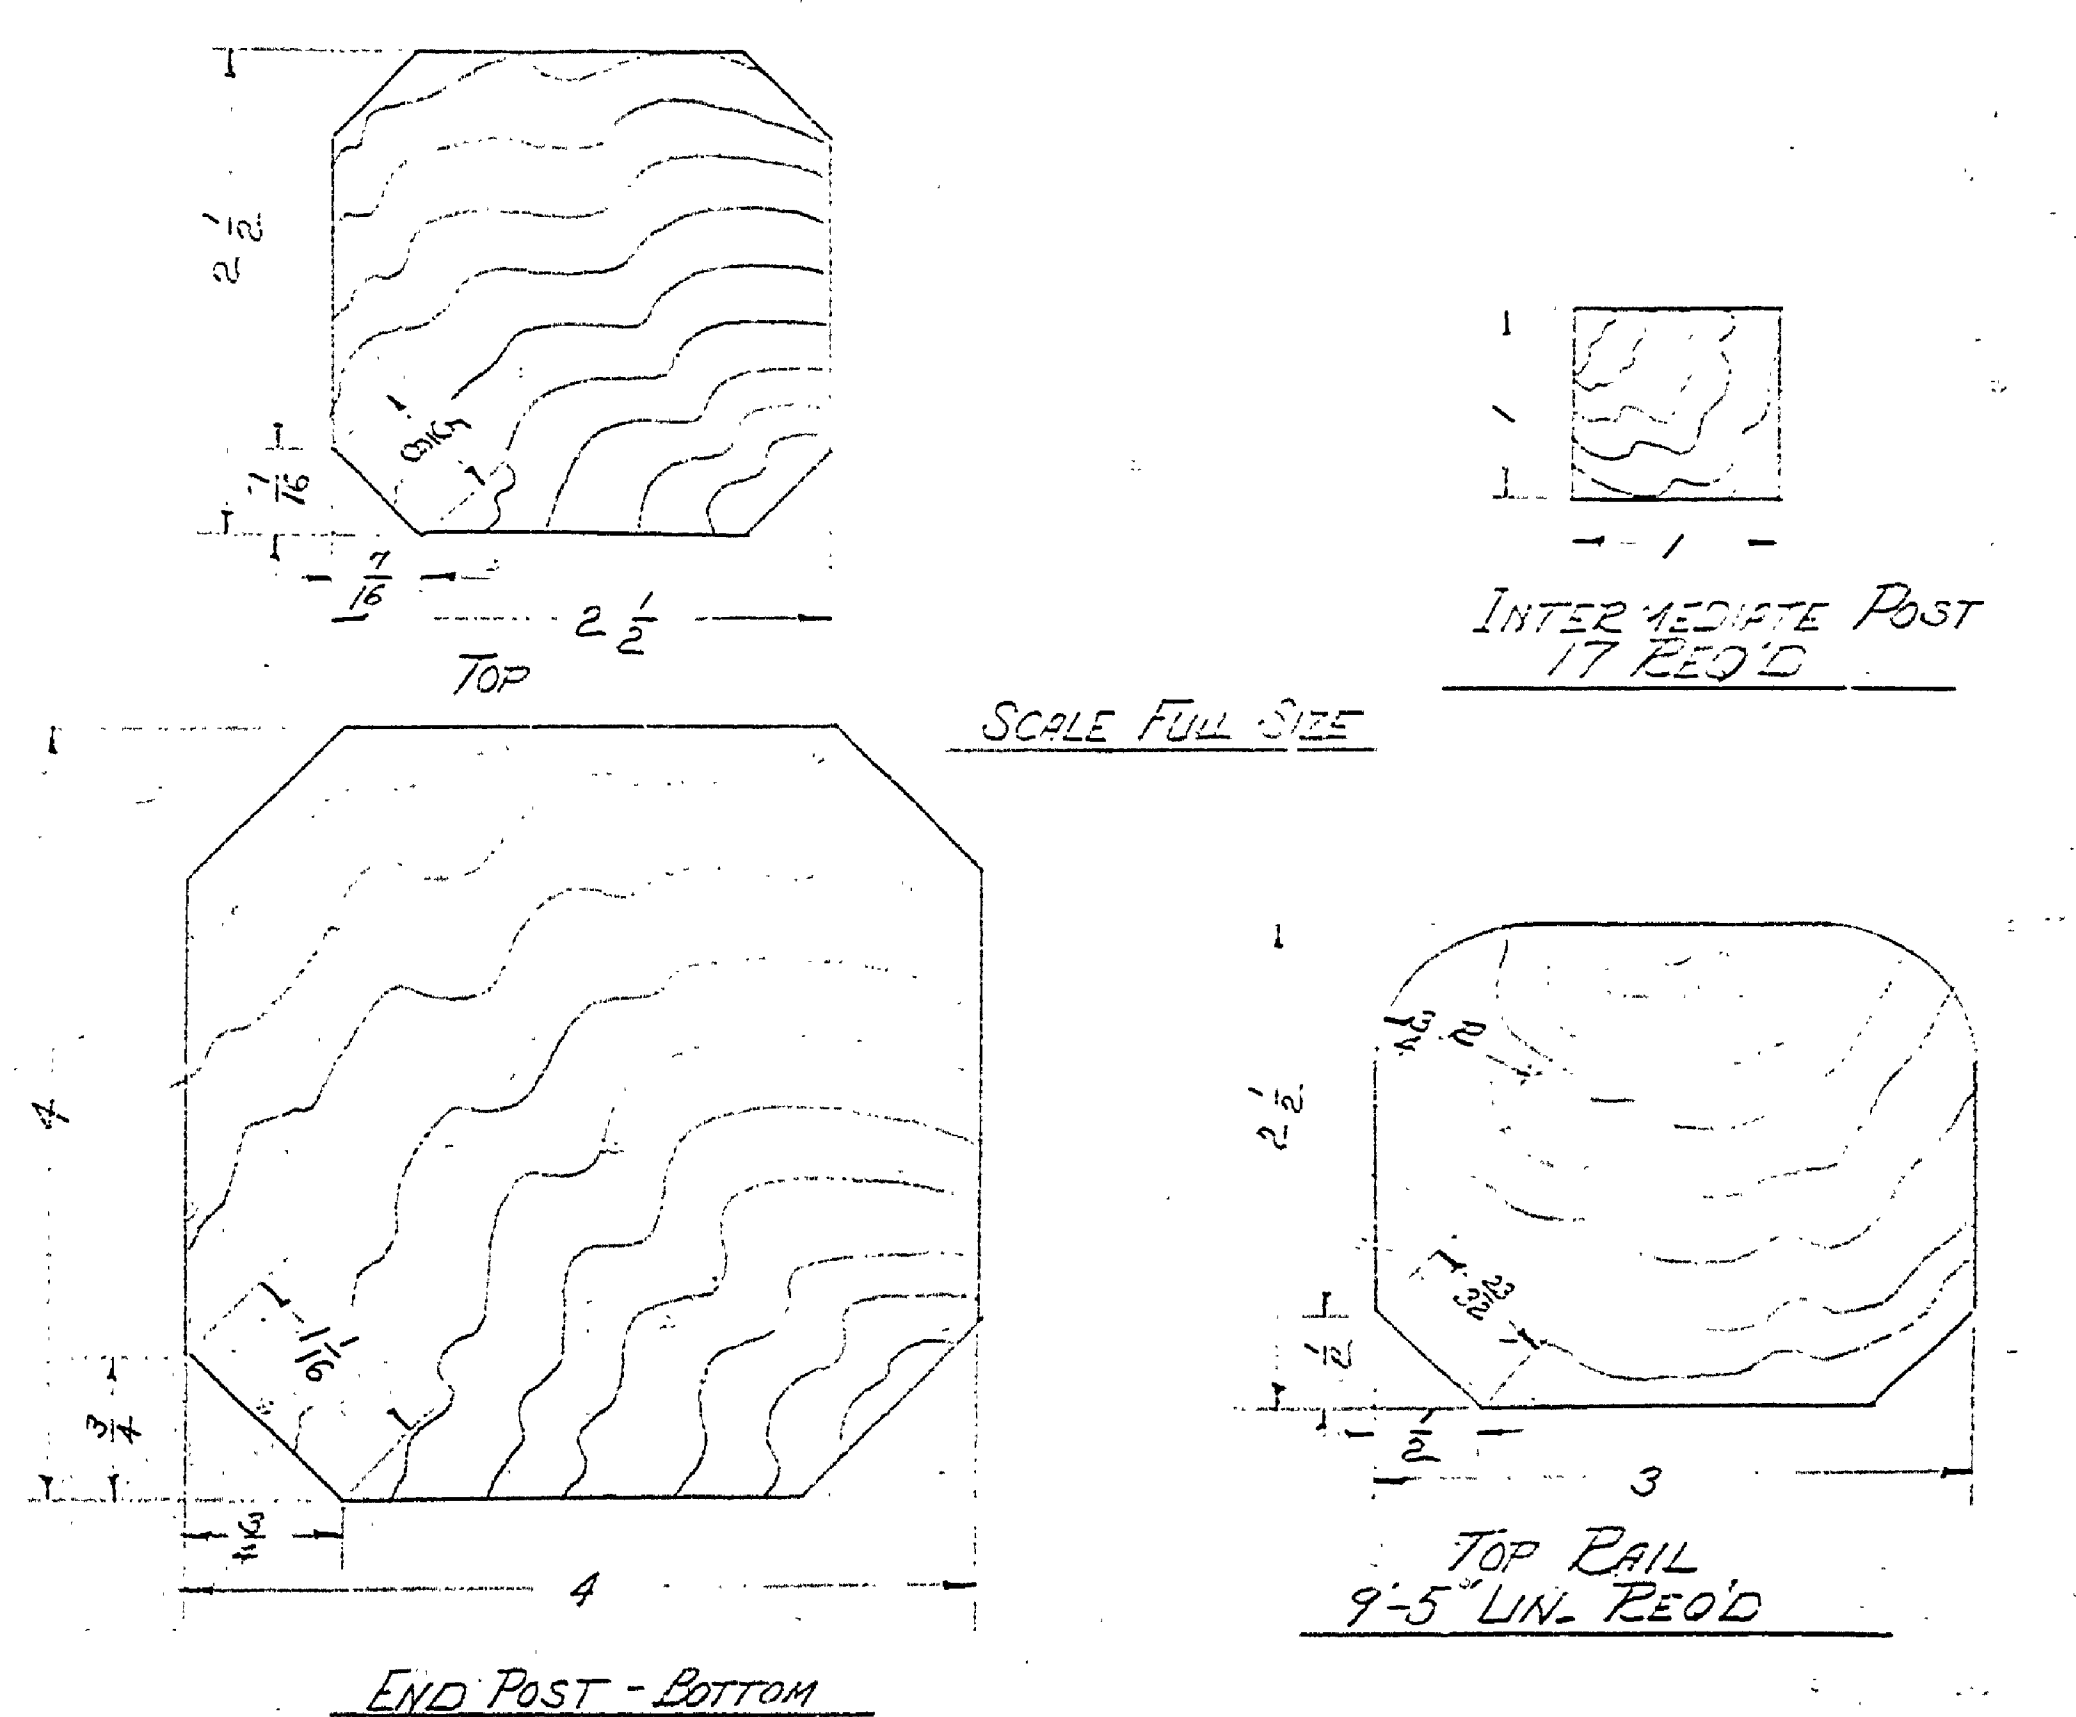
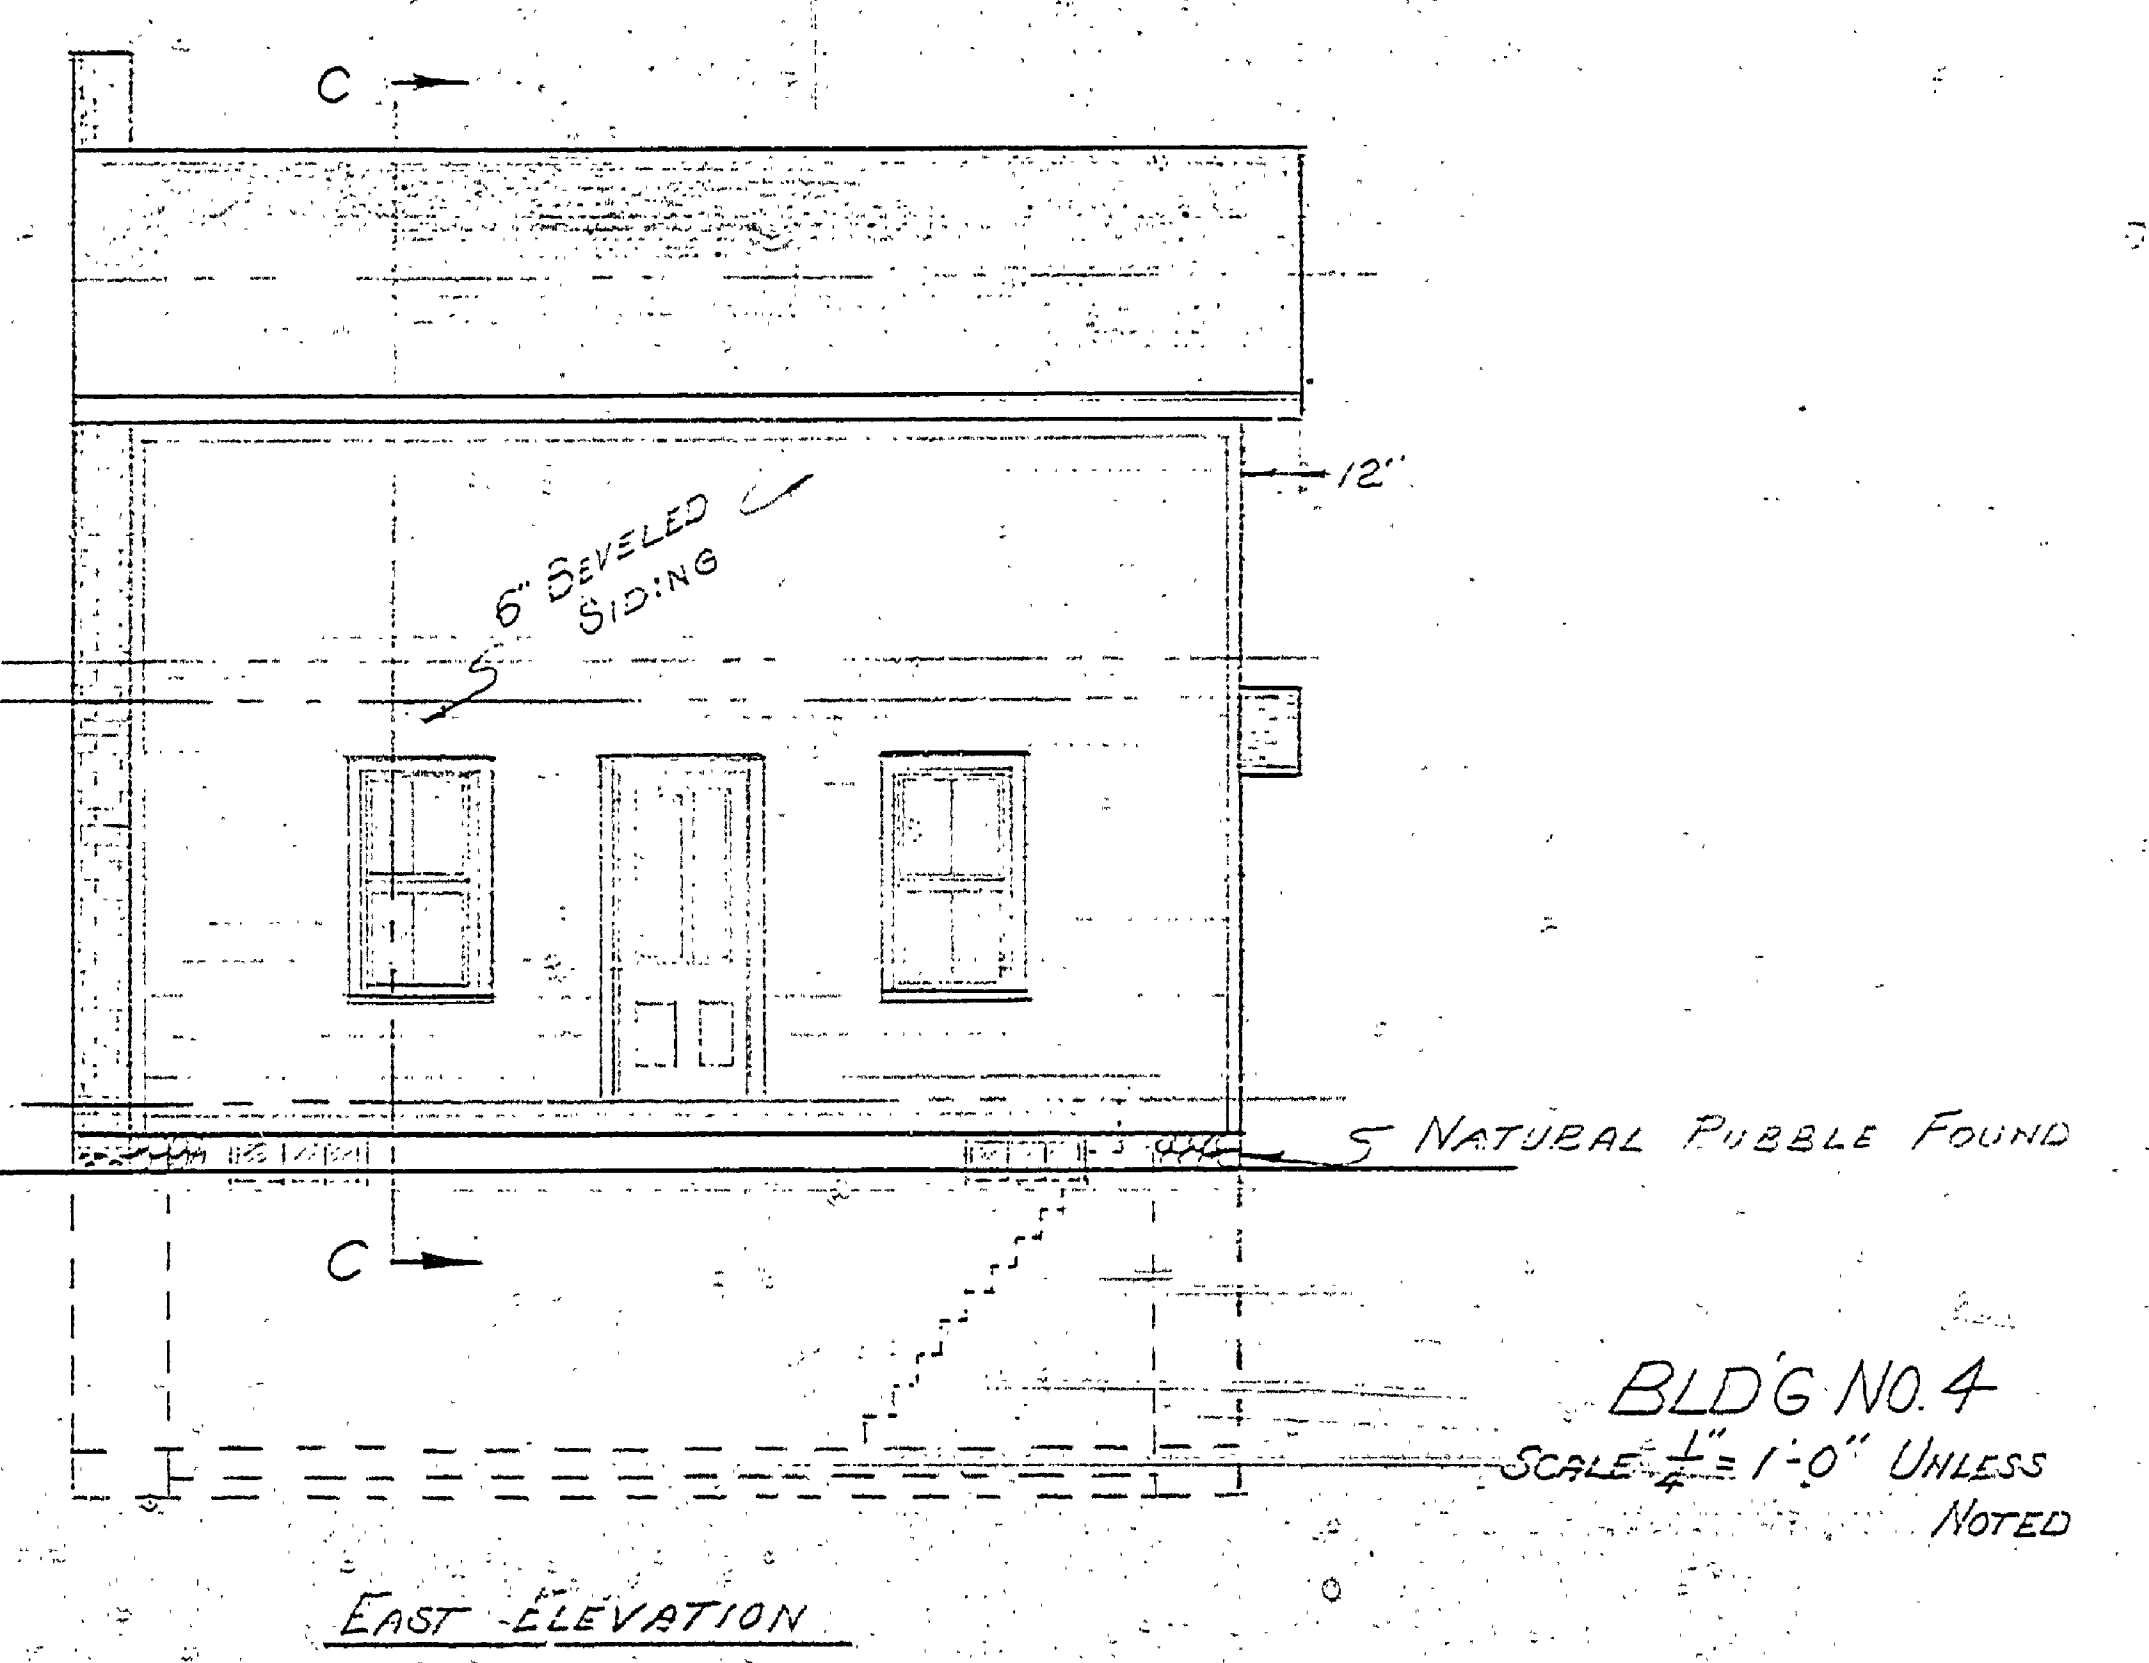
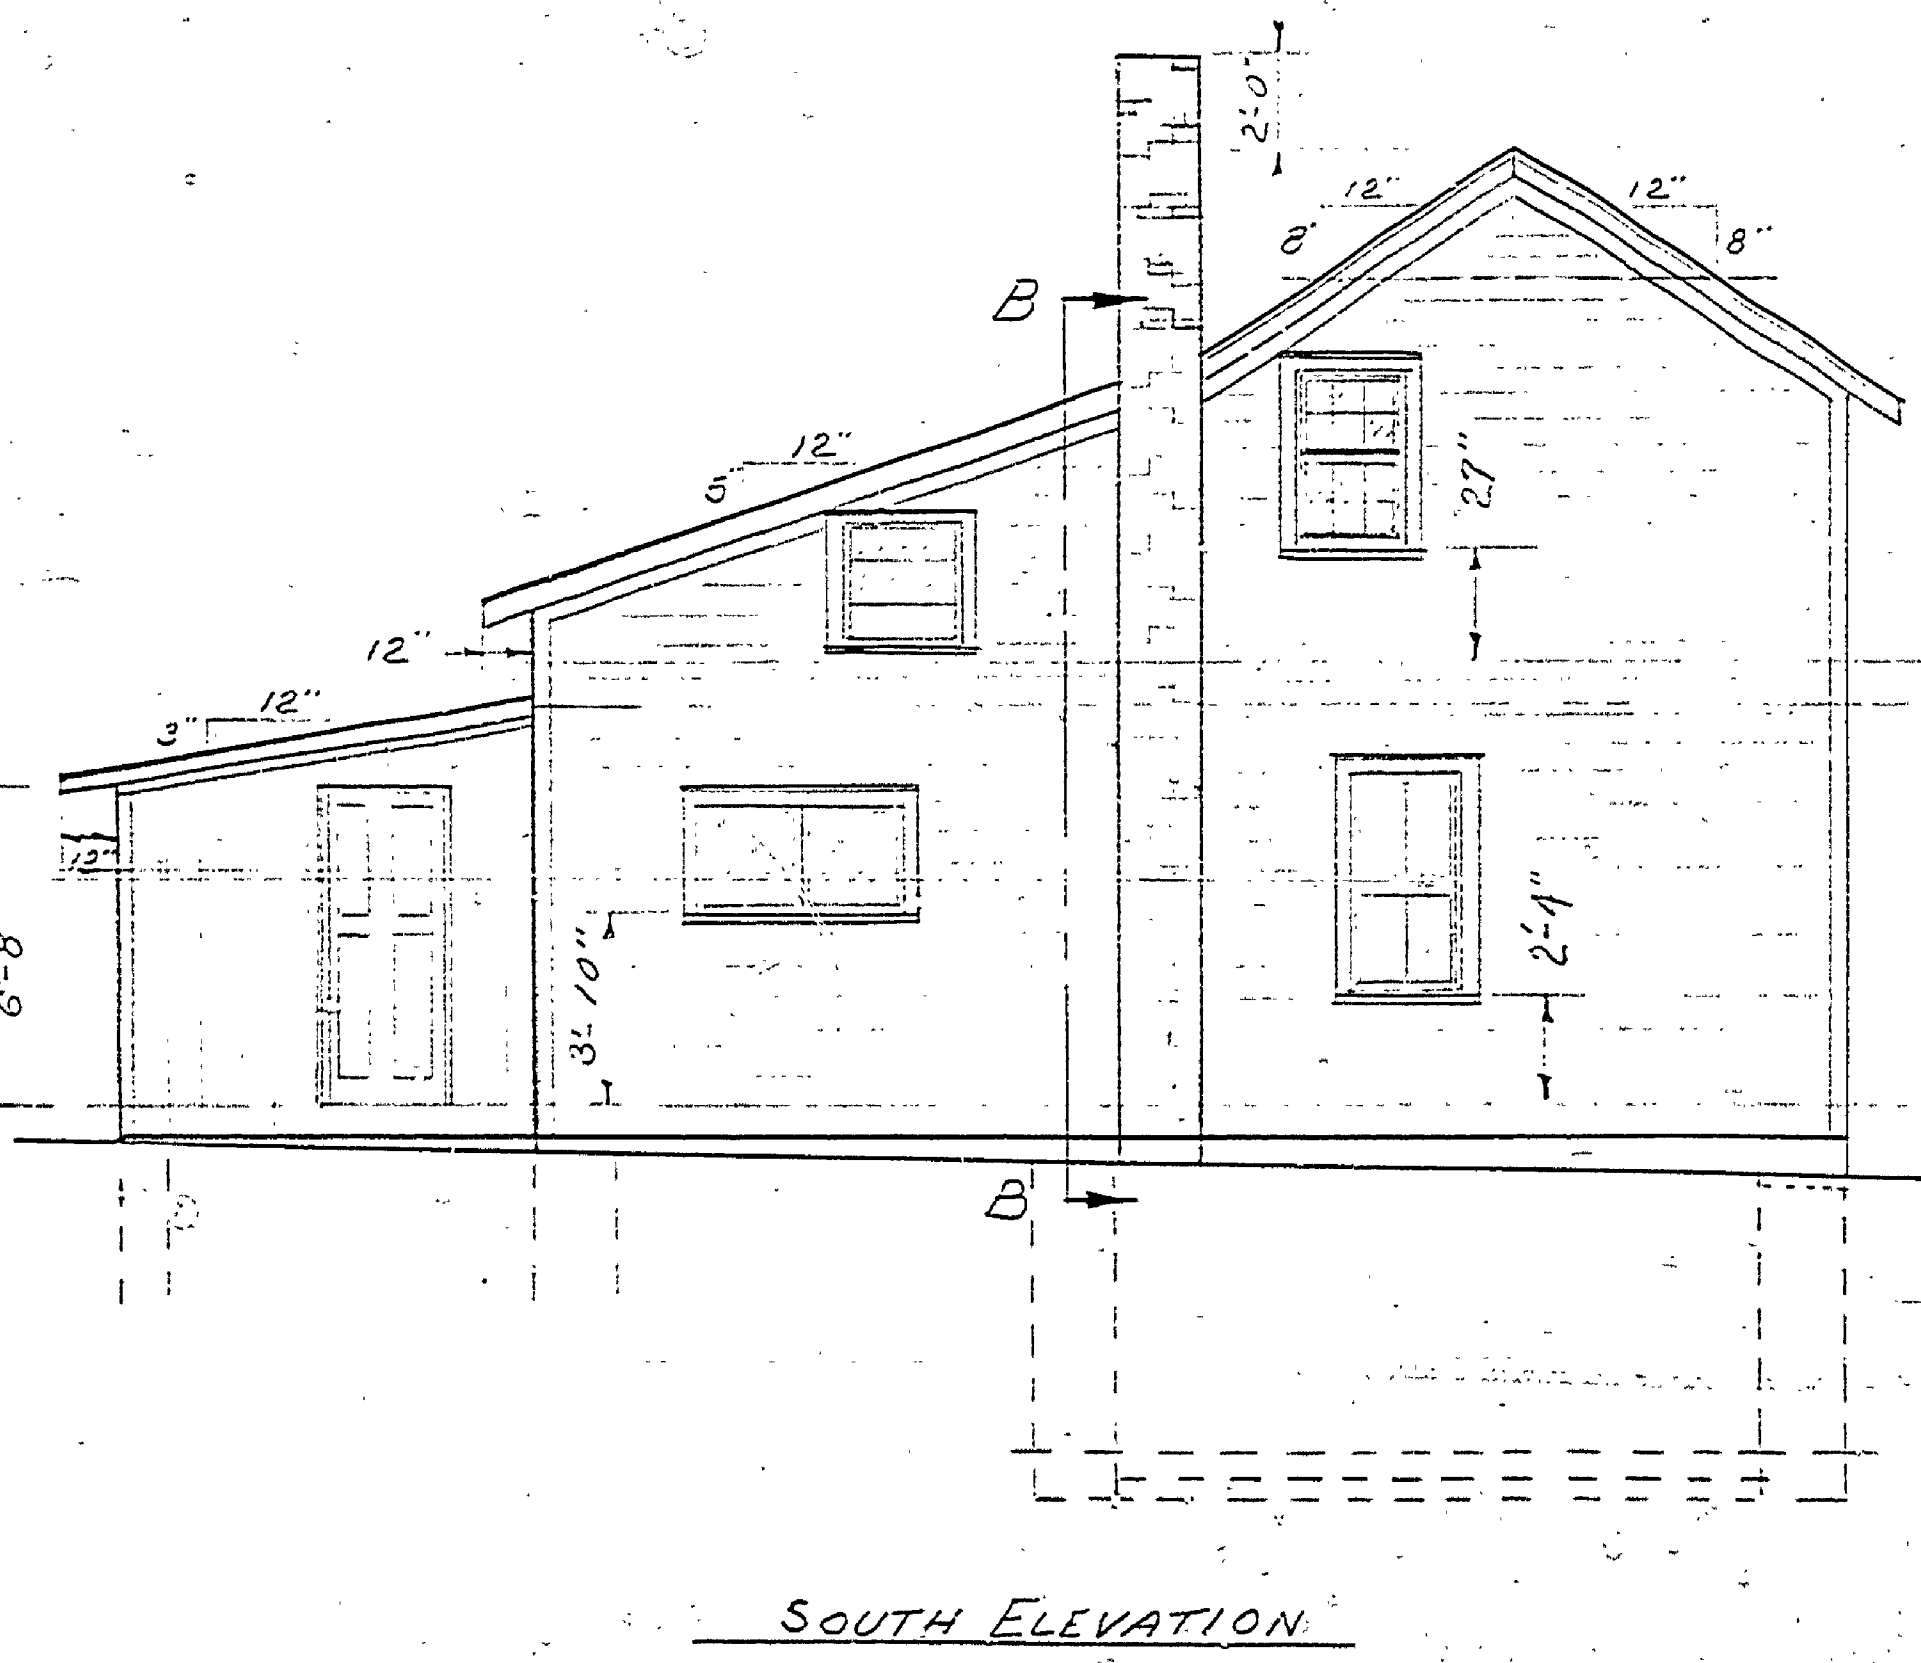
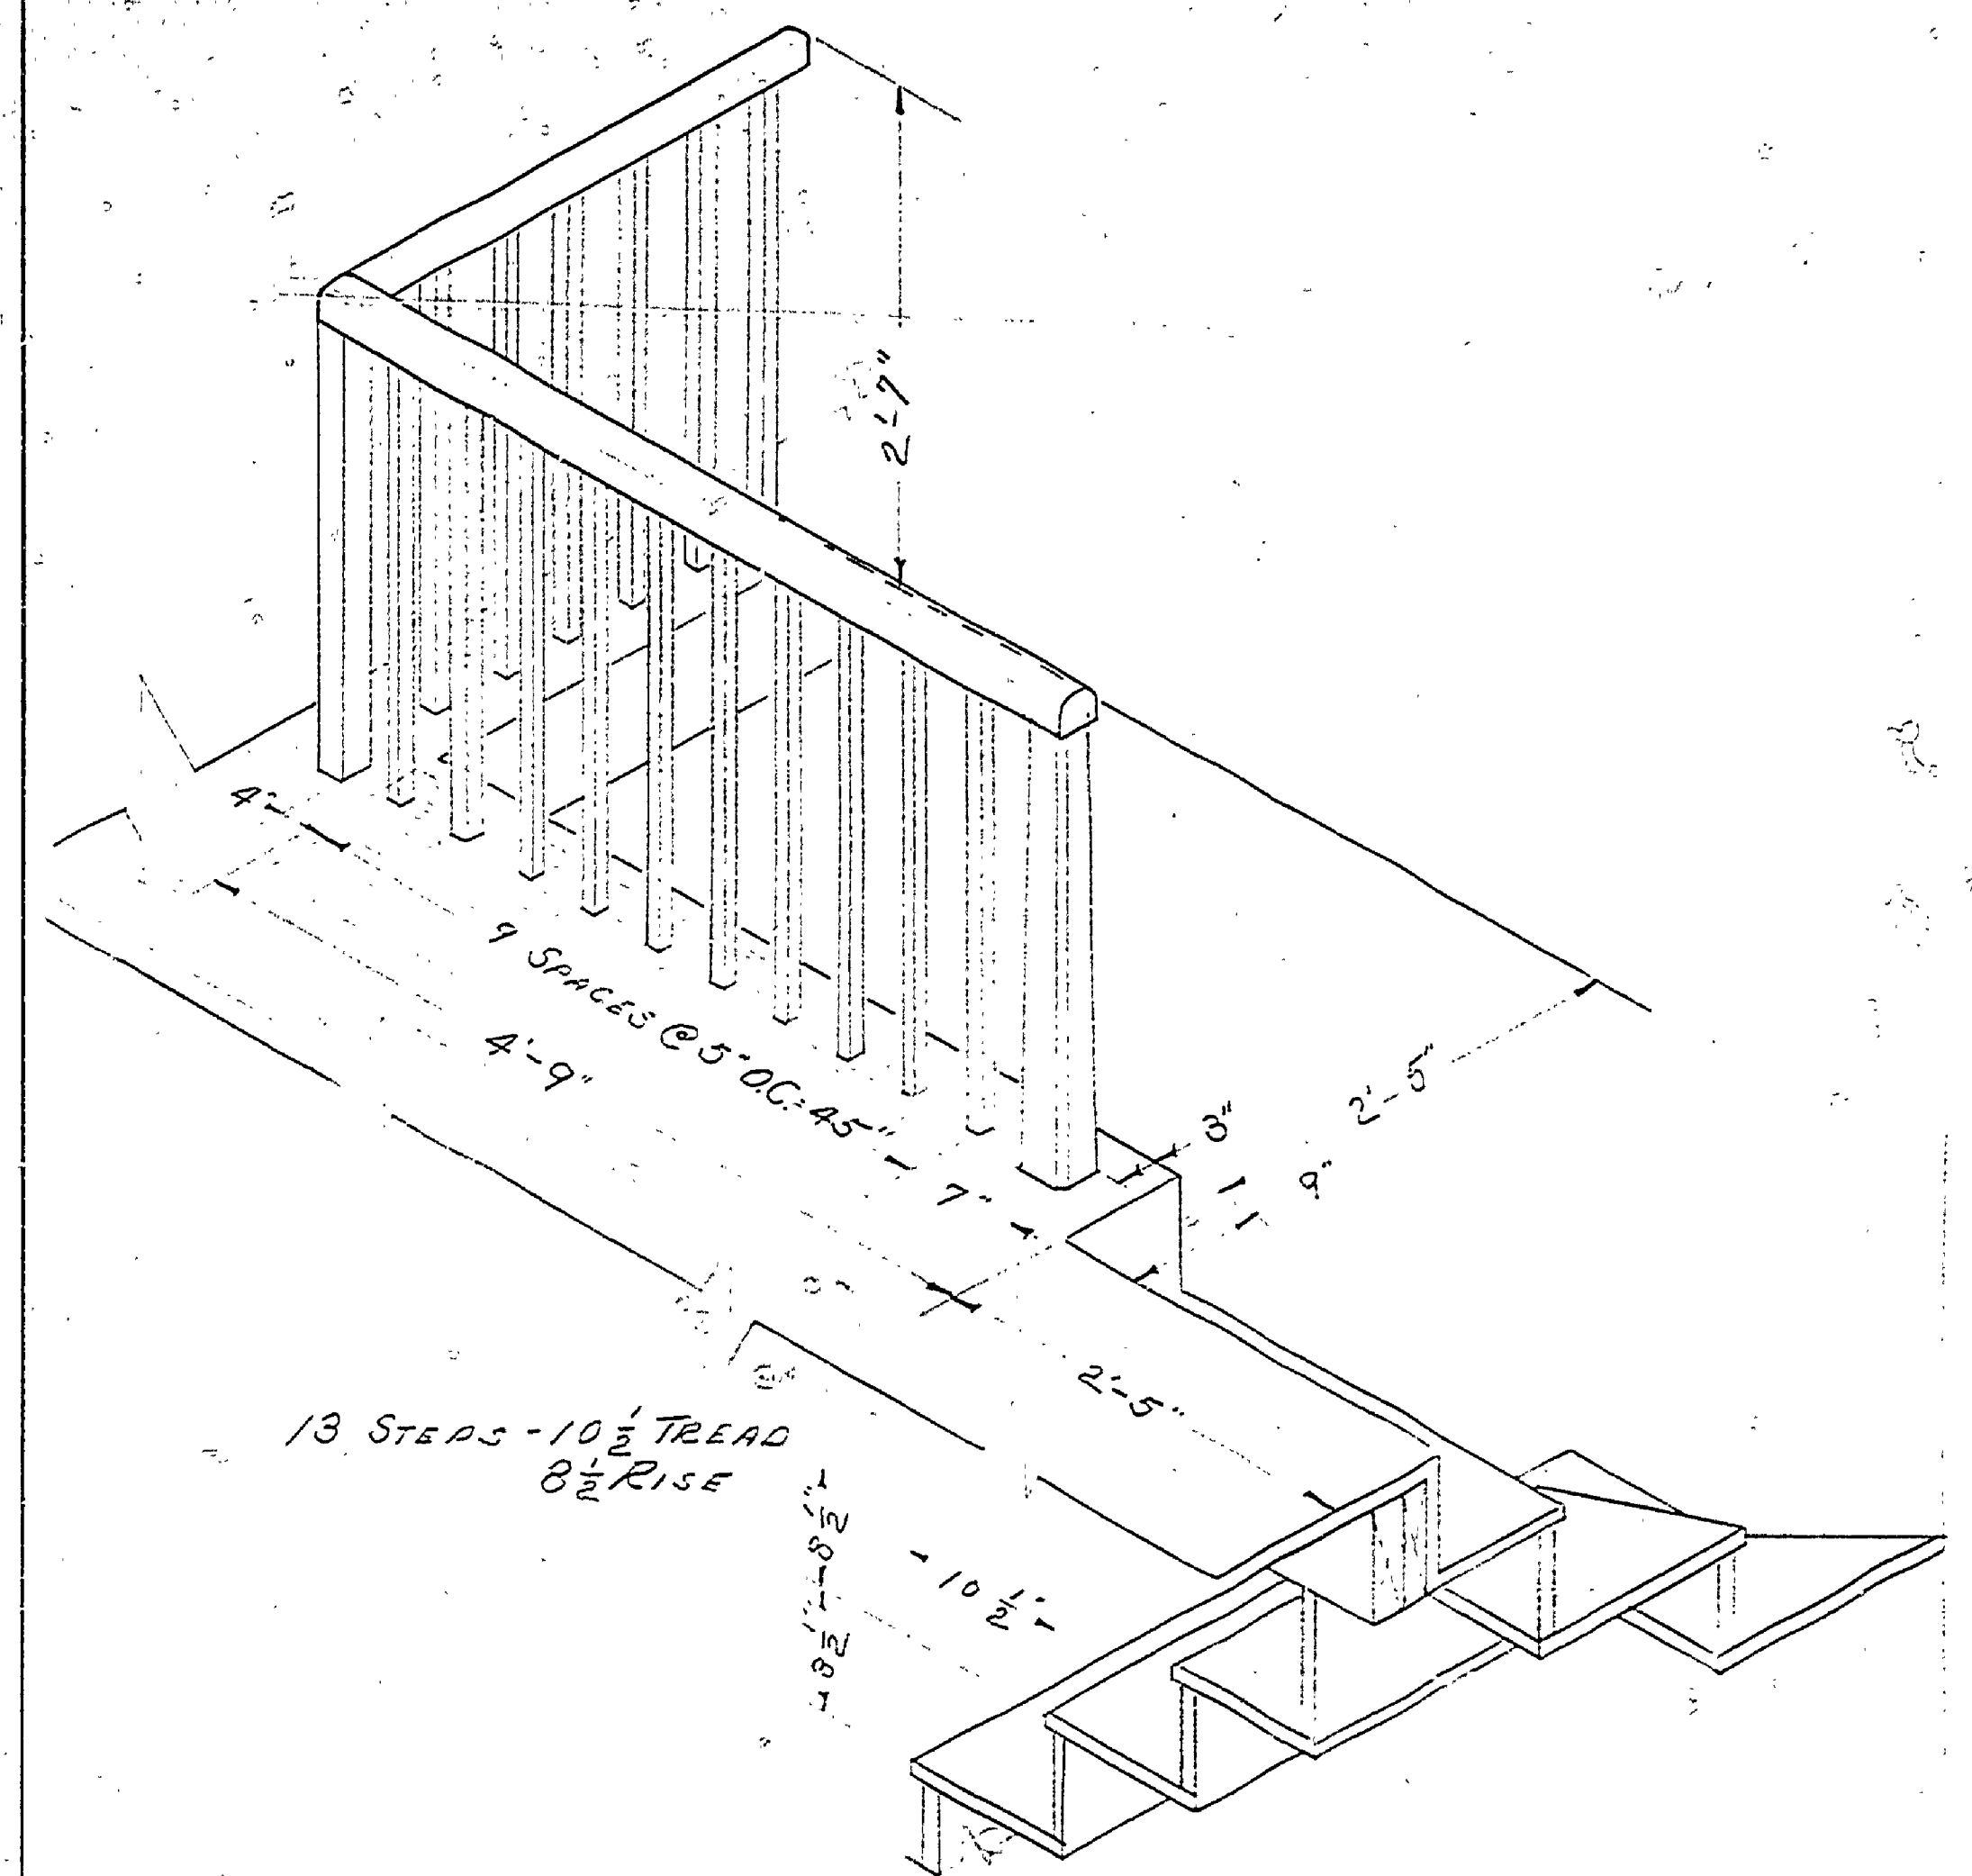
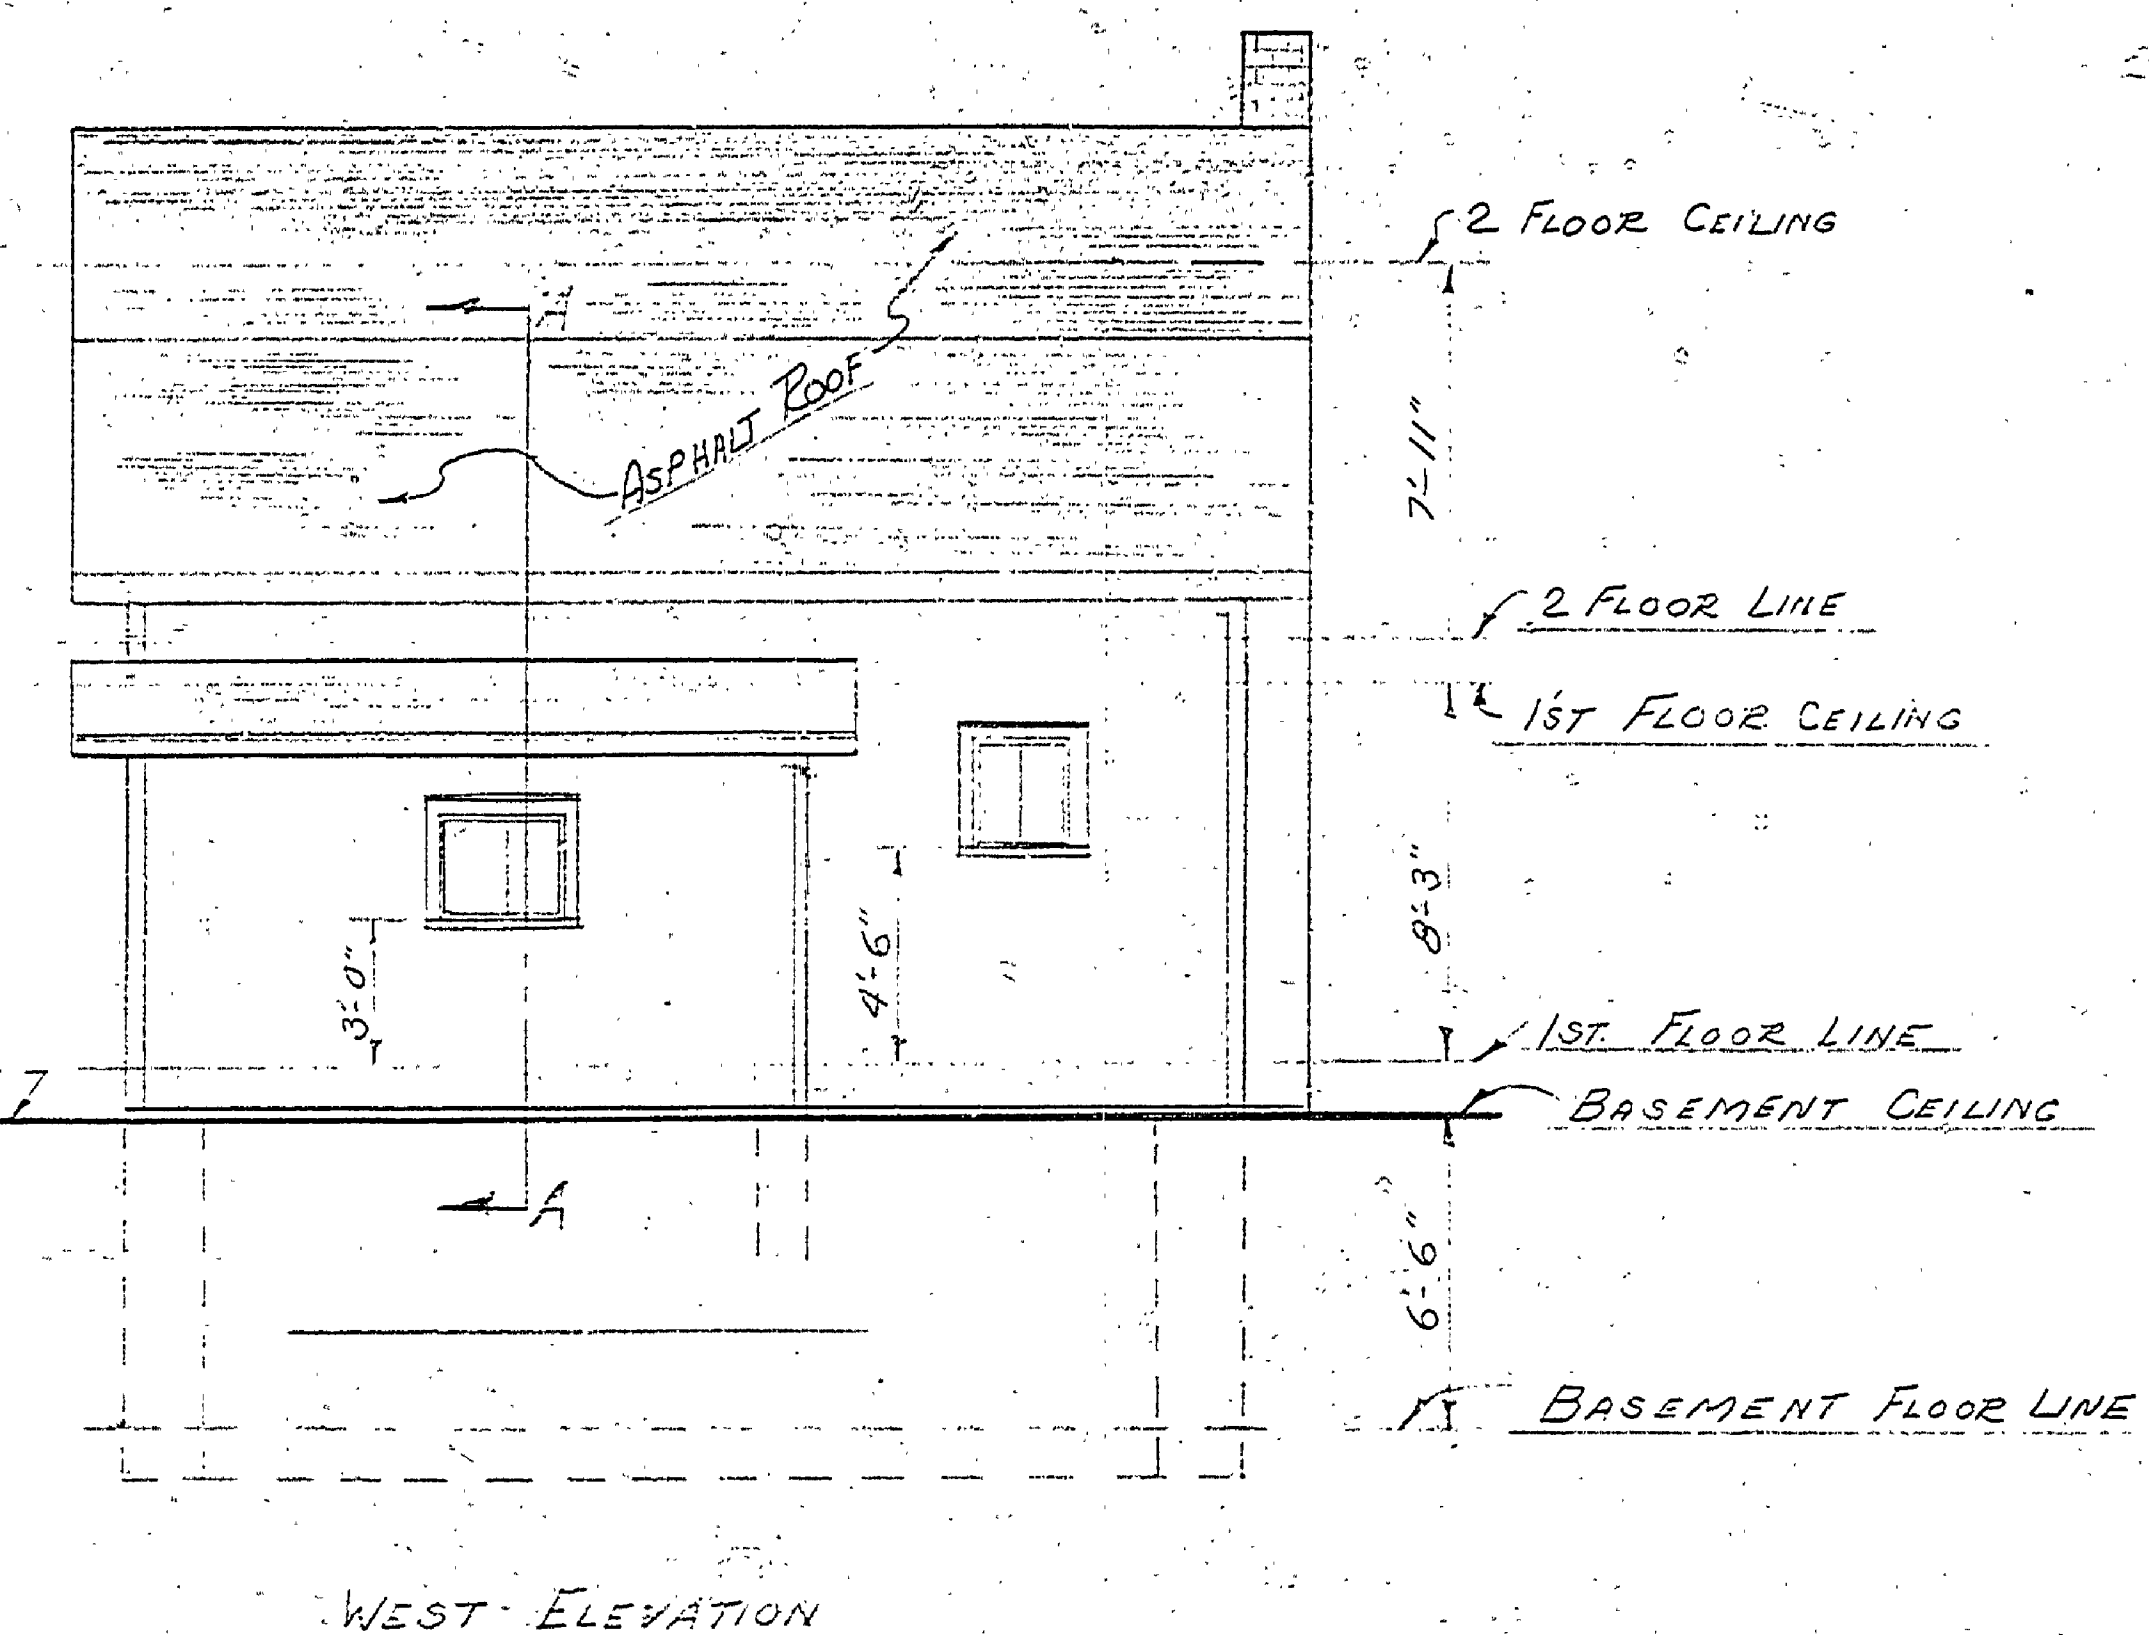


DESIGNED BY	DATE	REVIEWED	DATE	APPROVED	DATE	NO.	DATE	REVISIONS
DRAWN BY <i>Jan Shaw</i>	8/62	ARCHITECTURAL				1		4
CHECKED BY		ENGINEERING				2		5
		LANDSCAPE				3		6

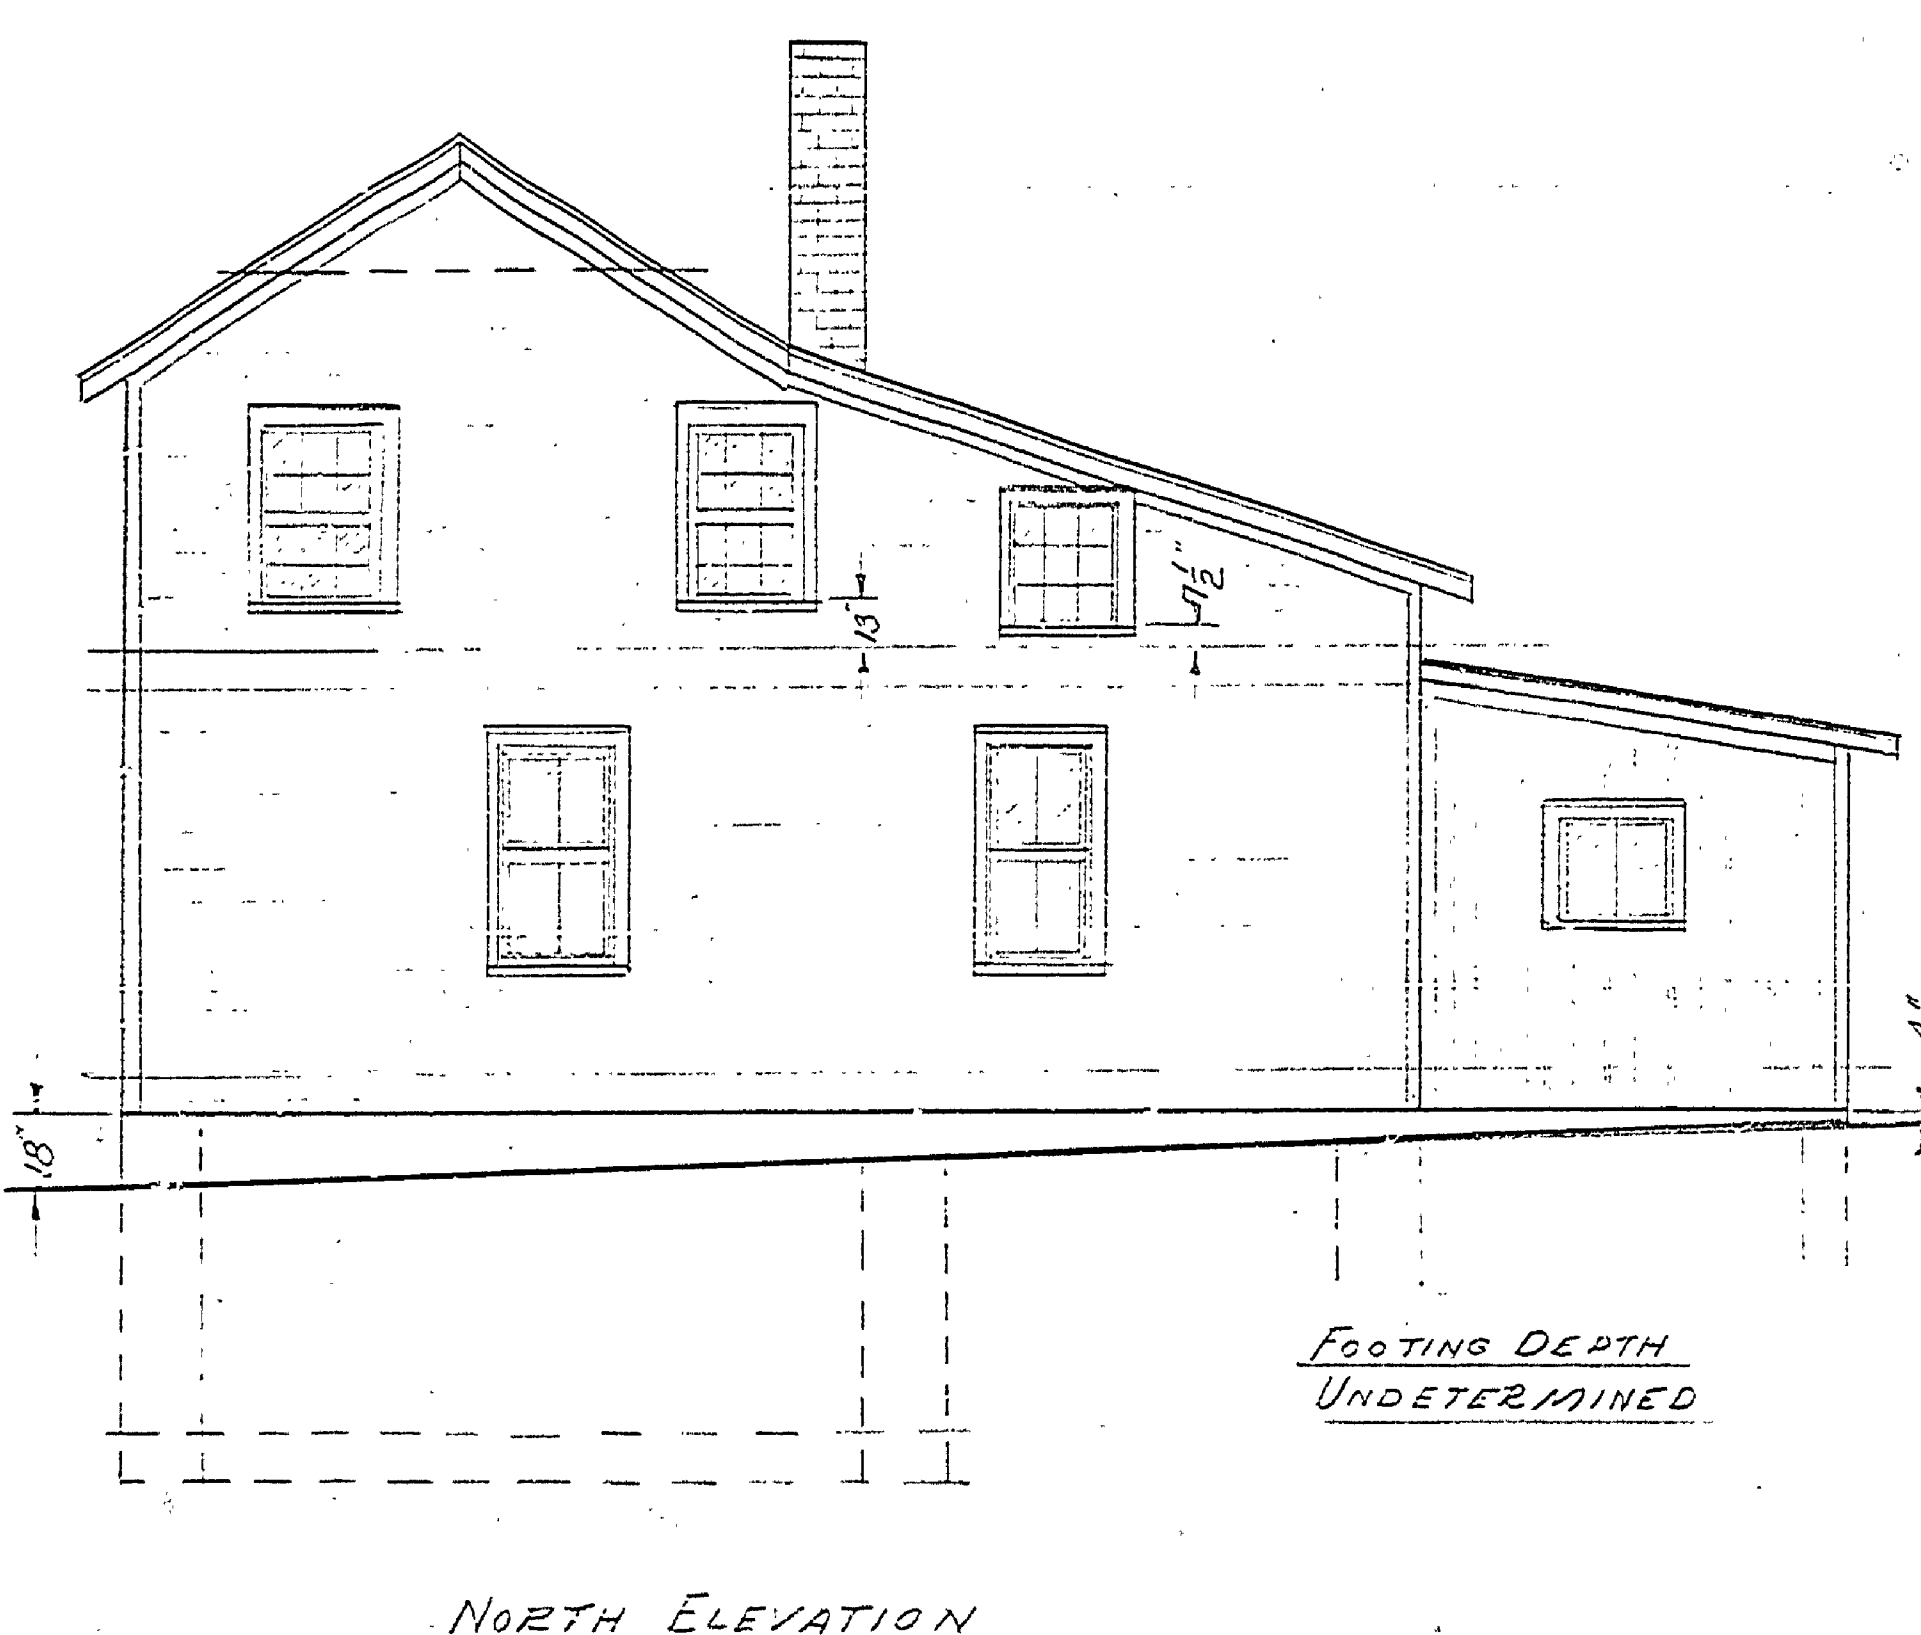

BLDG NO. 4
SCALE 1/4" = 1'-0" UNLESS NOTED

MICHIGAN
DEPARTMENT OF CONSERVATION
PARKS AND RECREATION DIVISION

MEASURED DRAWINGS
FAYETTE HISTORICAL TOWNSITE
FAYETTE STATE PARK

SHEET
NO. 2
OF 4
PLAN NO.
A-4