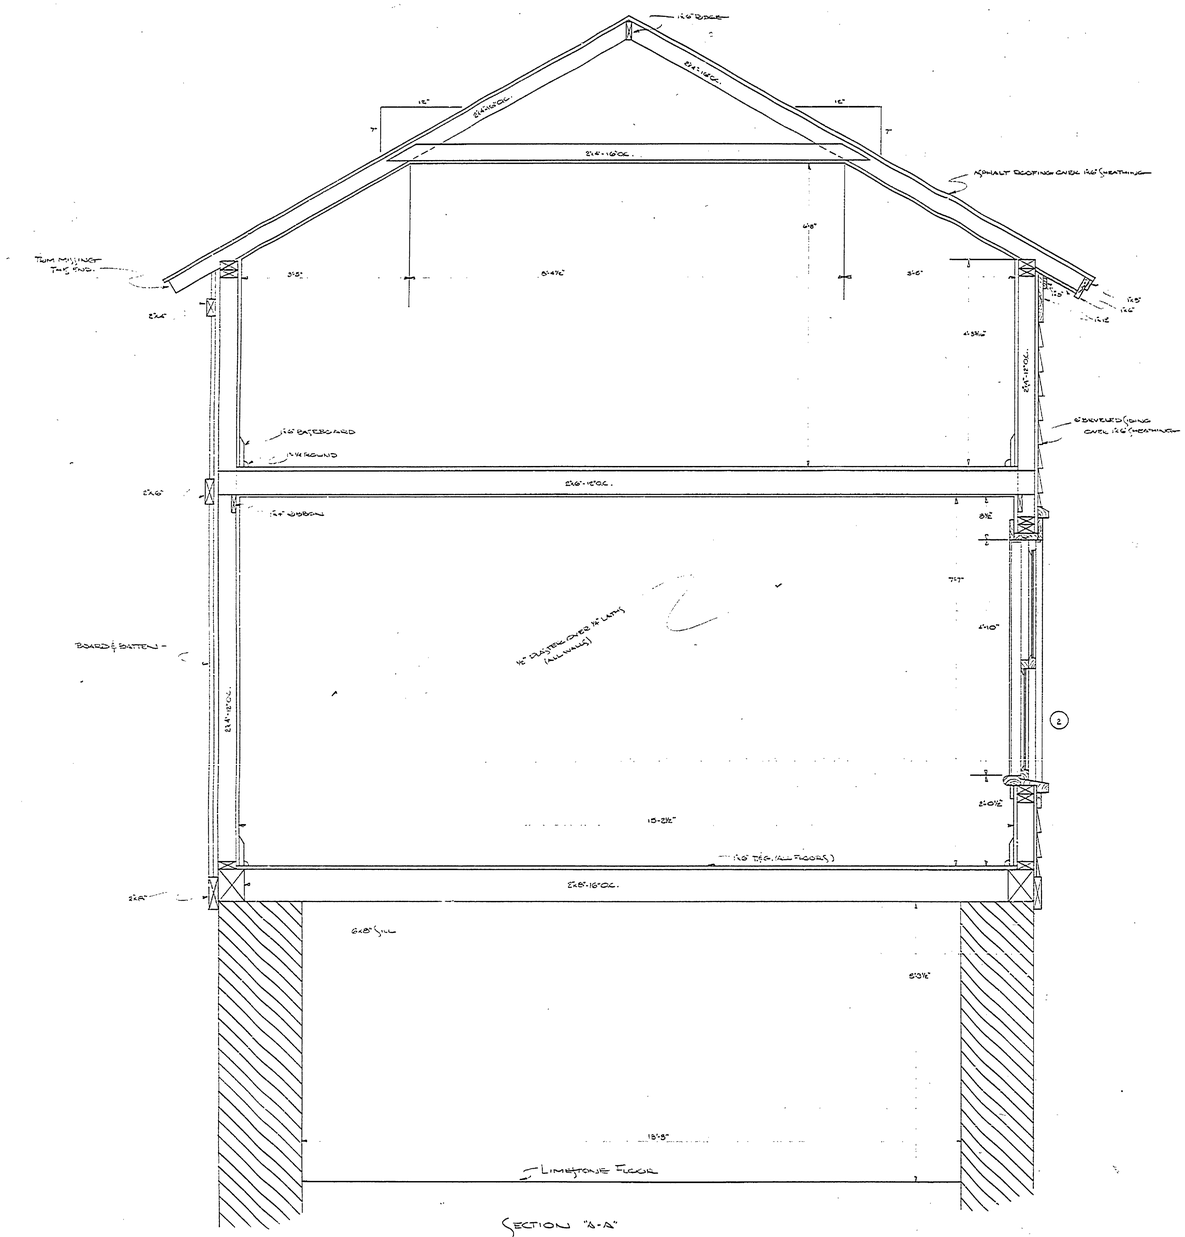

SECTION "A-A"
SCALE 3/4" = 1'-0"

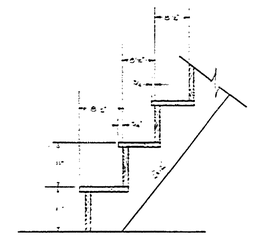

MAIN STAIR DETAIL
SCALE [illegible]

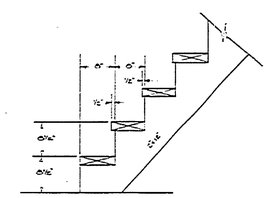

BASEMENT STAIR DETAIL
SCALE 3/4" = 1'-0"

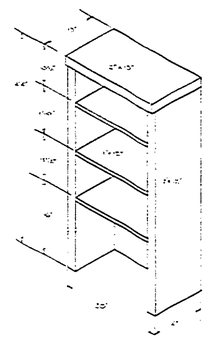

SCALE [illegible]

REVISIONS								
NO.	DATE	BY	NO.	DATE	BY	NO.	DATE	BY
1			4					
2			5					
3			6					

APPROVED	DATE
CHIEF OF DIVISION	
ASST. CHIEF OF DIVISION	
CHIEF OF PLANNING AND CONSTRUCTION	

REVIEWED	DATE
ARCHITECTURAL	7/1/72
ENGINEERING	7/1/72
LANDSCAPE	

DESIGNED BY	[illegible]
DRAWN BY	[illegible]
CHECKED BY	

COMMERCIAL BLUEPRINT SERVICE, LANSING

BUILDING # 6

MICHIGAN
DEPARTMENT OF CONSERVATION
PARKS AND RECREATION DIVISION

MEASURED DRAWINGS
FAYETTE HISTORICAL TOWNSITE
FAYETTE STATE PARK

SHEET NO. 2 OF 2

PLAN NO. A-18