



DESIGNED BY	DATE	REVIEWED	DATE	APPROVED	DATE	NO.	DATE	BY	REVISIONS	DATE	BY
DR	7/20/64	ARCHITECTURAL				1			4		
DRAWN BY		ENGINEERING				2			5		
CHECKED BY		LANDSCAPE				3			6		

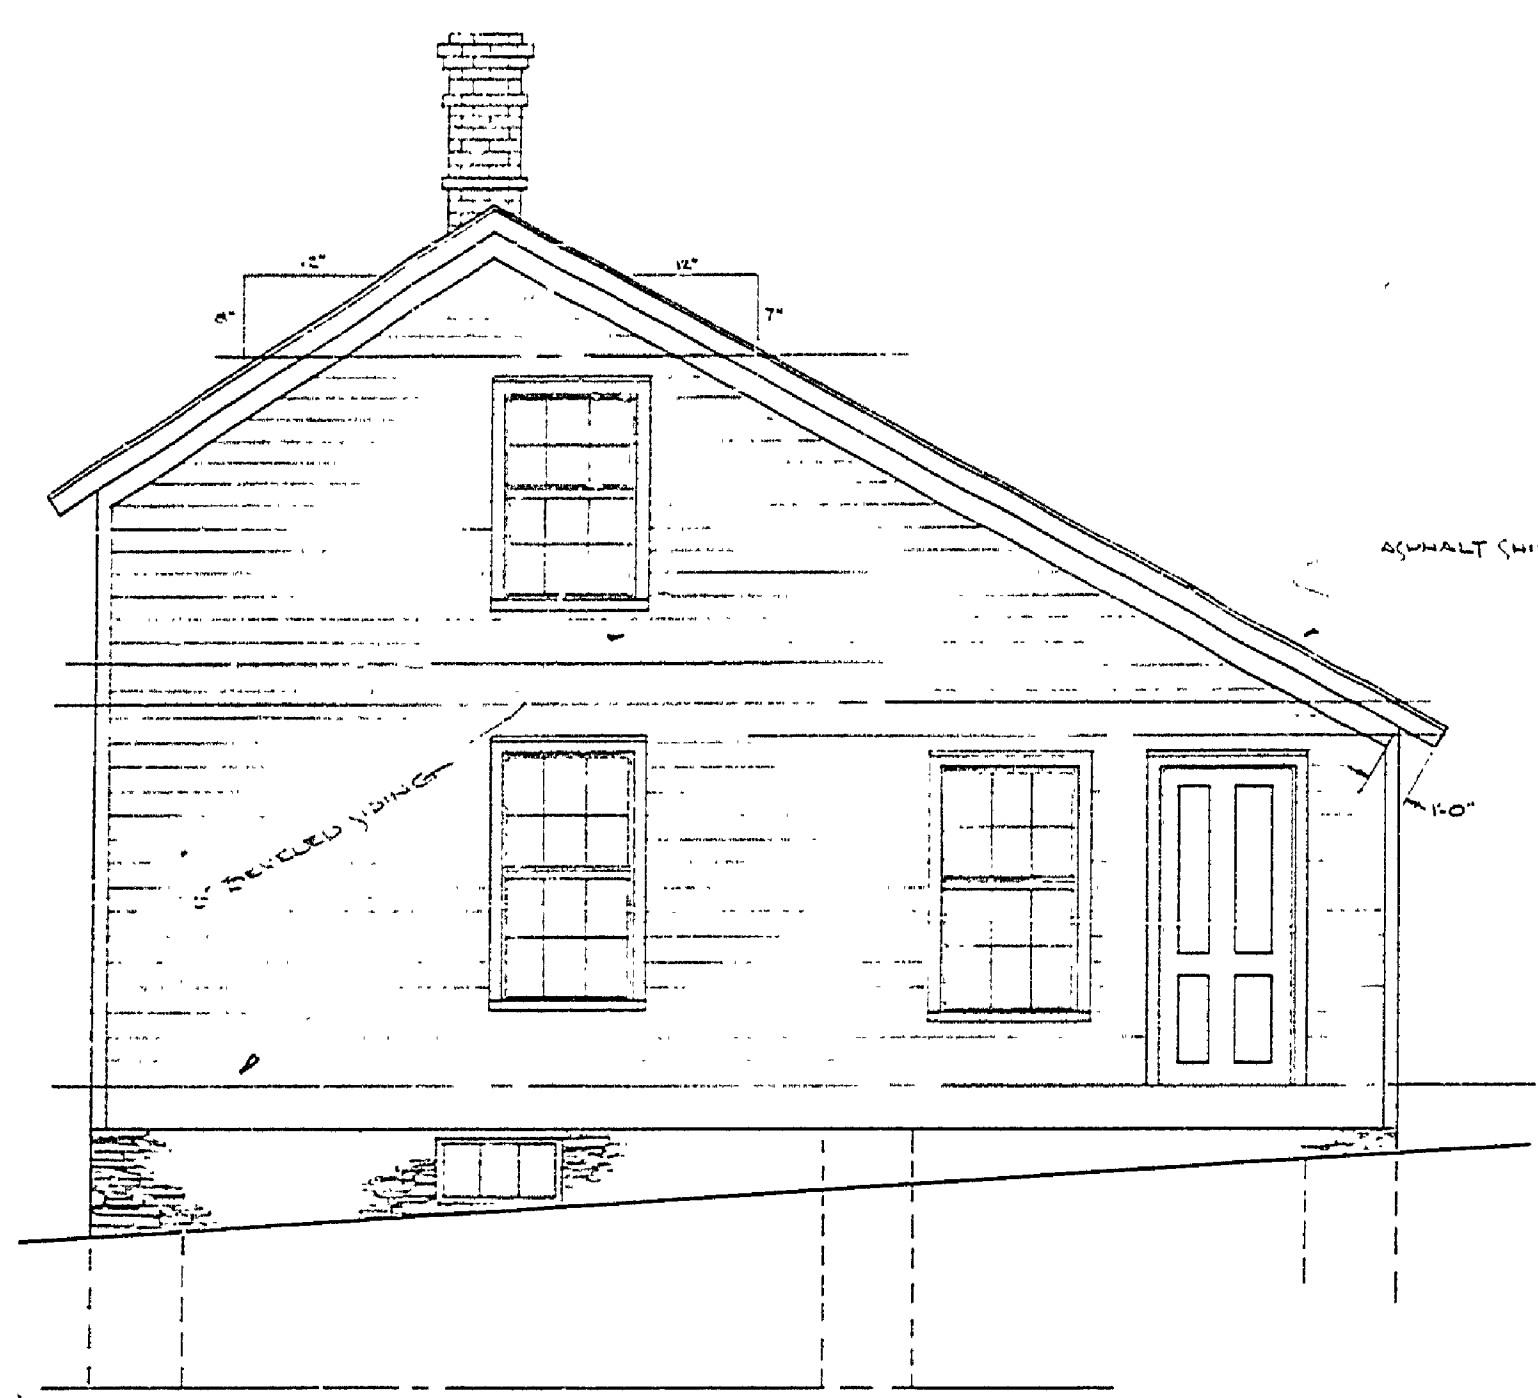


SOUTH ELEVATION

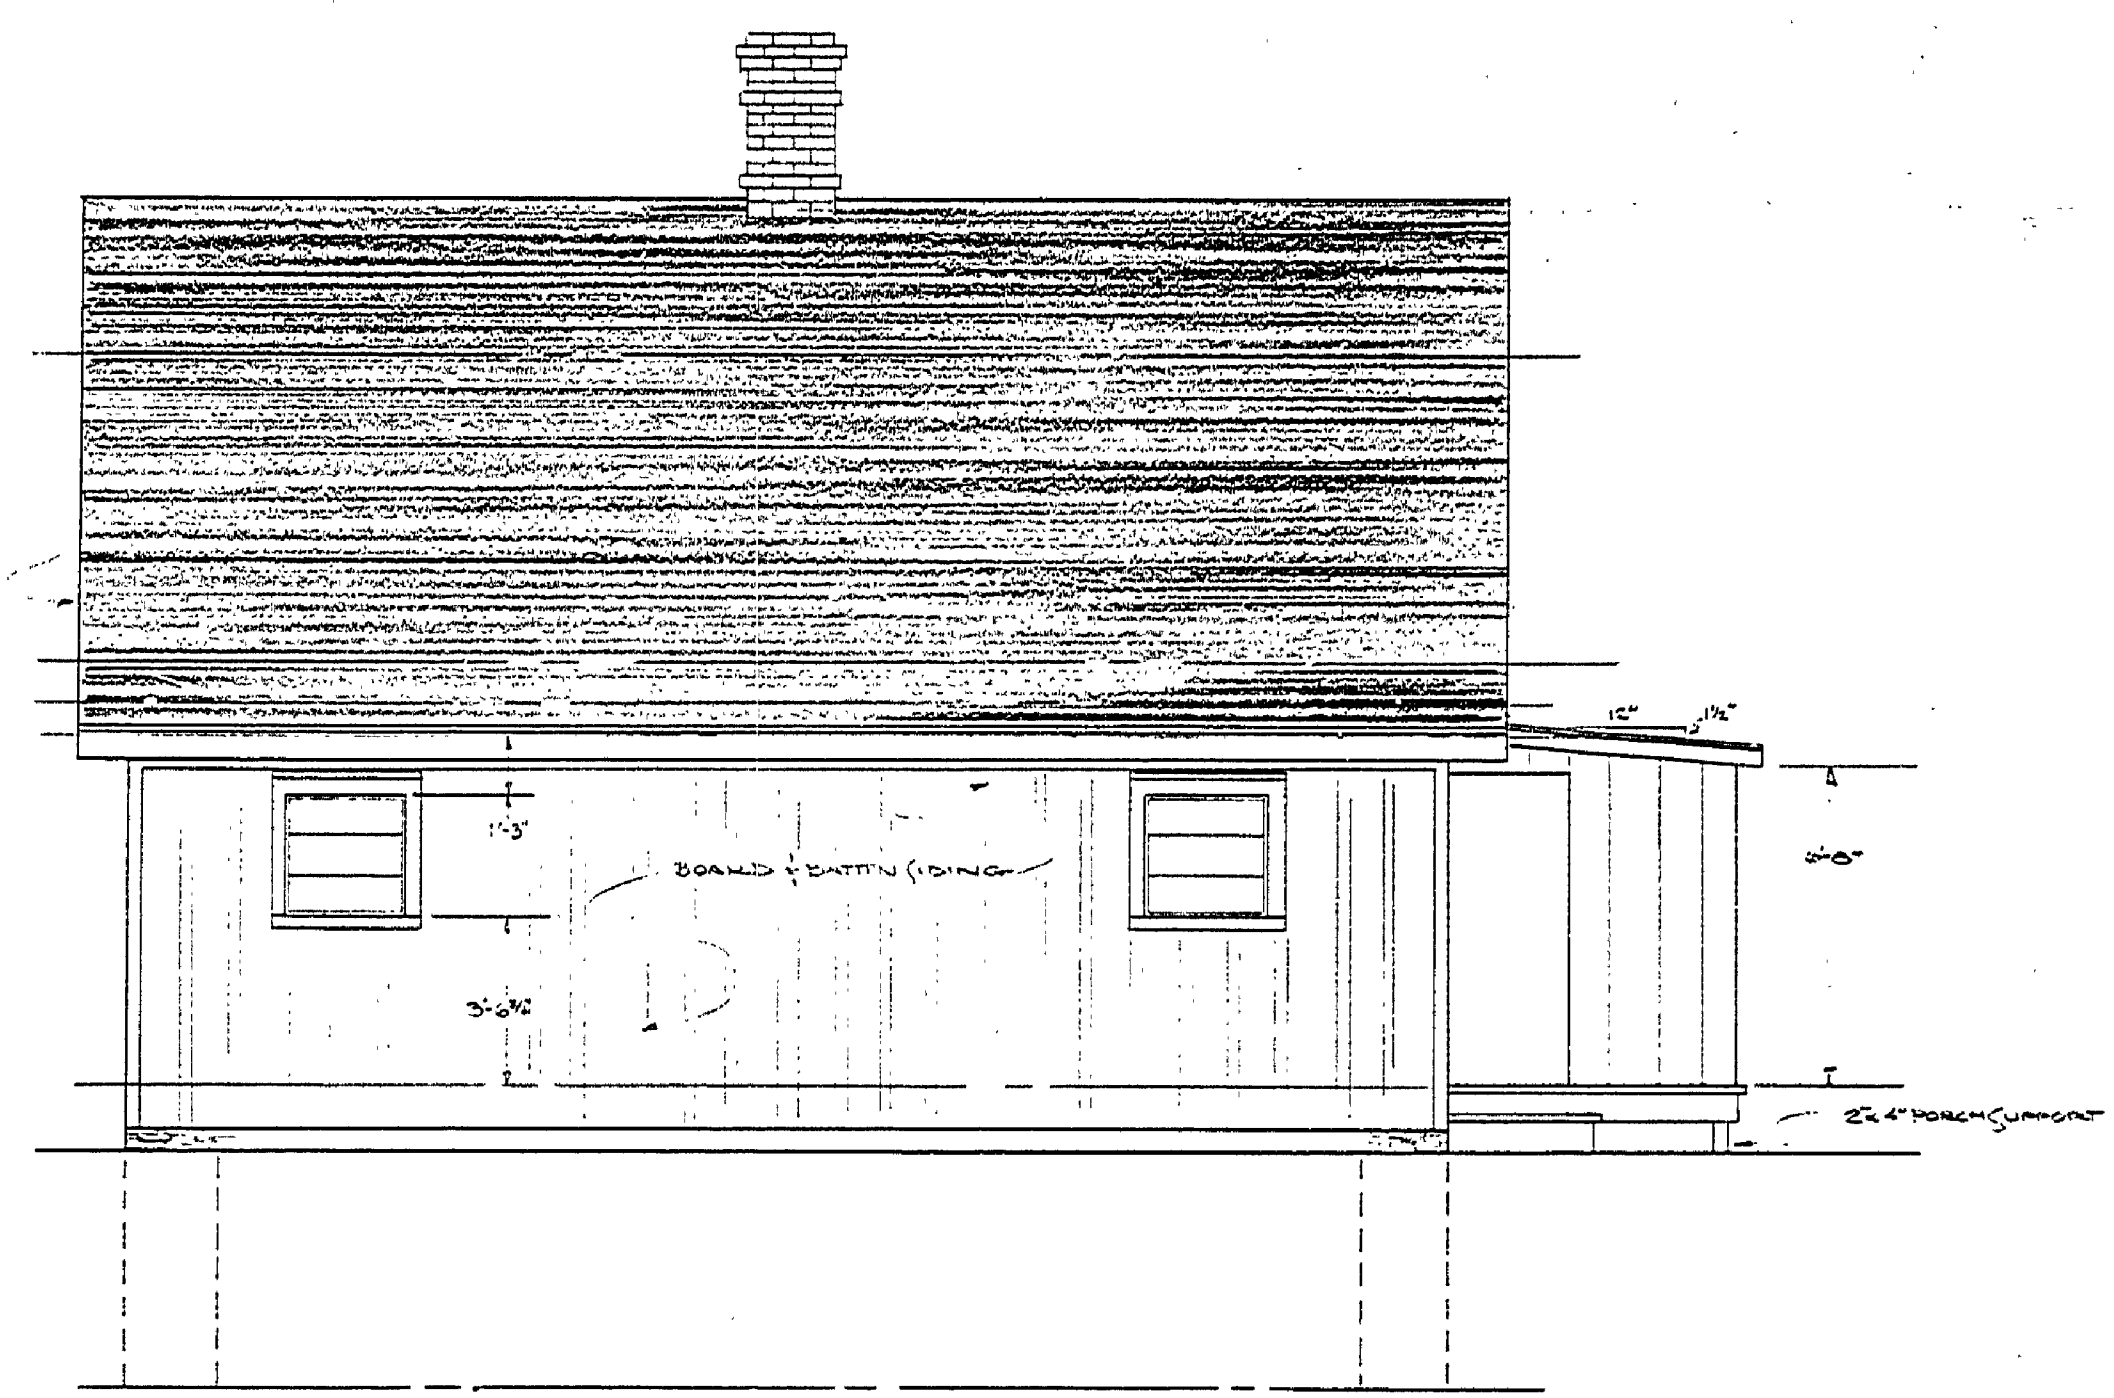


EAST ELEVATION



SCALE 1/4" = 1'-0"

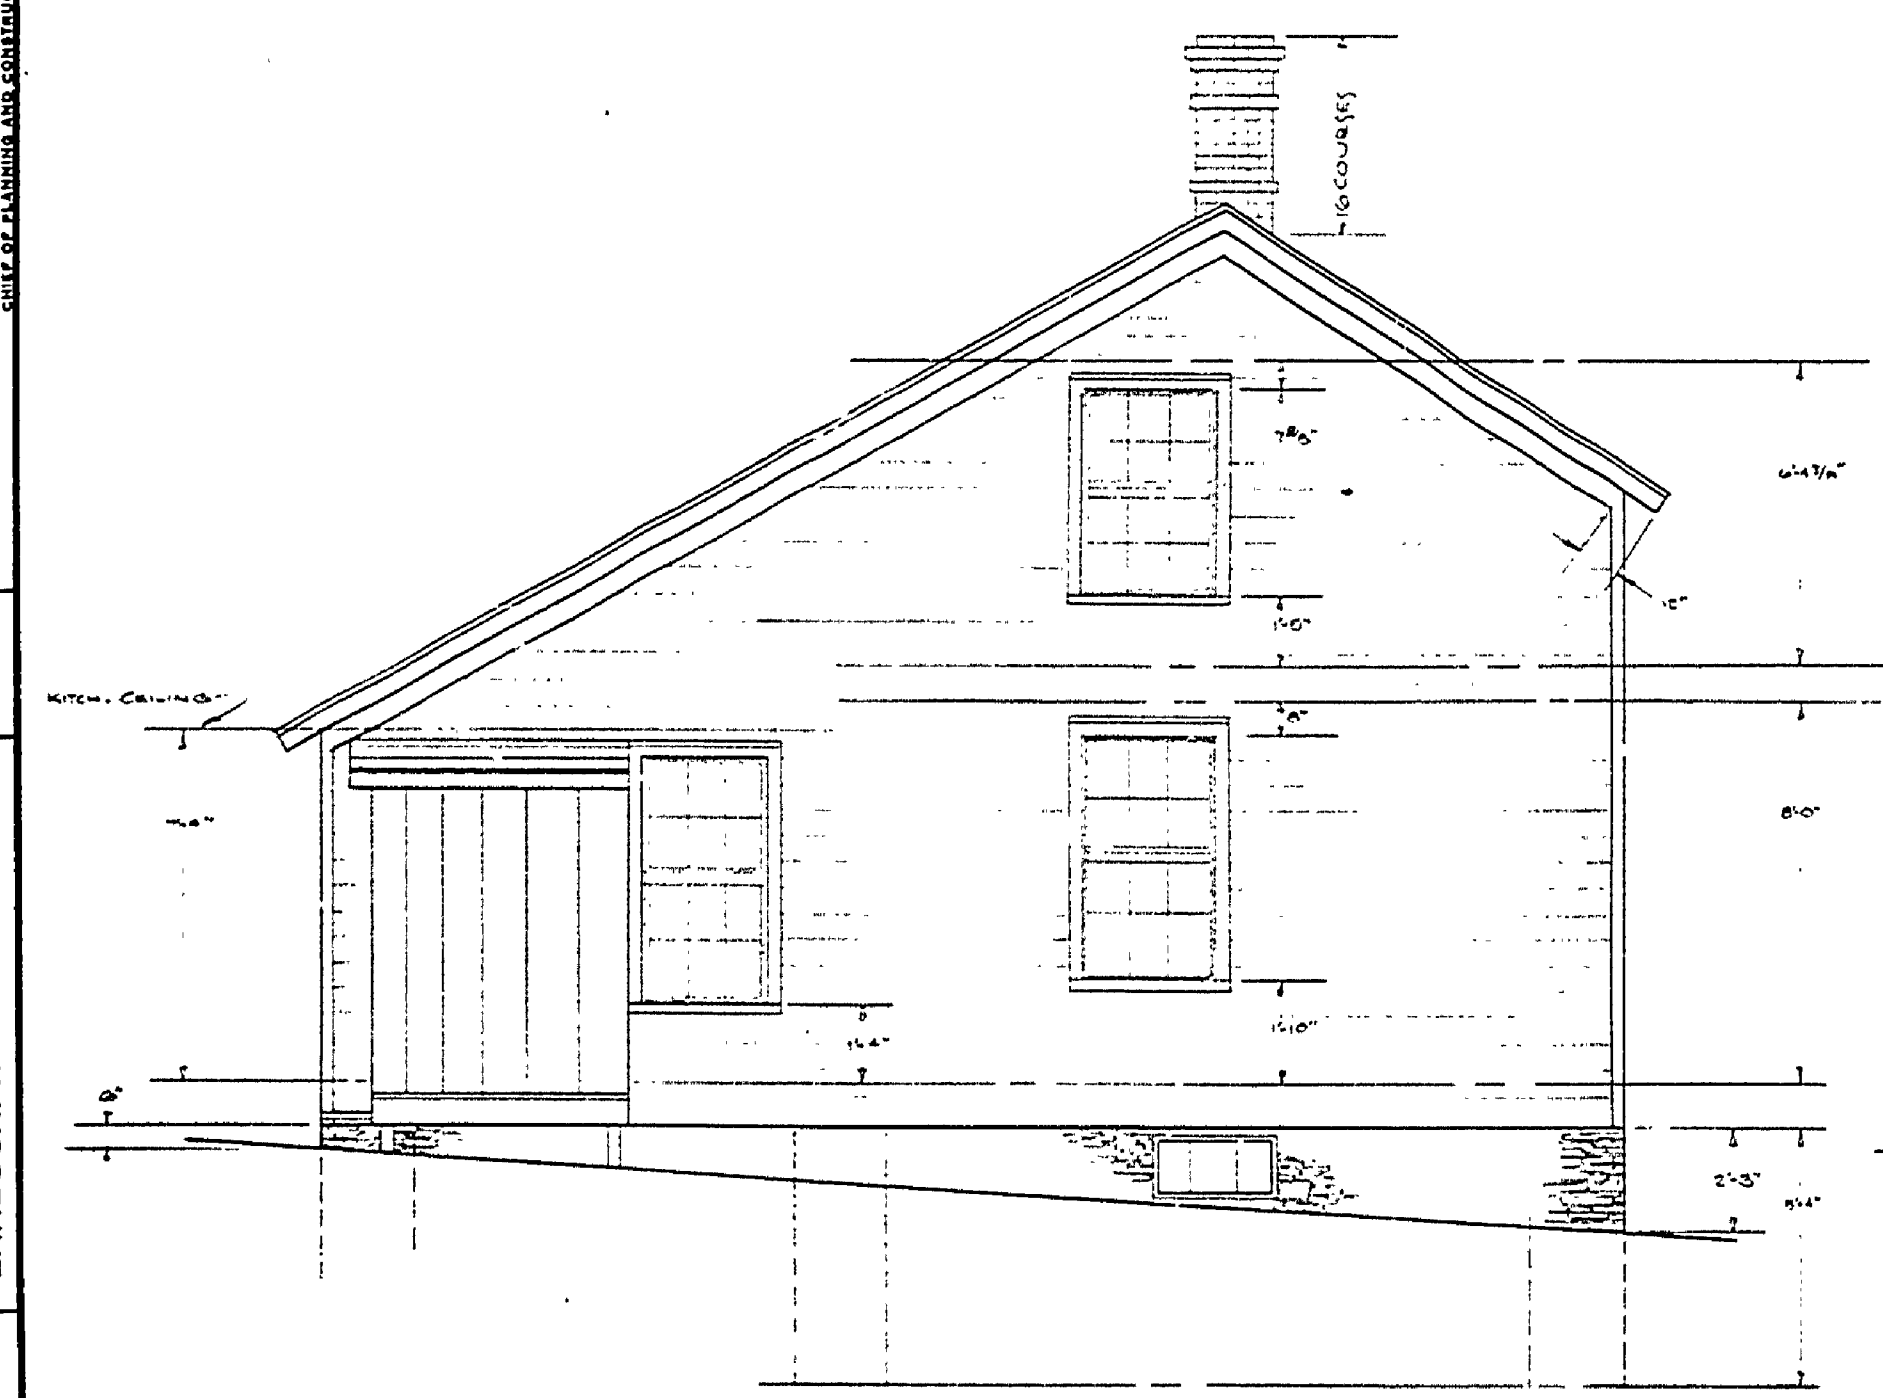


NORTH ELEVATION

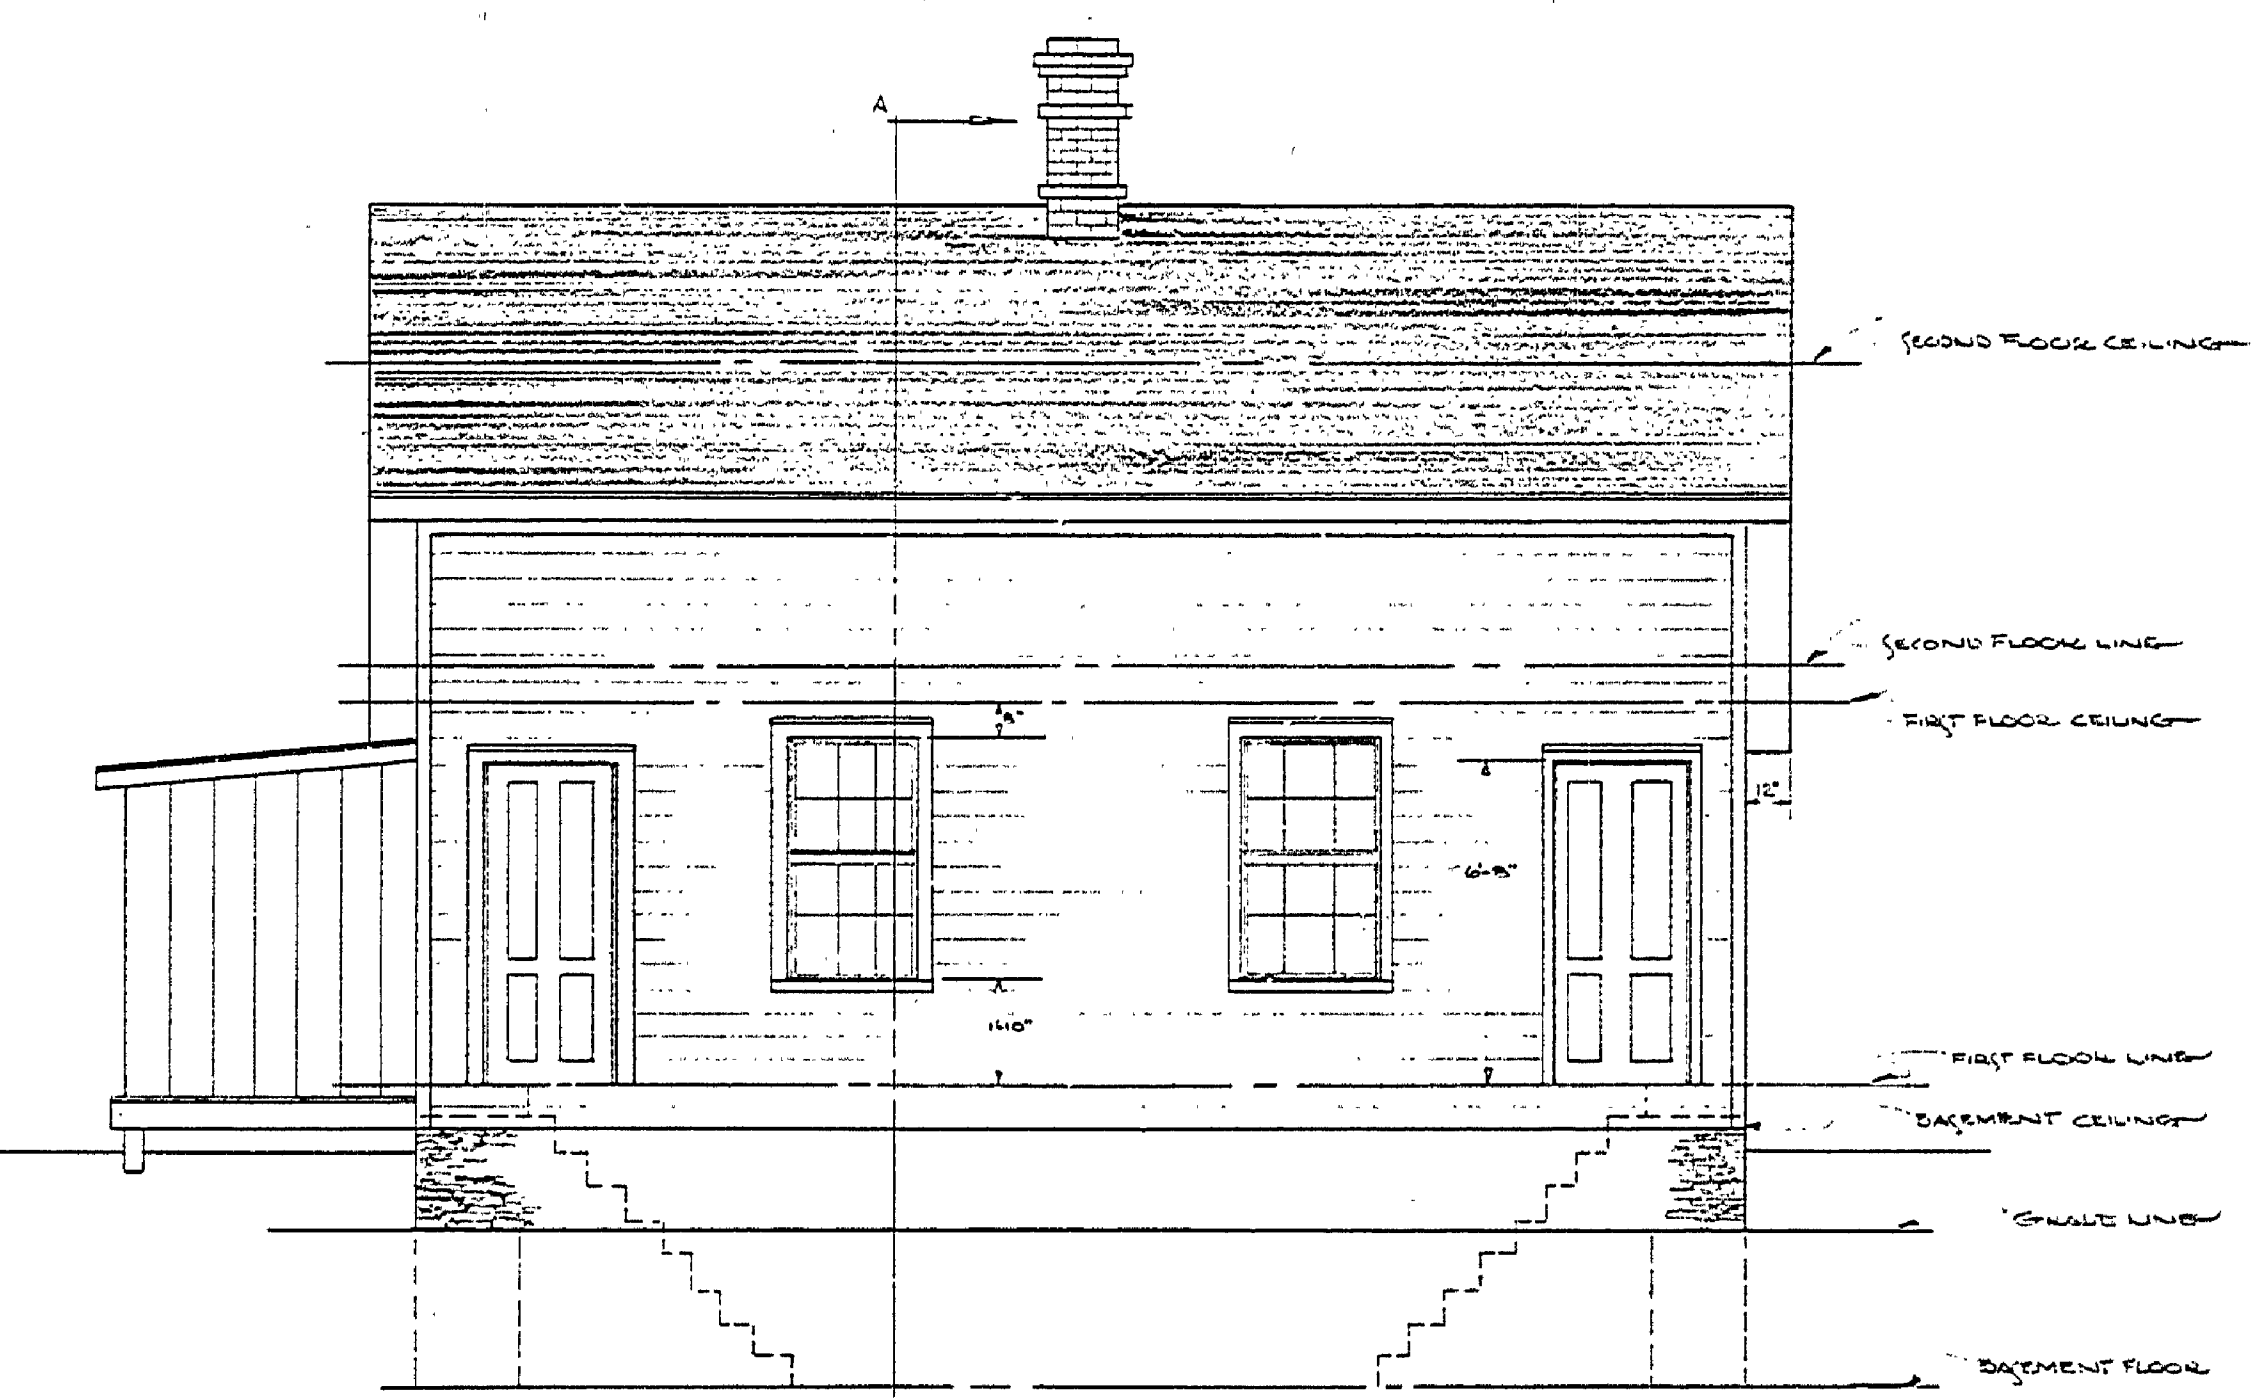

WEST ELEVATION

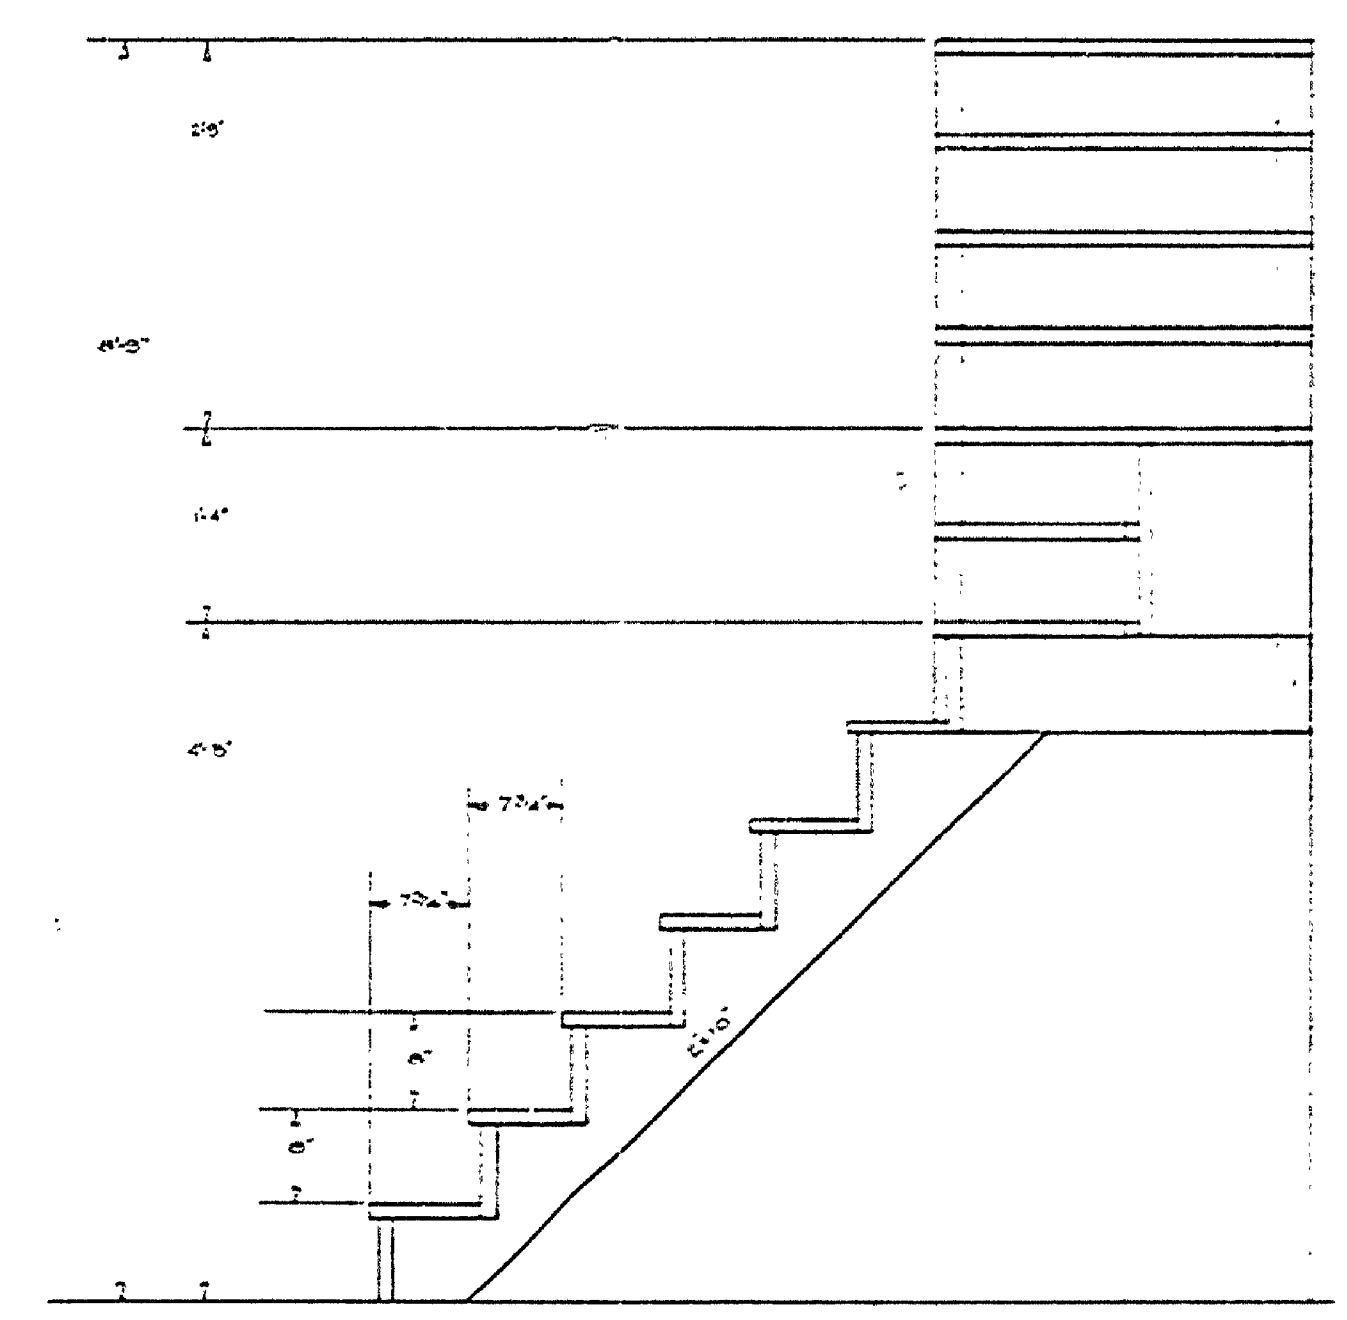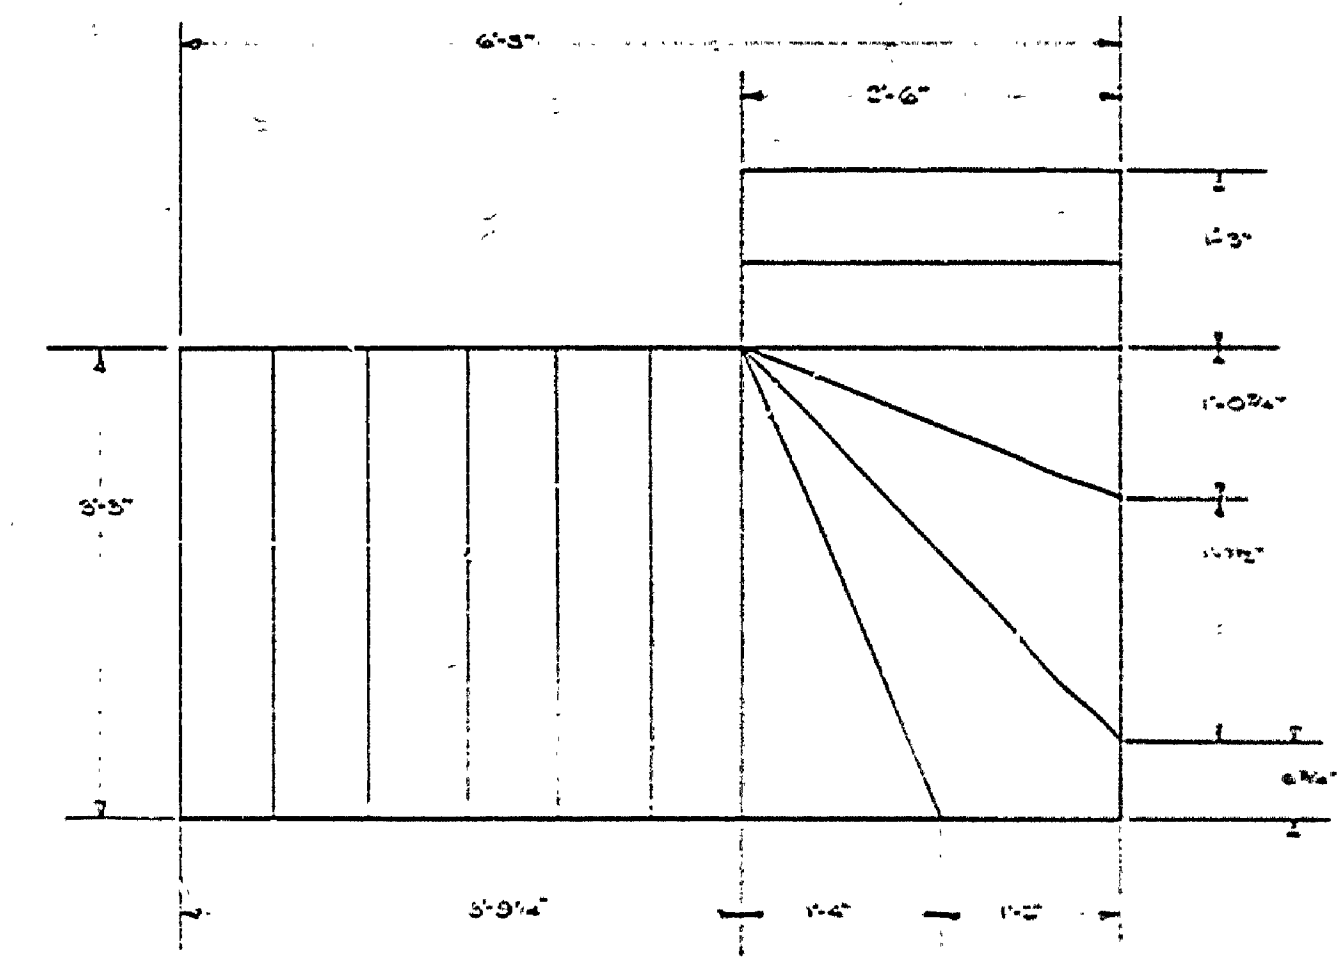

MAIN FLOOR DETAIL

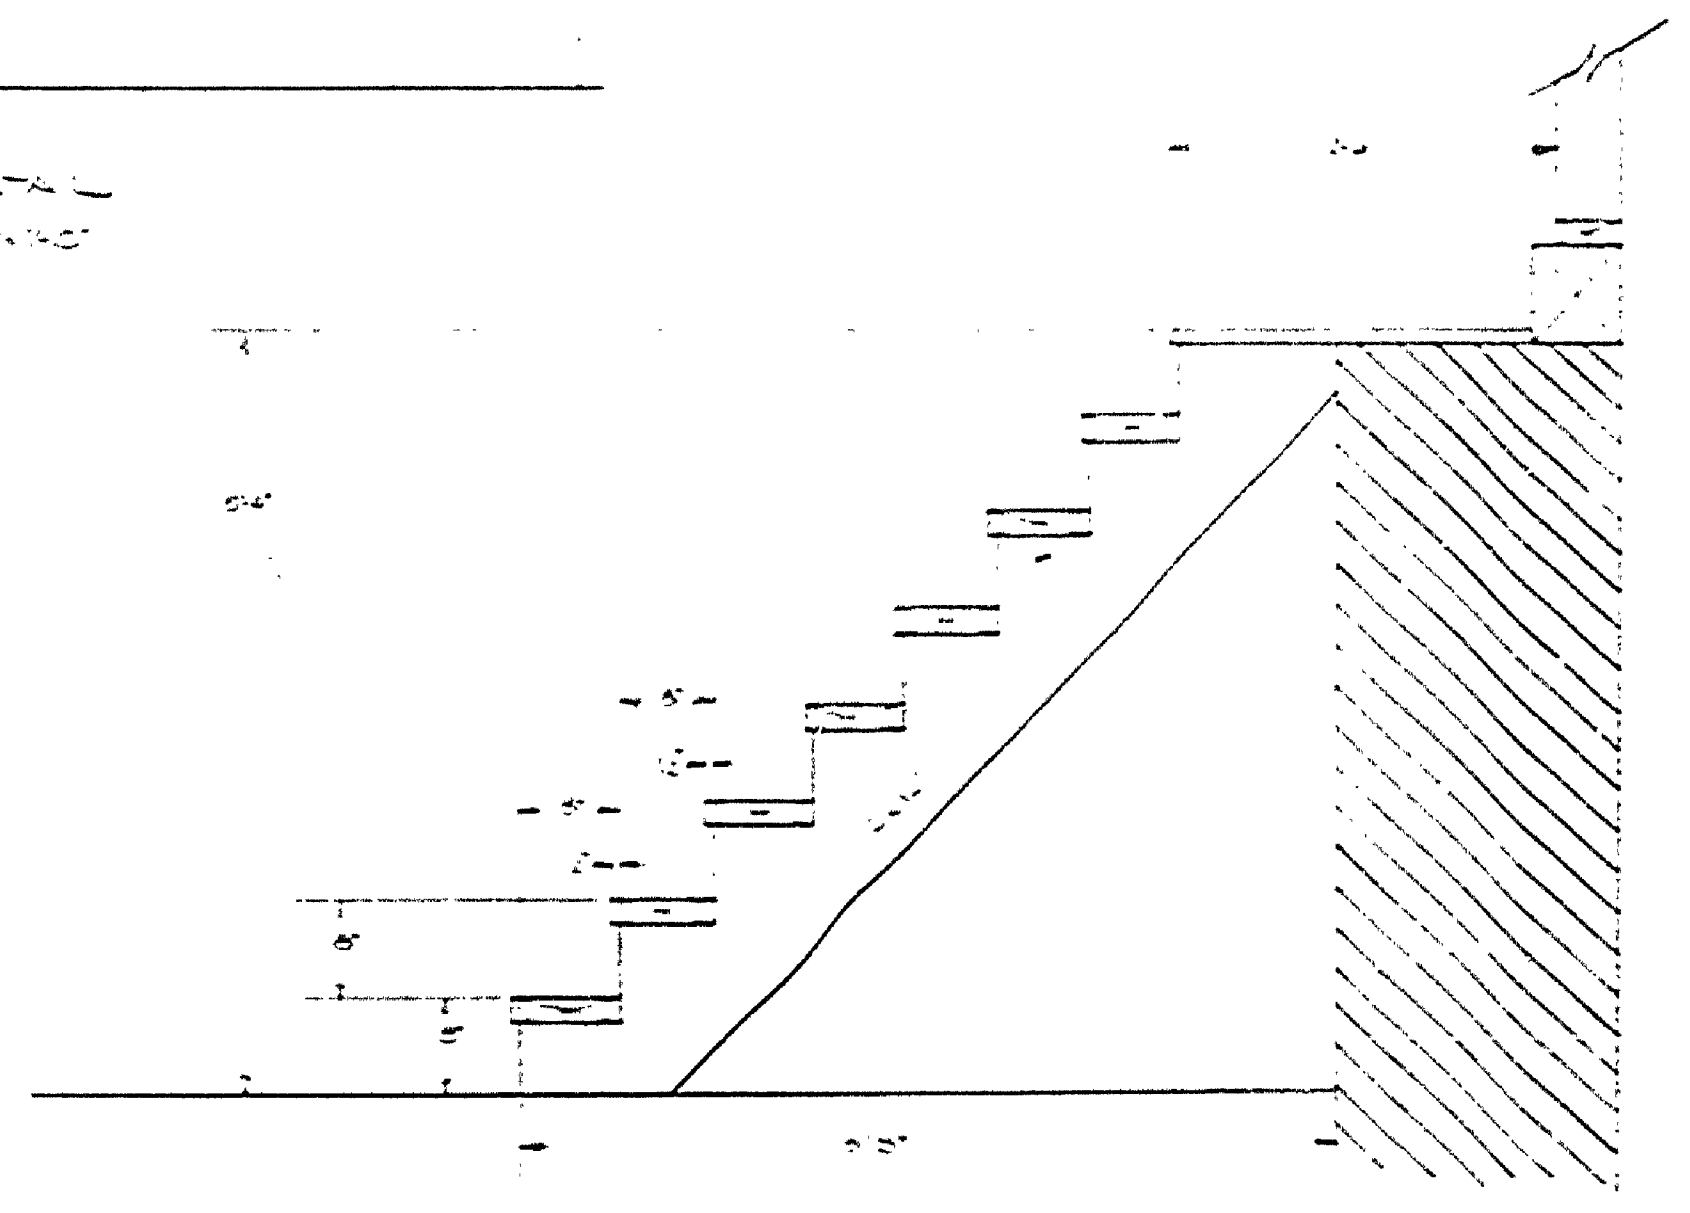

BASEMENT DETAIL

BUILDING 30231

MICHIGAN
DEPARTMENT OF CONSERVATION
PARKS AND RECREATION DIVISION

MEASURED DRAWING
FAYETTE ARCHITECTURAL ENGINEERS
FAYETTE STATE COLLEGE

SHEET NO. 1 OF 2 PLAN NO. A-30