


DESIGNED BY	DRAWN BY	CHECKED BY	DATE	REVIEWED	DATE	APPROVED	DATE	NO.	DATE	REVISIONS	DATE
				ARCHITECTURAL				1		4	
				ENGINEERING				2		5	
				LANDSCAPE				3		6	

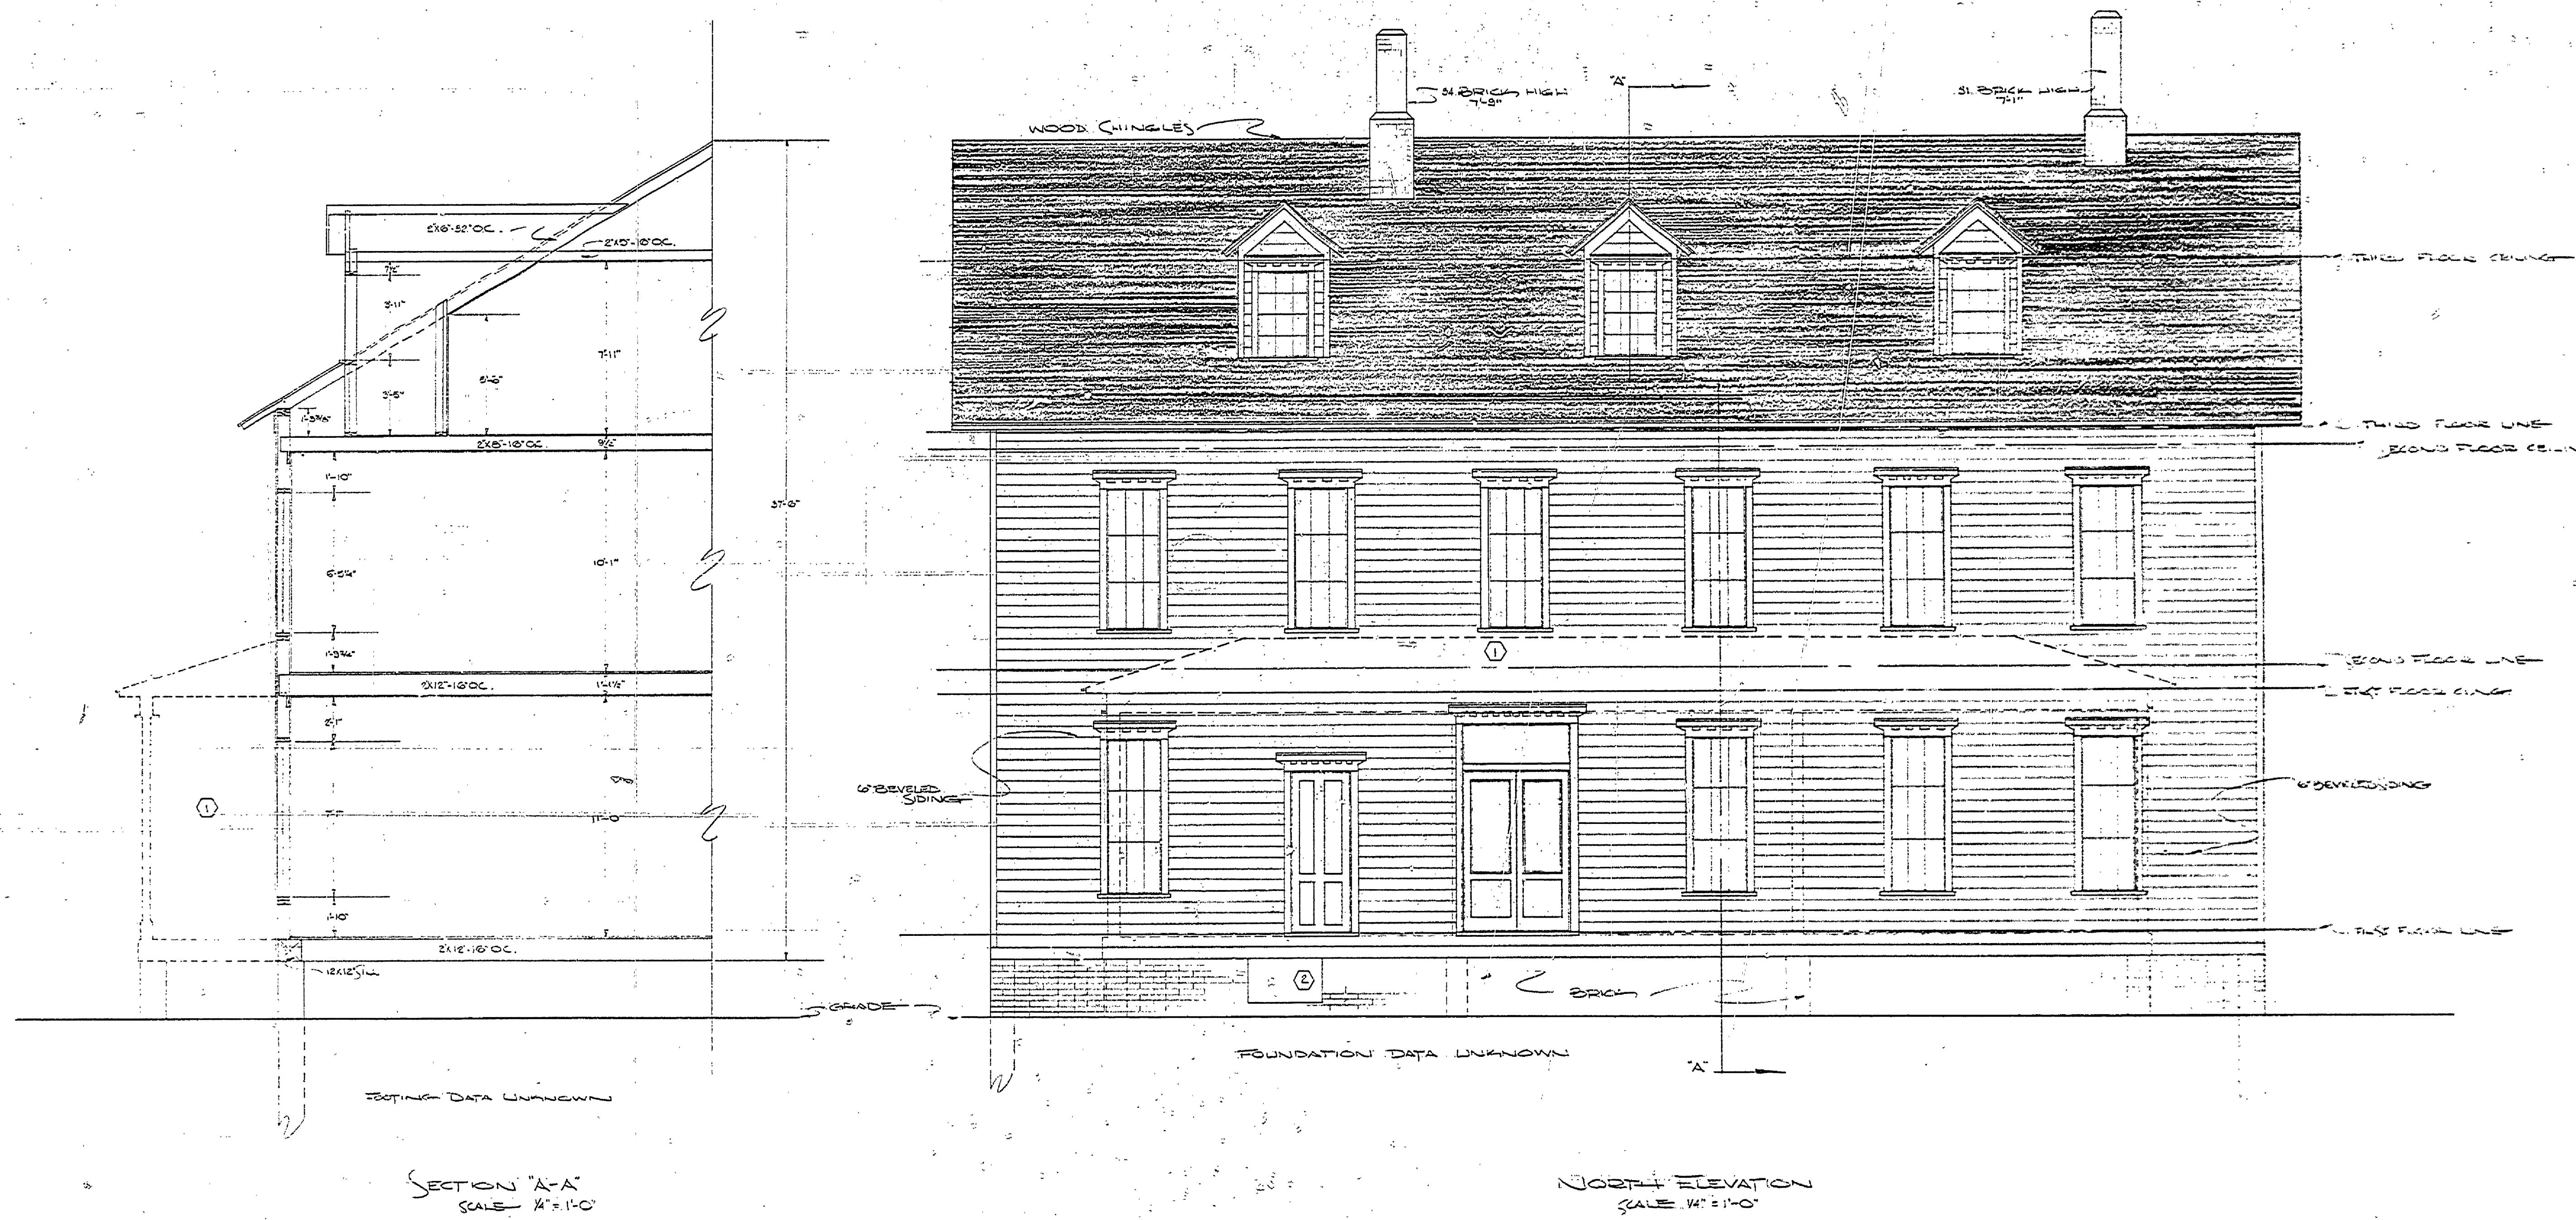

NORTH ELEVATION
SCALE 1/4" = 1'-0"

HOTEL & SALOON - BUILDING # 100

MICHIGAN
DEPARTMENT OF CONSERVATION
PARKS AND RECREATION DIVISION

MEASURED DRAWINGS
FAYETTE HISTORICAL TOWNSITE
FAYETTE STATE PARK

SHEET NO. 5
OF 11
PLAN NO. A-100