


DESIGNED BY	DRAWN BY	CHECKED BY	DATE	REVIEWED	DATE	APPROVED	DATE	NO.	DATE BY	REVISIONS	DATE BY
			5/24/02	ARCHITECTURAL ENGINEERING LANDSCAPE				1		4	
								2		5	
								3		6	

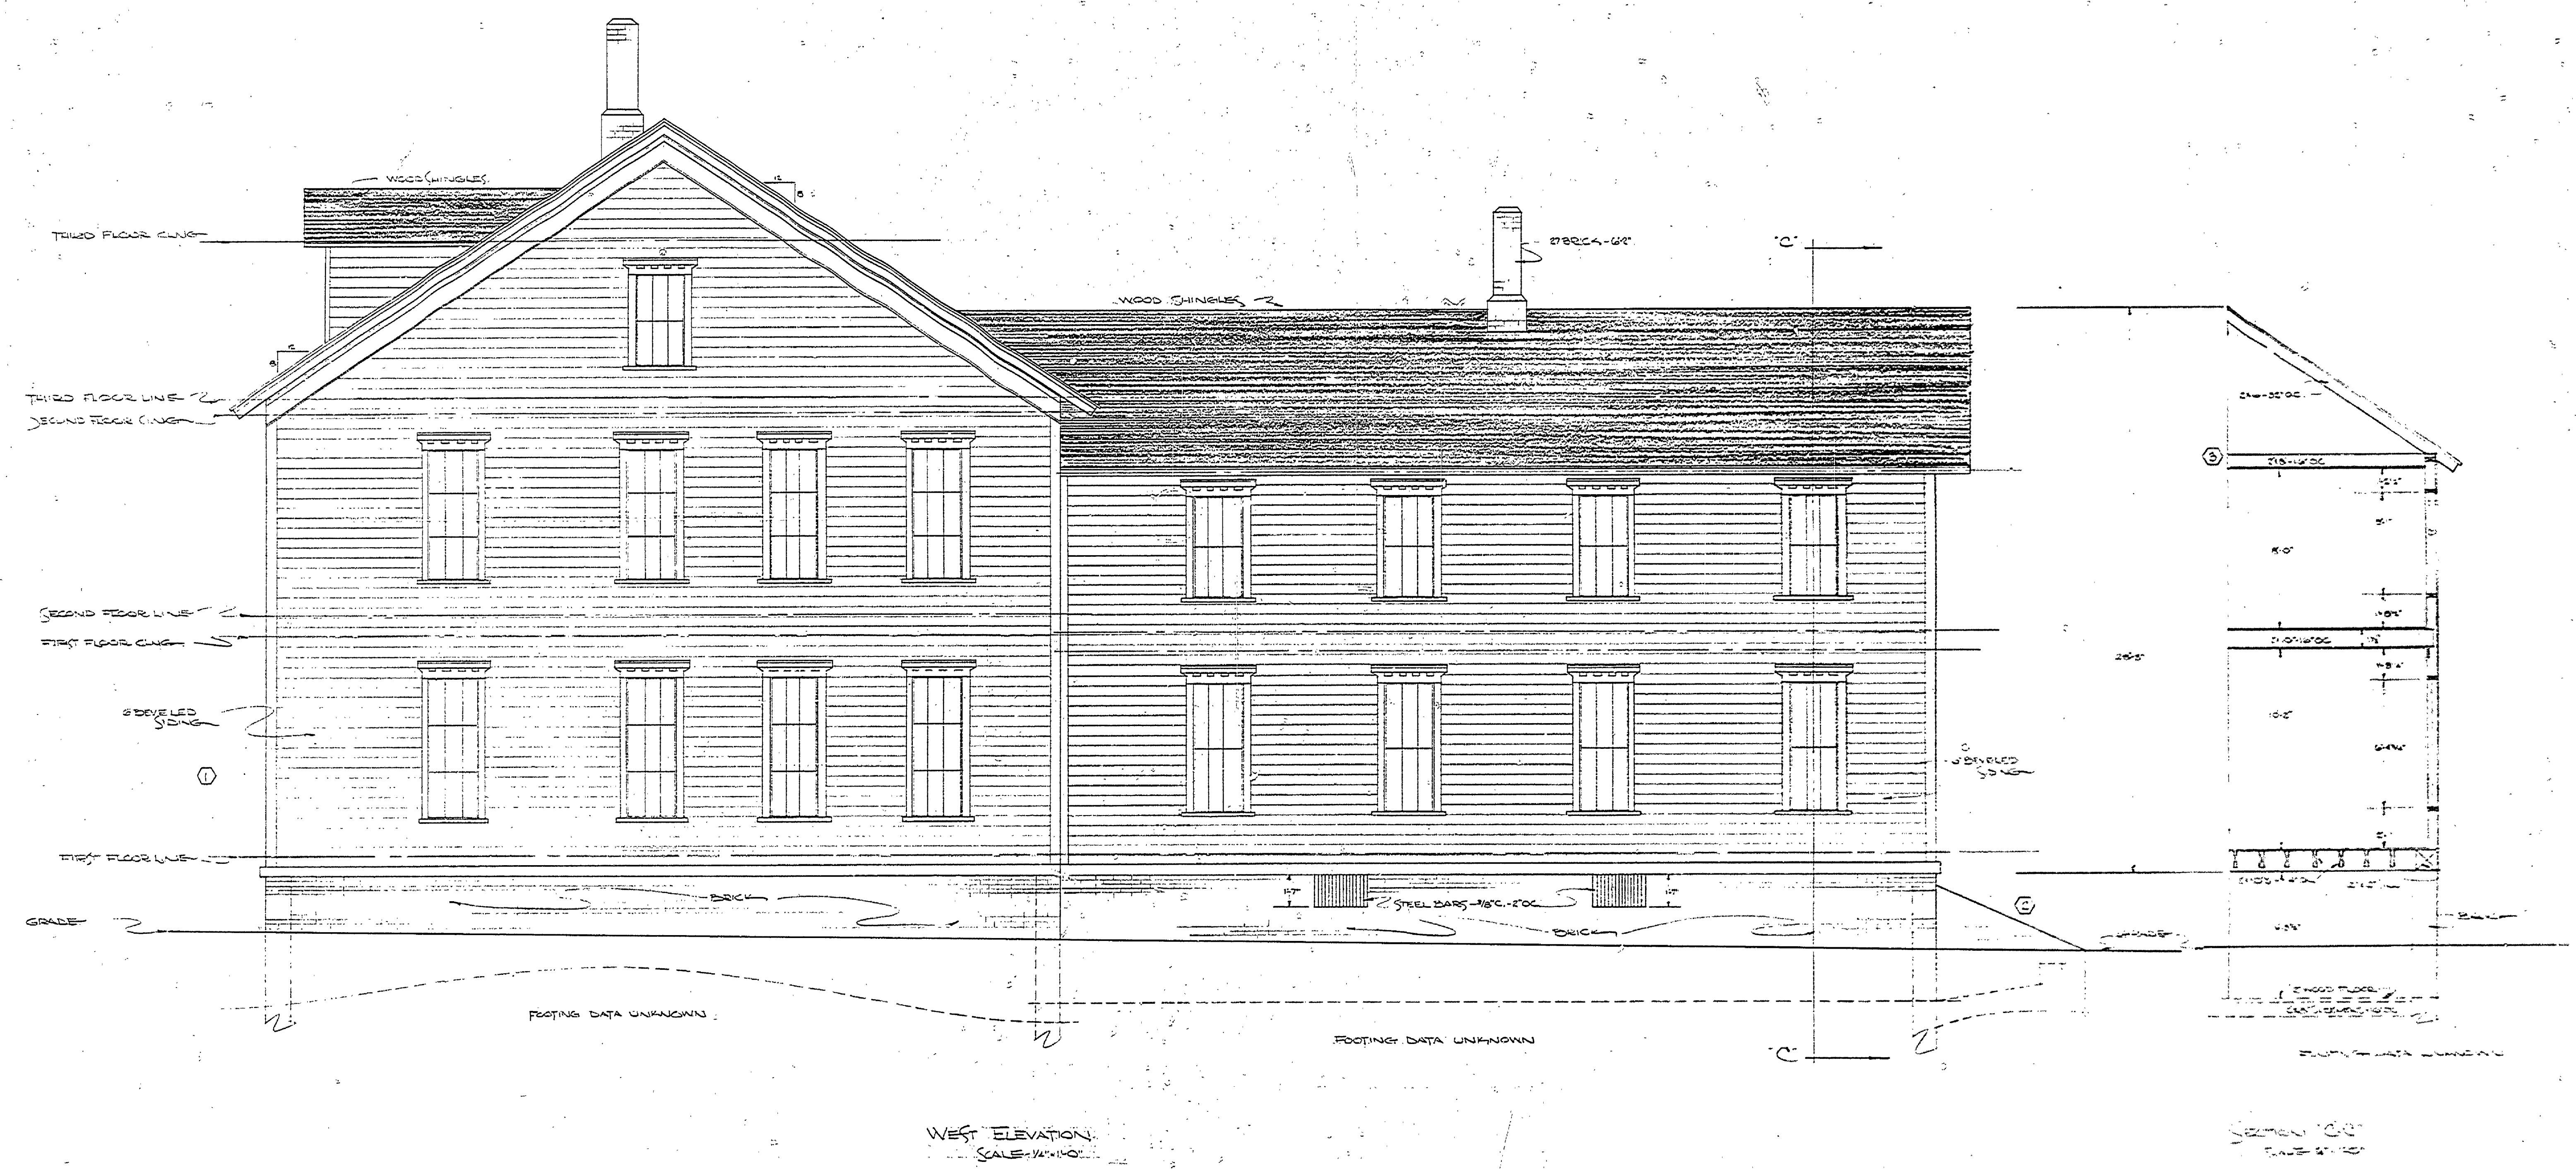

WEST ELEVATION
SCALE = 1/4" = 1'-0"

HOTEL & SALOON - BUILDING # 100

MICHIGAN
DEPARTMENT OF CONSERVATION
PARKS AND RECREATION DIVISION

MEASURED DRAWINGS
FAYETTE HISTORICAL TOWNSITE
FAYETTE GATE PARK

SHEET
NO. 7
OF 11
PLAN NO.
A-100