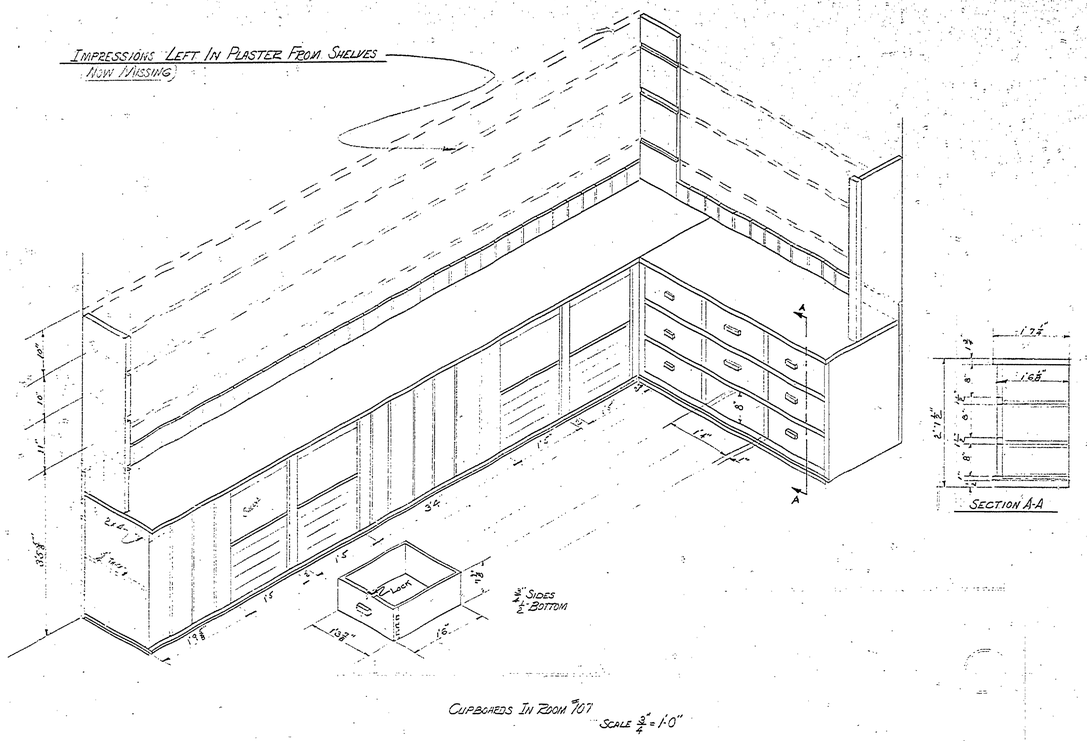

CUPBOARDS IN ROOM 107 SCALE 3/4" = 1'-0"

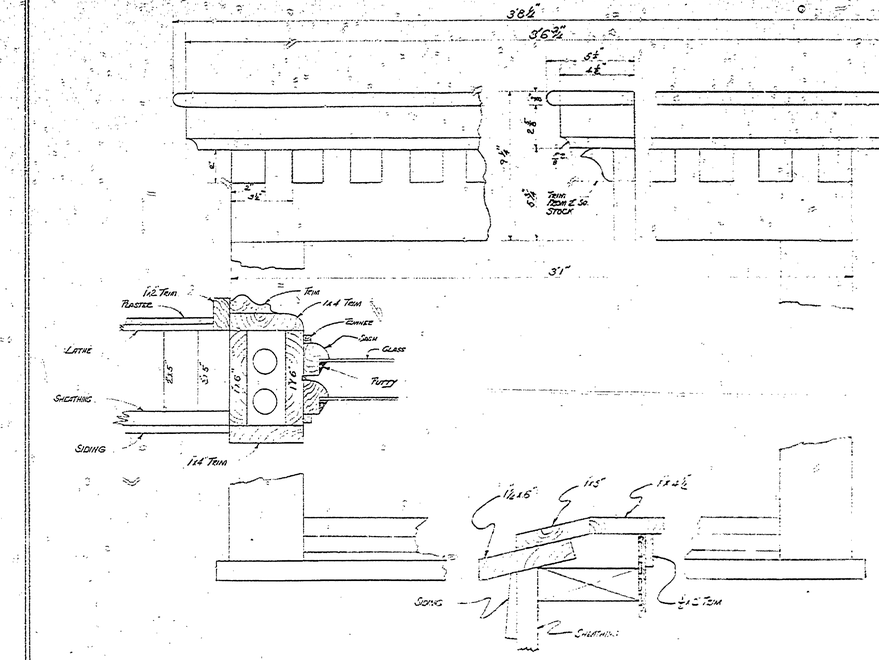

TYPICAL WINDOW SCALE 3" = 1'-0"

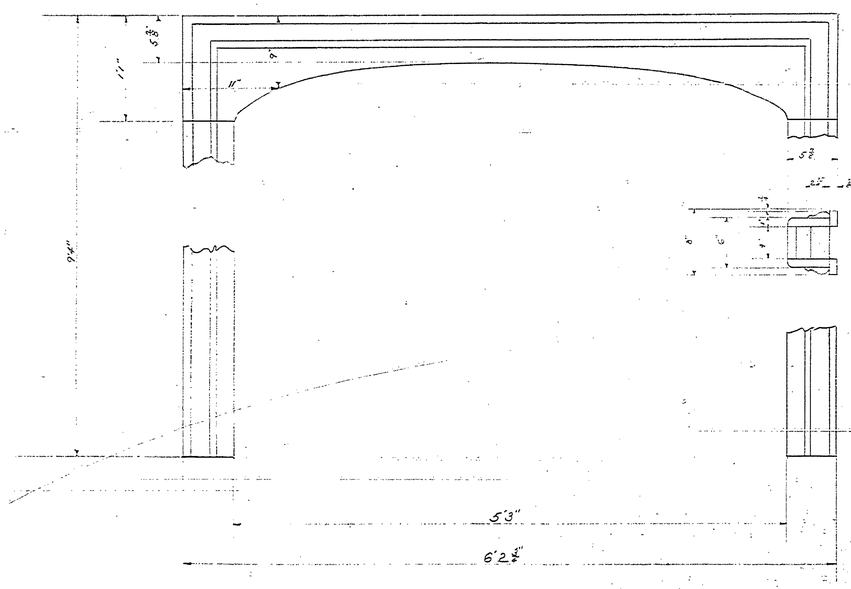

ARCHWAY 1ST FLOOR SCALE 1 1/2" = 1'-0"

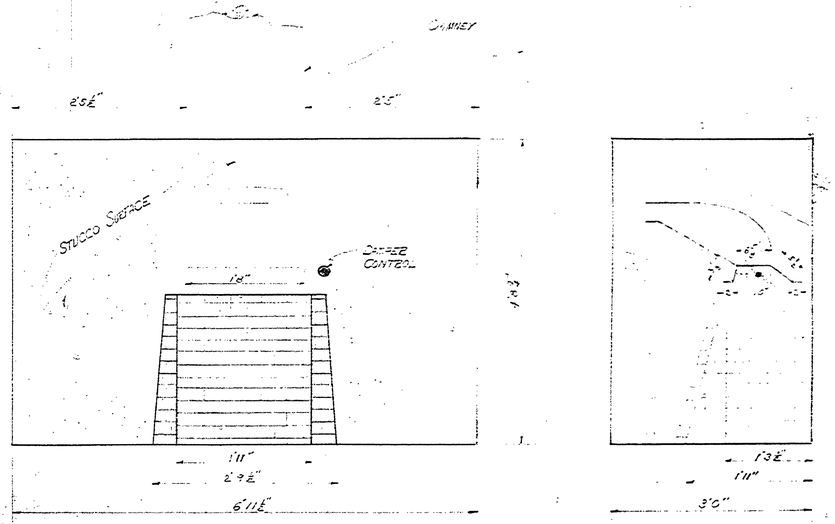

FIREPLACE IN ROOM 103 SCALE 1" = 1'-0"

DATE	BY

REVISIONS

NO.	DATE	BY
1		
2		
3		
4		
5		
6		

APPROVED	DATE
CHIEF OF DIVISION	
ASST. CHIEF OF DIVISION	
CHIEF OF PLANNING AND CONSTRUCTION	

REVIEWED	DATE
ARCHITECTURAL	
ENGINEERING	
LANDSCAPE	

	DATE
DESIGNED BY	
DRAWN BY	11/7/66
CHECKED BY	

MICHIGAN
DEPARTMENT OF CONSERVATION
PARKS AND RECREATION DIVISION

MEASURED DRAWINGS
FAYETTE HISTORICAL TOWNSITE
FAYETTE STATE PARK
HOTEL #100

DETAIL SHEET NO. 10 OF 11

PLAN NO. A-100