



DESIGNED BY	DATE	REVIEWED	DATE	APPROVED	DATE	NO.	DATE	BY	REVISIONS	DATE	BY
DRWN BY R. ELLIOTT	4-12-61	ARCHITECTURAL	4-17-61			1			4		
CHECKED BY W.H.G.	4-12-61	ENGINEERING	4-27-61			2			5		
		LANDSCAPE	4-27-61			3	5-2-61		6		

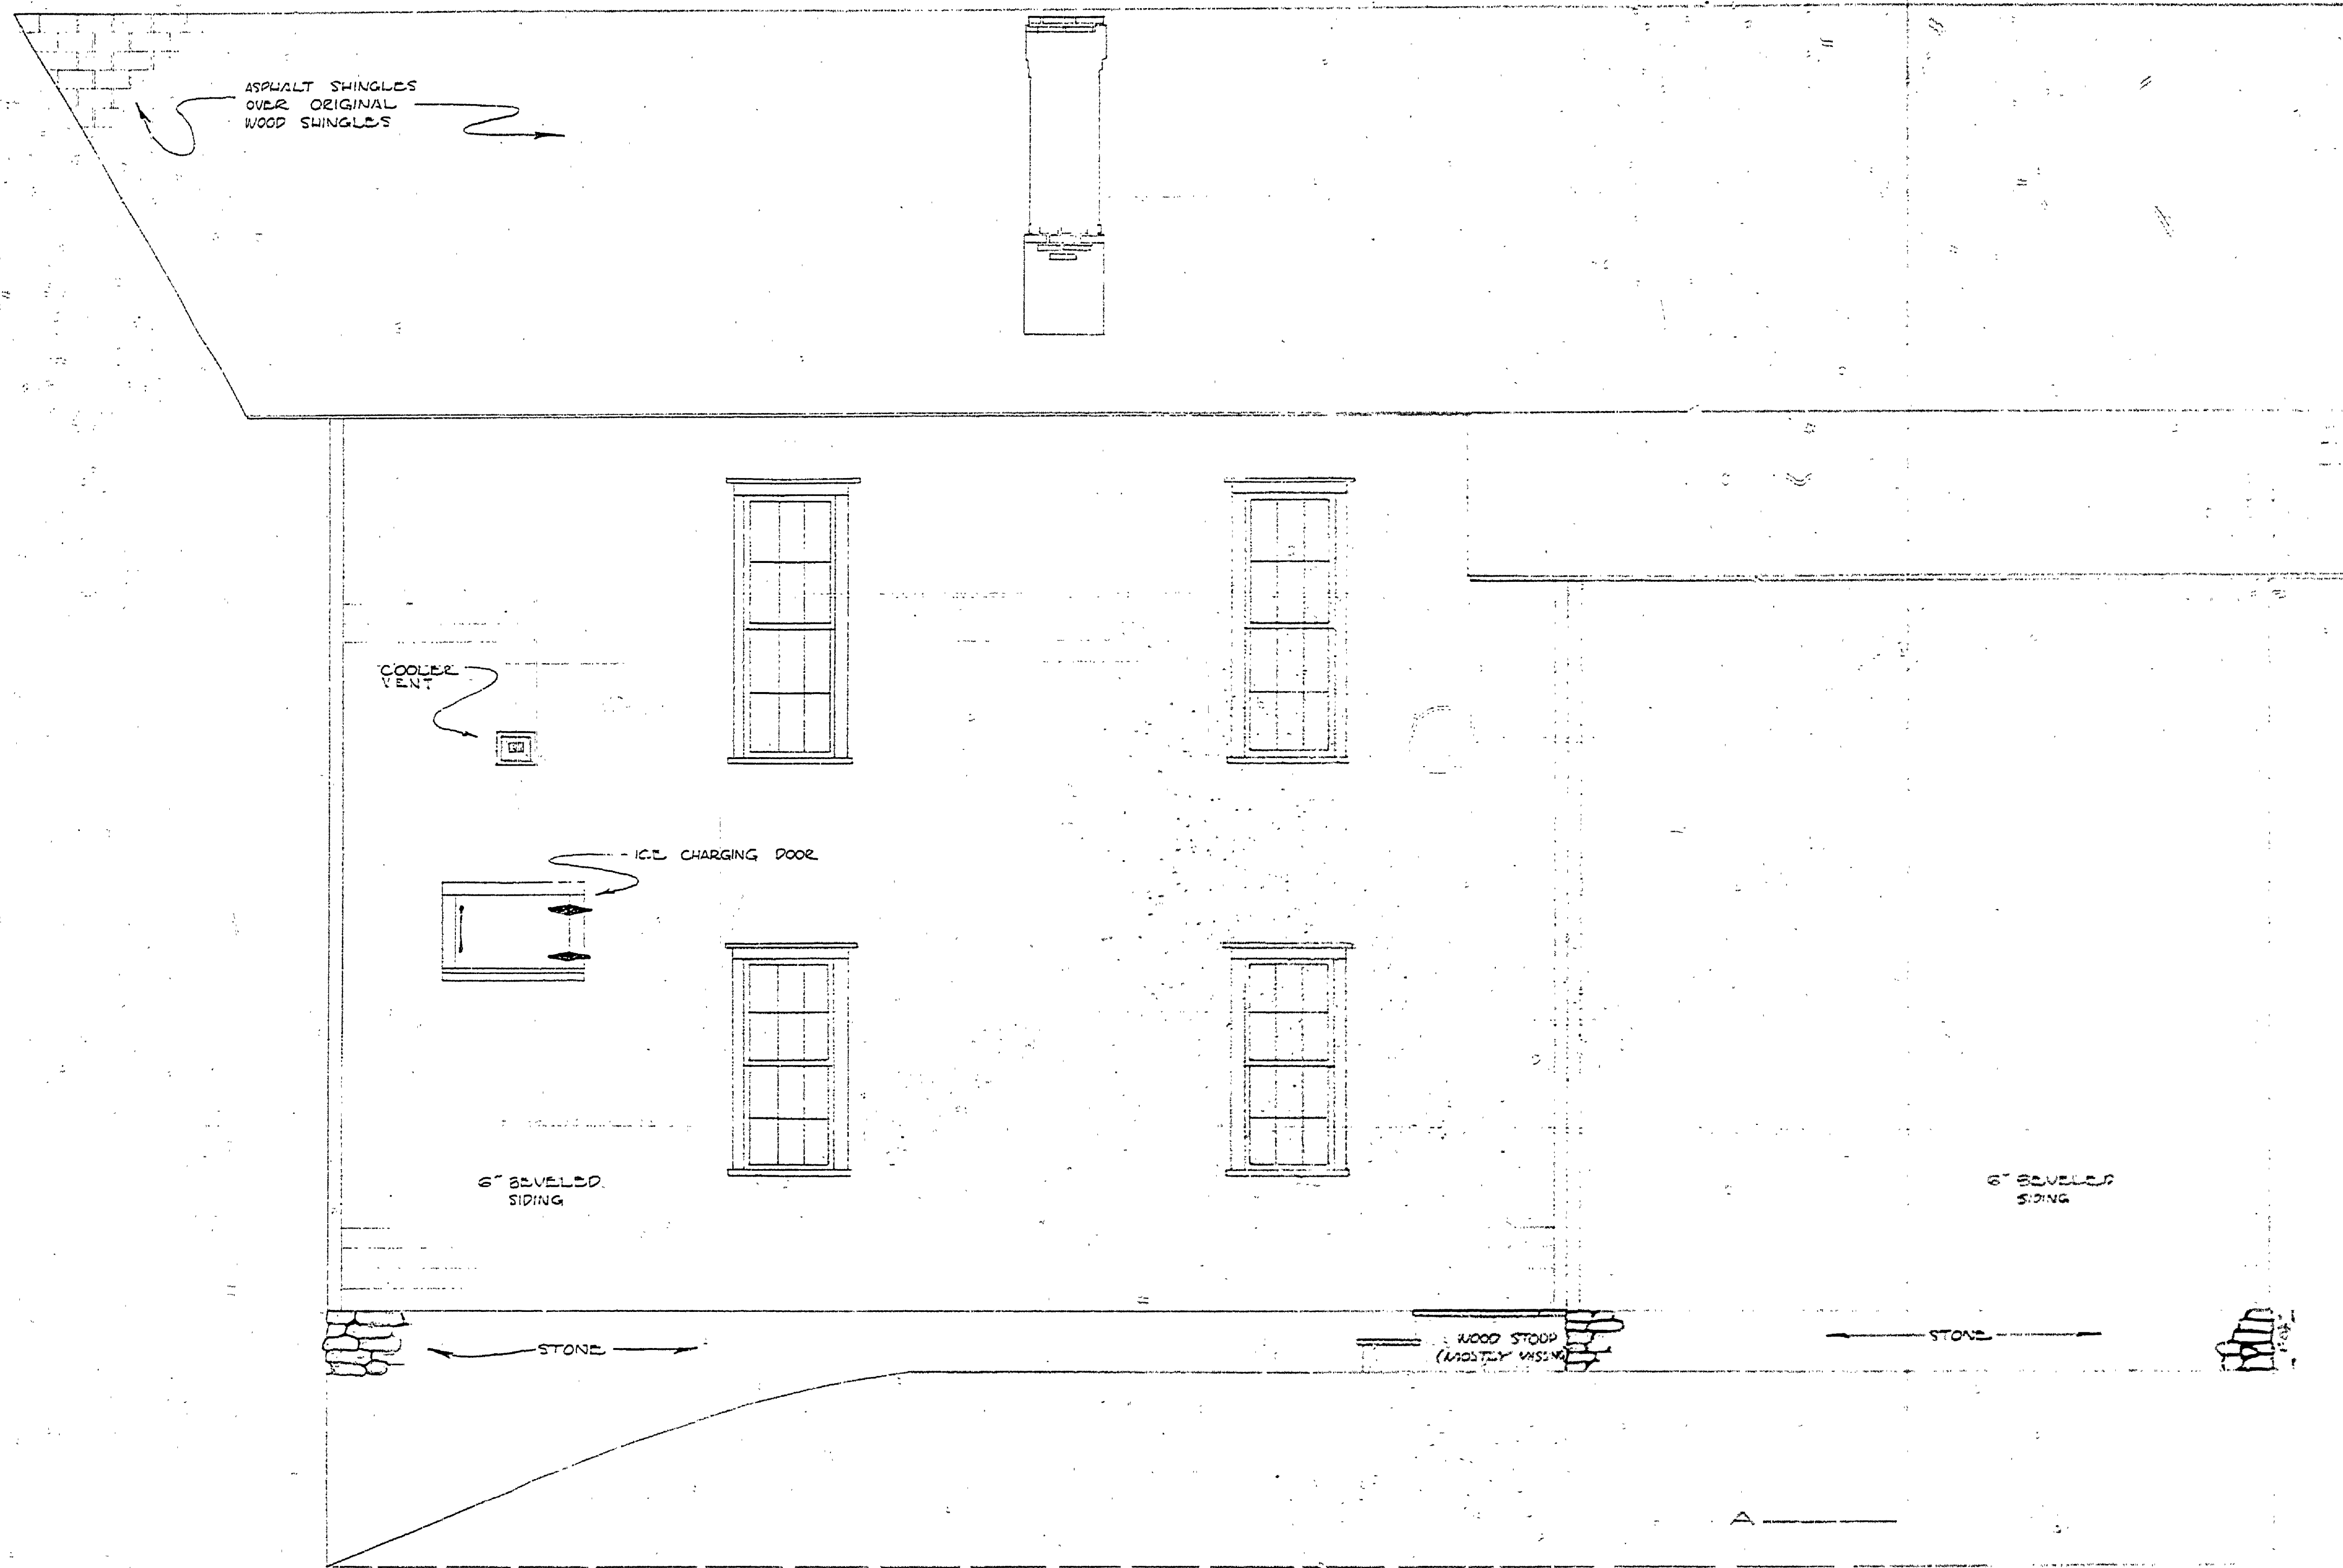

WEST ELEVATION
SCALE 3/8" = 1'

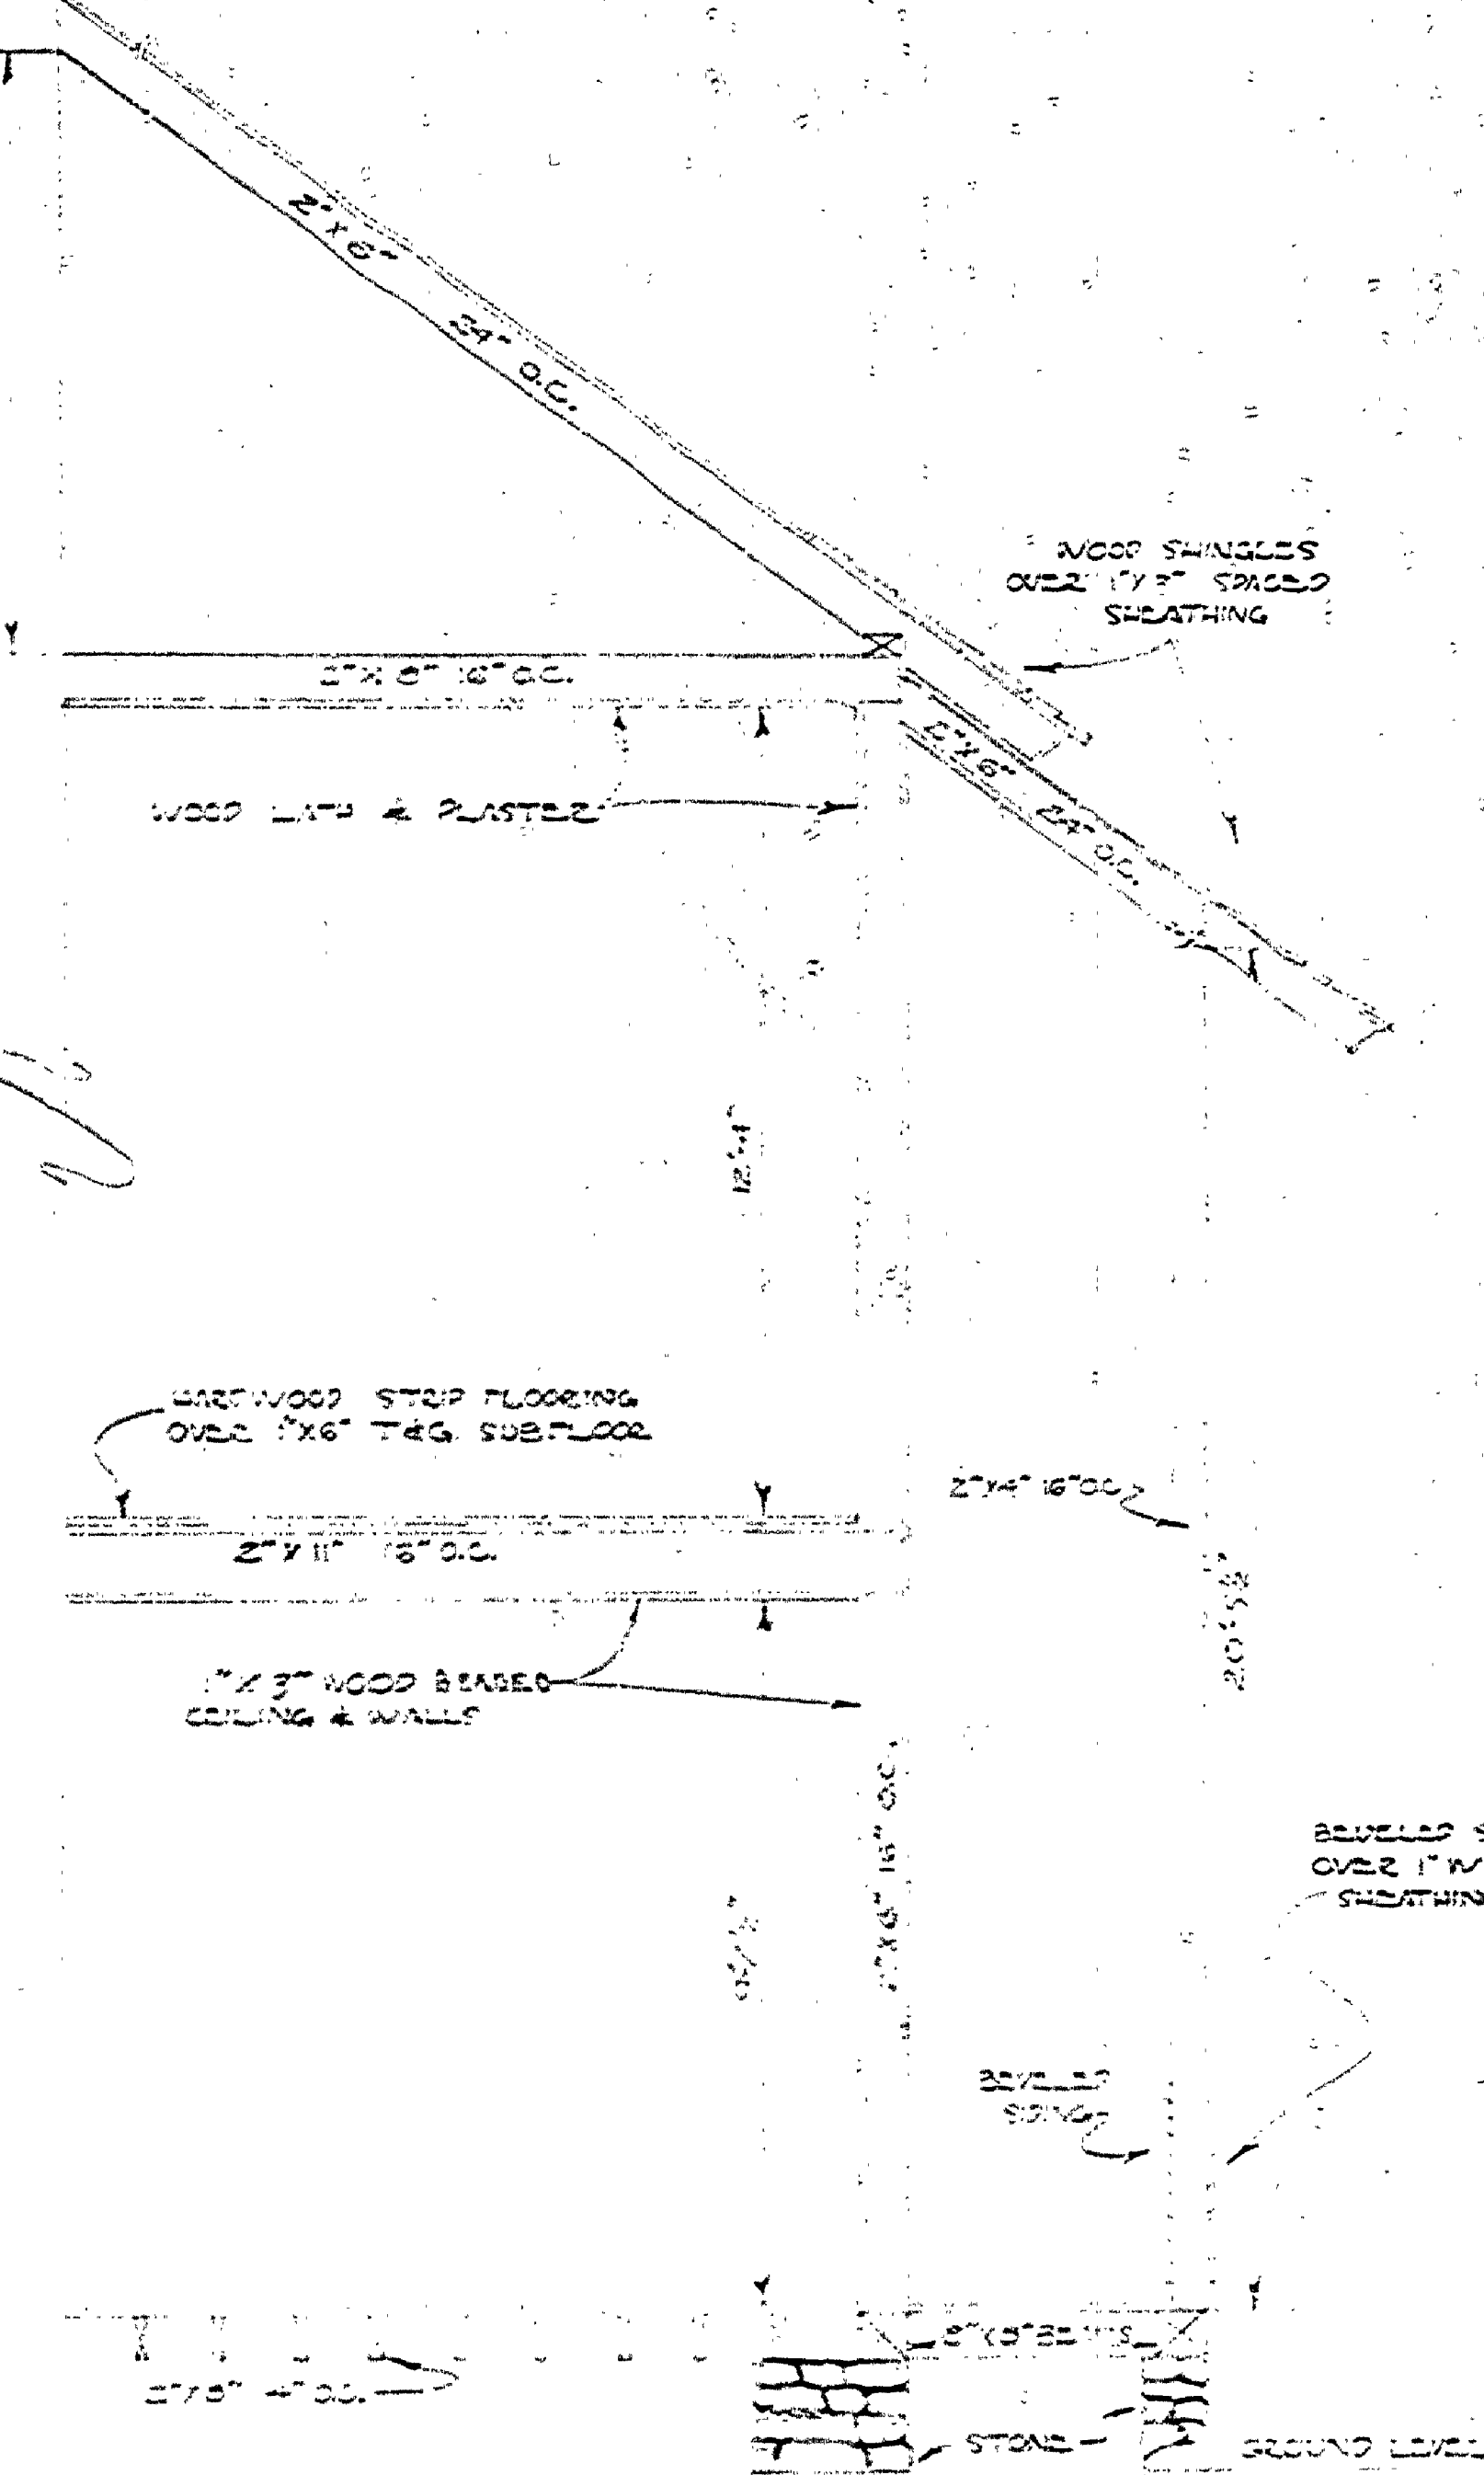

SECTION A-A
SCALE 3/8" = 1'

MICHIGAN
DEPARTMENT OF CONSERVATION
PARKS AND RECREATION DIVISION

MEASURED DRAWINGS
MAYETTE HISTORICAL TOWNSITE
MAYETTE STATE PARK
BUILDING NO. 101

SHEET
NO. 4
OF 8

PLAN NO.
A-101