



DESIGNED BY	DATE	REVIEWED	DATE	APPROVED	DATE	NO.	DATE	BY	REVISIONS	DATE	BY
W.A.C.	4-17-61	ARCHITECTURAL	4-17-61	<i>[Signature]</i>	1	1			4		
W.A.C.	4-17-61	ENGINEERING	4-17-61		2	2			5		
W.A.C.	4-22-61	LANDSCAPE	4-22-61		3	3	5-2-61		6		

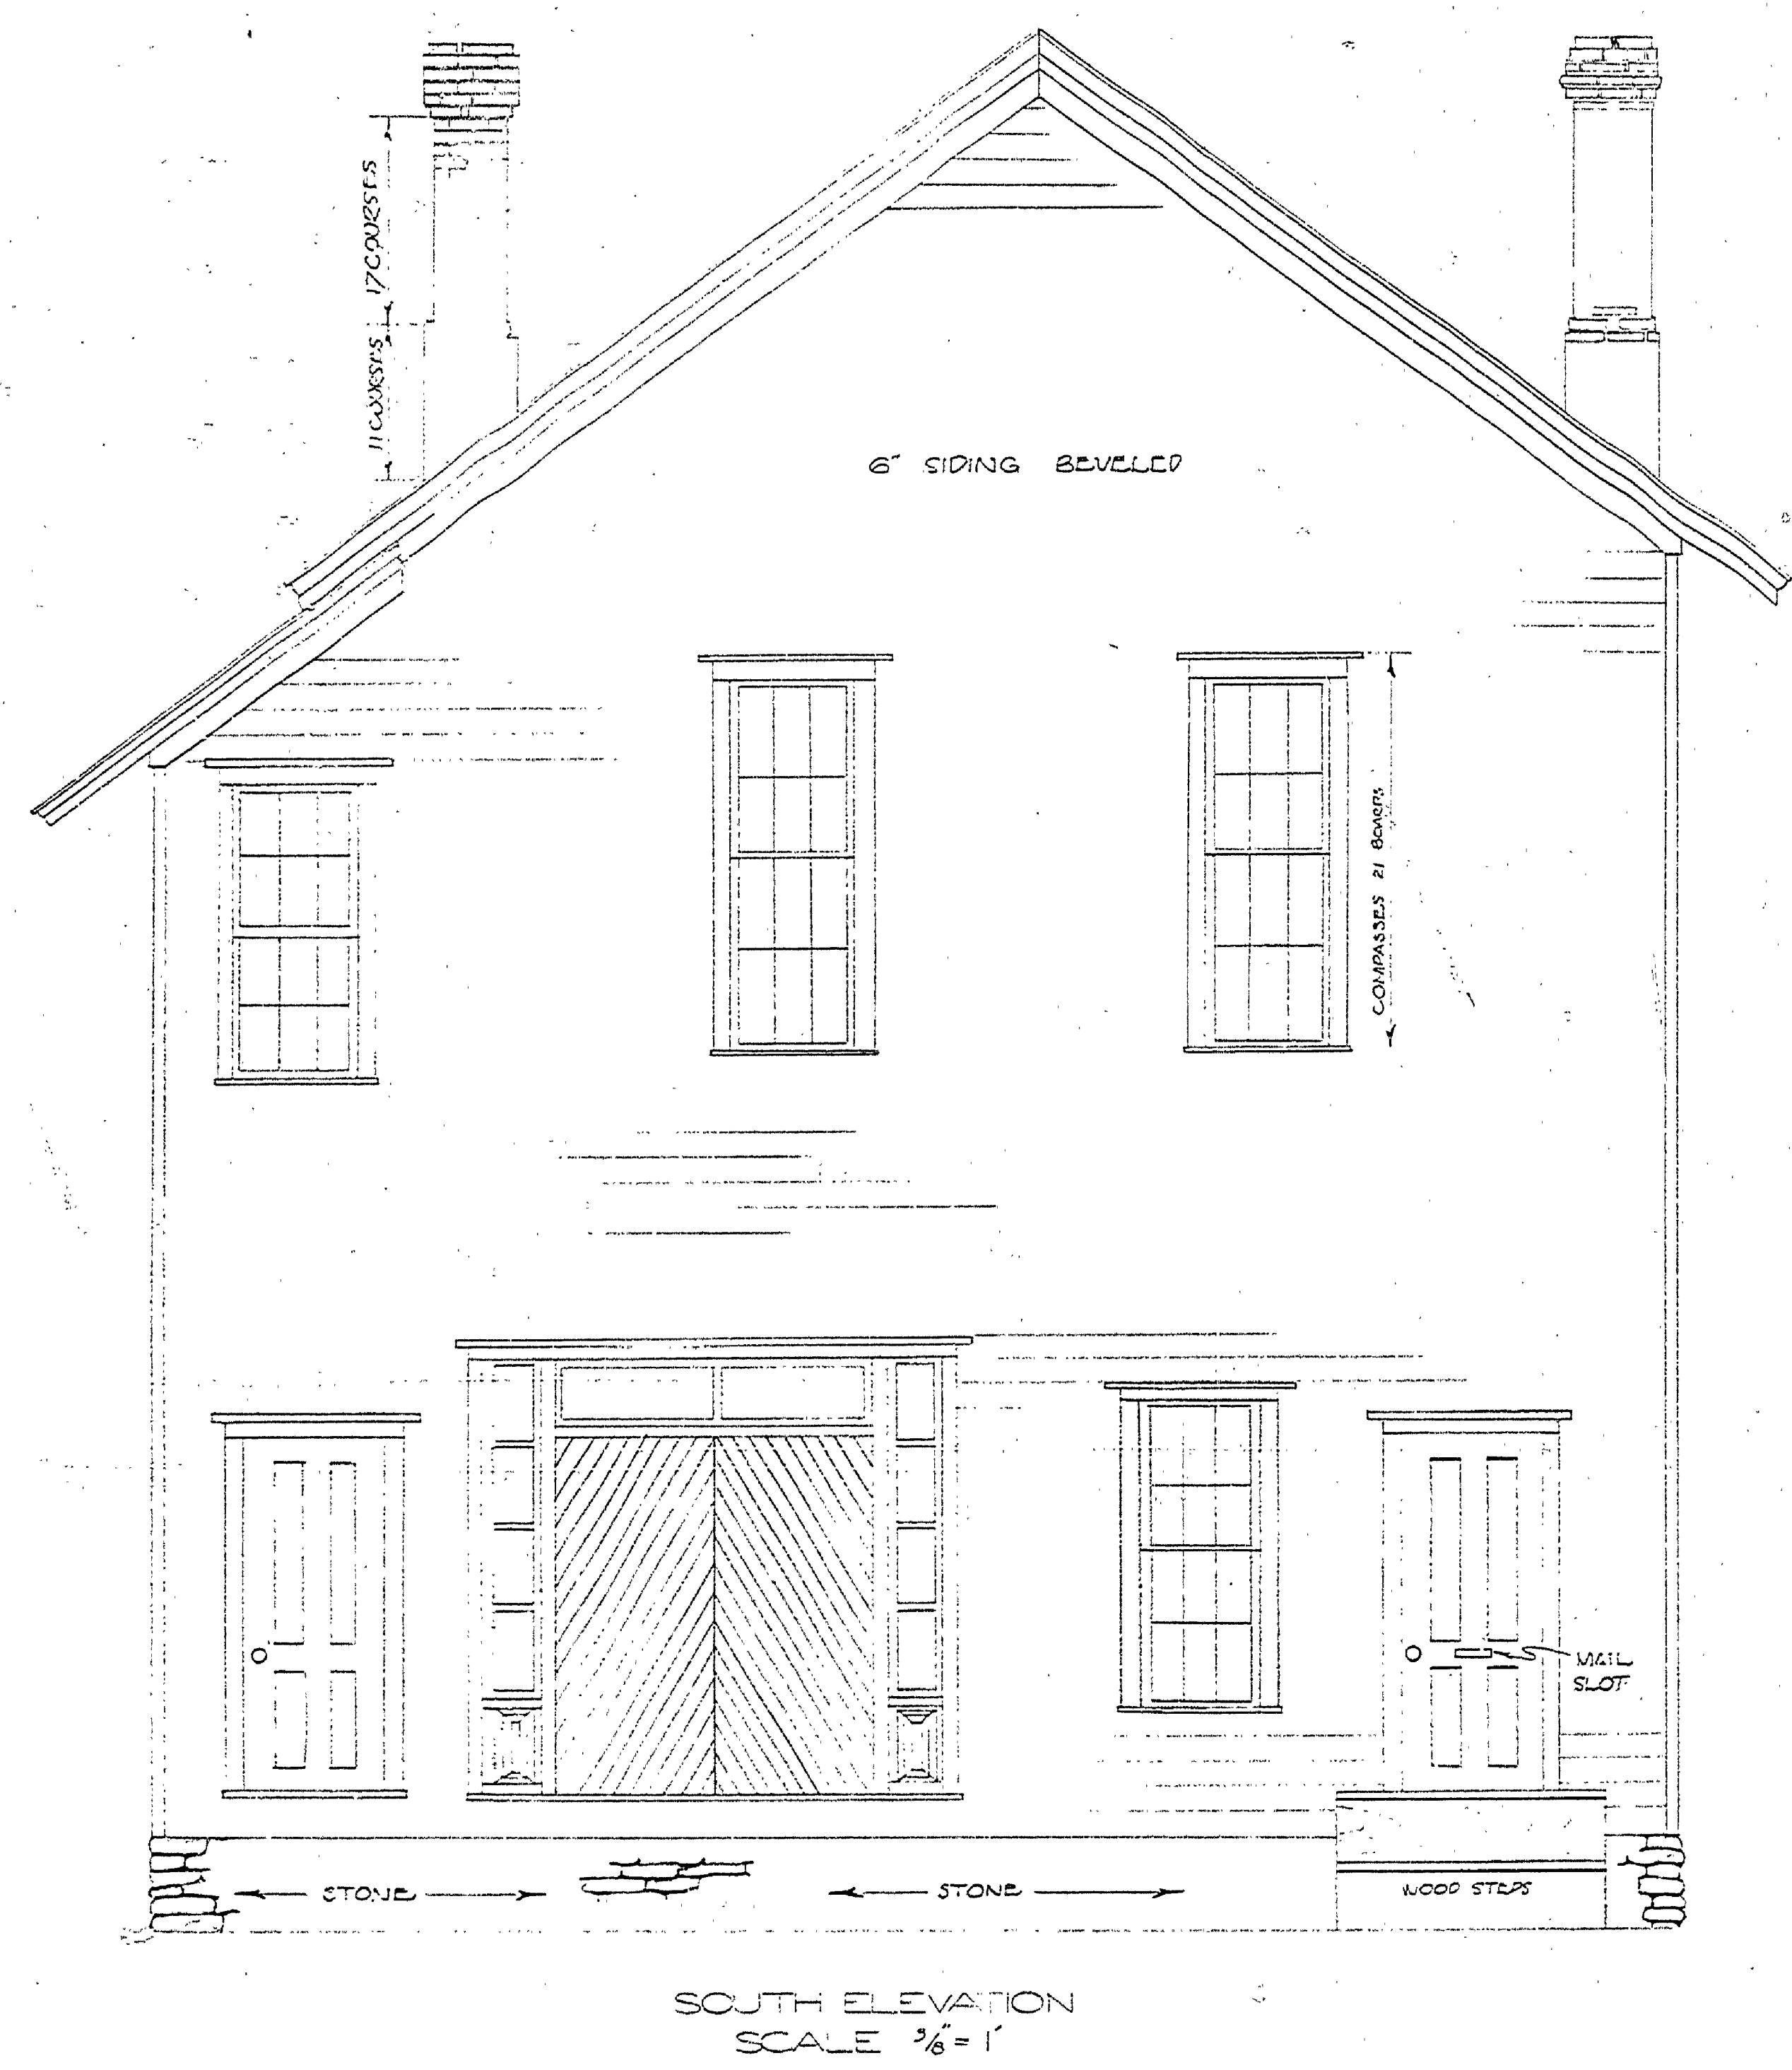

SOUTH ELEVATION  
SCALE 3/8" = 1'

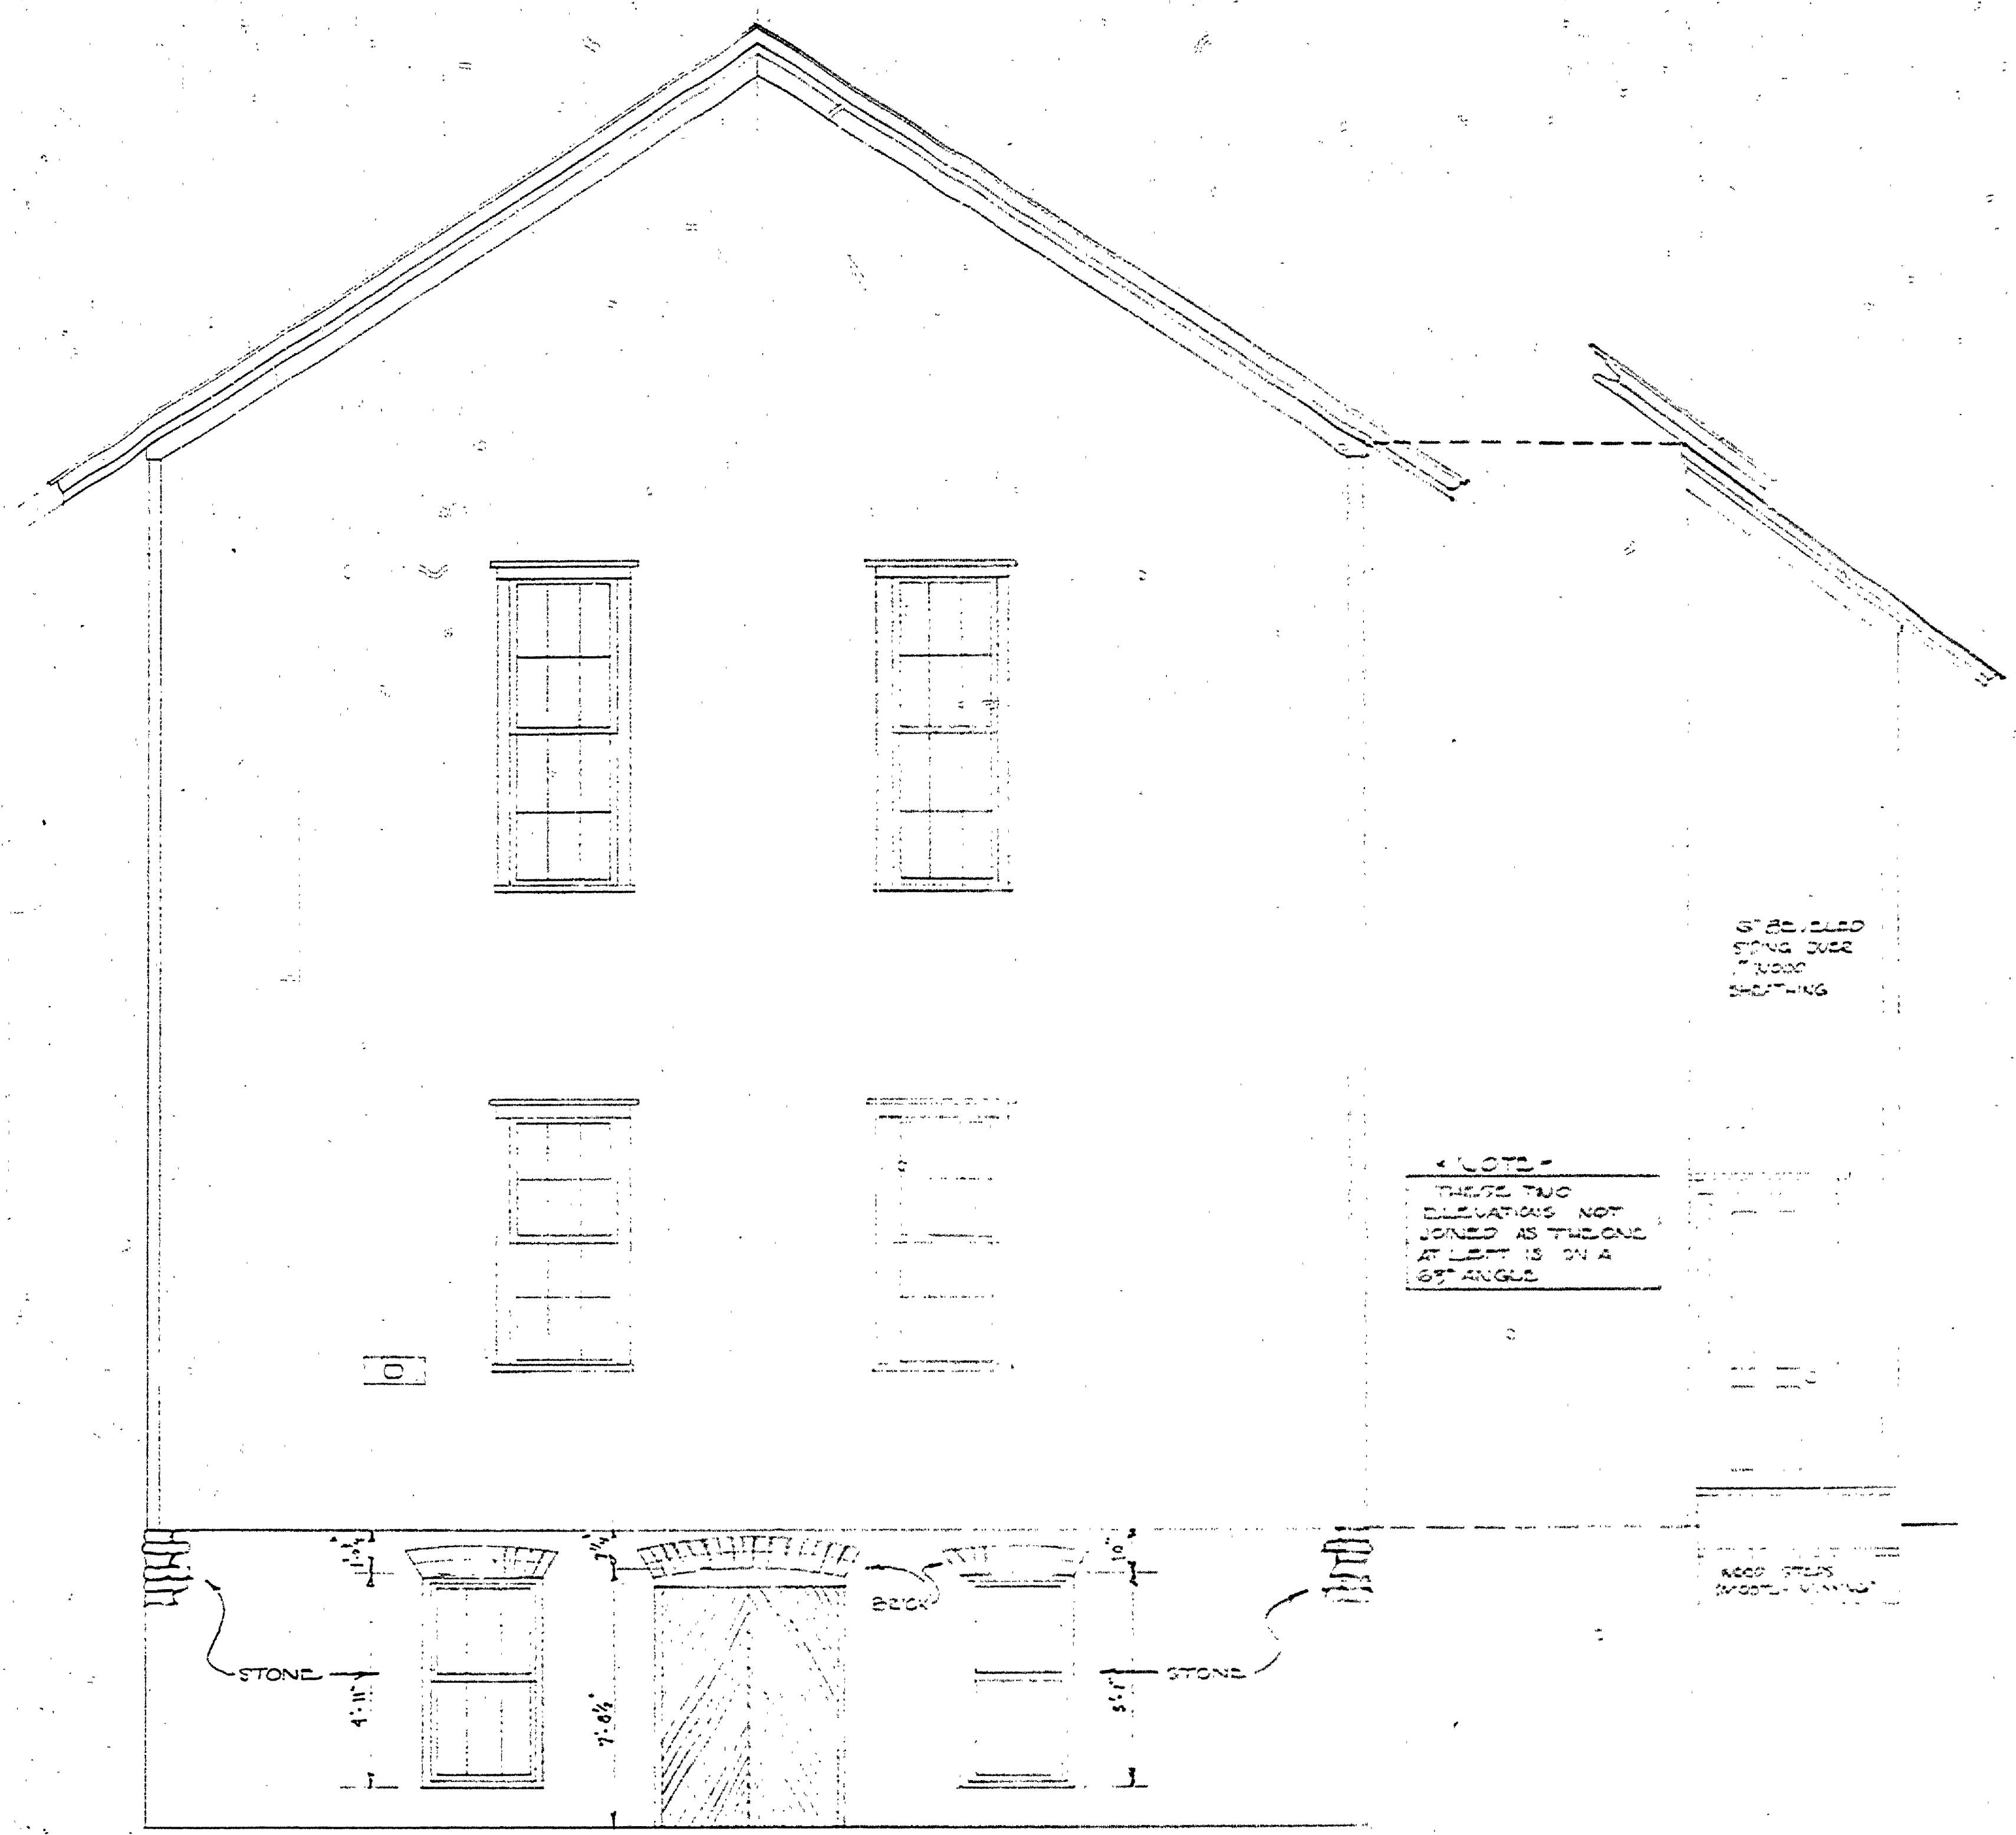

NORTH ELEVATION  
SCALE 3/8" = 1'

NOTE:  
THESE TWO  
ELEVATIONS NOT  
67 ANGLE

MICHIGAN  
DEPARTMENT OF CONSERVATION  
PARKS AND RECREATION DIVISION

MEASURED DRAWINGS  
FAYETTE HISTORICAL TOWNSITE  
FAYETTE STATE PARK  
BUILDING NO. 101

SHEET  
NO. 5  
OF 8

PLAN NO.  
A-101