EAST ELEVATION
SCALE 3/8" = 1'

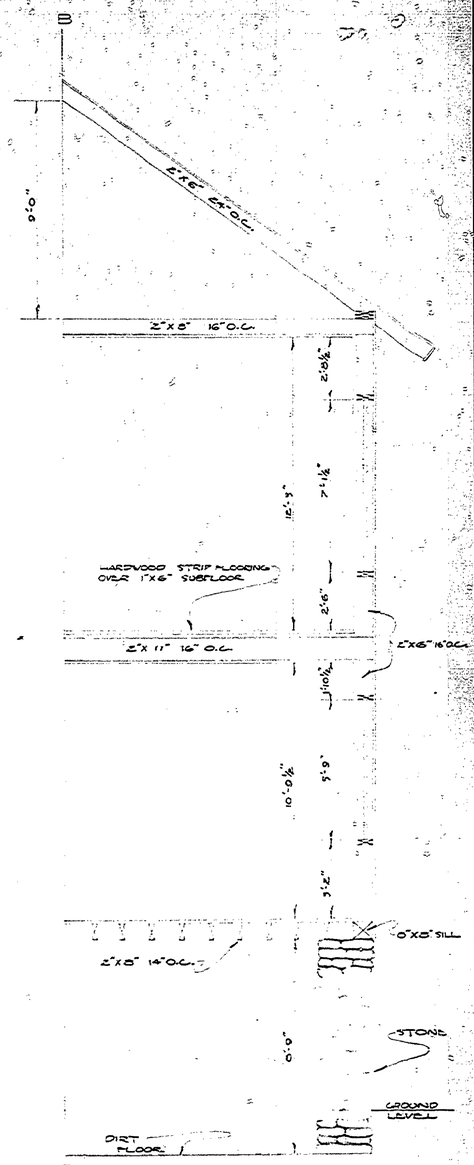

SECTION B-B
SCALE 3/8" = 1'

DESIGNED BY		DATE	
DRAWN BY	J.S.C.	4-12-41	
CHECKED BY	W.H.G.	4-12-41	

REVIEWED		DATE	
ARCHITECTURAL	W.J.C.	4-11-41	
ENGINEERING	E.J.P.	4-24-41	
LANDSCAPE	W.H.G.	4-24-41	

APPROVED
CHIEF, DIVISION OF ARCHITECTURE
CHIEF, DIVISION OF ENGINEERING
CHIEF, DIVISION OF LANDSCAPE ARCHITECTURE

NO.	DATE	BY
1		
2		
3	5-2-41	
4		
5		
6		

REVISIONS

MICHIGAN
DEPARTMENT OF CONSERVATION
PARKS AND RECREATION DIVISION

MEASURED DRAWINGS
FAYETTE HISTORICAL TOWNSITE
FAYETTE STATE PARK
BUILDING NO. 101

SHEET NO. 6 OF 8

PLAN NO. A-101