



DESIGNED BY	DATE	REVIEWED	DATE	APPROVED	DATE	NO.	DATE	BY	REVISIONS
DRAWN BY CHECKED BY	11/1/62	ARCHITECTURAL			1				4
		ENGINEERING			2				5
		LANDSCAPE			3				6

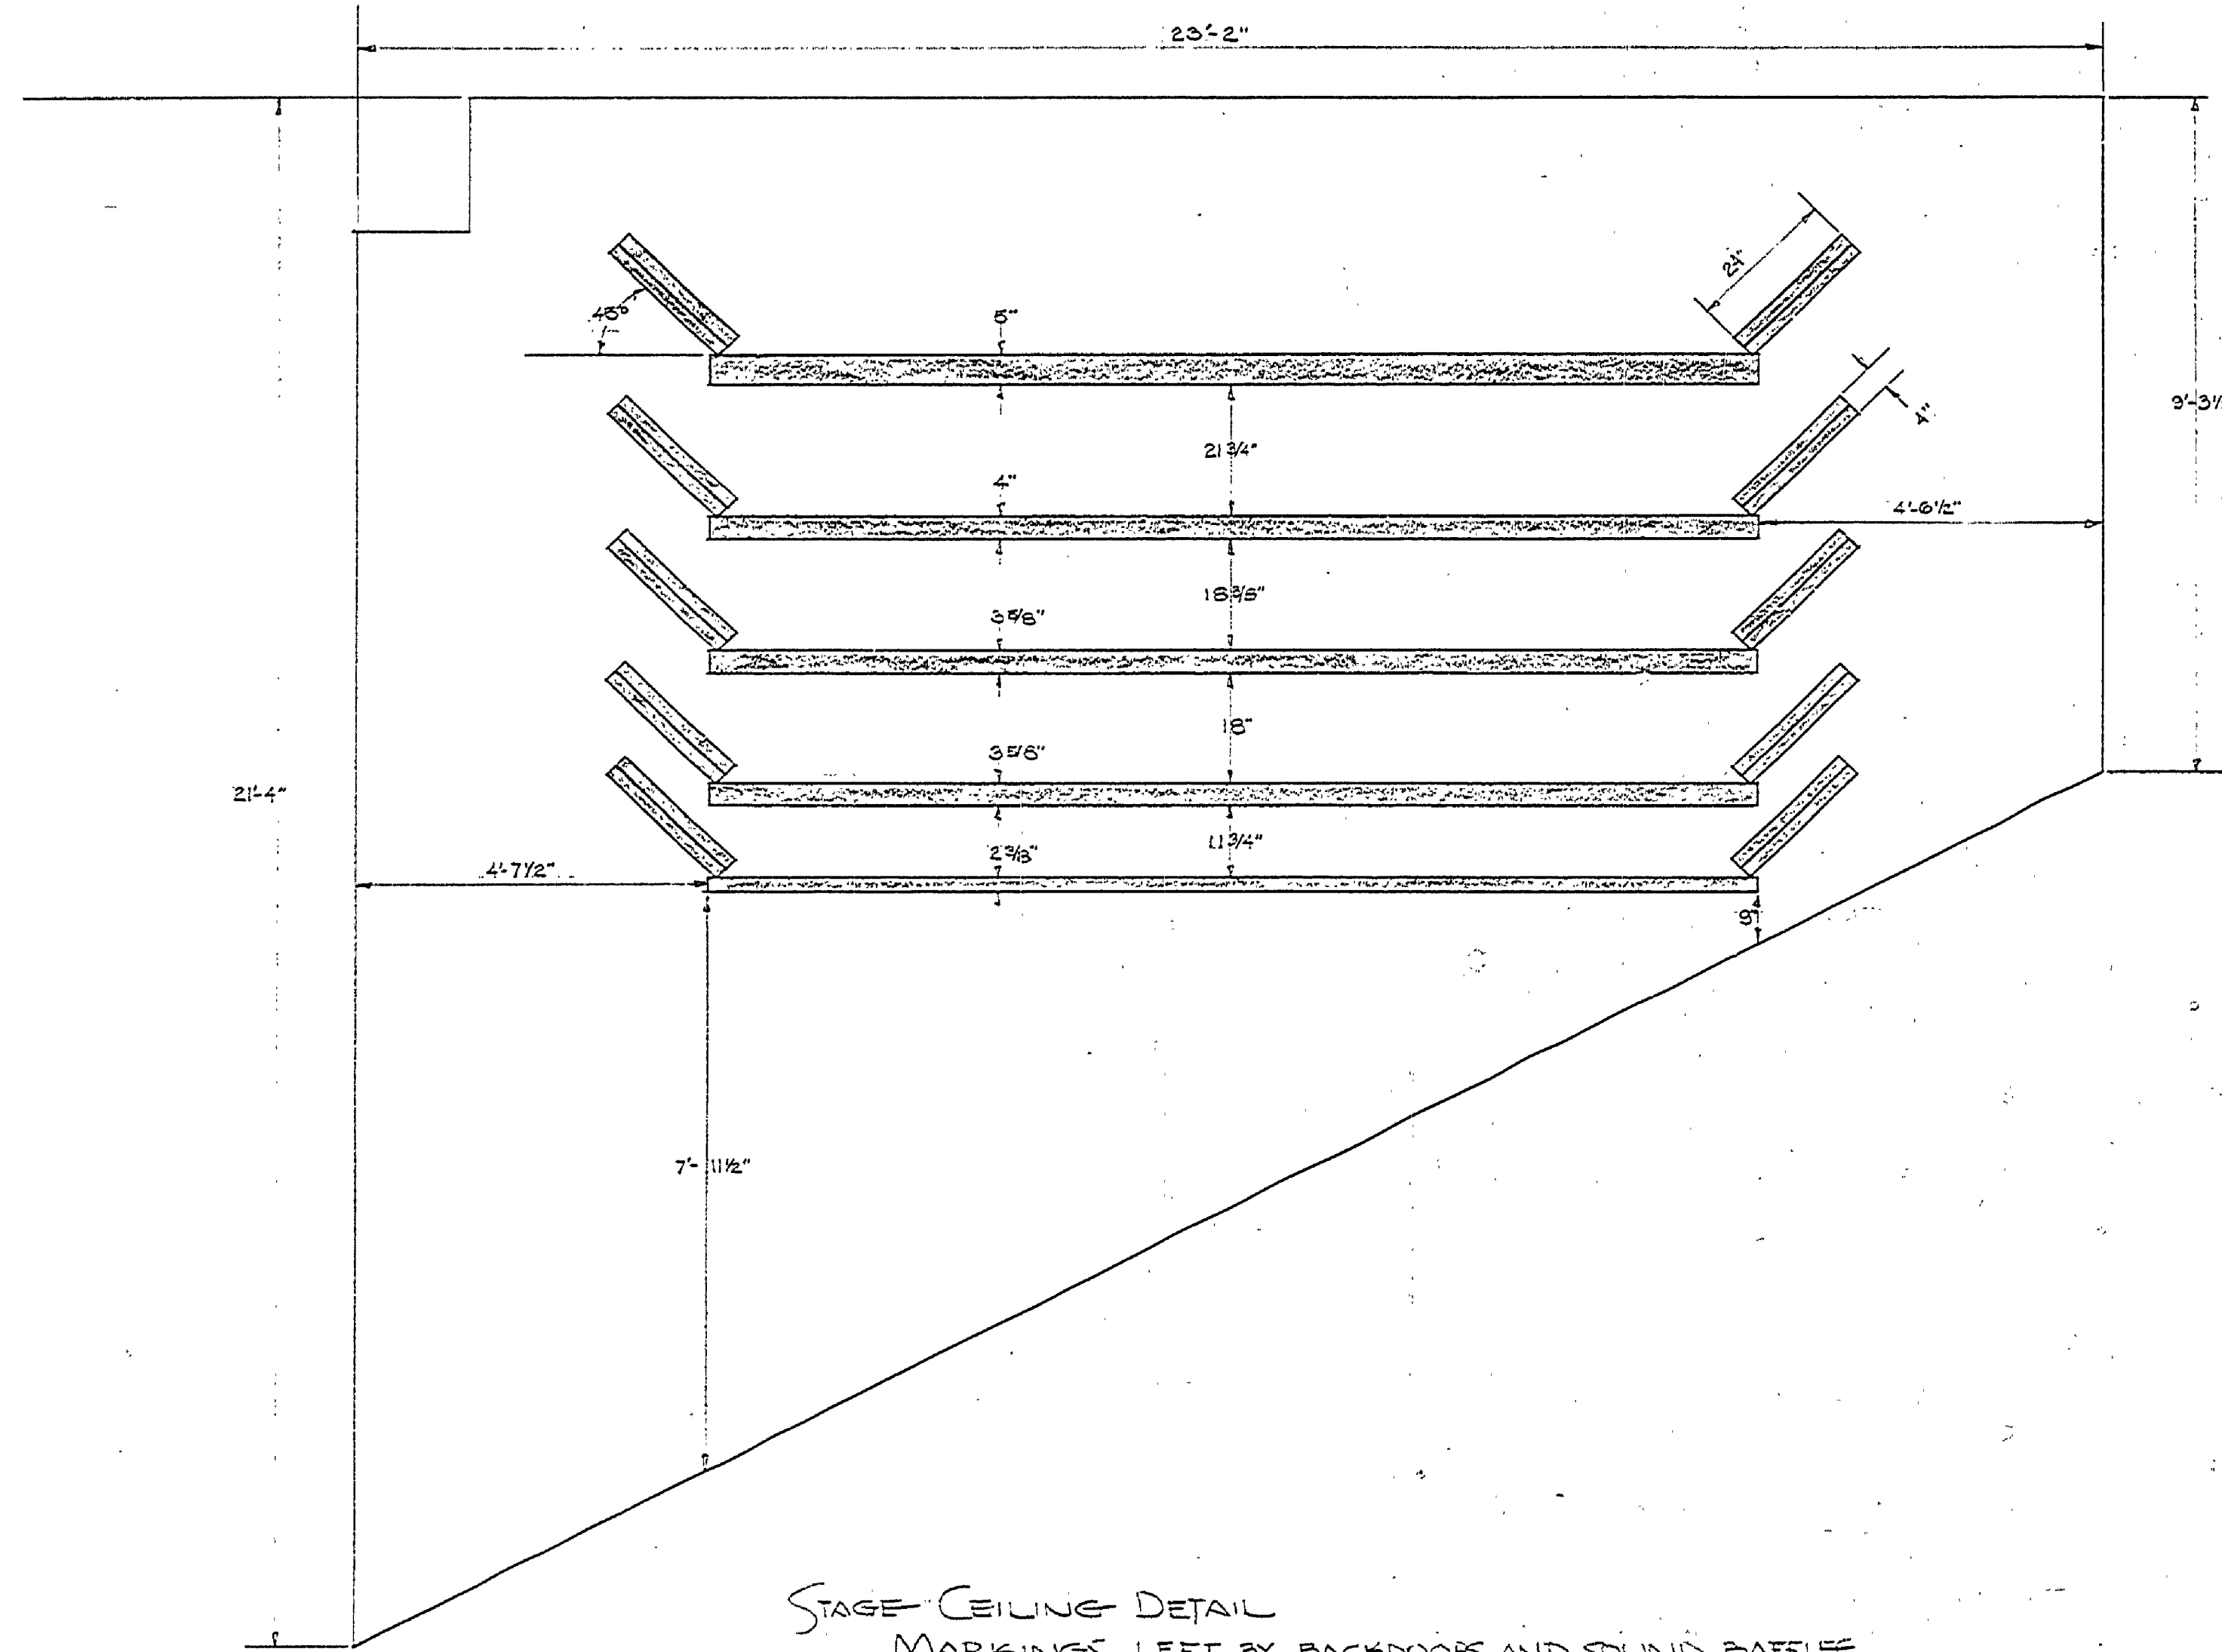

STAGE-CEILING DETAIL
 MARKINGS LEFT BY BACKDROPS AND SOUND Baffle.
 SCALE 1/2" = 1'-0"

NOTE:
 ALL SOUND Baffles ARE 2'-0" LONG AND AT A 45° ANGLE.
 MARKED AREAS HAVE BEEN SHADED TO CLARIFY THE DRAWING-
 THEY ARE NOT ACTUALLY THIS DARK ON THE PLASTER.

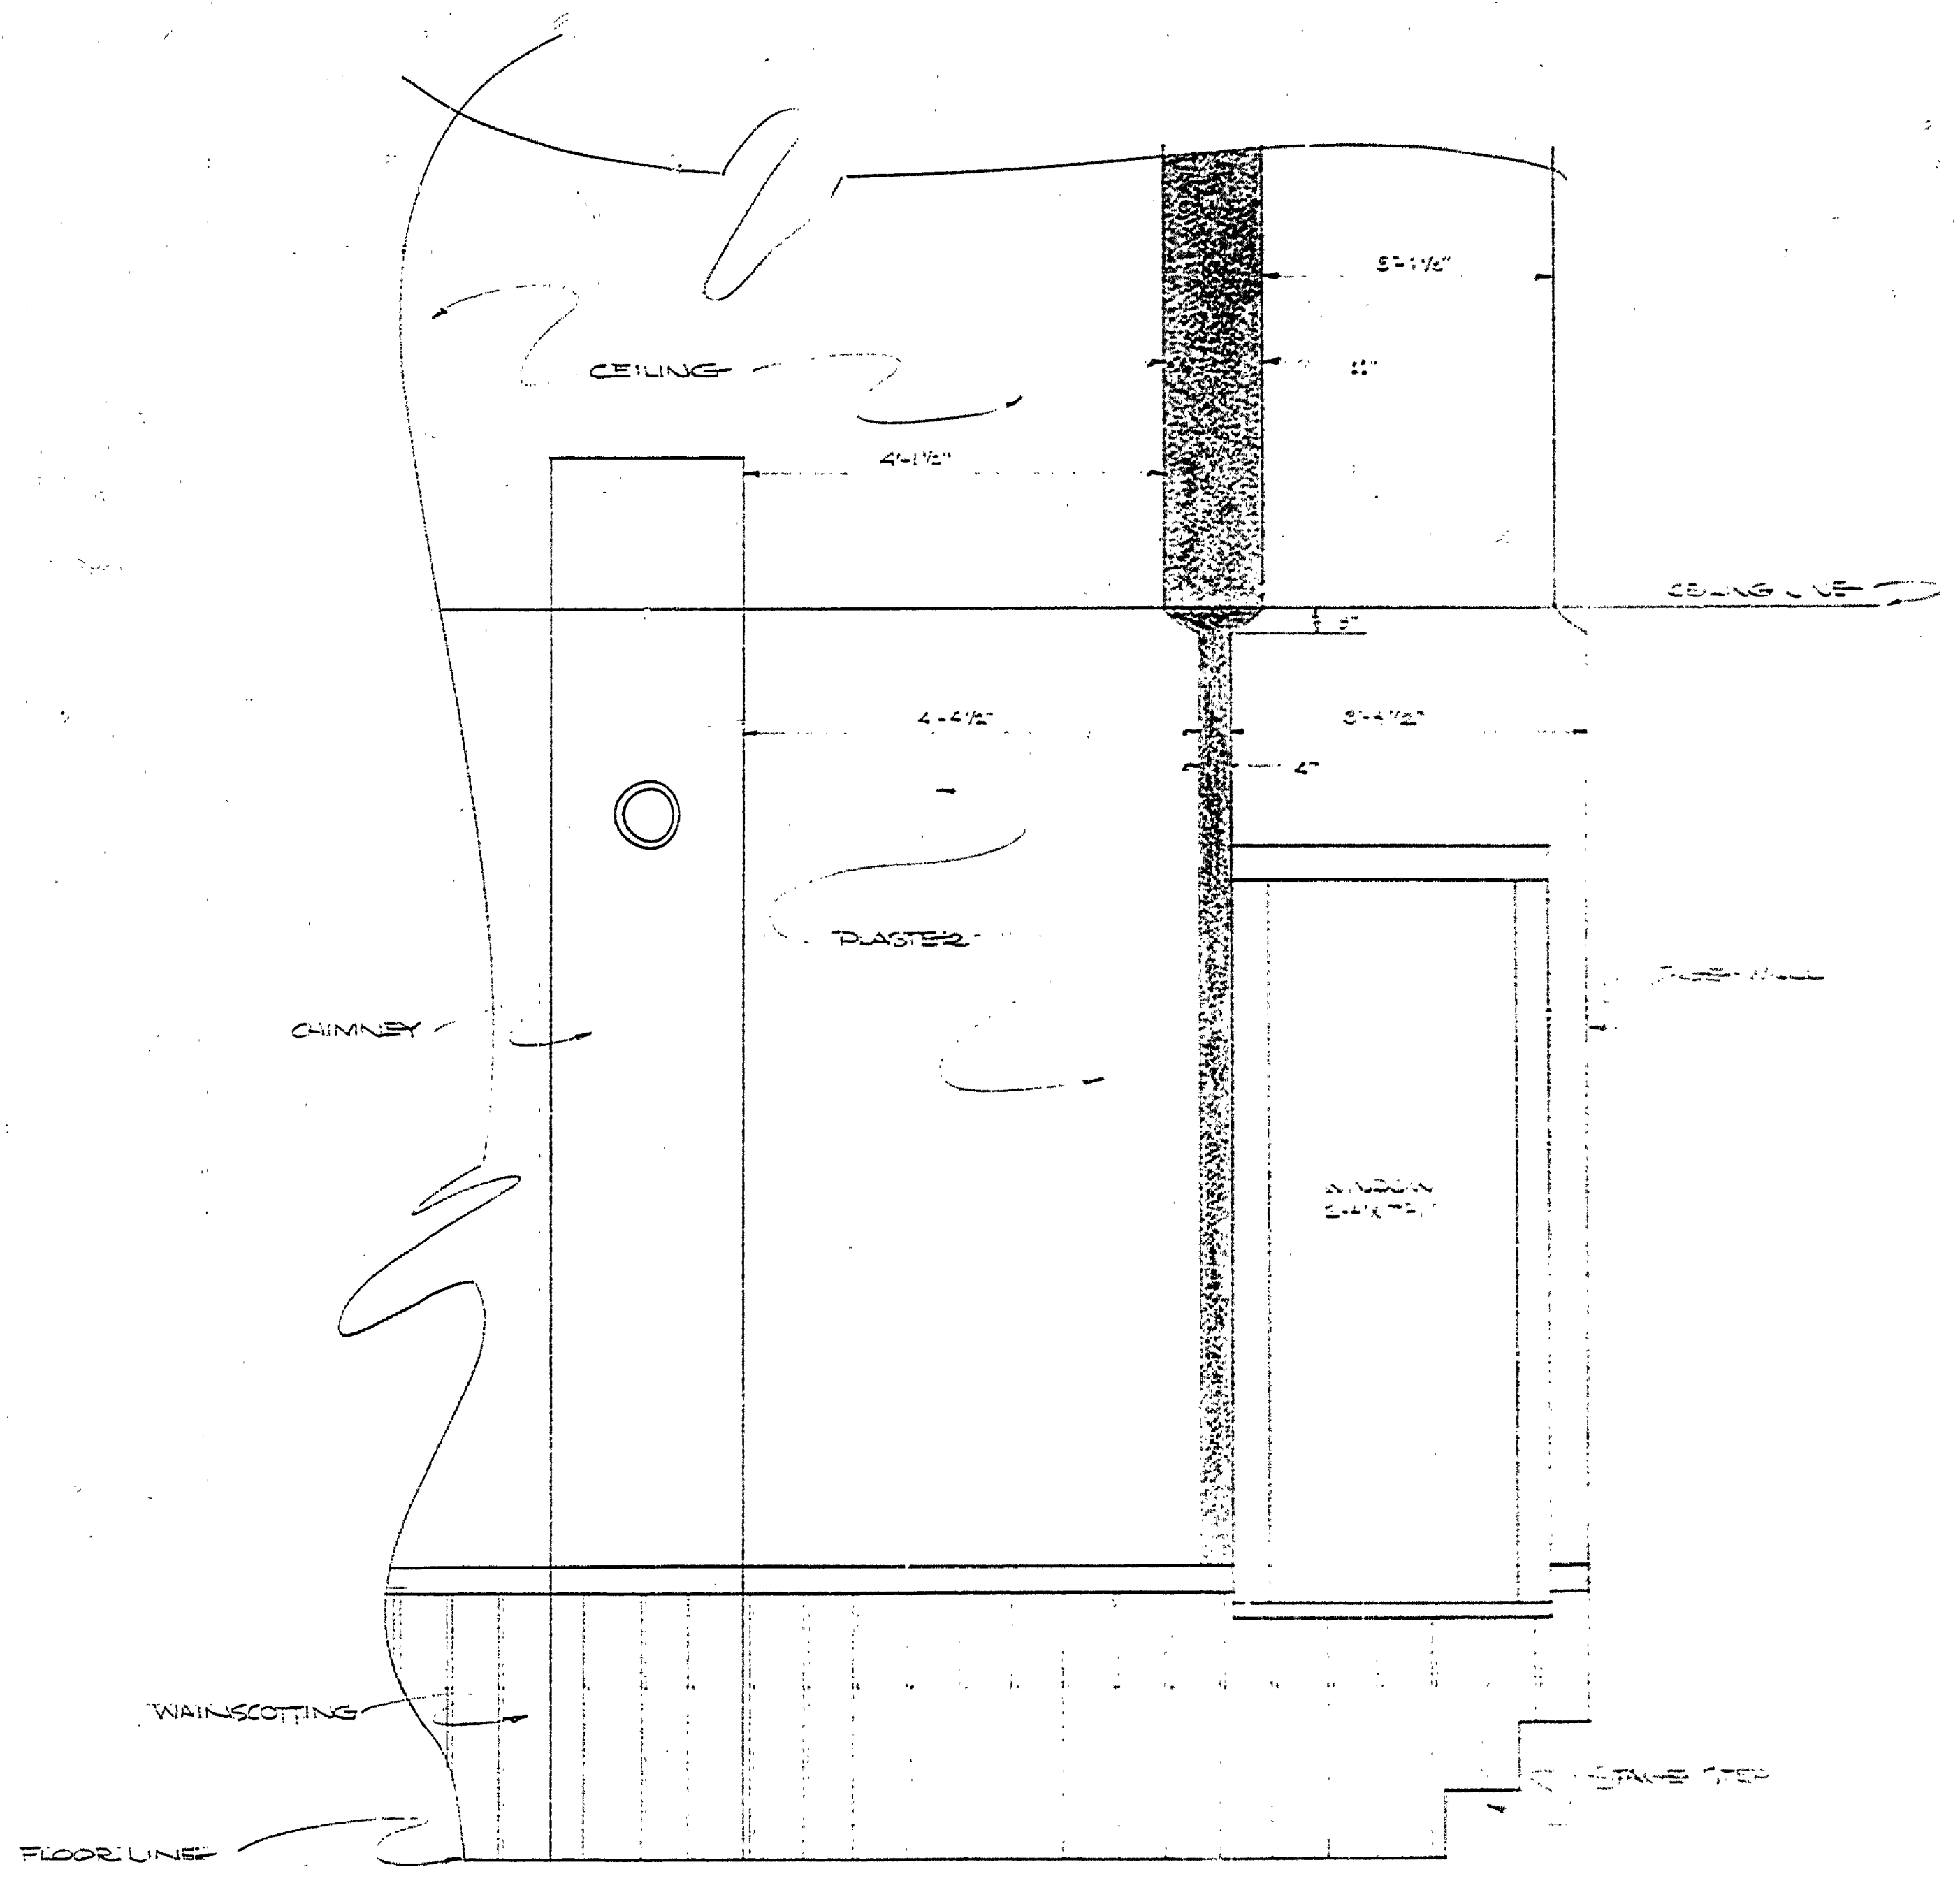

DETAIL DETAIL
 MARKS LEFT ON WALL AND CEILING BY CURTAIN HOLD UP
 SCALE 1/4" = 1'-0"

NOTE:
 MARKED AREAS HAVE BEEN SHADED FOR CLARITY.
 THEY ARE NOT ACTUALLY SO DARK.

OPERA HOUSE - BUILDING # 101

MICHIGAN
 DEPARTMENT OF CONSERVATION
 PARKS AND RECREATION DIVISION

MEASURED DRAWING
 FAYETTE HISTORICAL TOWNSITE
 FAYETTE STATE PARK

SHEET
 NO. 1
 OF 1

PLAN NO.
 A-101a