


DATE	REVIEWED	DATE	APPROVED	DATE	NO.	DATE	REVISIONS
	ARCHITECTURAL	1-7-77		1			4
	ENGINEERING			2			5
	LANDSCAPE			3			6

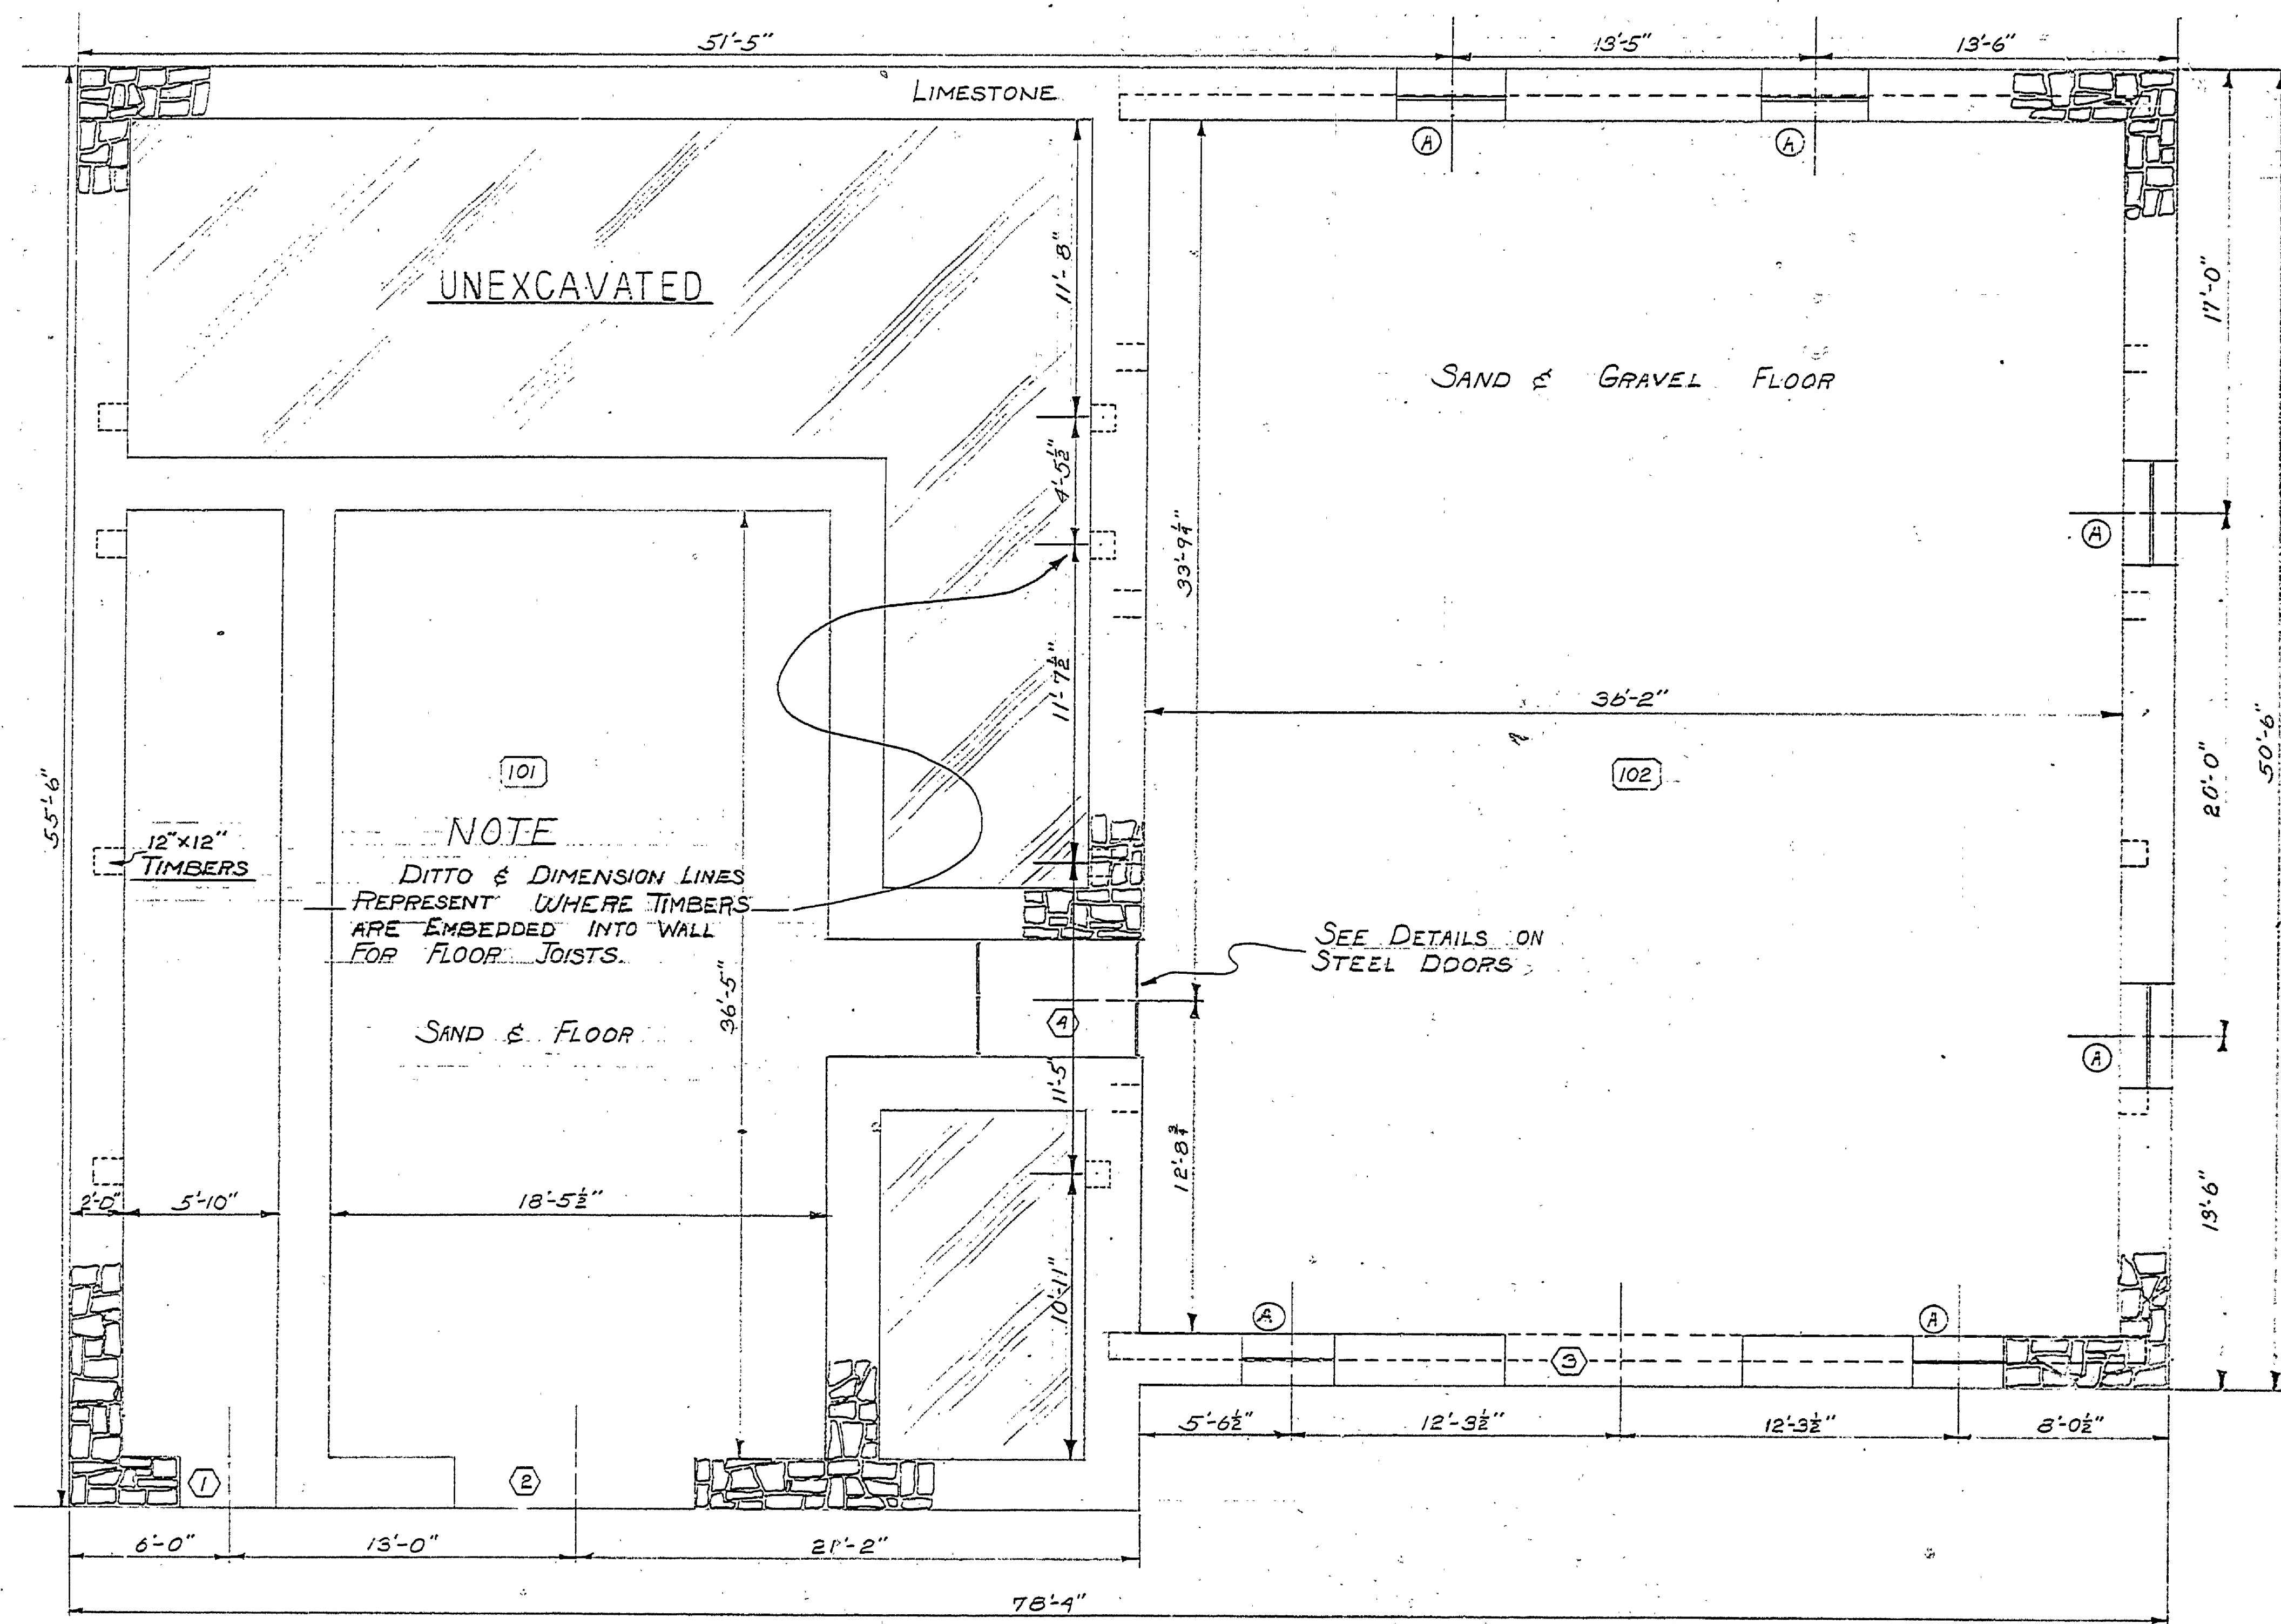


BASEMENT & FLOOR PLAN

SCALE - 1/4" = 1'-0"

DIMENSIONS OF DOOR CASEMENT
1 - 3'-8" x 5'-7"
2 - 4'-0" x 6'-0"
3 - 3'-8" x 6'-7"
4 - 4'-6" x 6'-0"

DIMENSIONS OF WINDOW CASEMENT
A - 3'-5" x 2'-3 1/2"

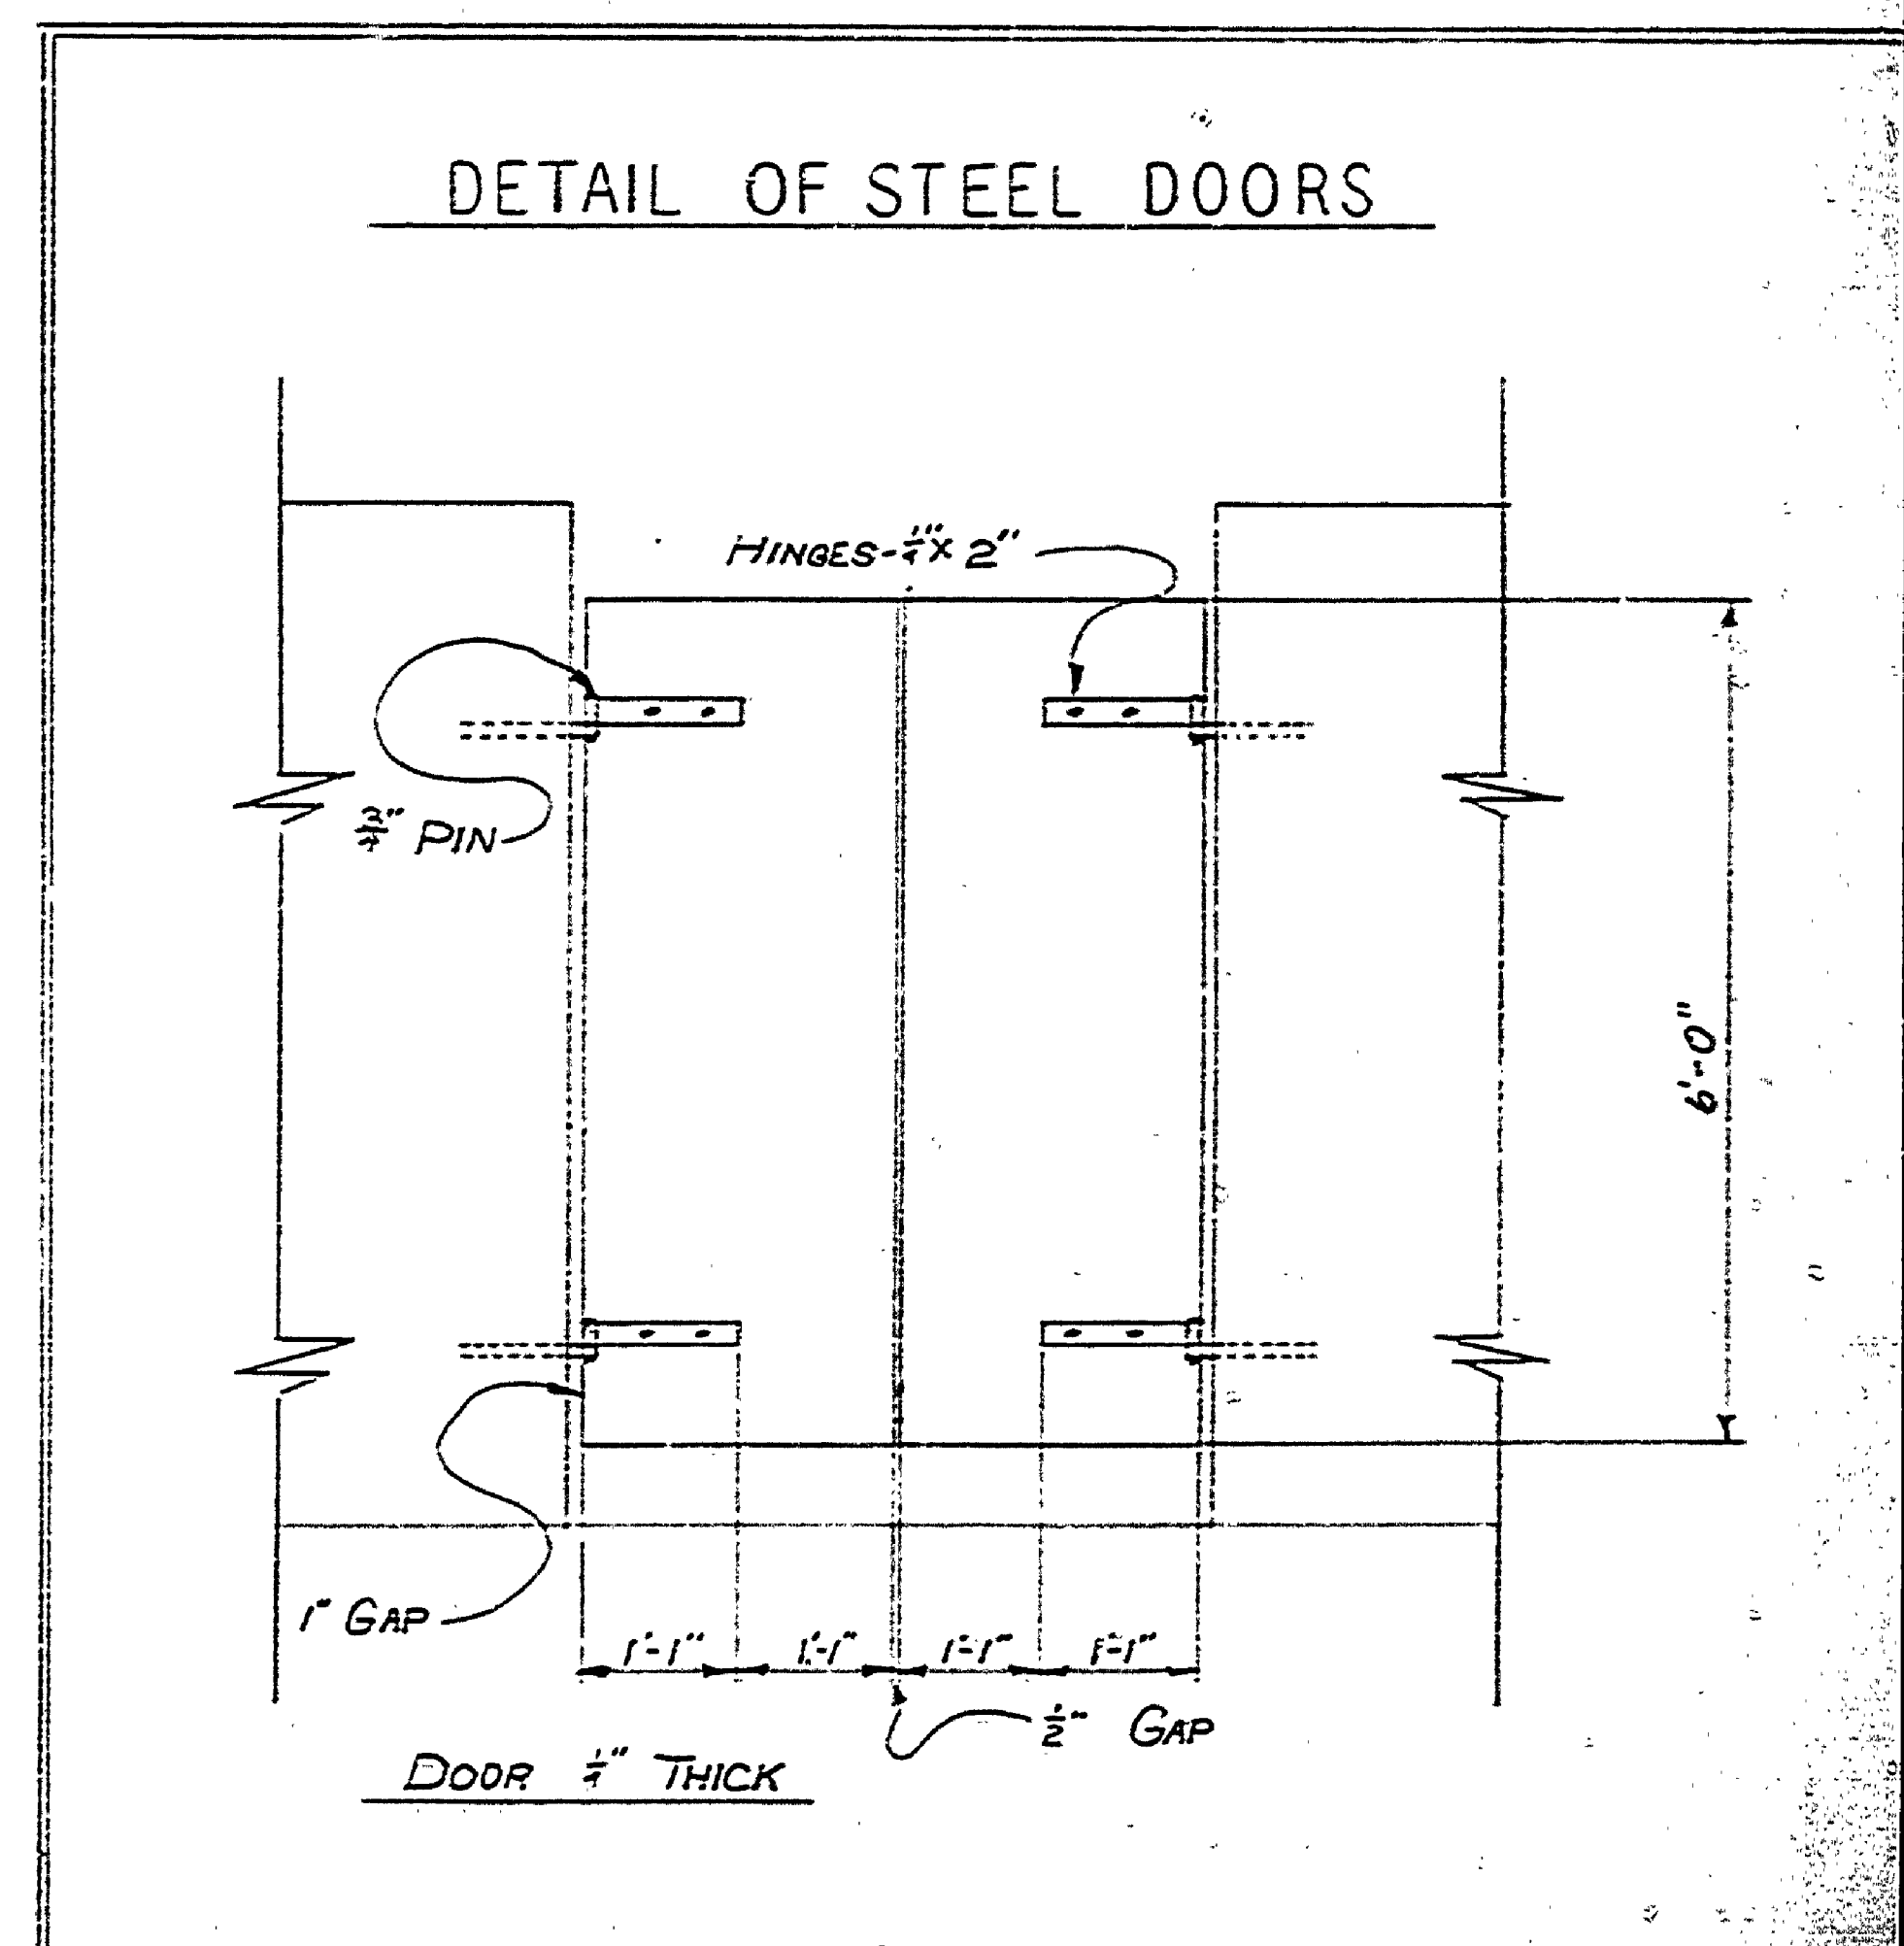

SCALE - 3/8" = 1'-0"

MICHIGAN DEPARTMENT OF CONSERVATION PARKS AND RECREATION DIVISION

MEASURED DRAWING
FAYETTE HISTORICAL TOWNSITE
FAYETTE STATE PARK

SHEET NO. 1 OF 5
PLAN NO. A-102