



DESIGNED BY	DRAWN BY	CHECKED BY	DATE	REVIEWED	DATE	APPROVED	DATE	NO.	DATE	BY	REVISIONS
				ARCHITECTURAL	1-7-17			1			4
				ENGINEERING				2			5
				LANDSCAPE				3			6

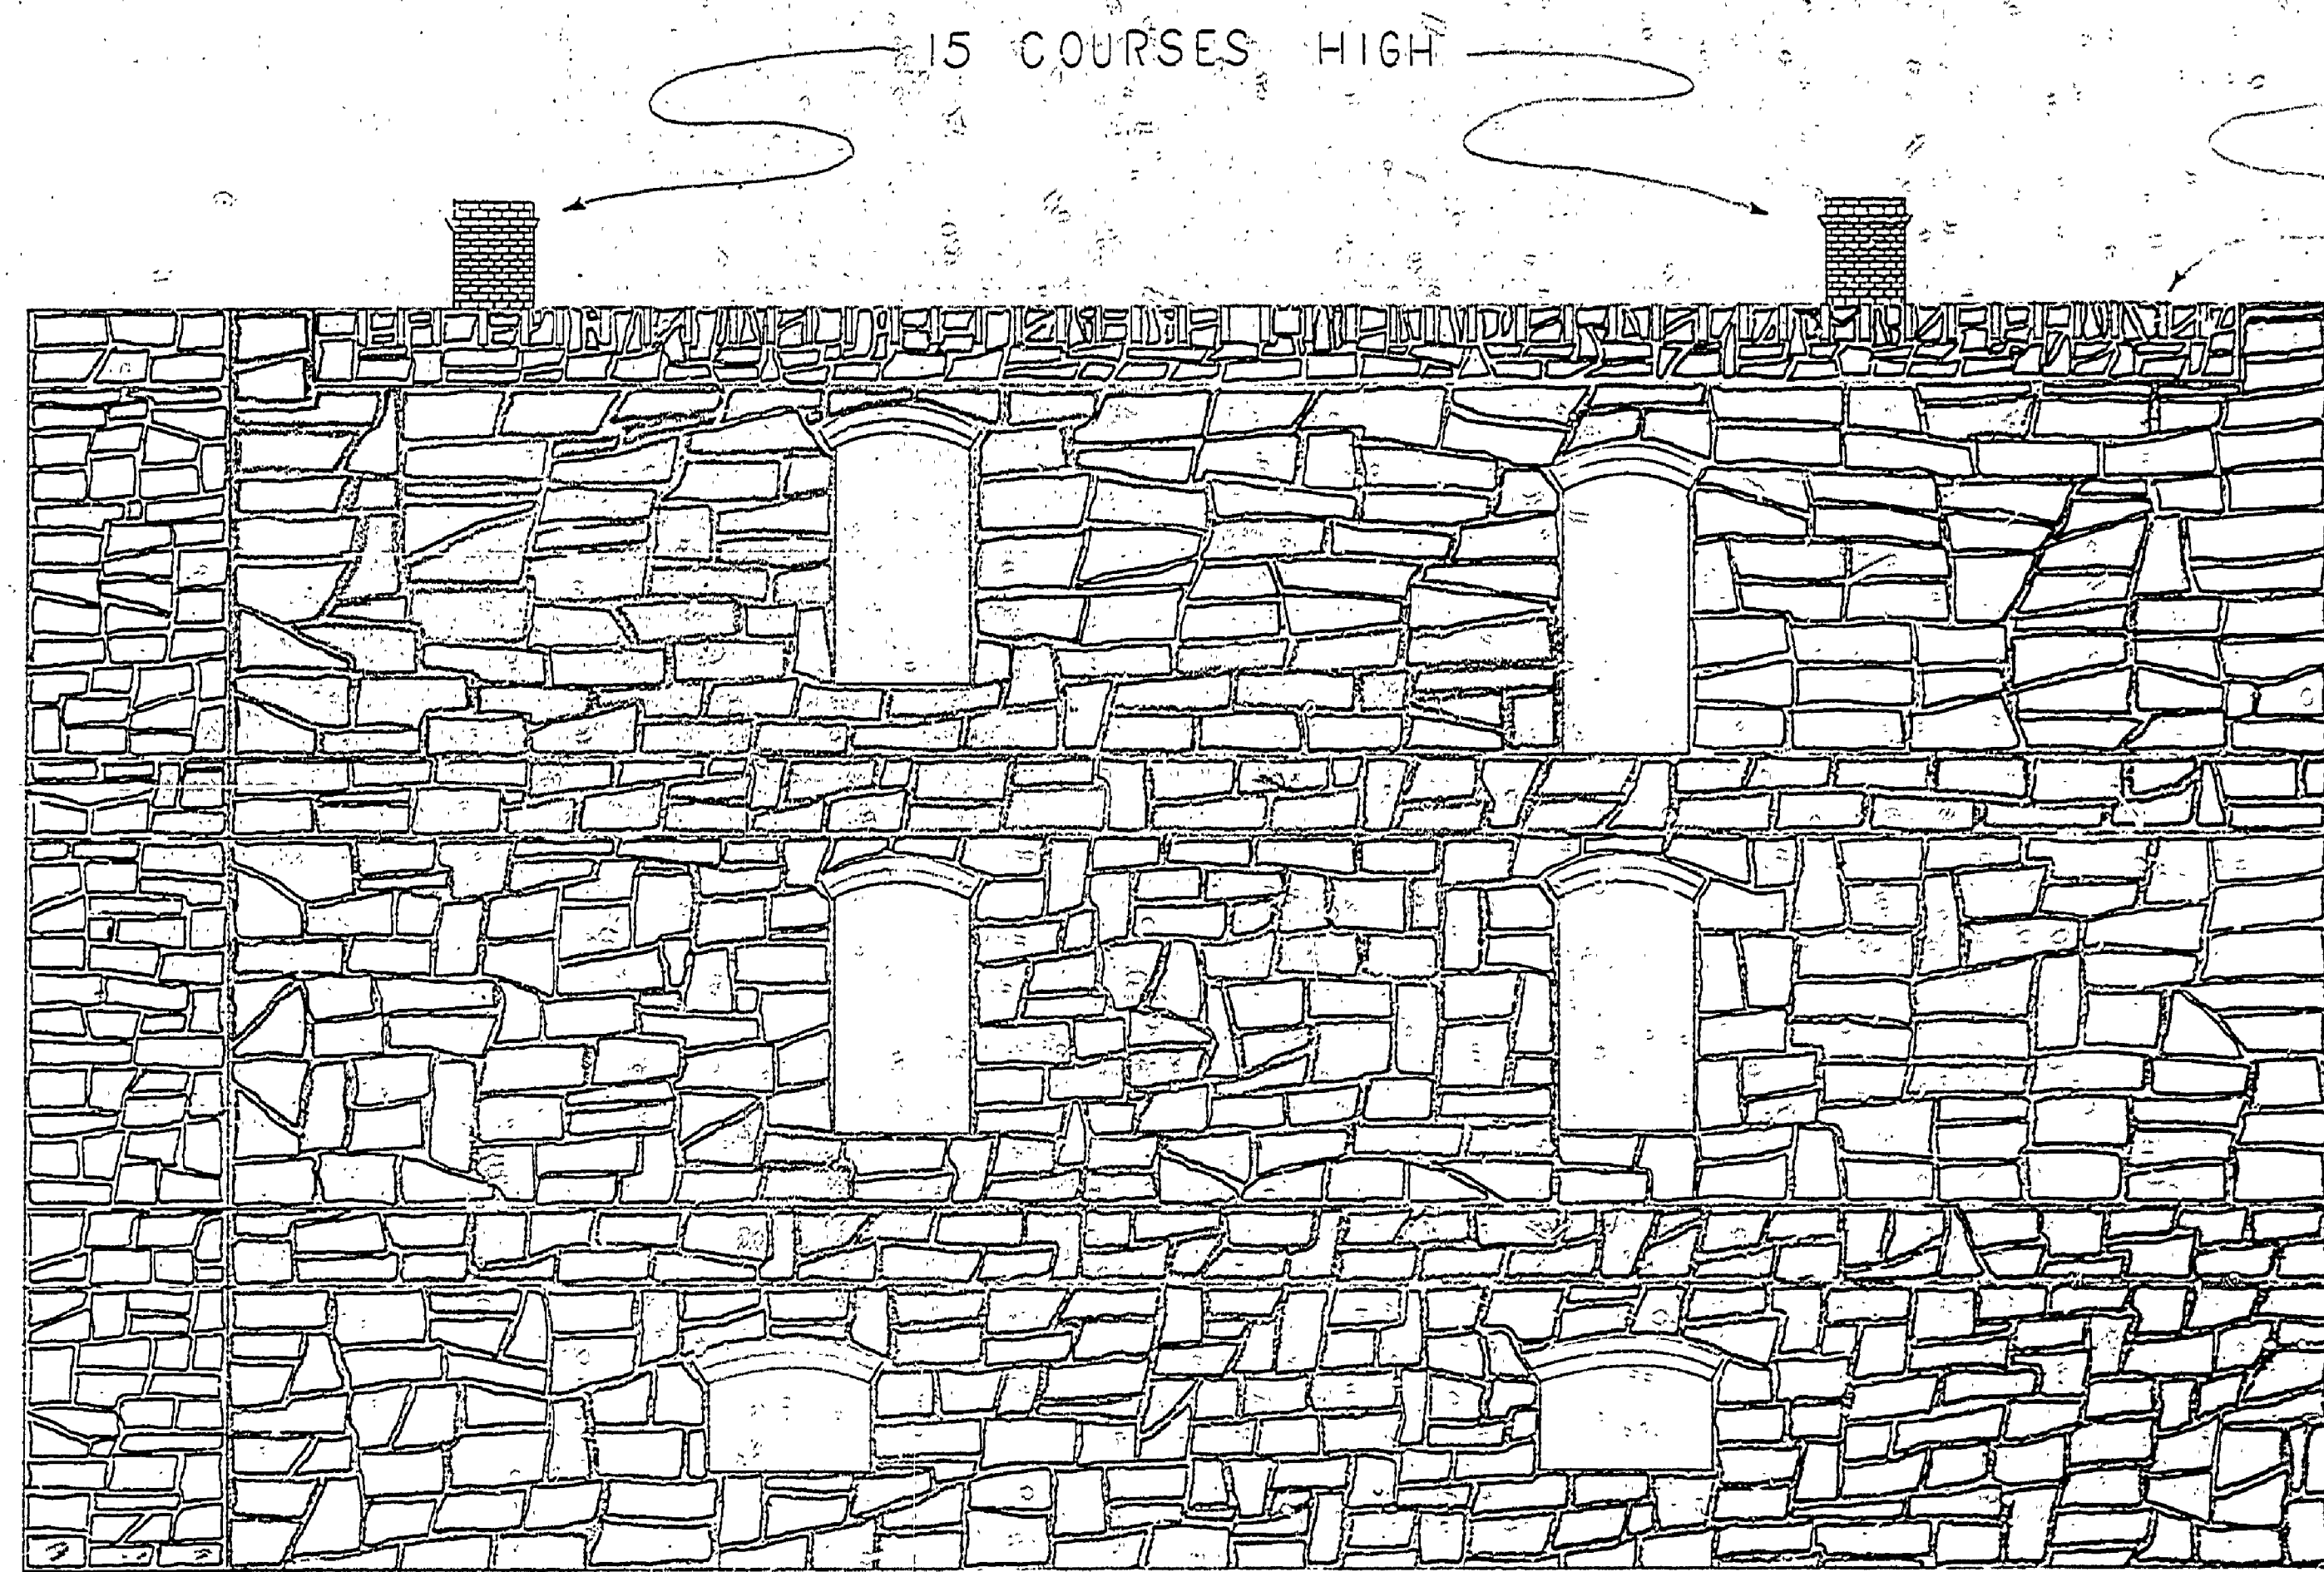

WEST ELEVATION

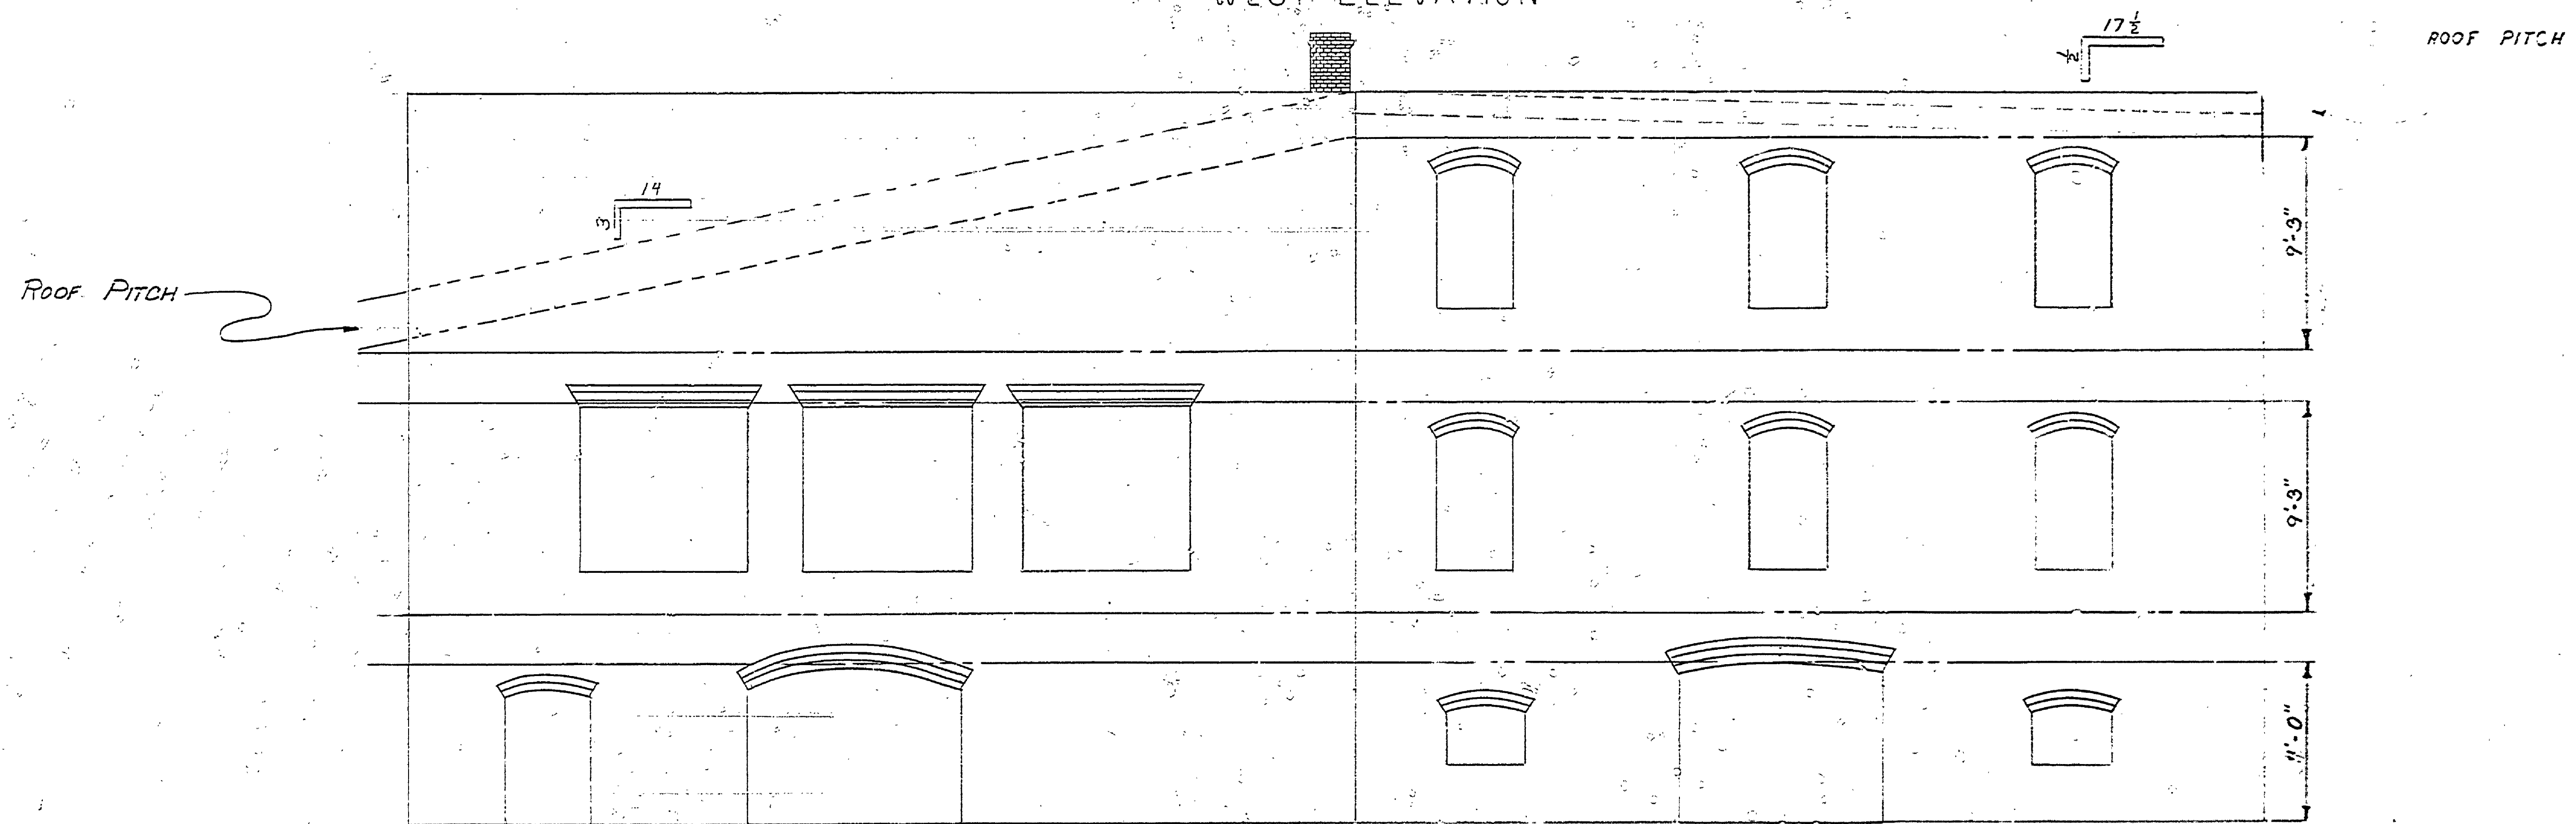

NORTH ELEVATION

SCALE - 1/4" = 1'-0"

MICHIGAN  
DEPARTMENT OF CONSERVATION  
PARKS AND RECREATION DIVISION

MEASURED DRAWING  
FAYETTE HISTORICAL TOWNSITE  
FAYETTE STATE PARK

SHEET  
NO. 4  
OF 5

PLAN NO.  
A-102