



DESIGNED BY	DATE	REVIEWED	DATE	APPROVED	DATE	NO.	DATE	REVISIONS	DATE	BY
DRAWN BY <i>Combs</i>		ARCHITECTURAL	1/2/97			1		4		
CHECKED BY <i>Clark</i>		ENGINEERING				2		5		
		LANDSCAPE				3		6		

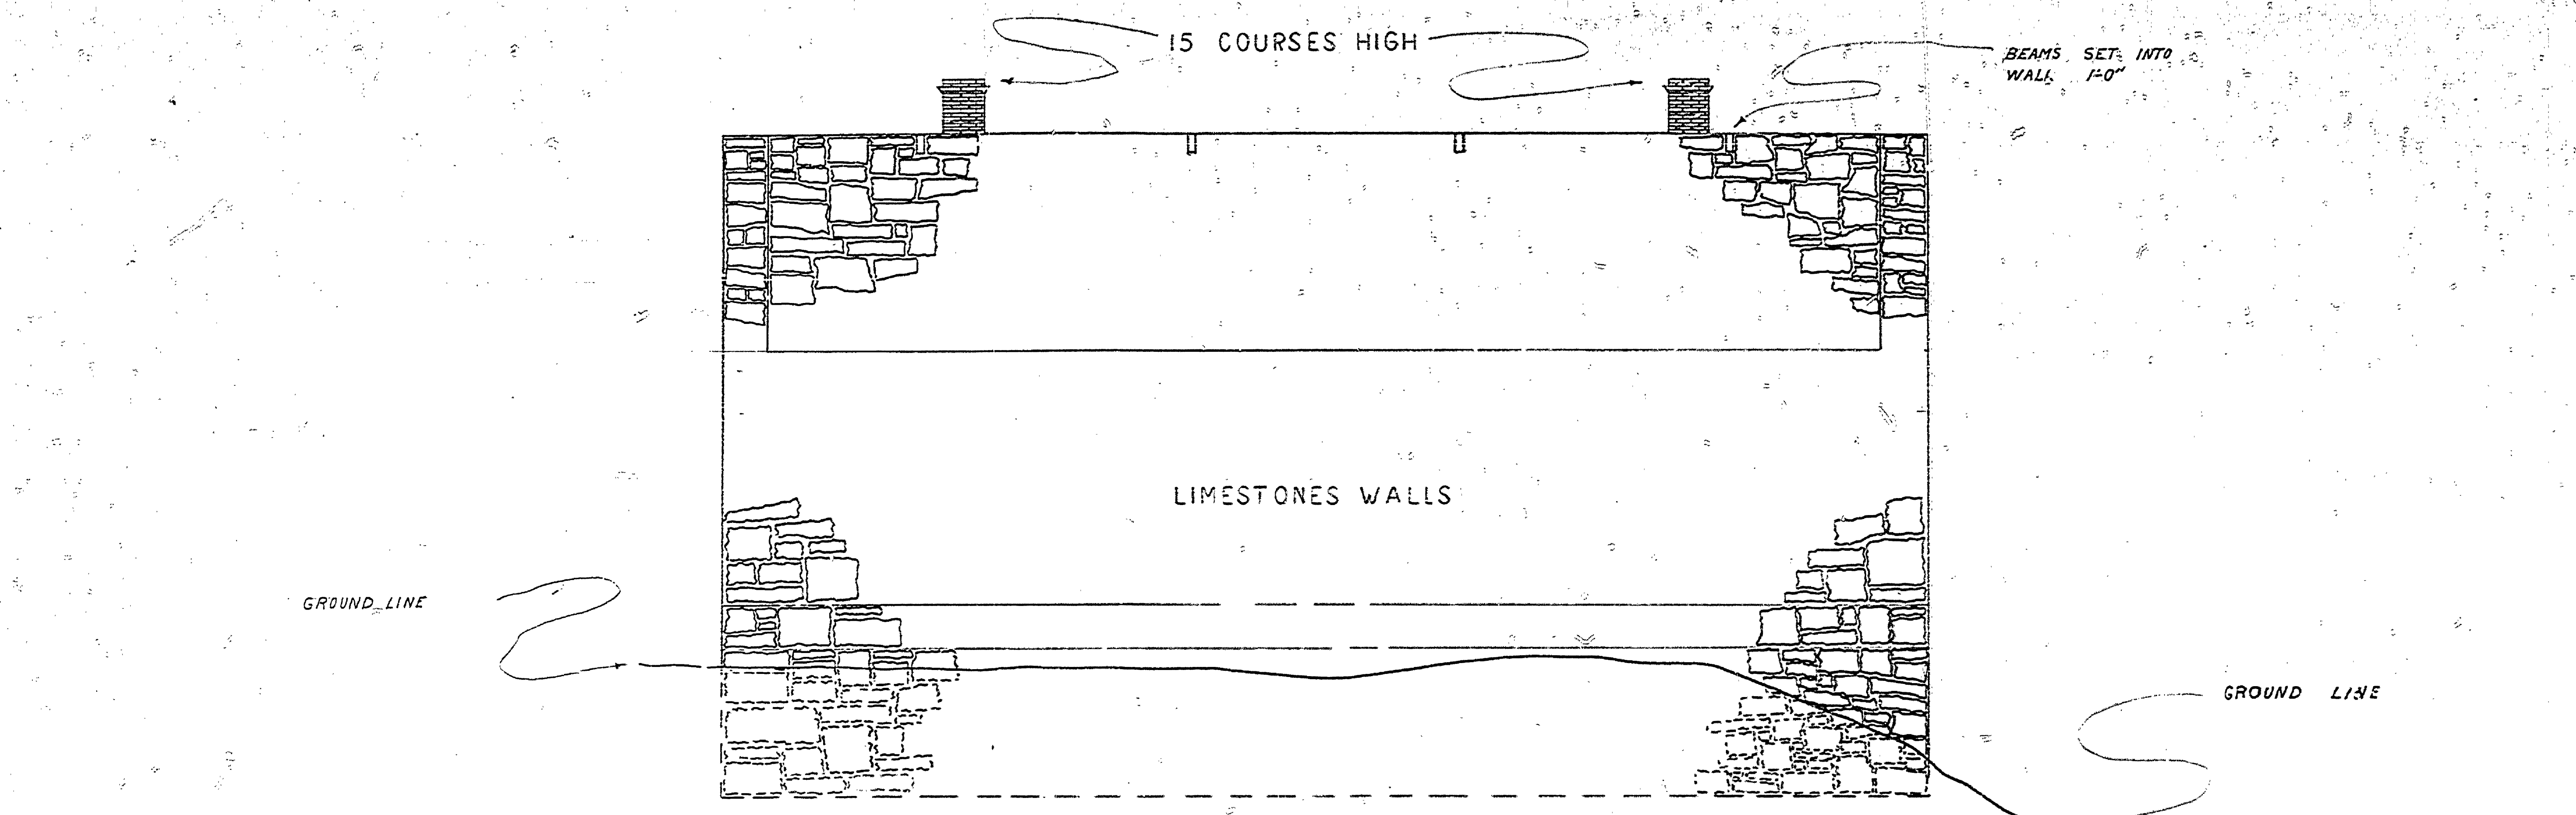

EAST ELEVATION

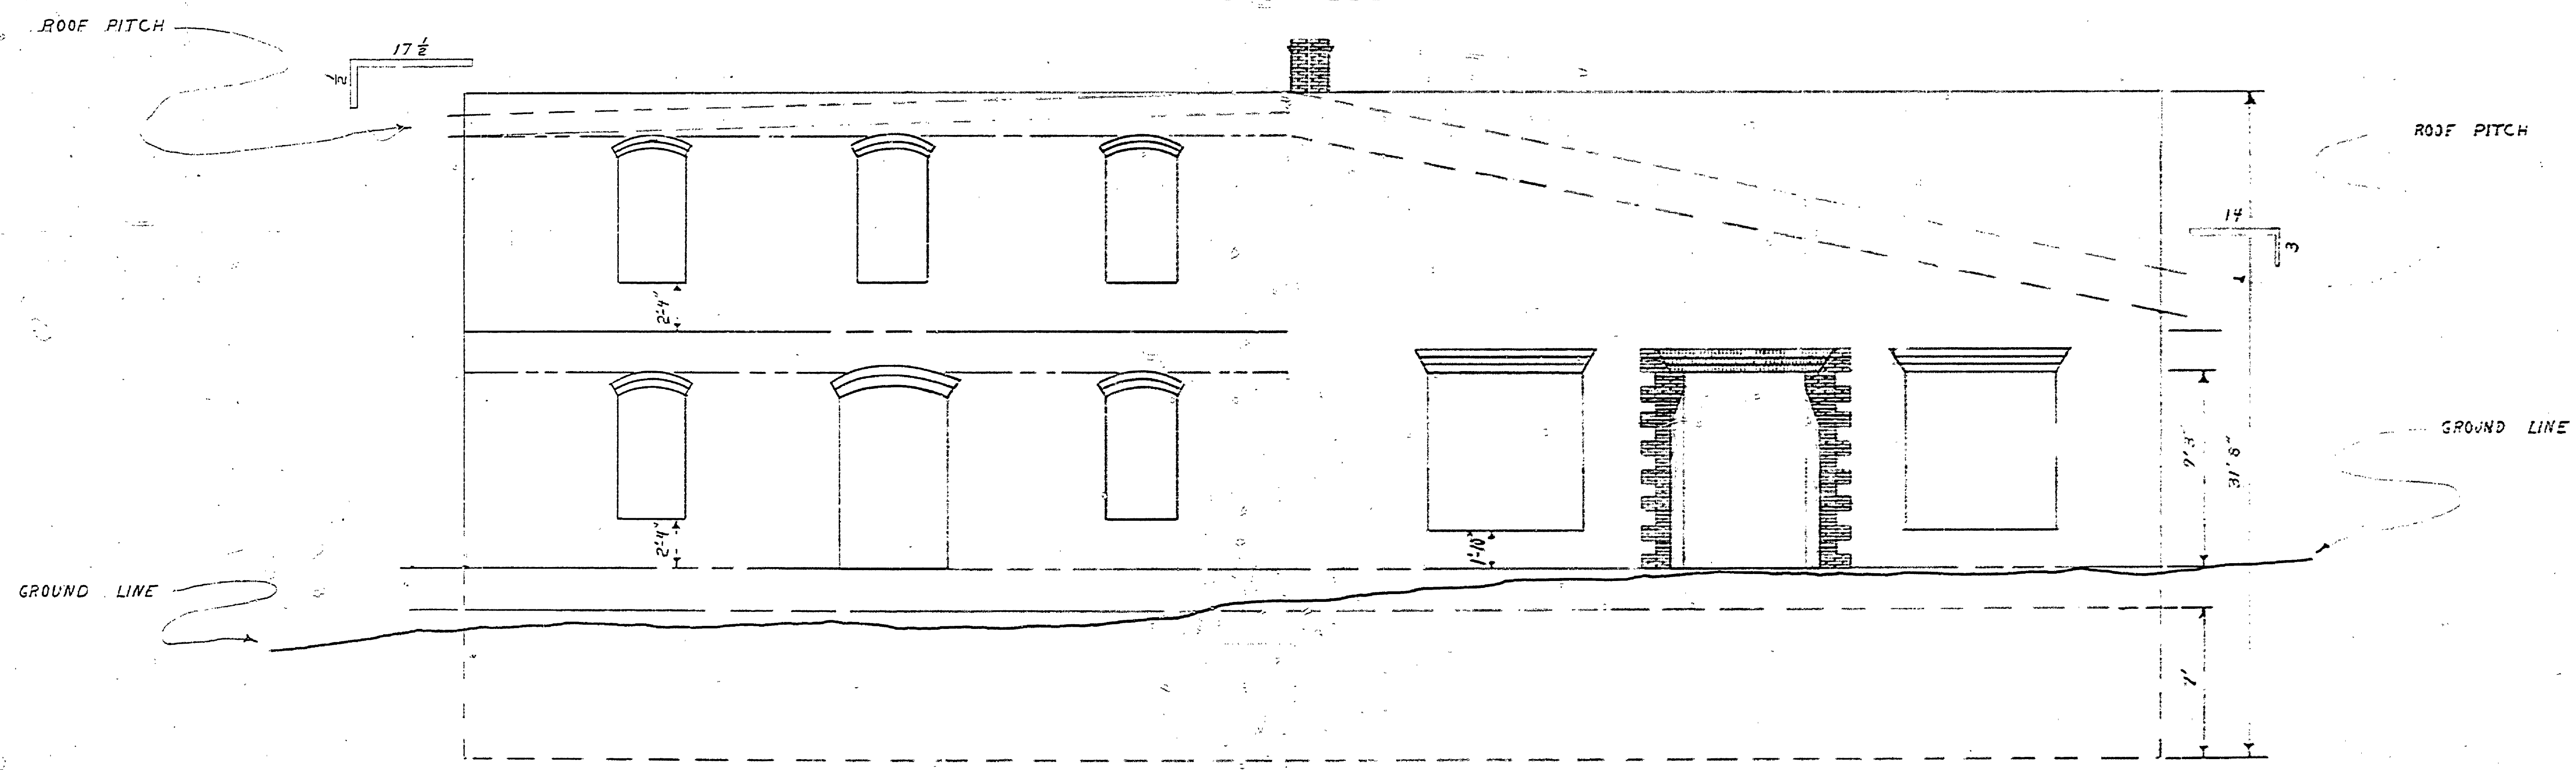

SOUTH ELEVATION

SCALE - 1/4" = 1'-0"

MICHIGAN DEPARTMENT OF CONSERVATION PARKS AND RECREATION DIVISION

MEASURED DRAWING FAYETTE HISTORICAL TOWNSITE FAYETTE STATE PARK

SHEET NO. 5 OF 5 PLAN NO. A102