



DESIGNED BY	DATE	REVIEWED	DATE	APPROVED	DATE	NO.	DATE	BY	REVISIONS	DATE	BY
J. M. Green	11-24-61	ARCHITECTURAL				1			4		
GREEN		ENGINEERING				2			5		
		LANDSCAPE				3			6		

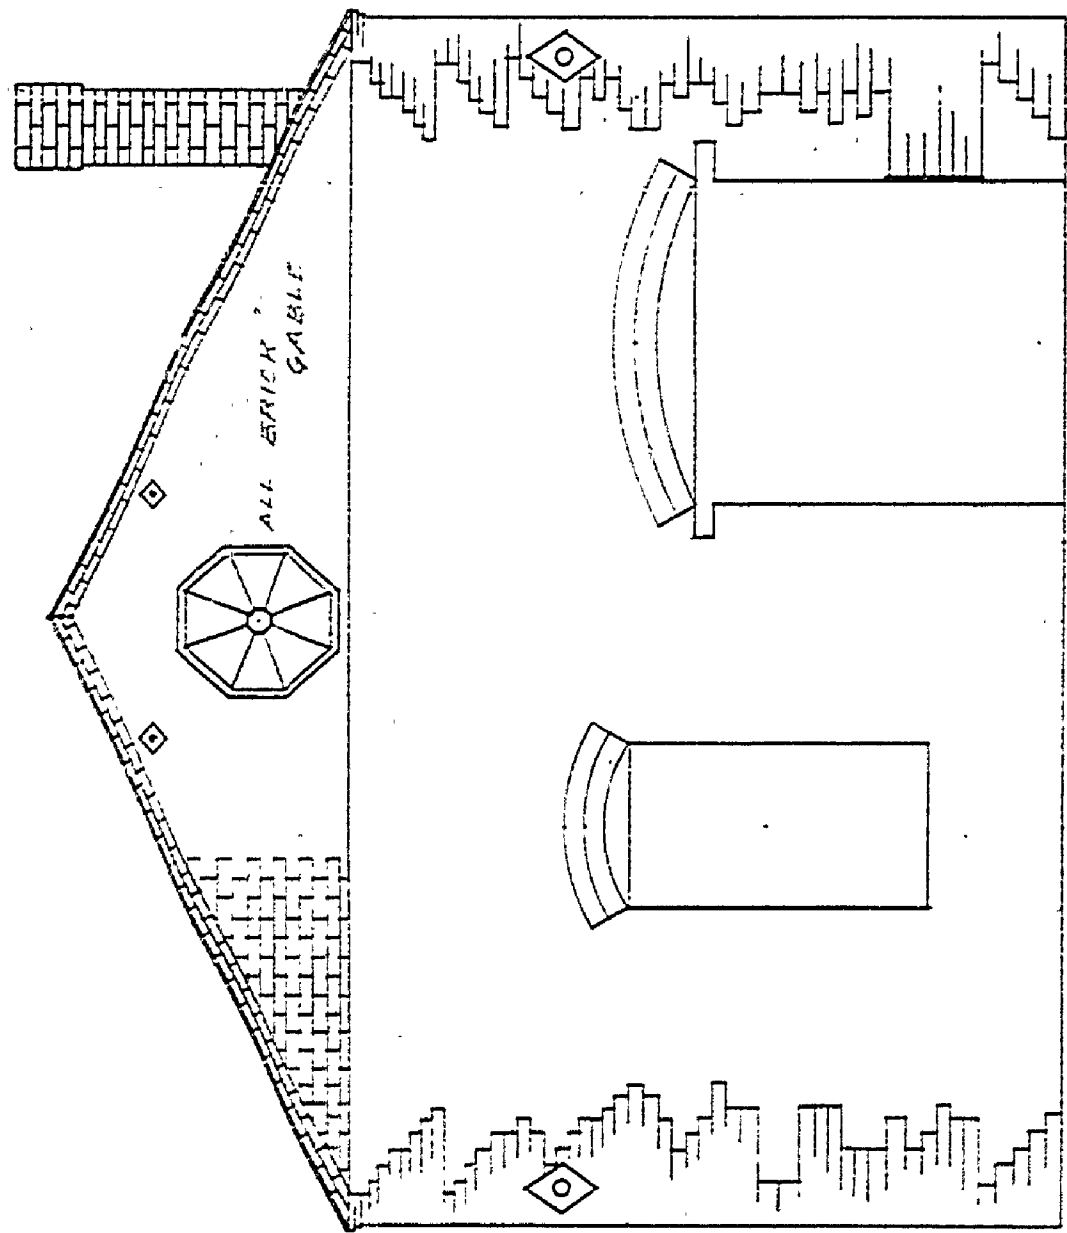


WEST ELEVATION

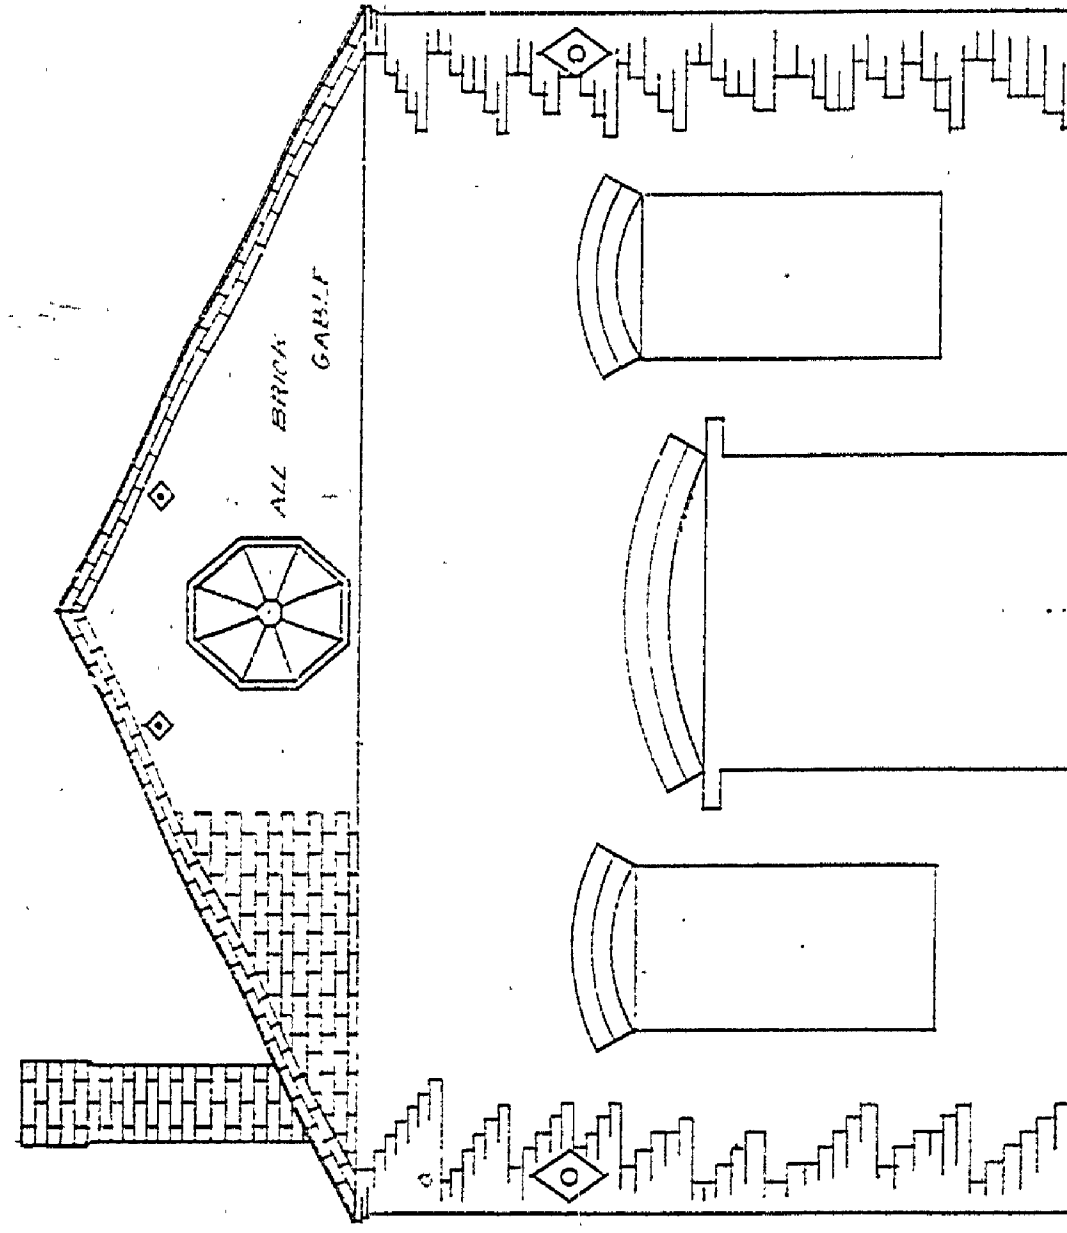


EAST ELEVATION


SCALE - GIVEN

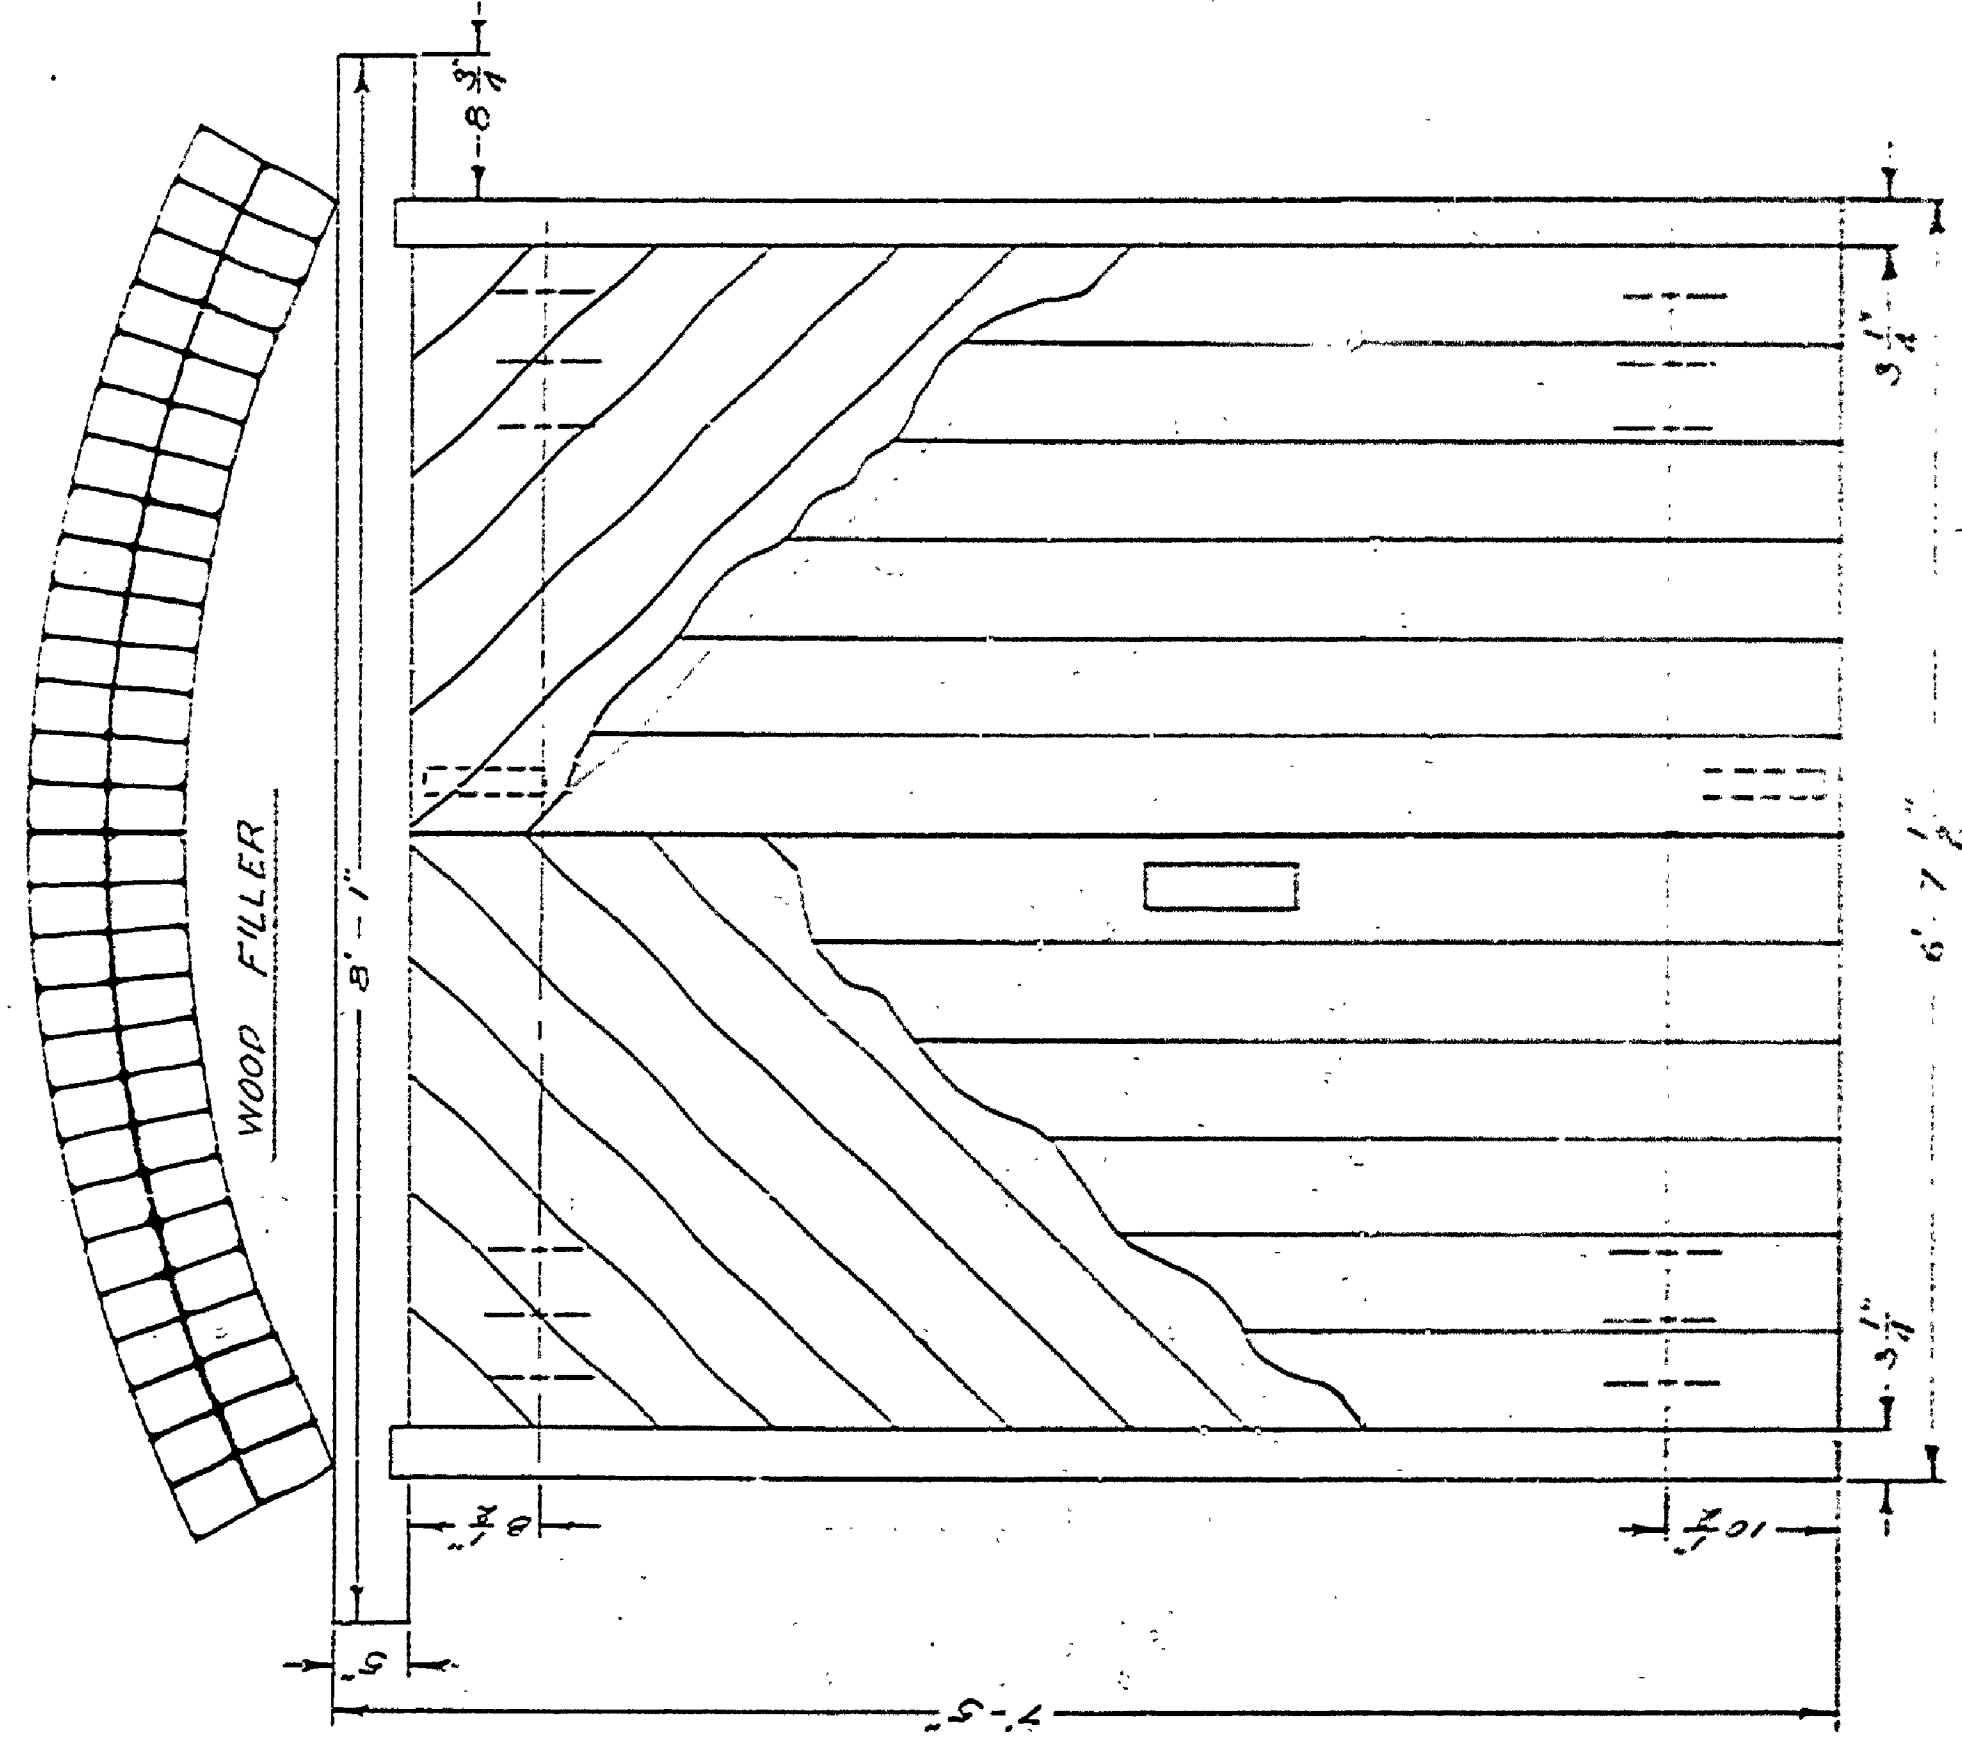


DOOR - EAST & WEST

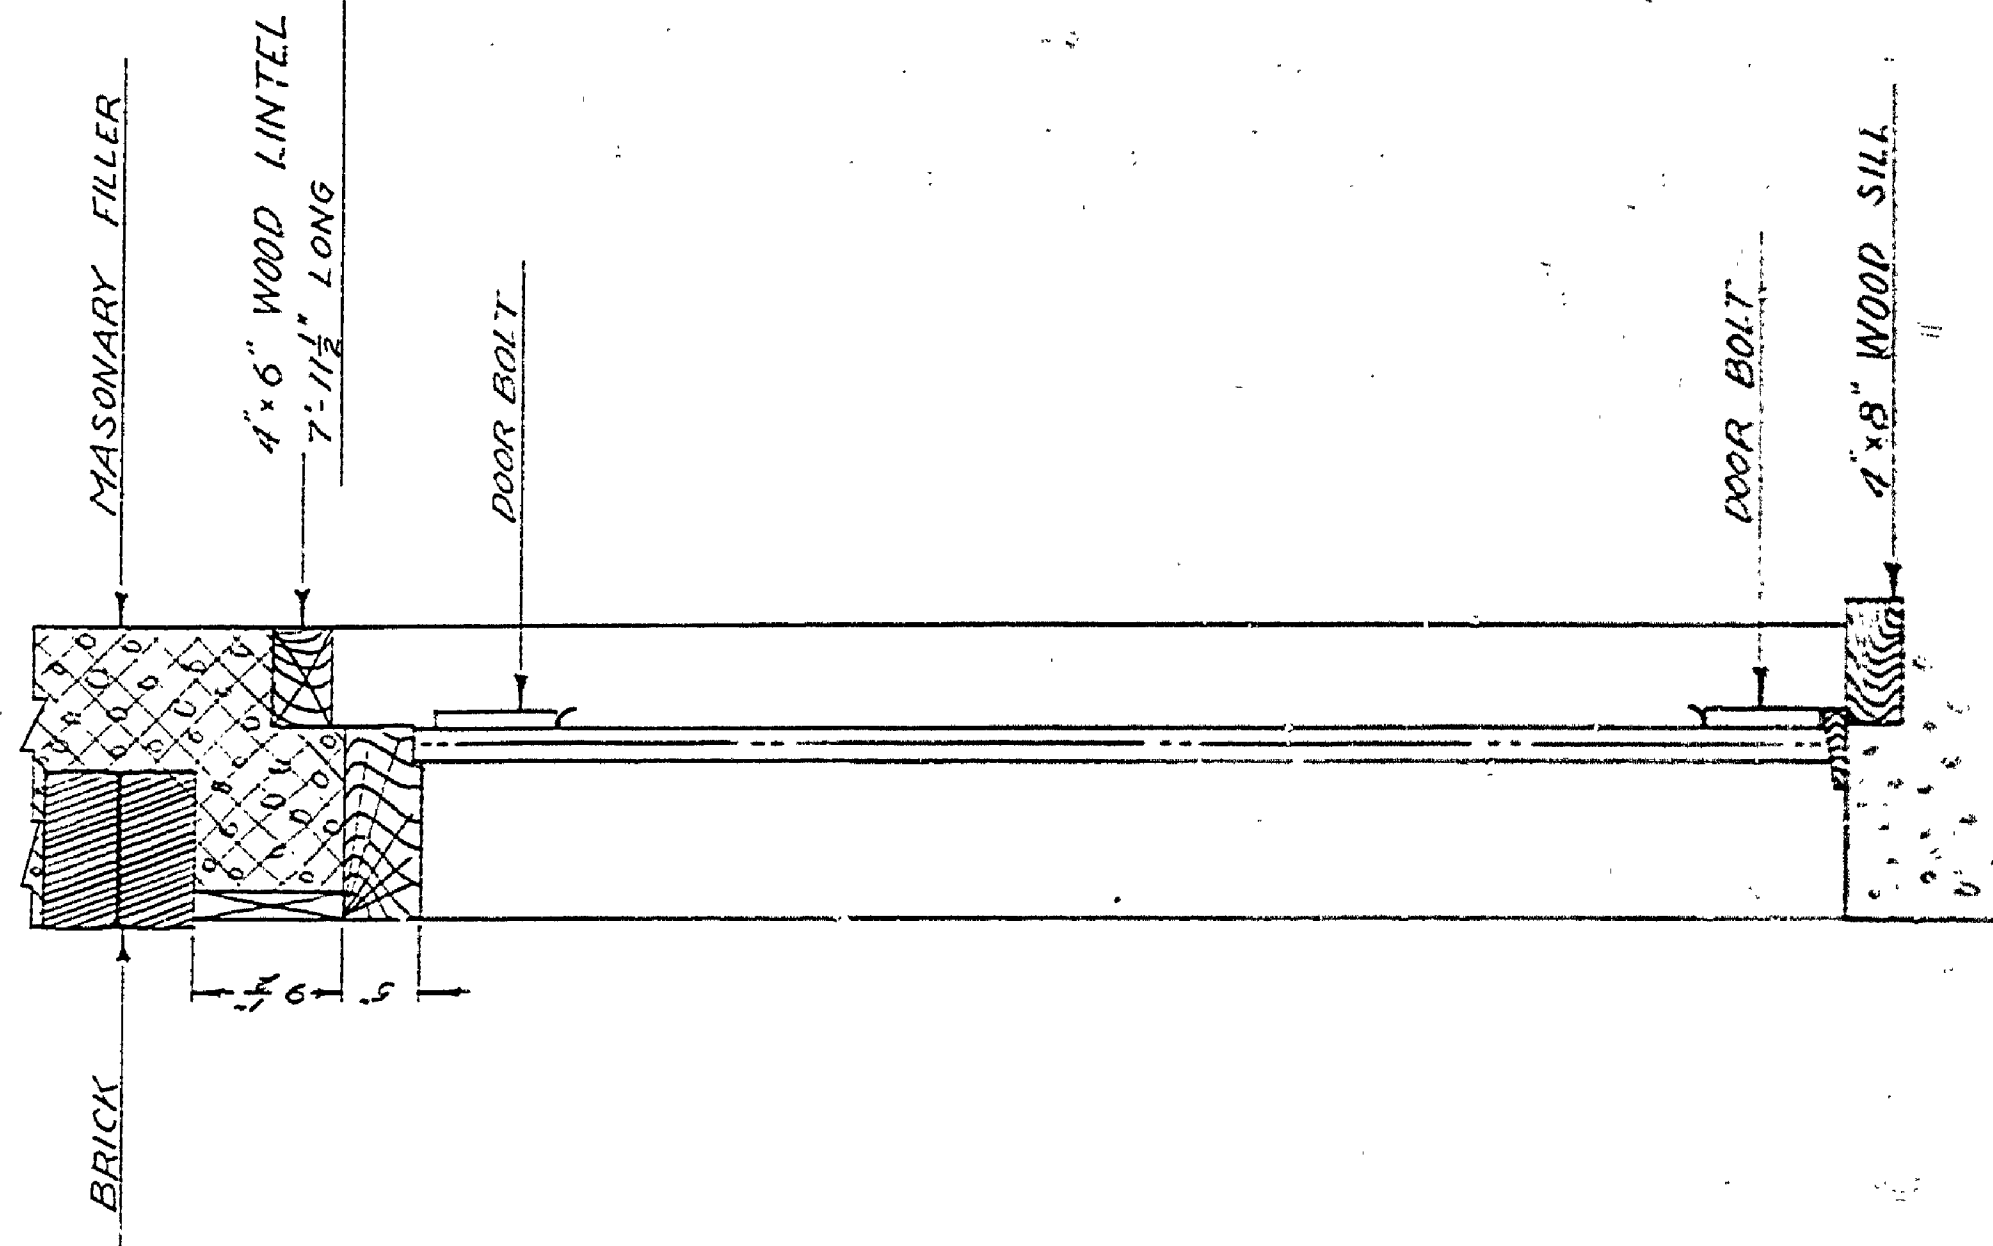


SCALE 1/4\"/>

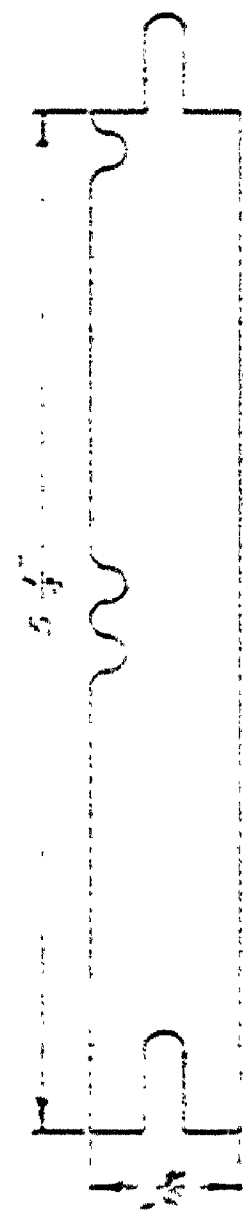


END VIEW OF DOOR BOARD
FULL SCALE

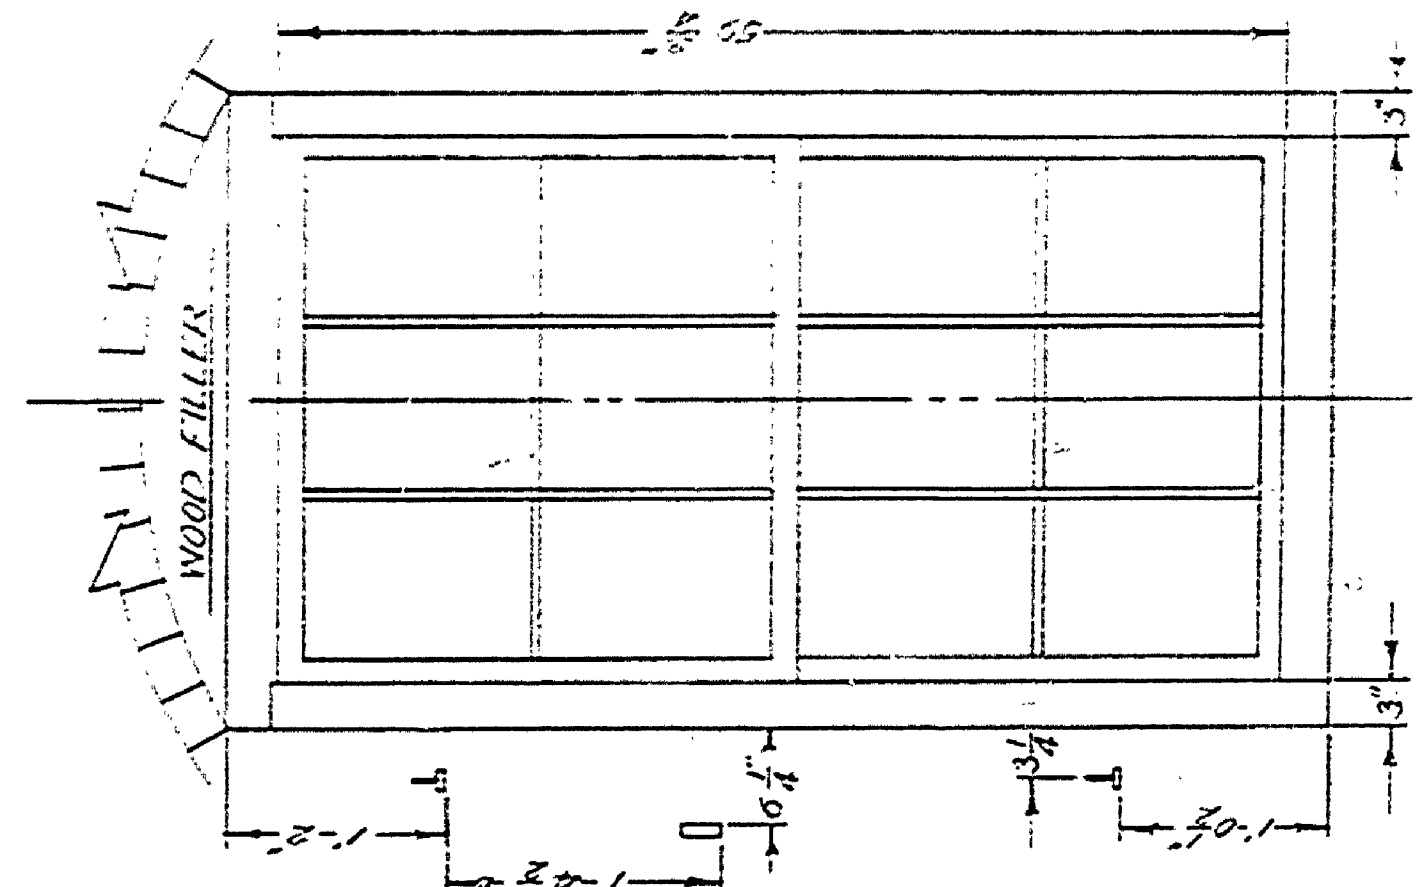

SCALE 1/4\"/>

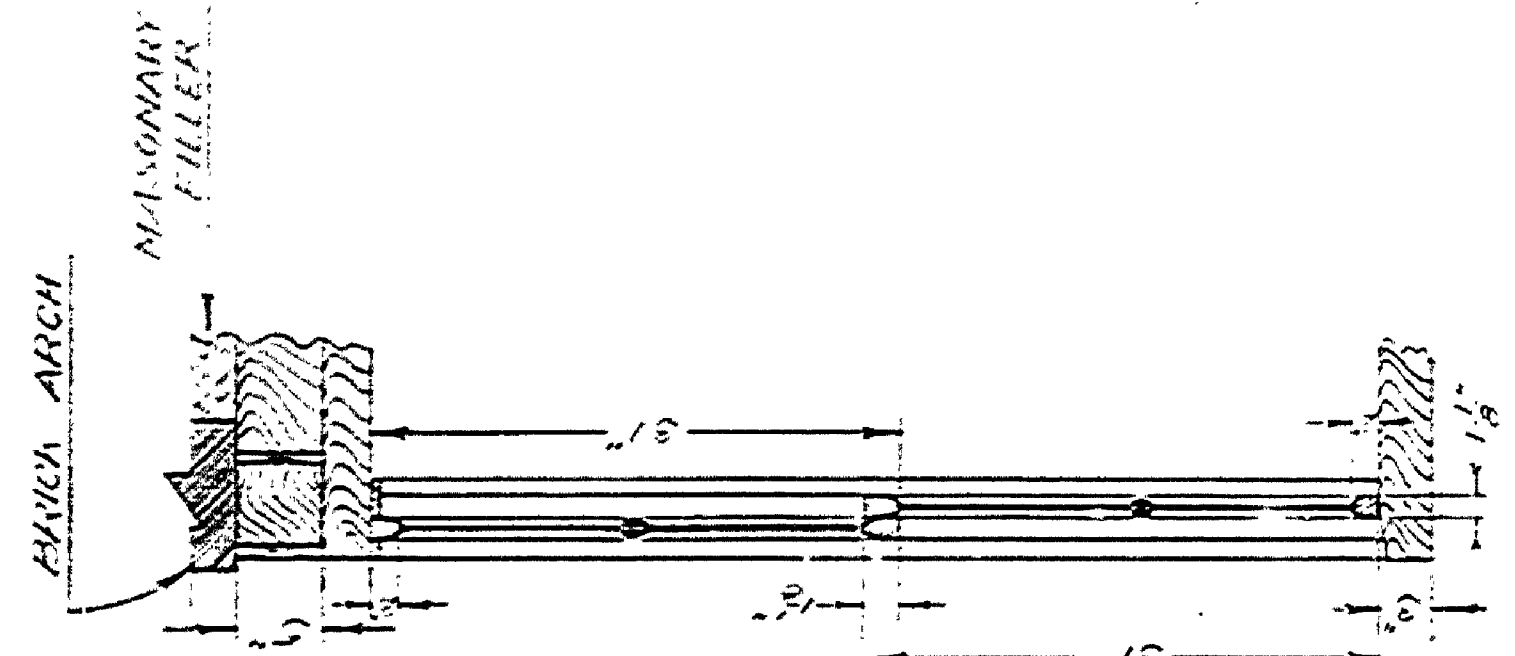

SASH - 18\"/>

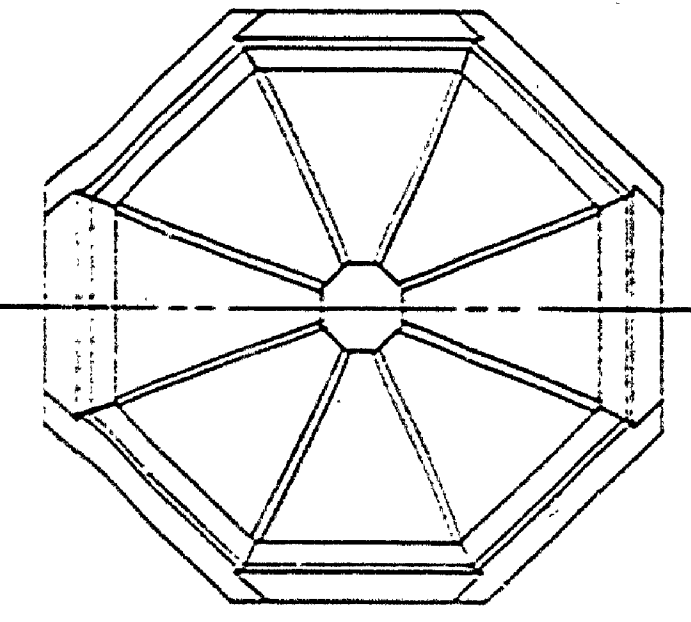

OCTAGON WINDOW: SASH - 18\"/>

MICHIGAN
DEPARTMENT OF CONSERVATION
PARKS AND RECREATION DIVISION

Fayette State Park
Measured Drawing
Fayette Historical Townsite
Building # 100

SHEET
NO. 2
OF 3

PLAN NO.
A-104