



DATE	REVIEWED	DATE	APPROVED	NO.	DATE	BY	REVISIONS
1/24/71	ARCHITECTURAL	1/24/71		1			4
	ENGINEERING			2			5
	LANDSCAPE			3			6

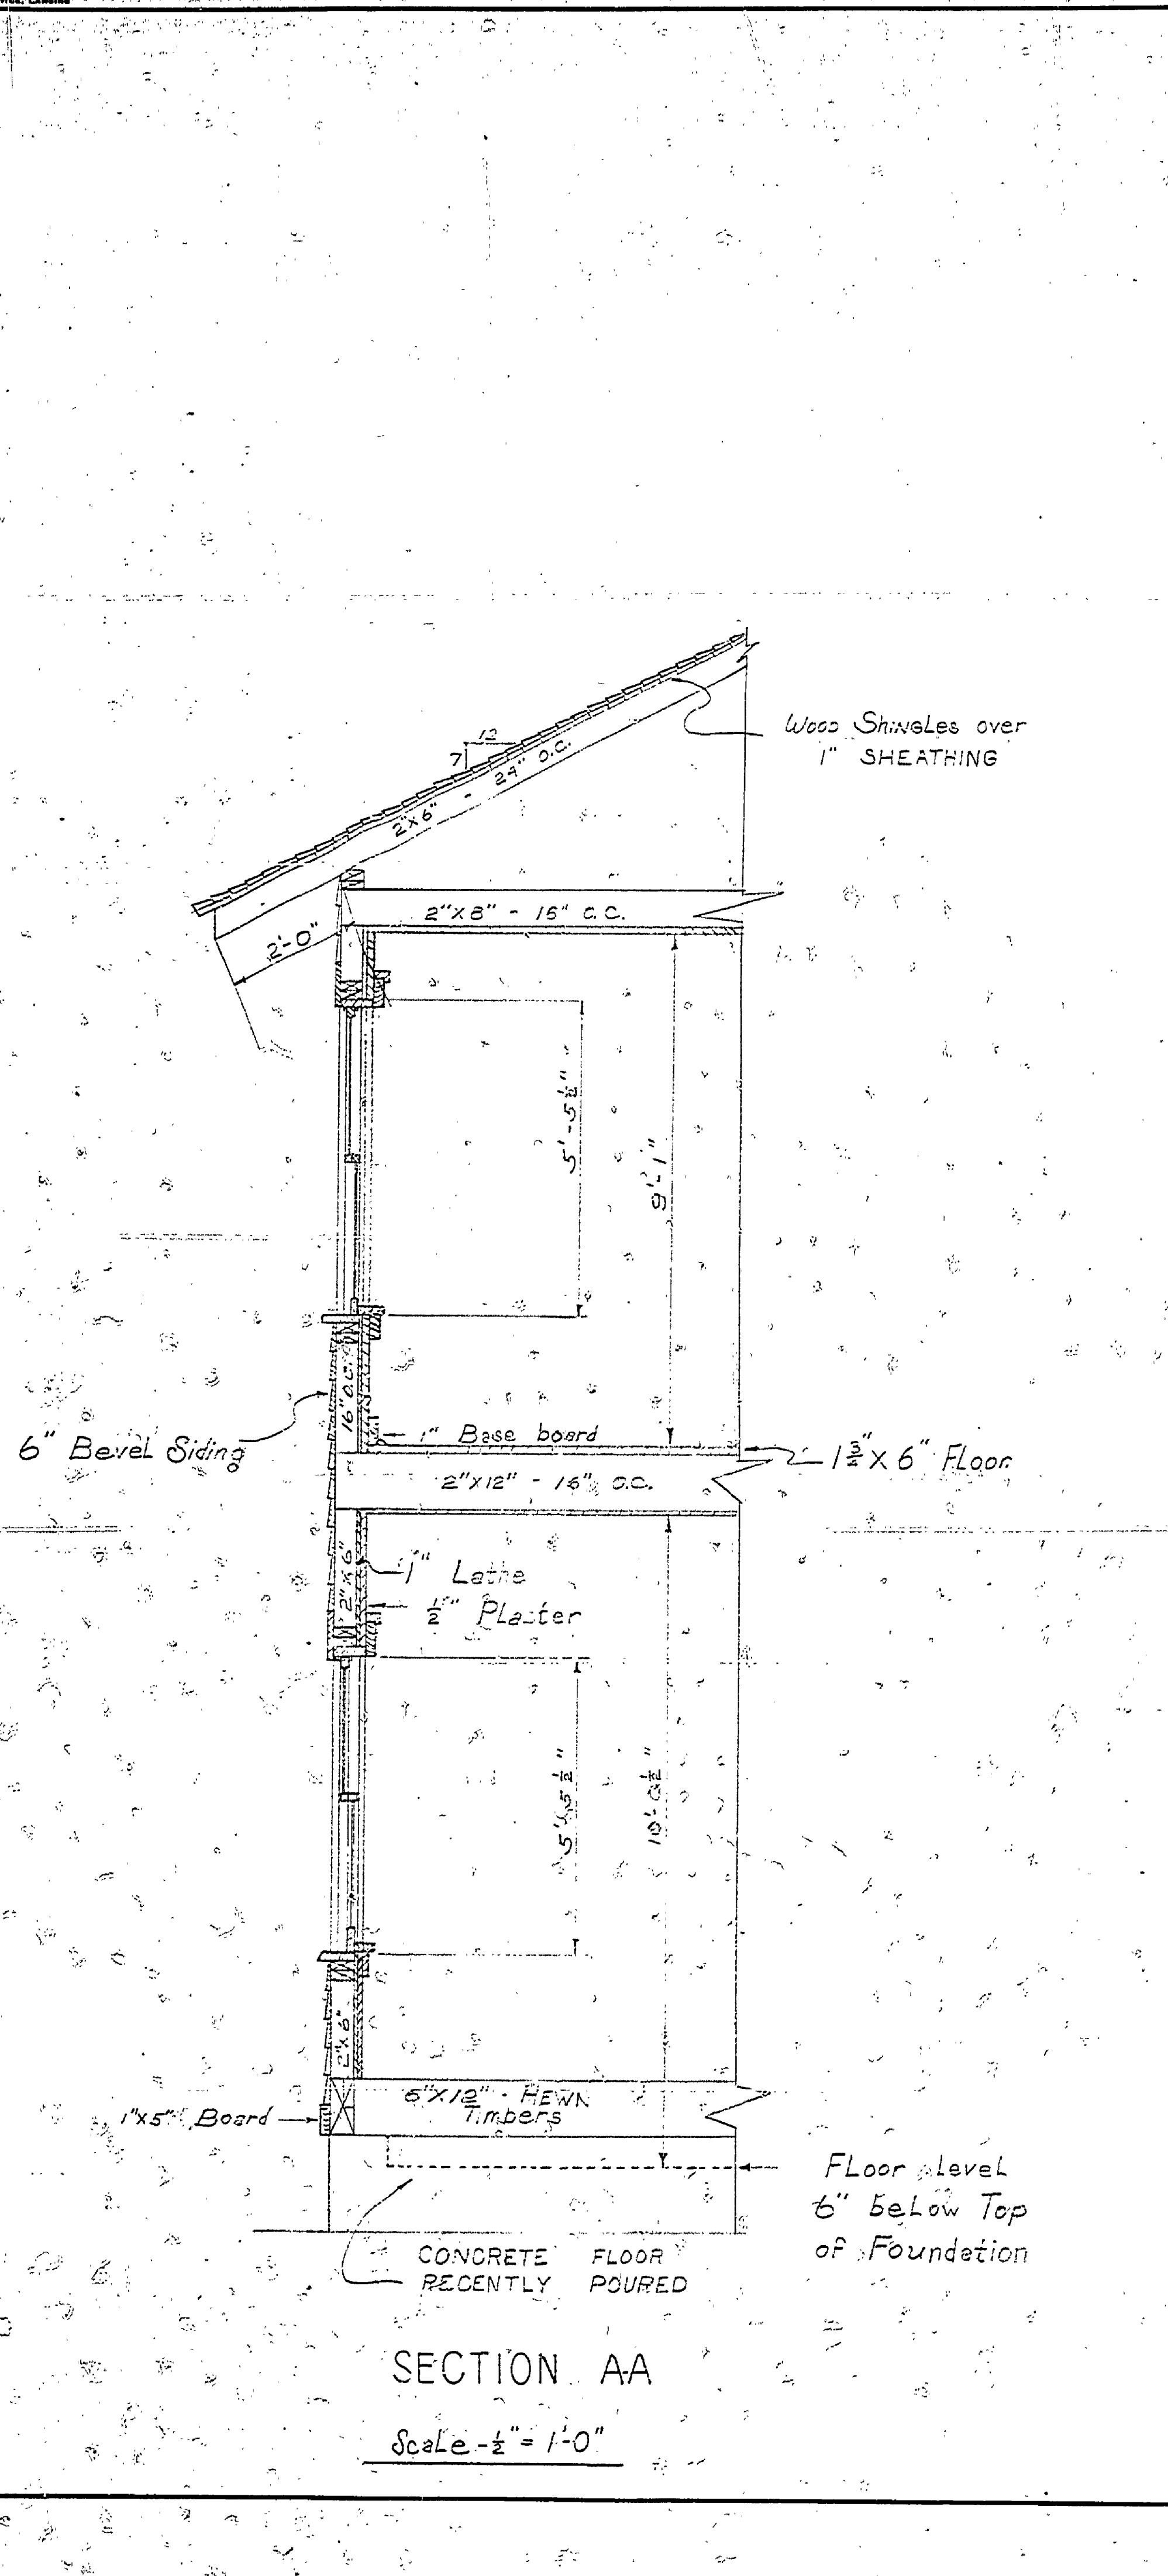


SECTION AA
Scale - 1/2" = 1'-0"

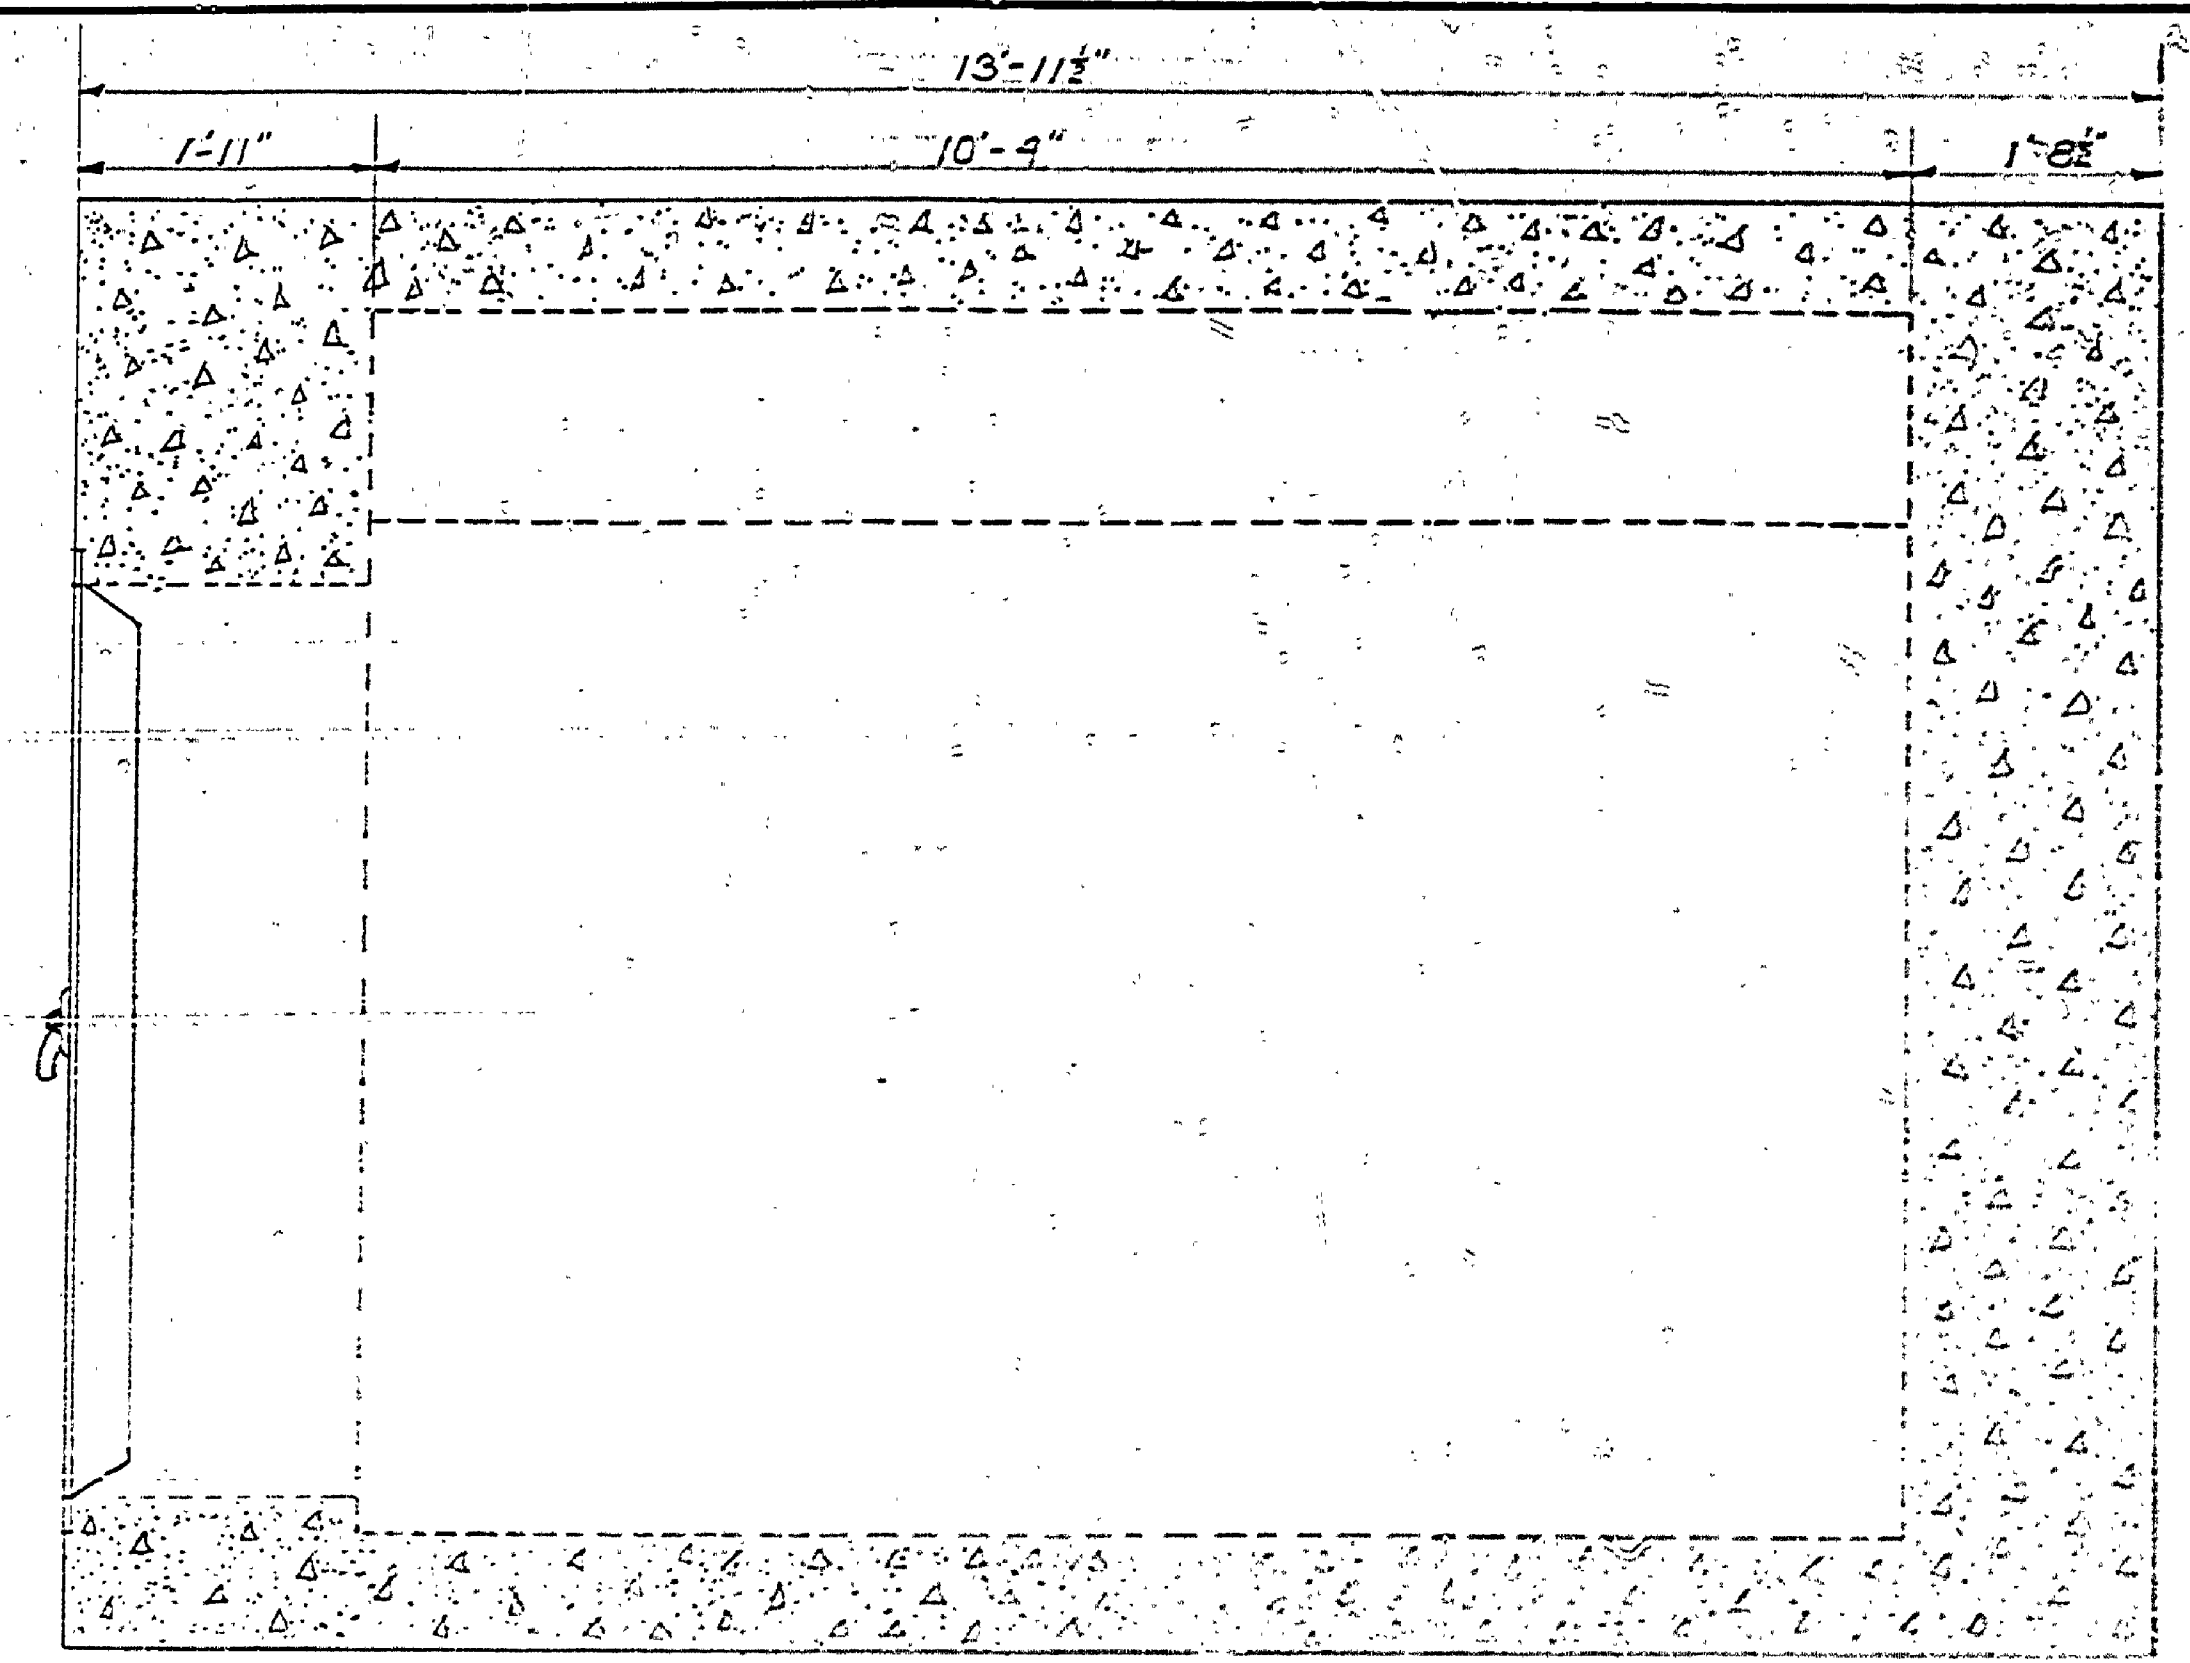


NOTE
AT LEAST 1 COURSE OF BRICK AROUND CASING ON OUTSIDE OF VAULT & 1 COURSE ON INSIDE WITH CONCRETE CENTER.


NOTE
VAULT DOOR NOT ORIGINAL

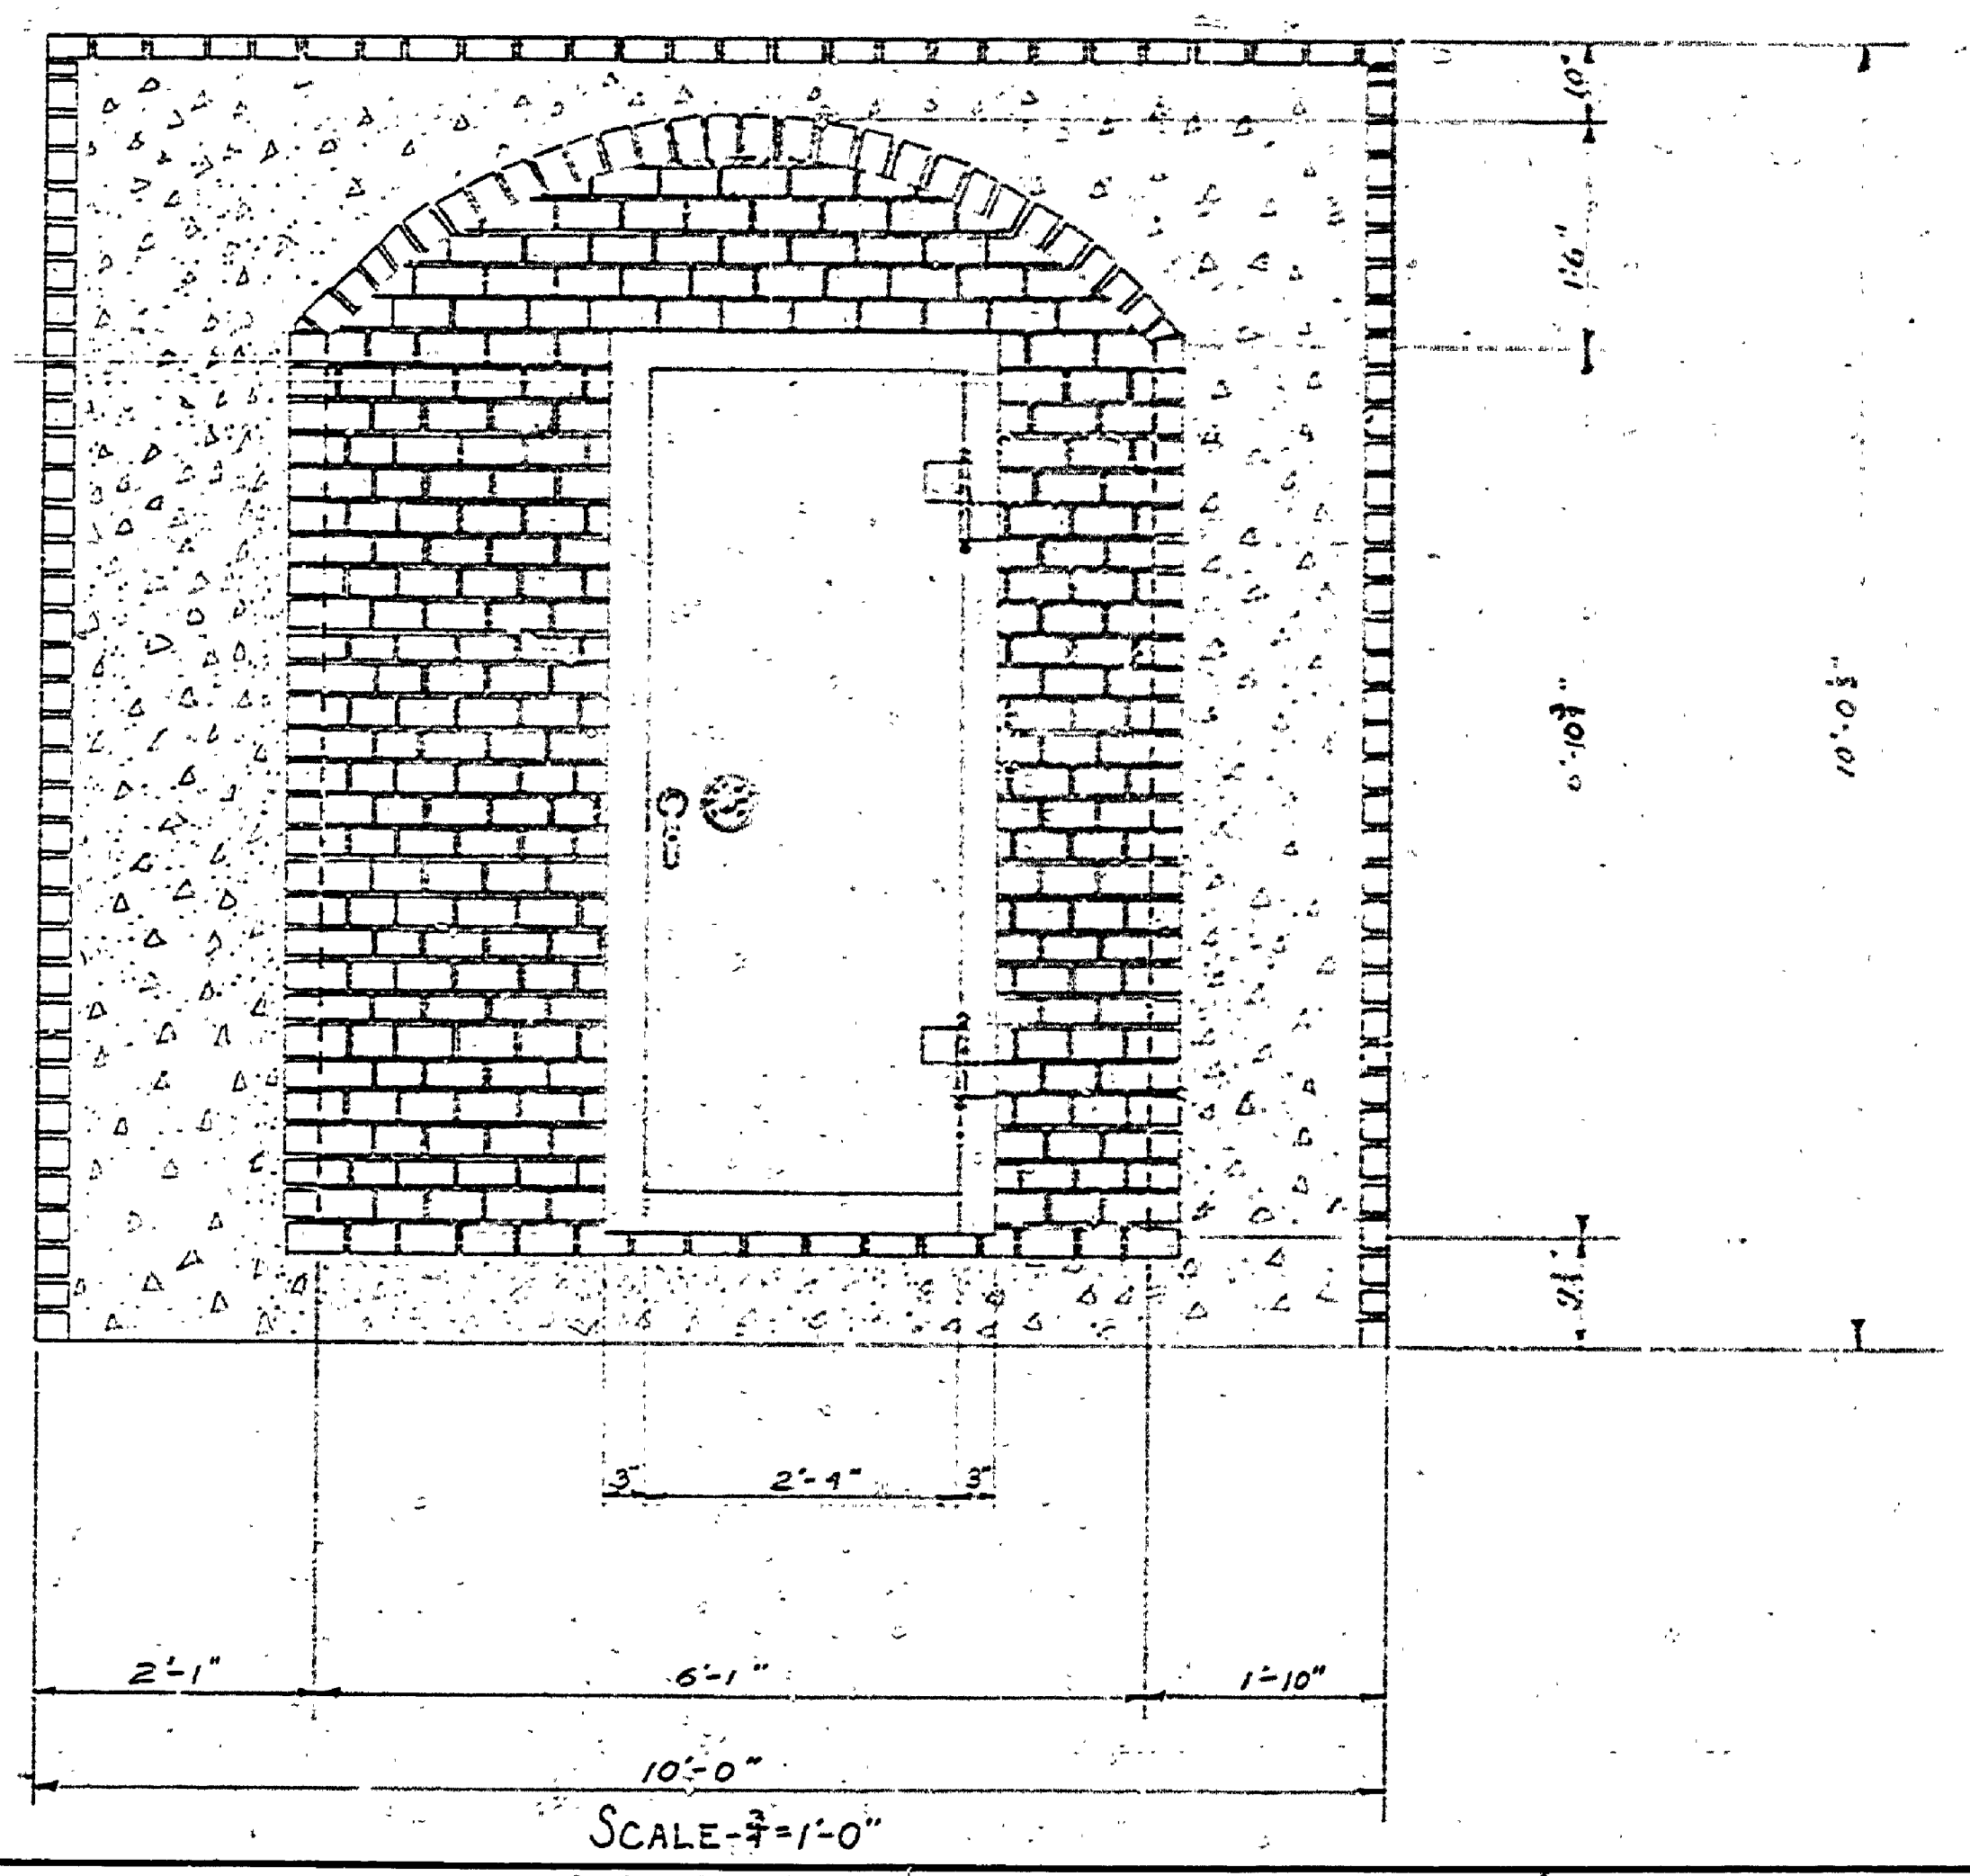

SCALE - 3/4" = 1'-0"

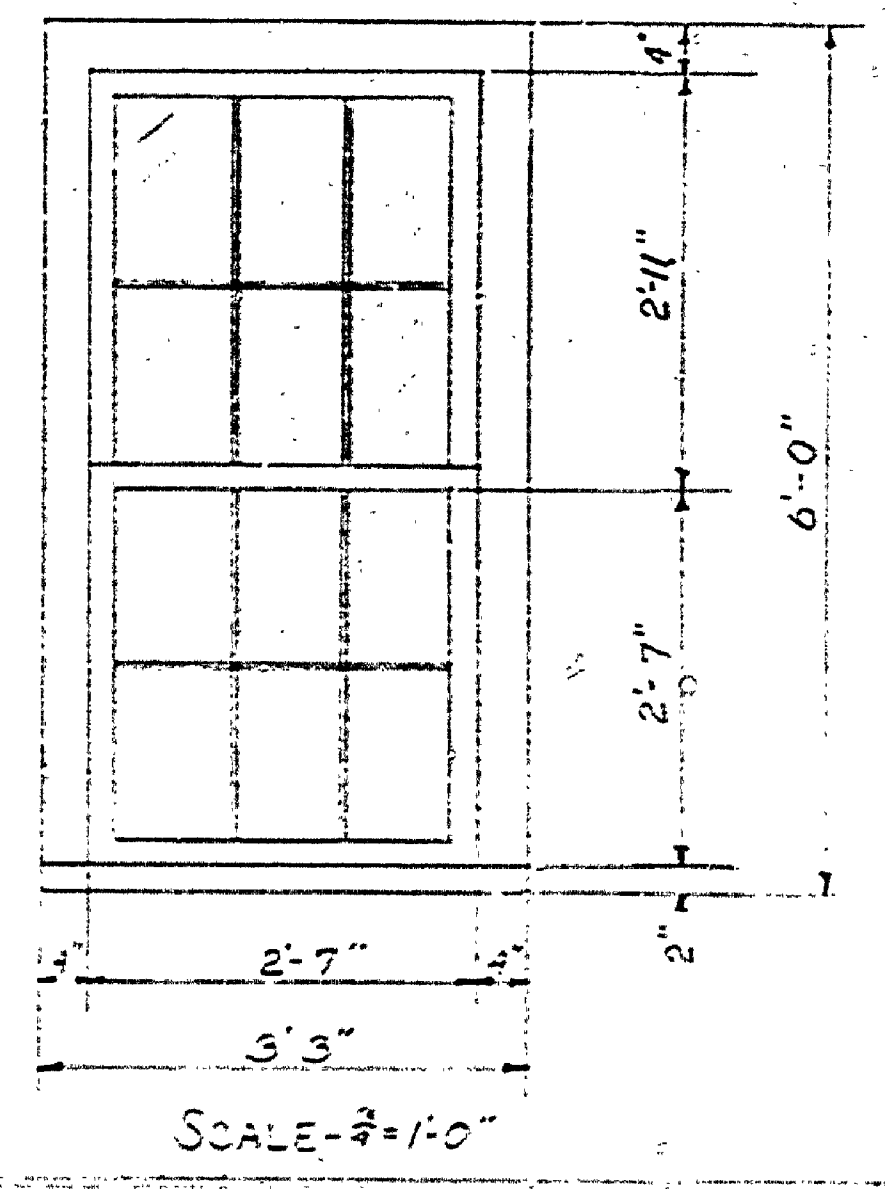

SCALE - 3/4" = 1'-0"

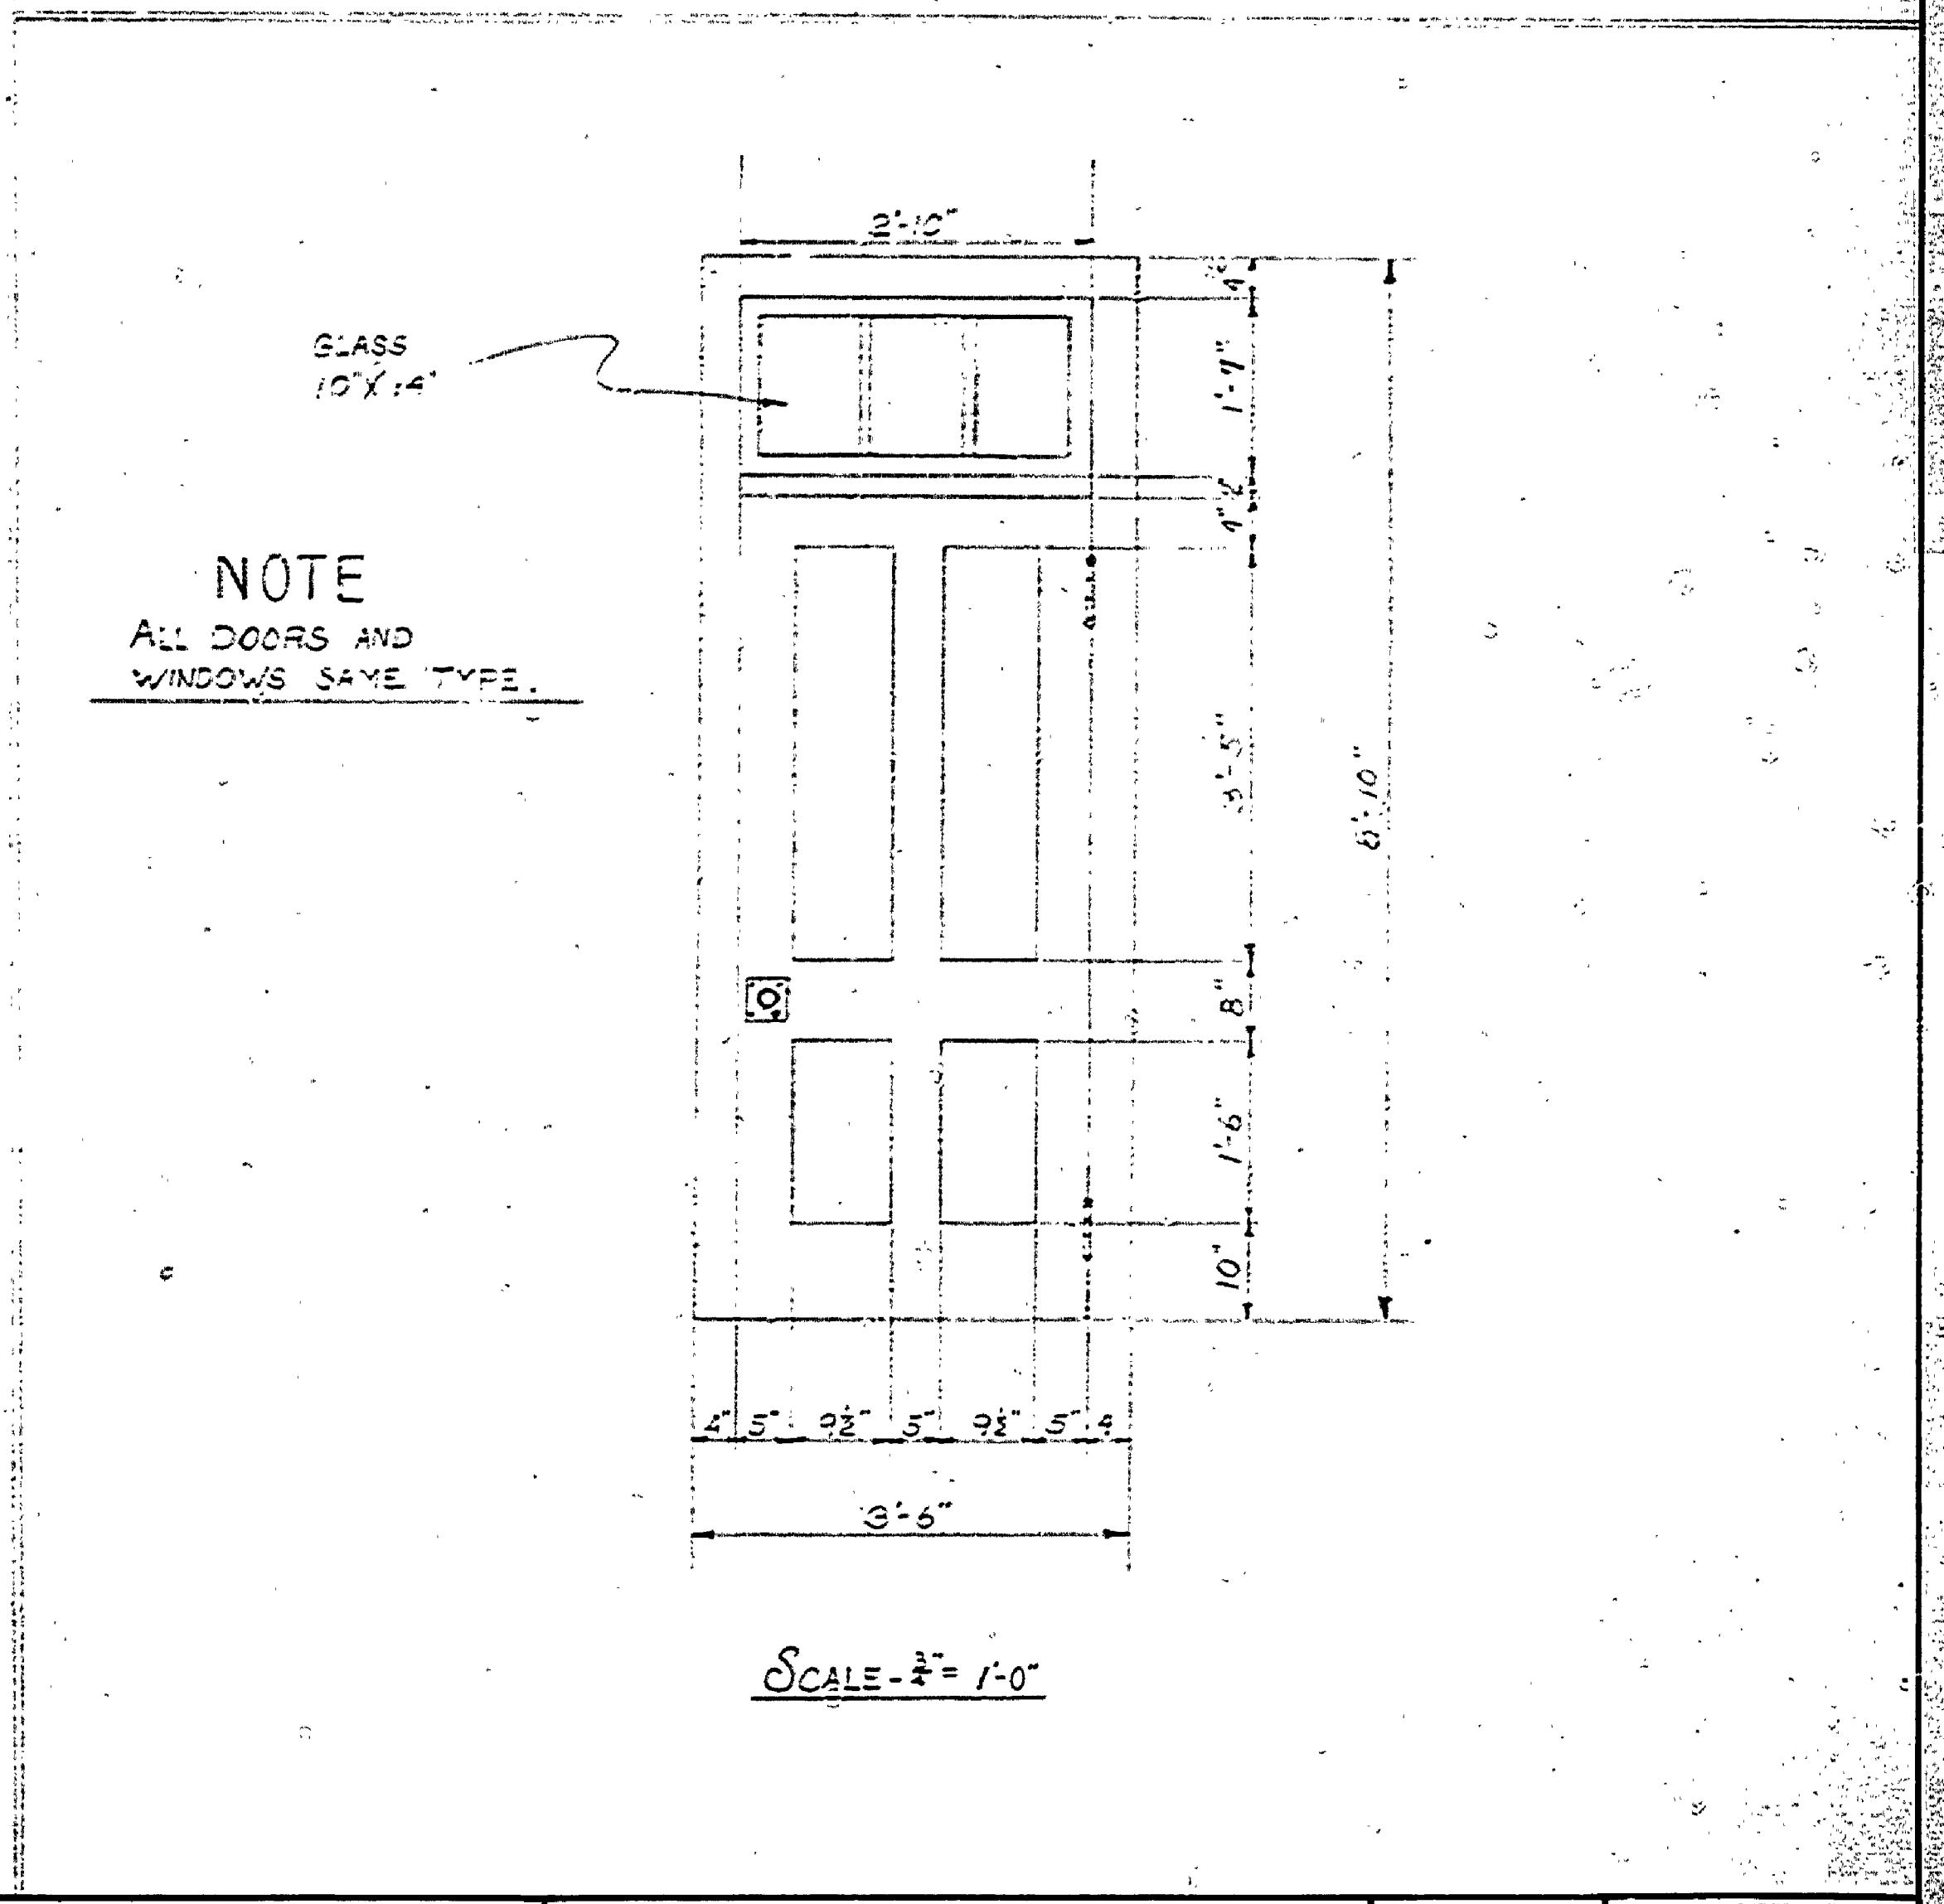

NOTE
ALL DOORS AND WINDOWS SAME TYPE.

SCALE - 3/4" = 1'-0"

MICHIGAN
DEPARTMENT OF CONSERVATION
PARKS AND RECREATION DIVISION

MEASURED DRAWING
FAYETTE HISTORICAL TOWNSITE
FAYETTE STATE PARK

SHEET NO. 3
OF 3
PLAN NO. A-10.8