




DESIGNED BY	DATE	REVIEWED	DATE	APPROVED	DATE	NO.	DATE	BY	REVISIONS	DATE	BY
		ARCHITECTURAL				1			4		
		ENGINEERING				2			5		
		LANDSCAPE				3			6		

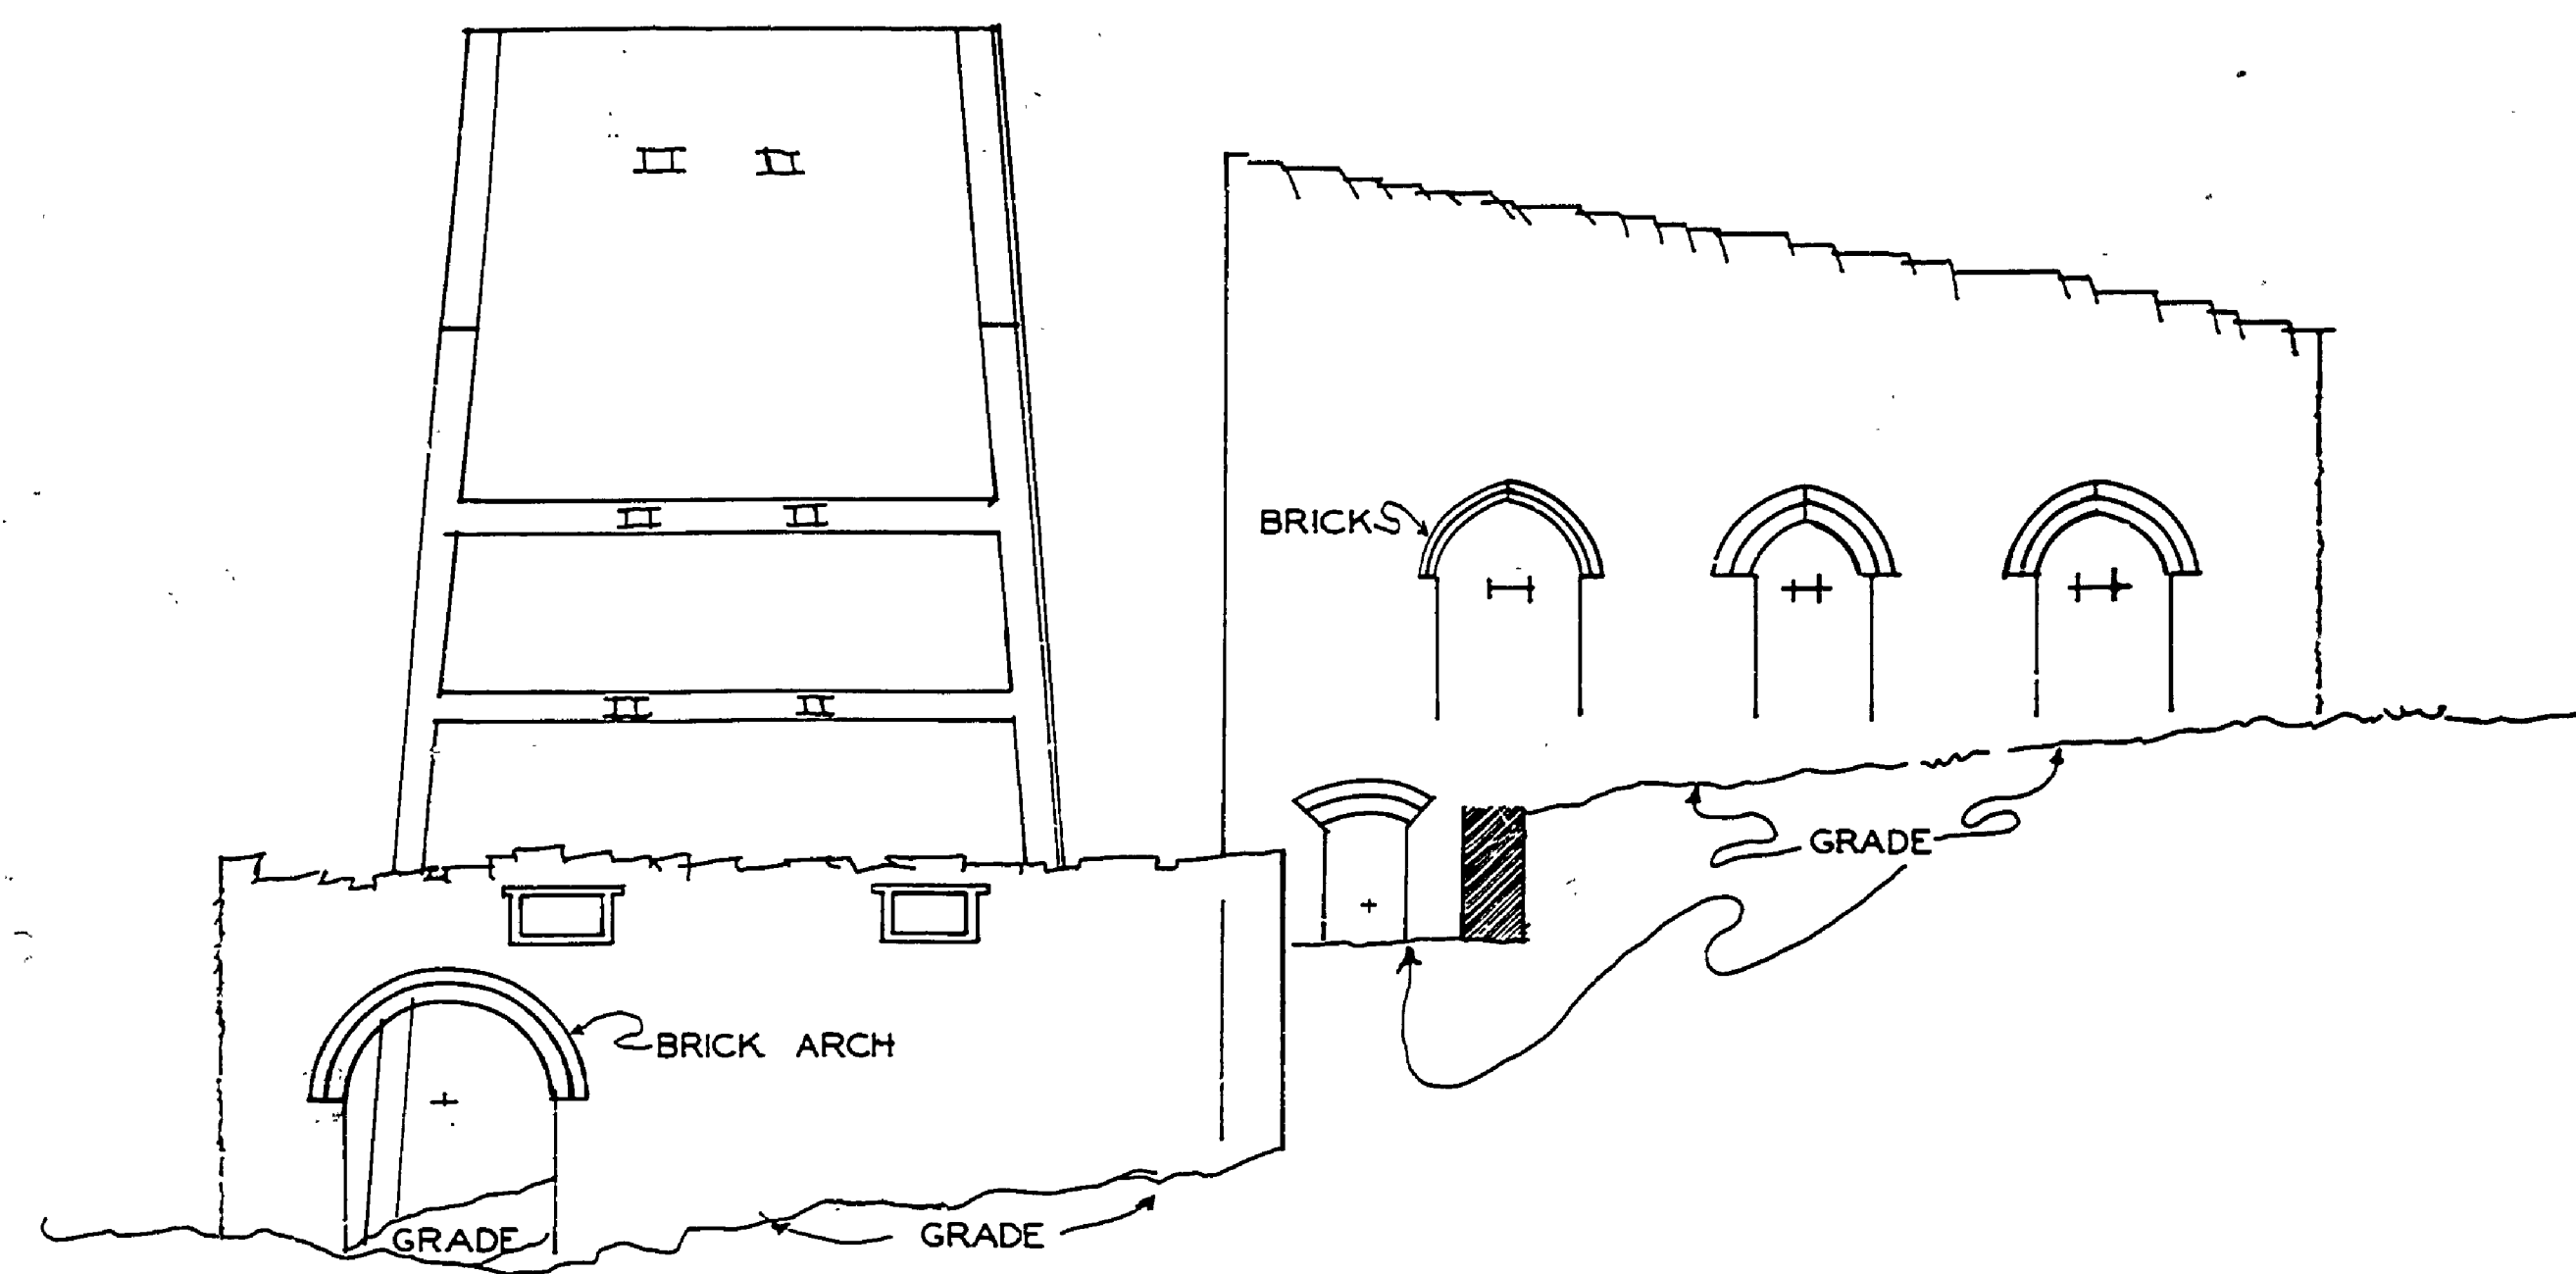

WEST ELEVATION

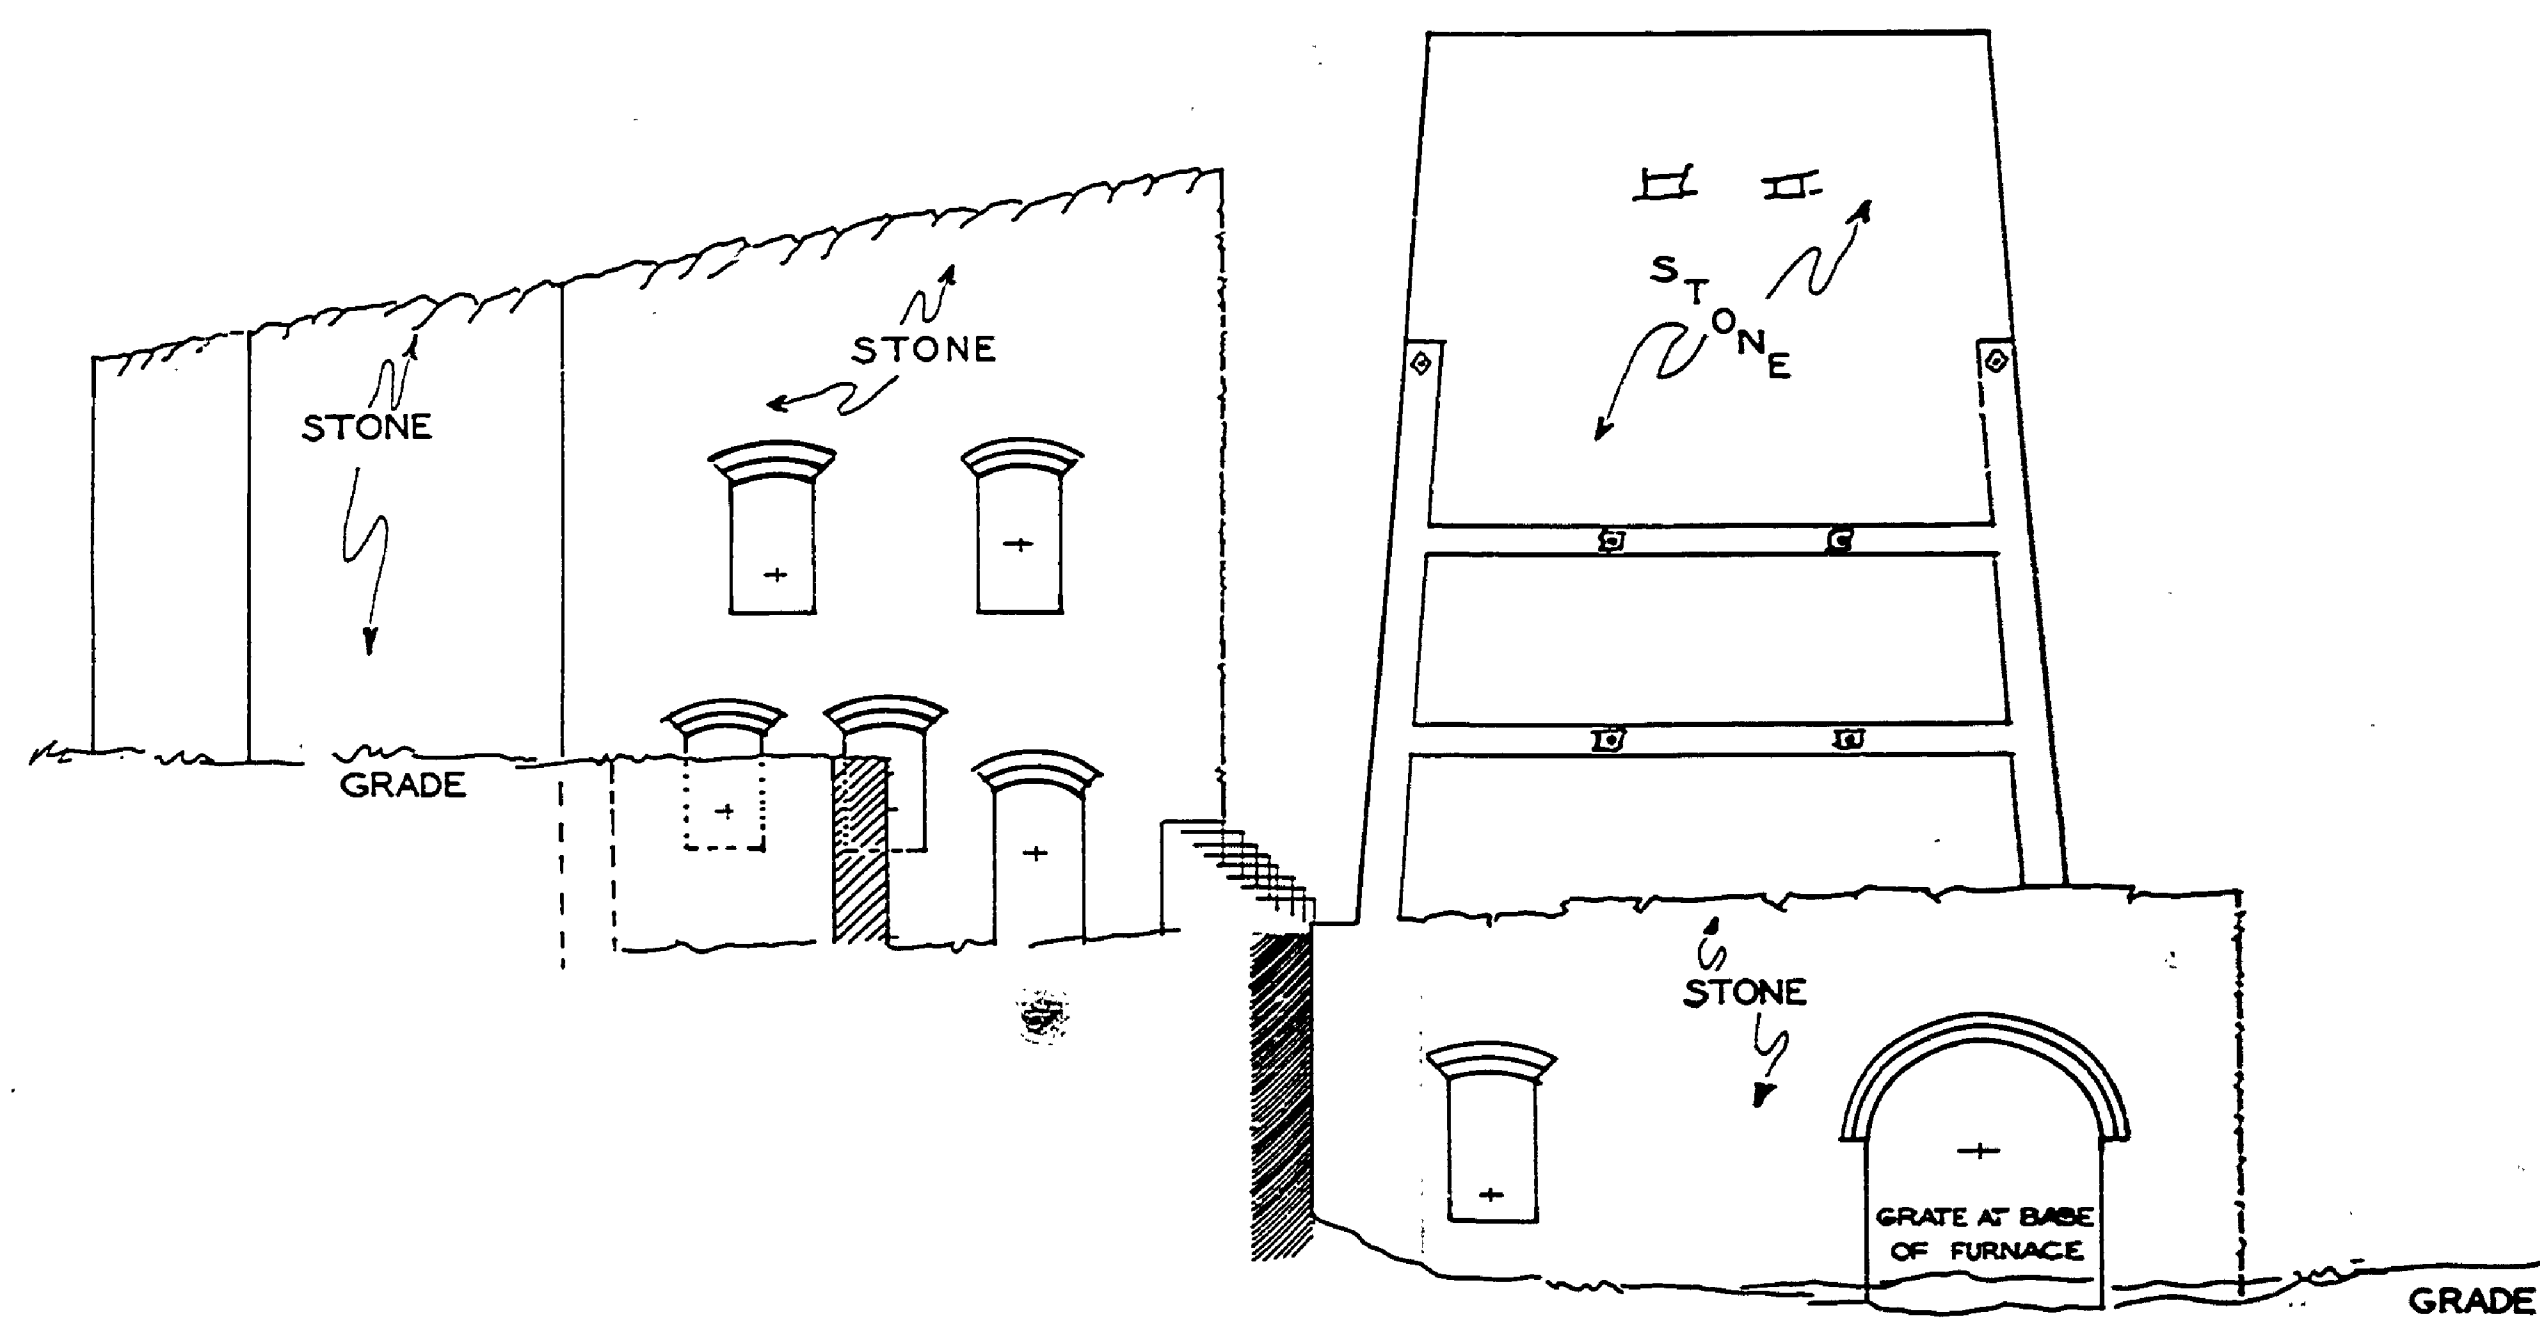

EAST ELEVATION

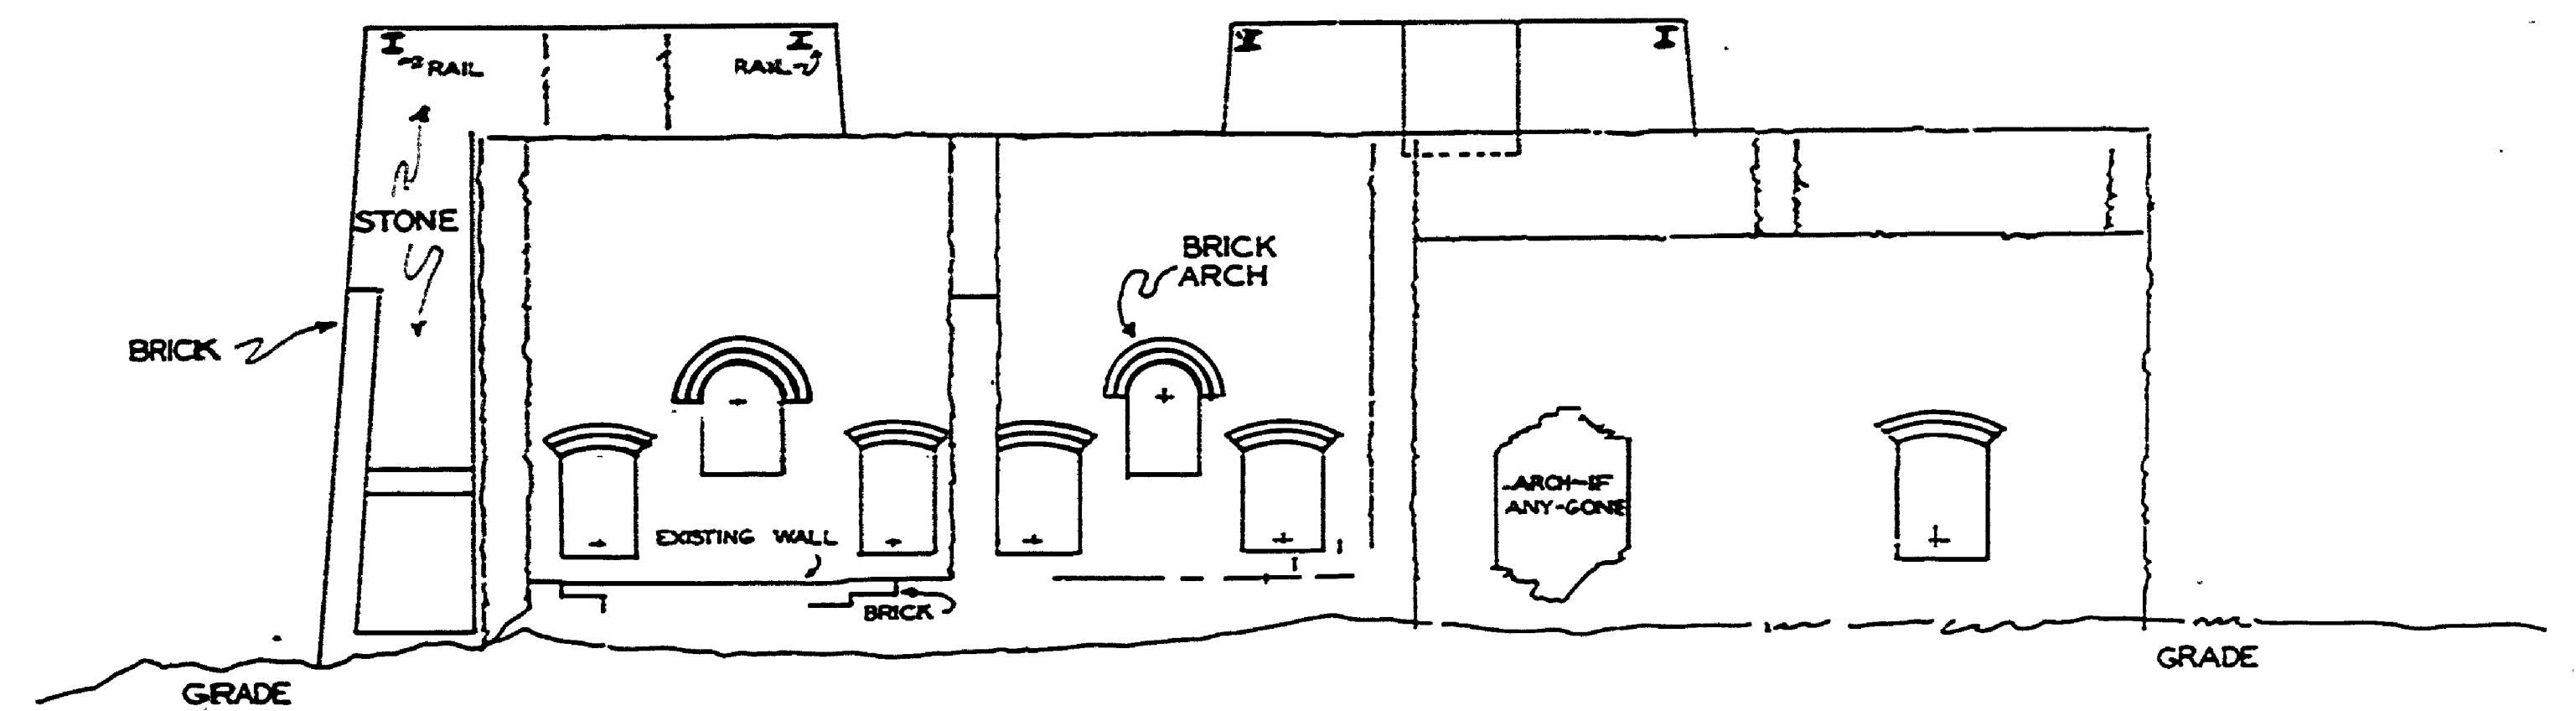

SOUTH ELEVATION

SCALE 1/8" = 1'-0" UNLESS OTHERWISE SPECIFIED

MICHIGAN
DEPARTMENT OF CONSERVATION
PARKS AND RECREATION DIVISION

MEASURED DRAWING
FAYETTE HISTORICAL TOWNSITE
FAYETTE STATE PARK

SHEET
NO. 3
OF 5

PLAN NO.
A-114