Sections 4 and 5, T. 38 N. R. 19 W.

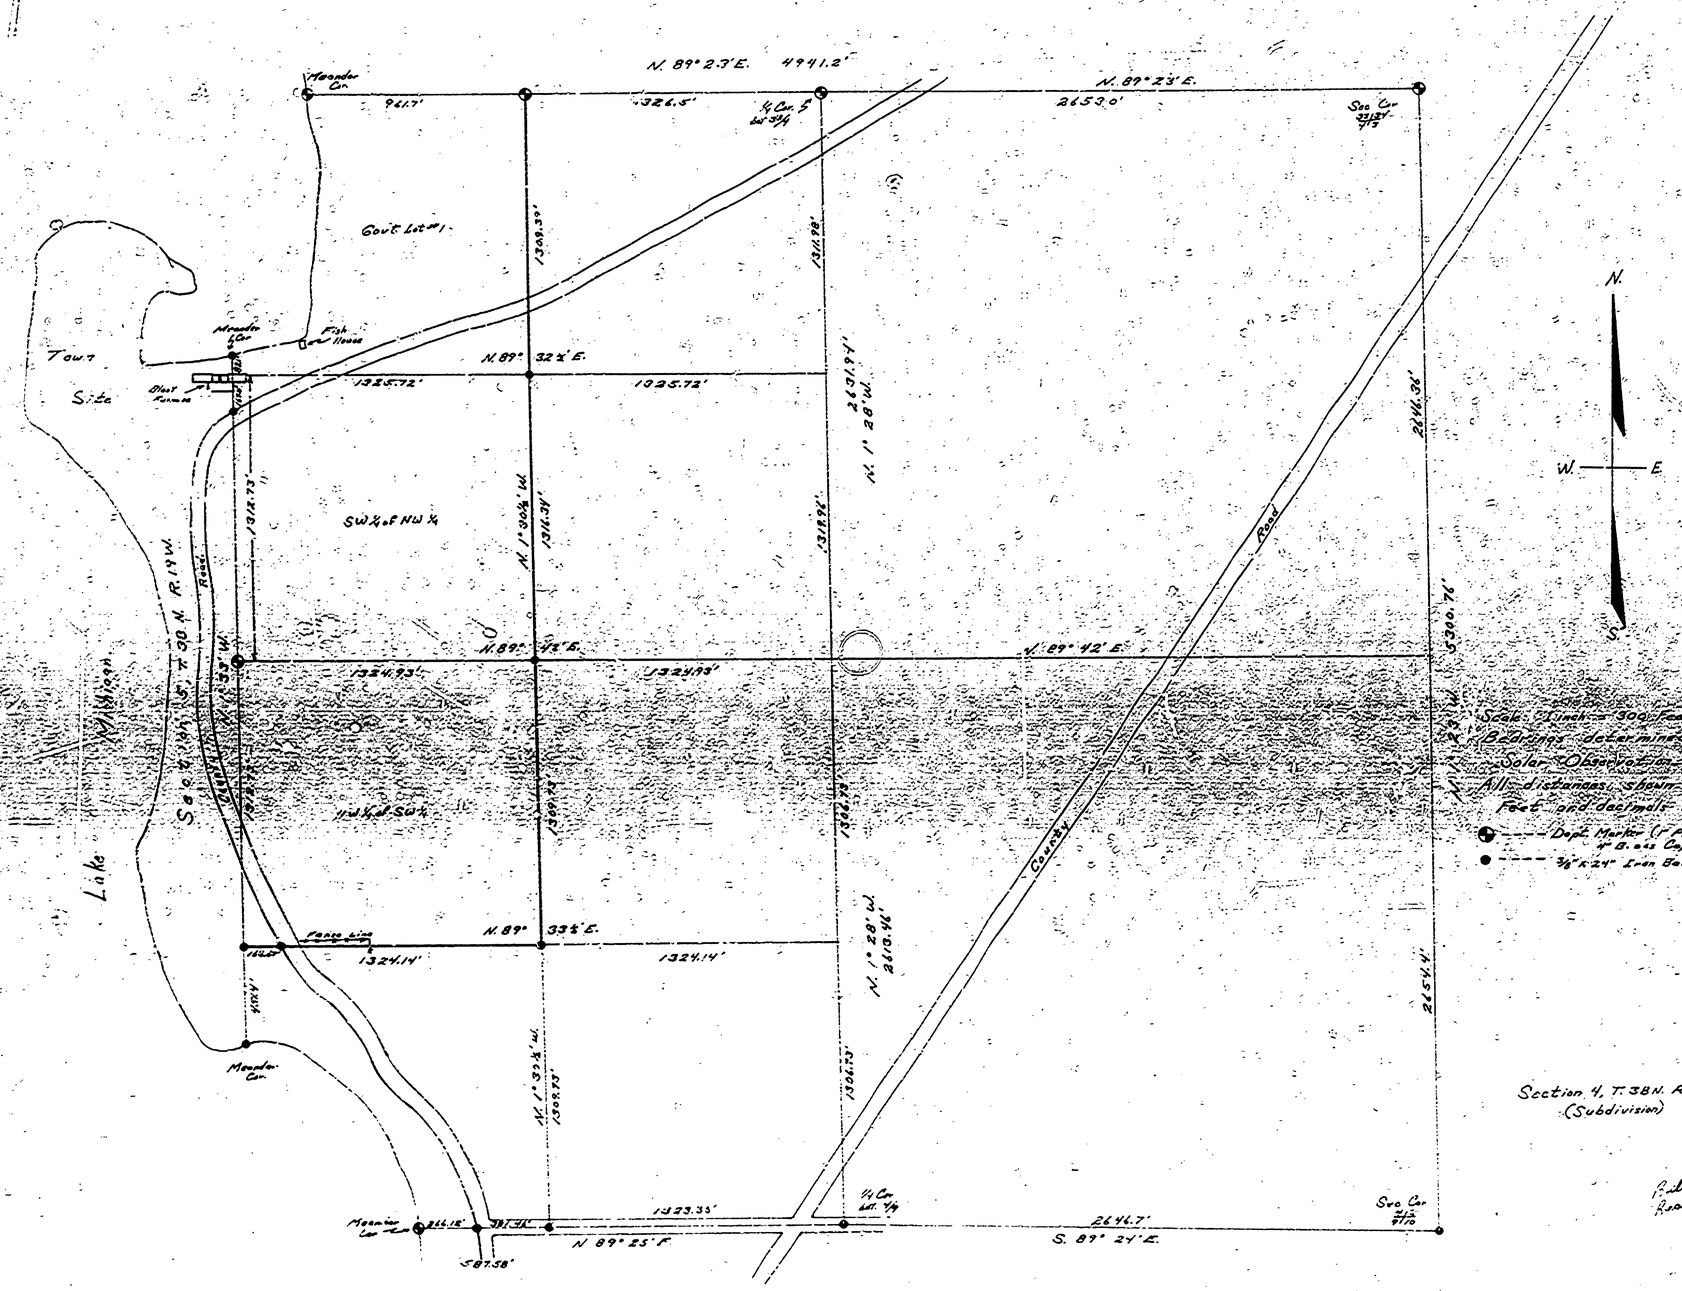

Section 4, T. 38 N. R. 19 W.
(Subdivision)

Billy D. Buckles
Registered Land Surveyor
8887
11/12/61

Mich. Conservation Dep't Forestry Division Survey Section	Field Crew: Frank Bray, Engr. Aide I
	Surveyor: Billy D. Buckles # 8887
	Drawing: Buckles 11/12/61

1 = 2