

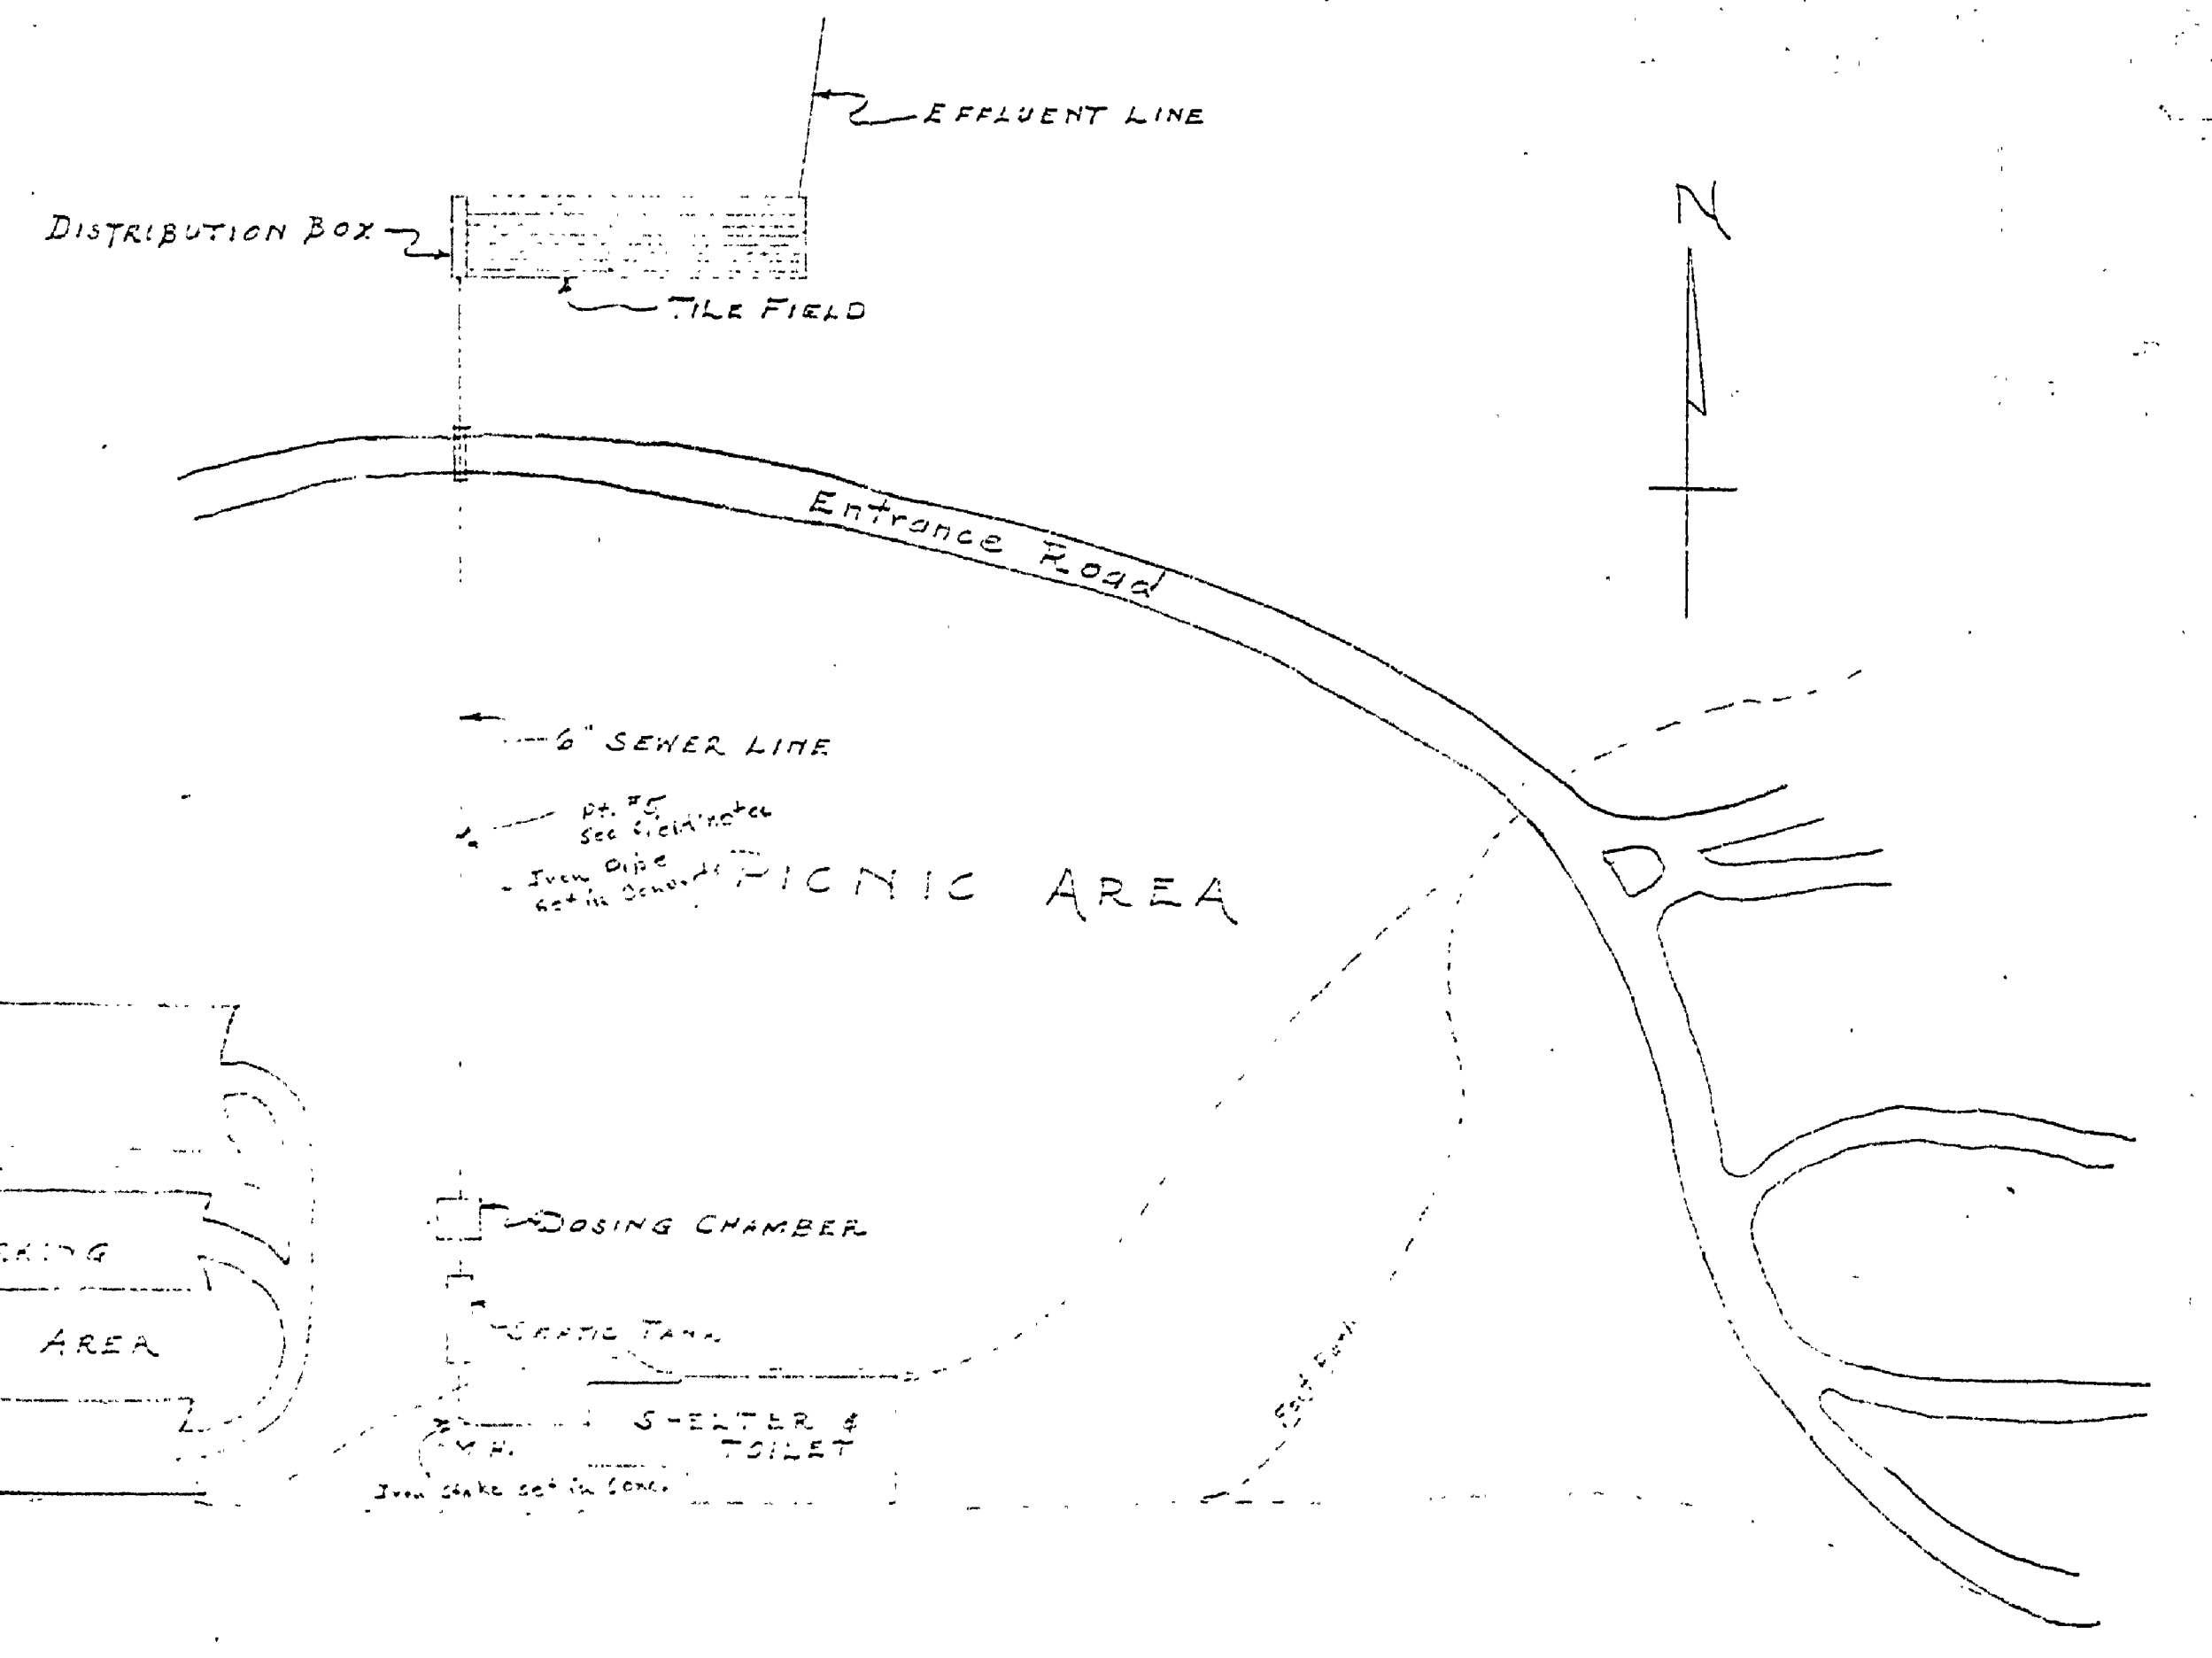
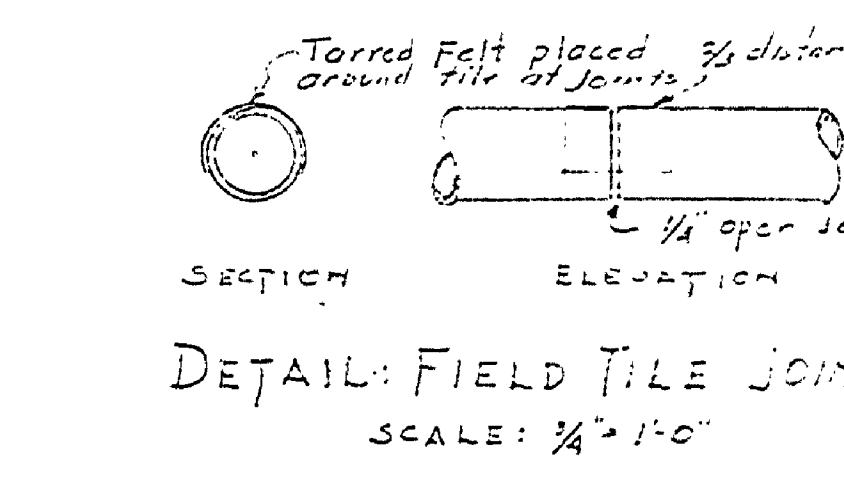
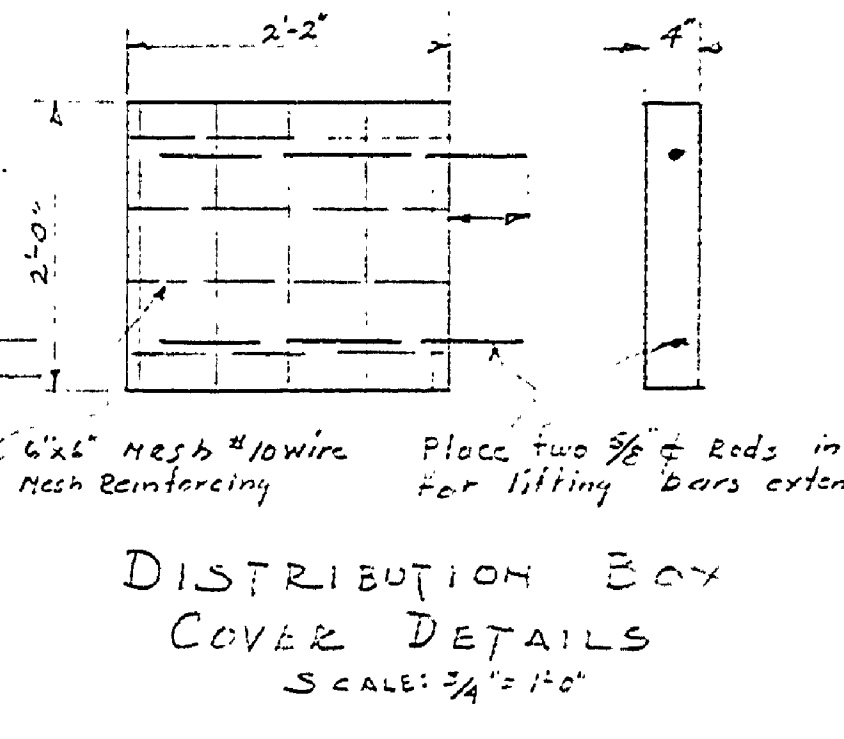



- PLAN - DISPOSAL FIELD -

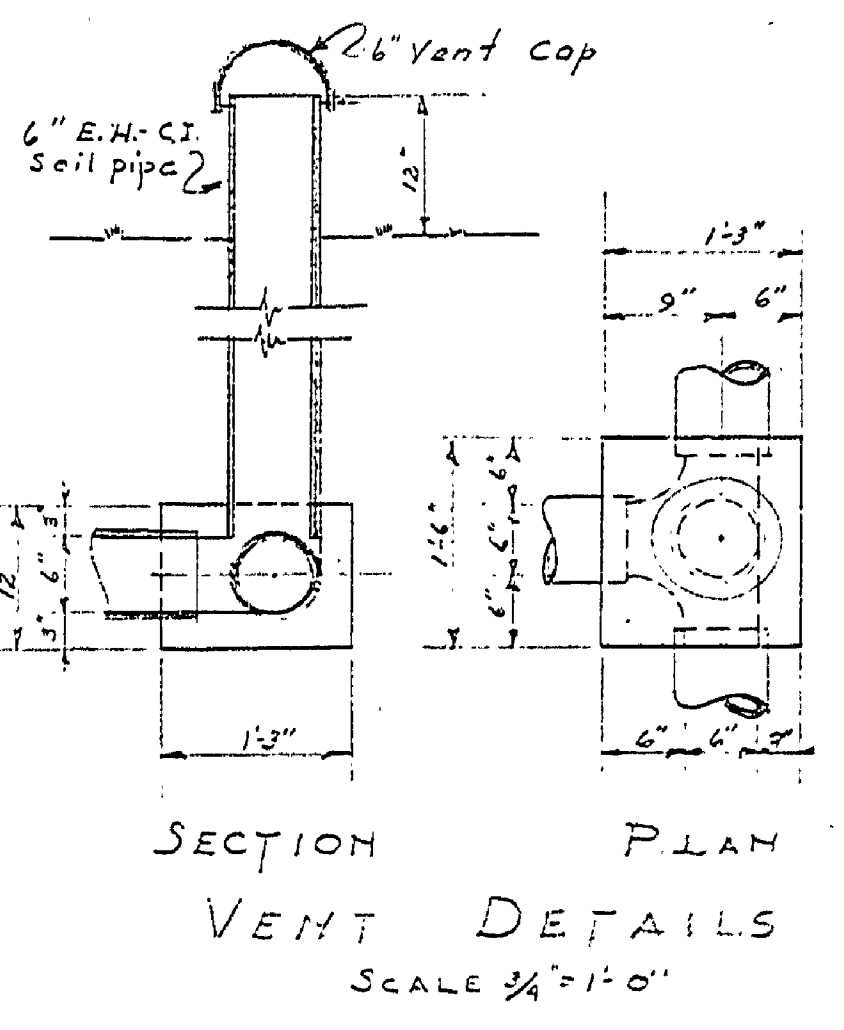


PLOT PLAN
SCALE 1"=50'-0"

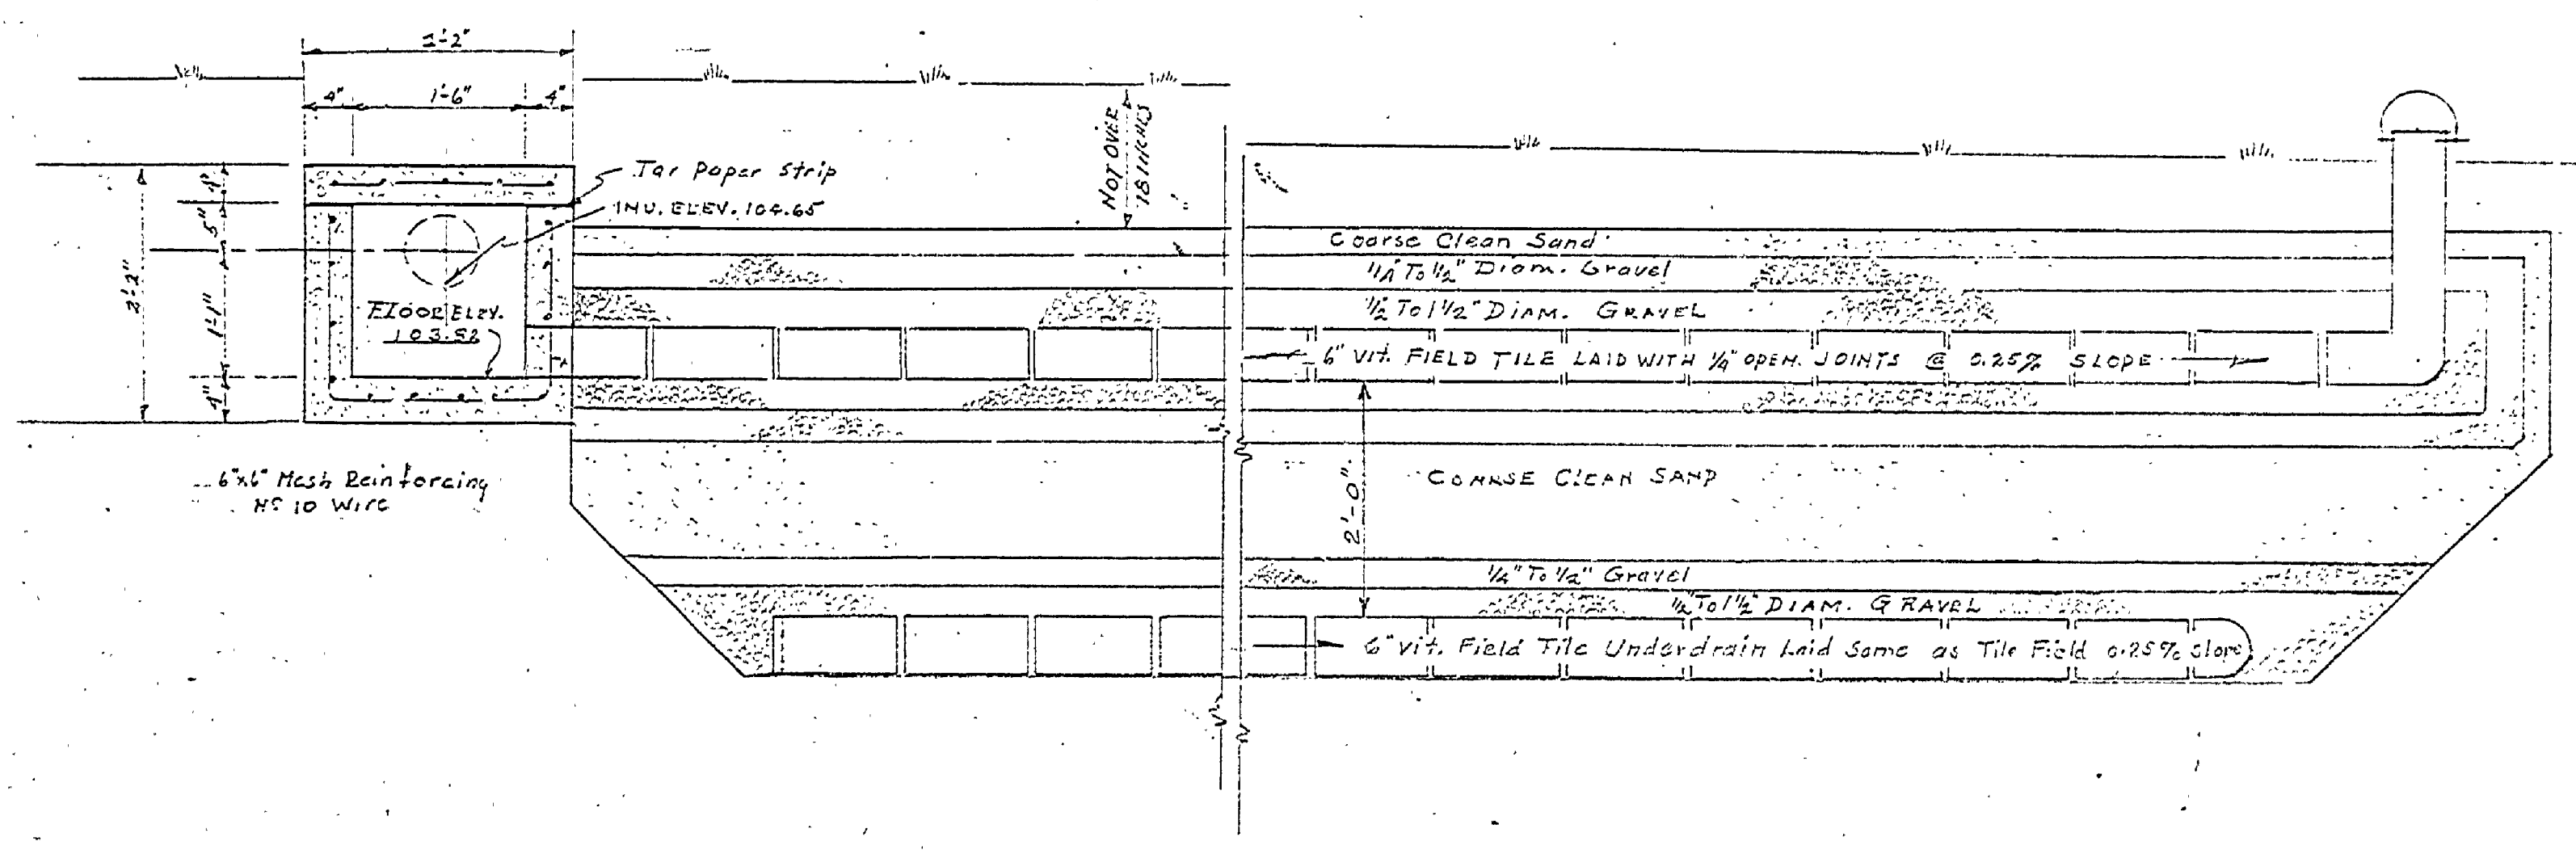


SECTION A-A
SCALE 3/4"=1'-0"

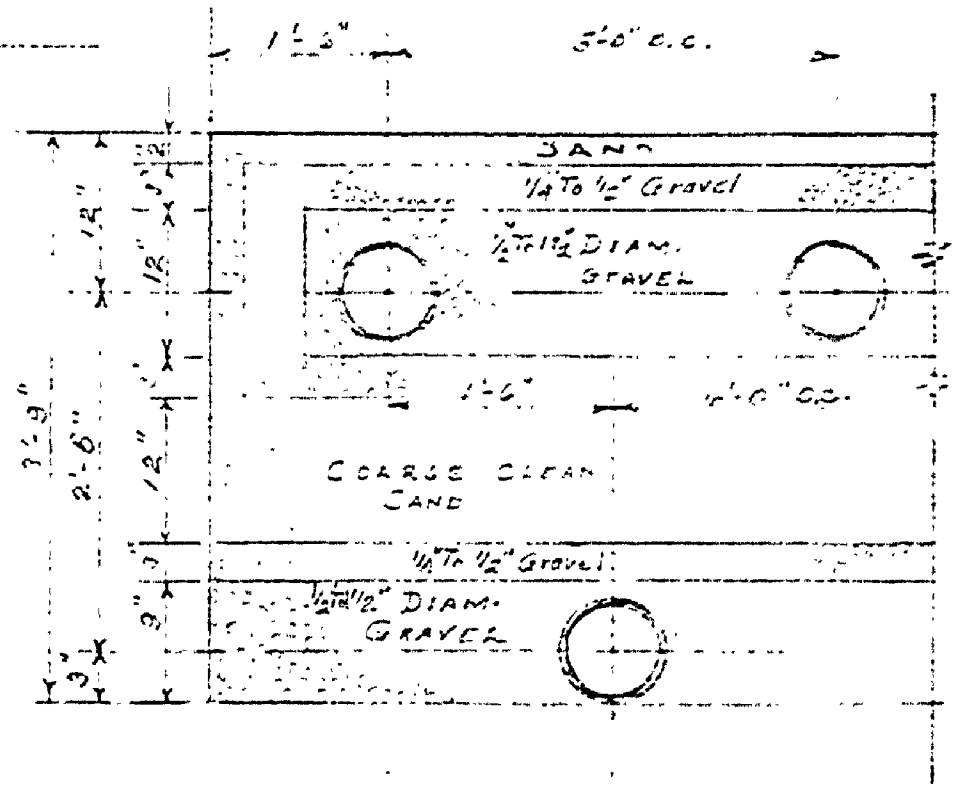

TYPICAL X-SECTION OF FIELD
SCALE 3/4"=1'-0"

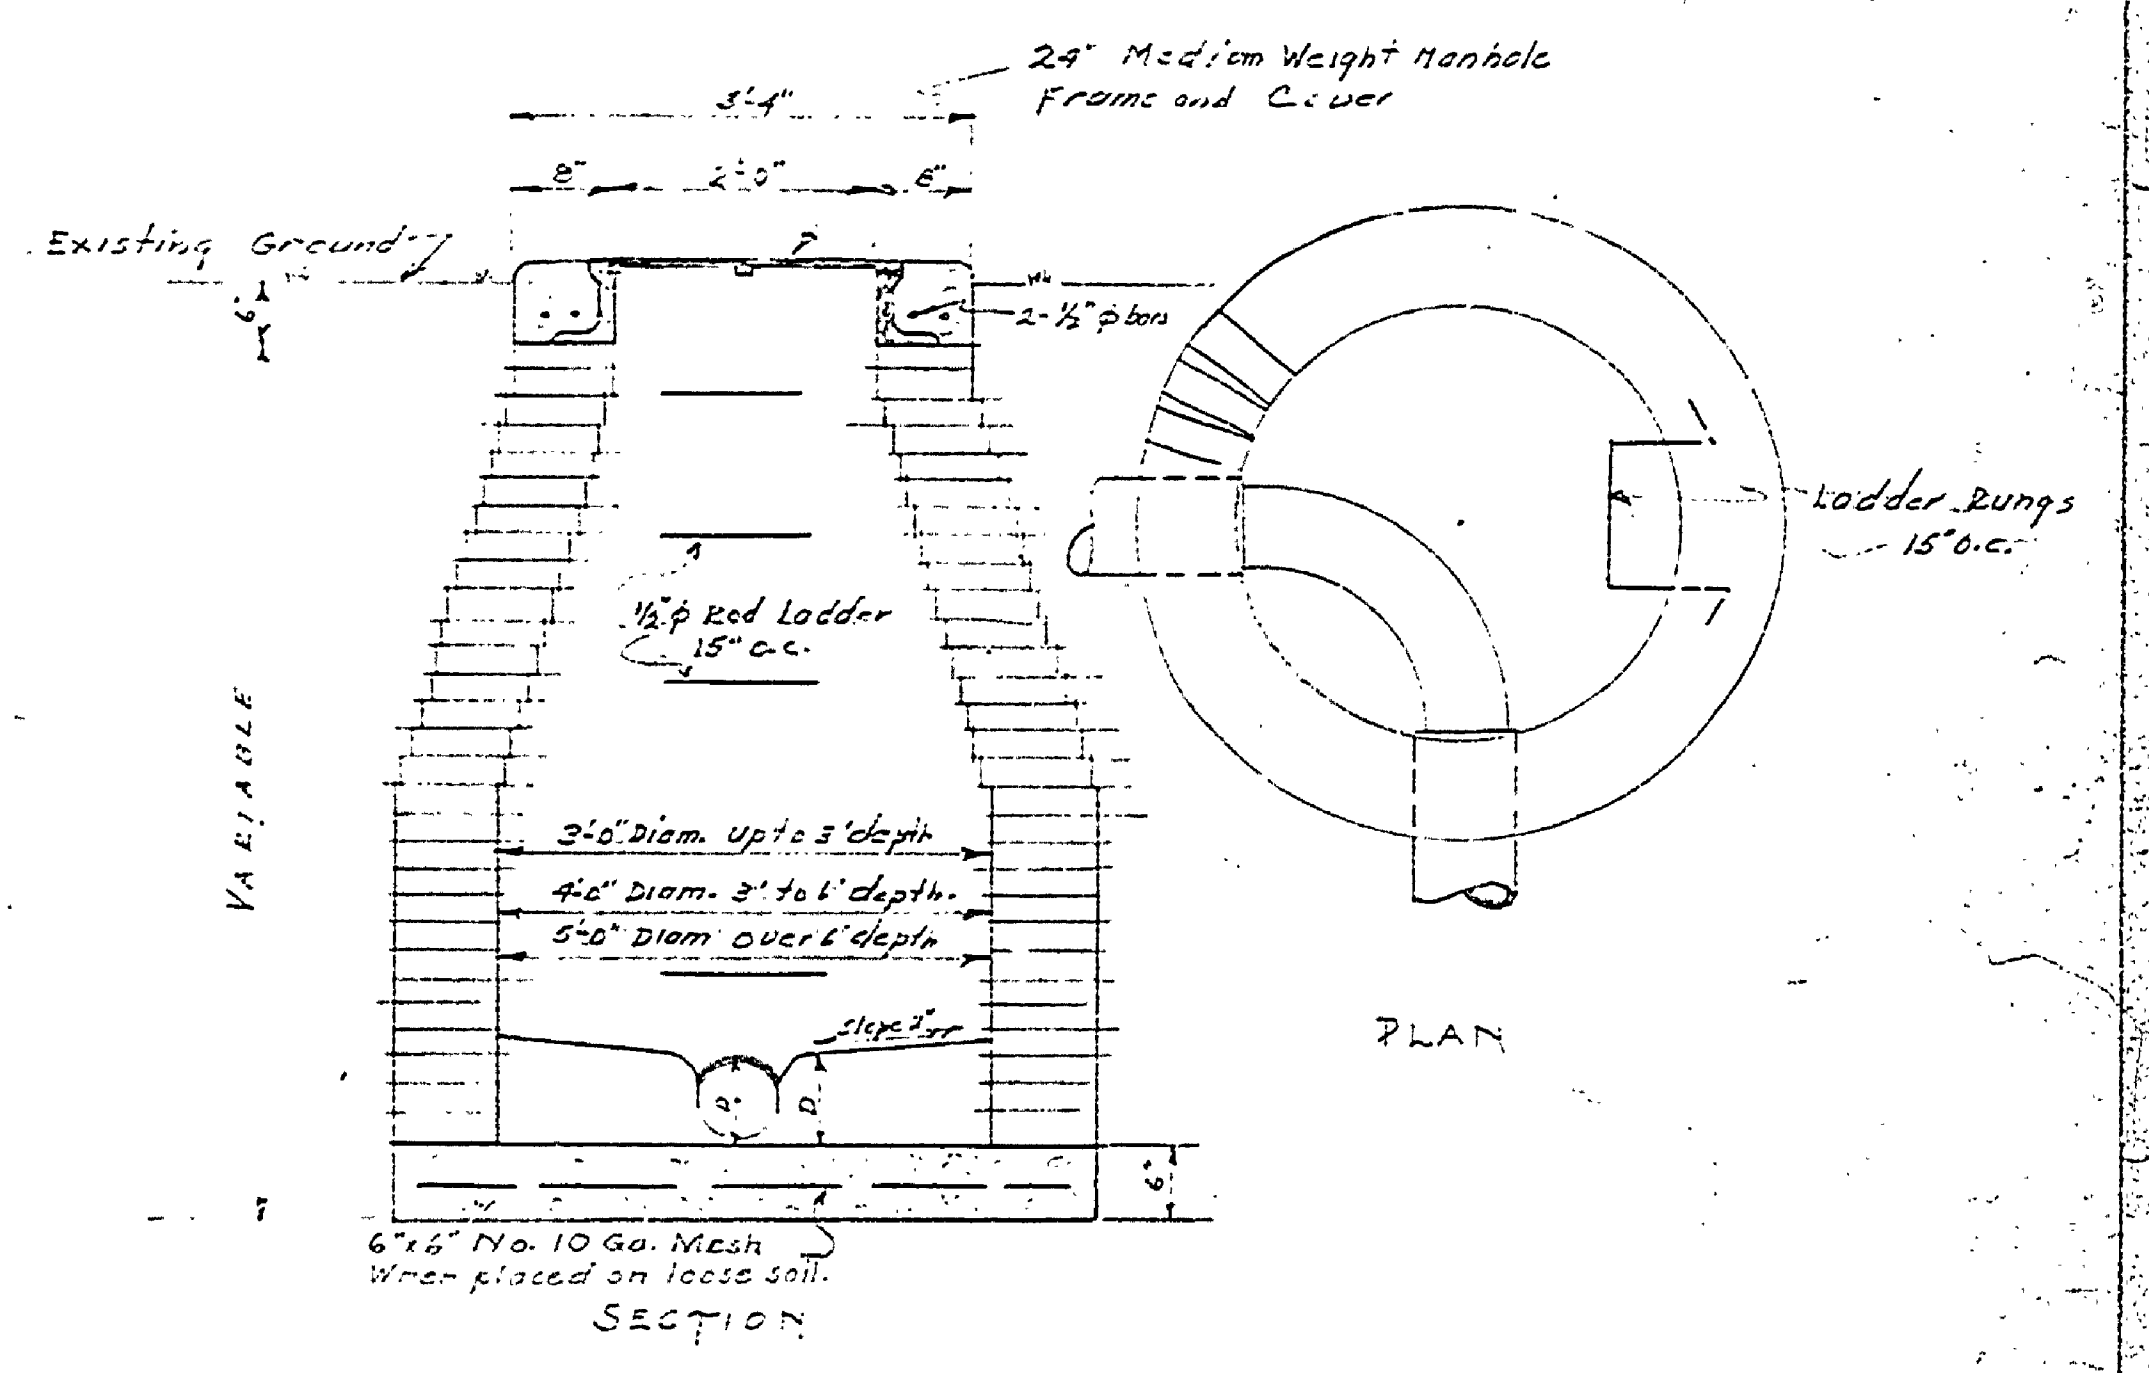

MANHOLE
SCALE 3/4"=1'-0"

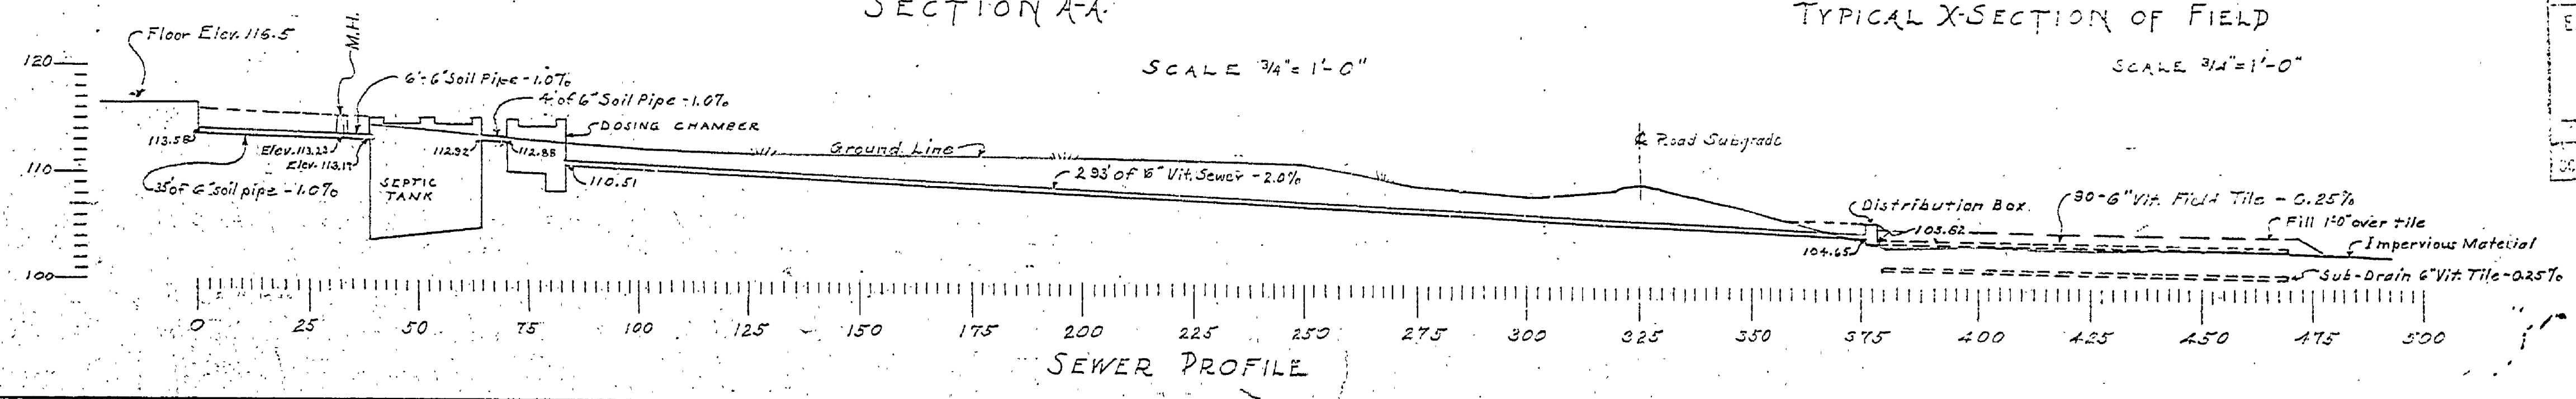

Michigan Department of Conservation
Bureau of Soil Conservation
EXAMINED AND APPROVED
OCT 12 1941
Richard M. Phillips
SUPERVISOR
CONSTRUCTION DEPT. No. 4572

MICHIGAN DEPARTMENT OF CONSERVATION
STATE PARKS DIVISION
FORT WILKINS STATE PARK
DISPOSAL SYSTEM
PICNIC AREA T.S. BLDG.
DESIGNED BY: H.C.M.E.E.J.P.
DRAWN BY: H.C.M.E.E.J.P.
CHECKED BY: *Richard M. Phillips*
PREPARED AND APPROVED BY: *Richard M. Phillips*
DATE: 7/11/41
APPROVED BY: *Richard M. Phillips*
SCALE: 1"=50'-0"
PLAN NO.: 4572
DATE: 7/11/41

E-99