


SOUTH ELEVATION

EAST ELEVATION BLDG. NO. 1

WEST ELEVATION BLDG. NO. 2


SCALE 1/2" = 1'-0"

SEE FLOOR PLANS FOR VARIATIONS

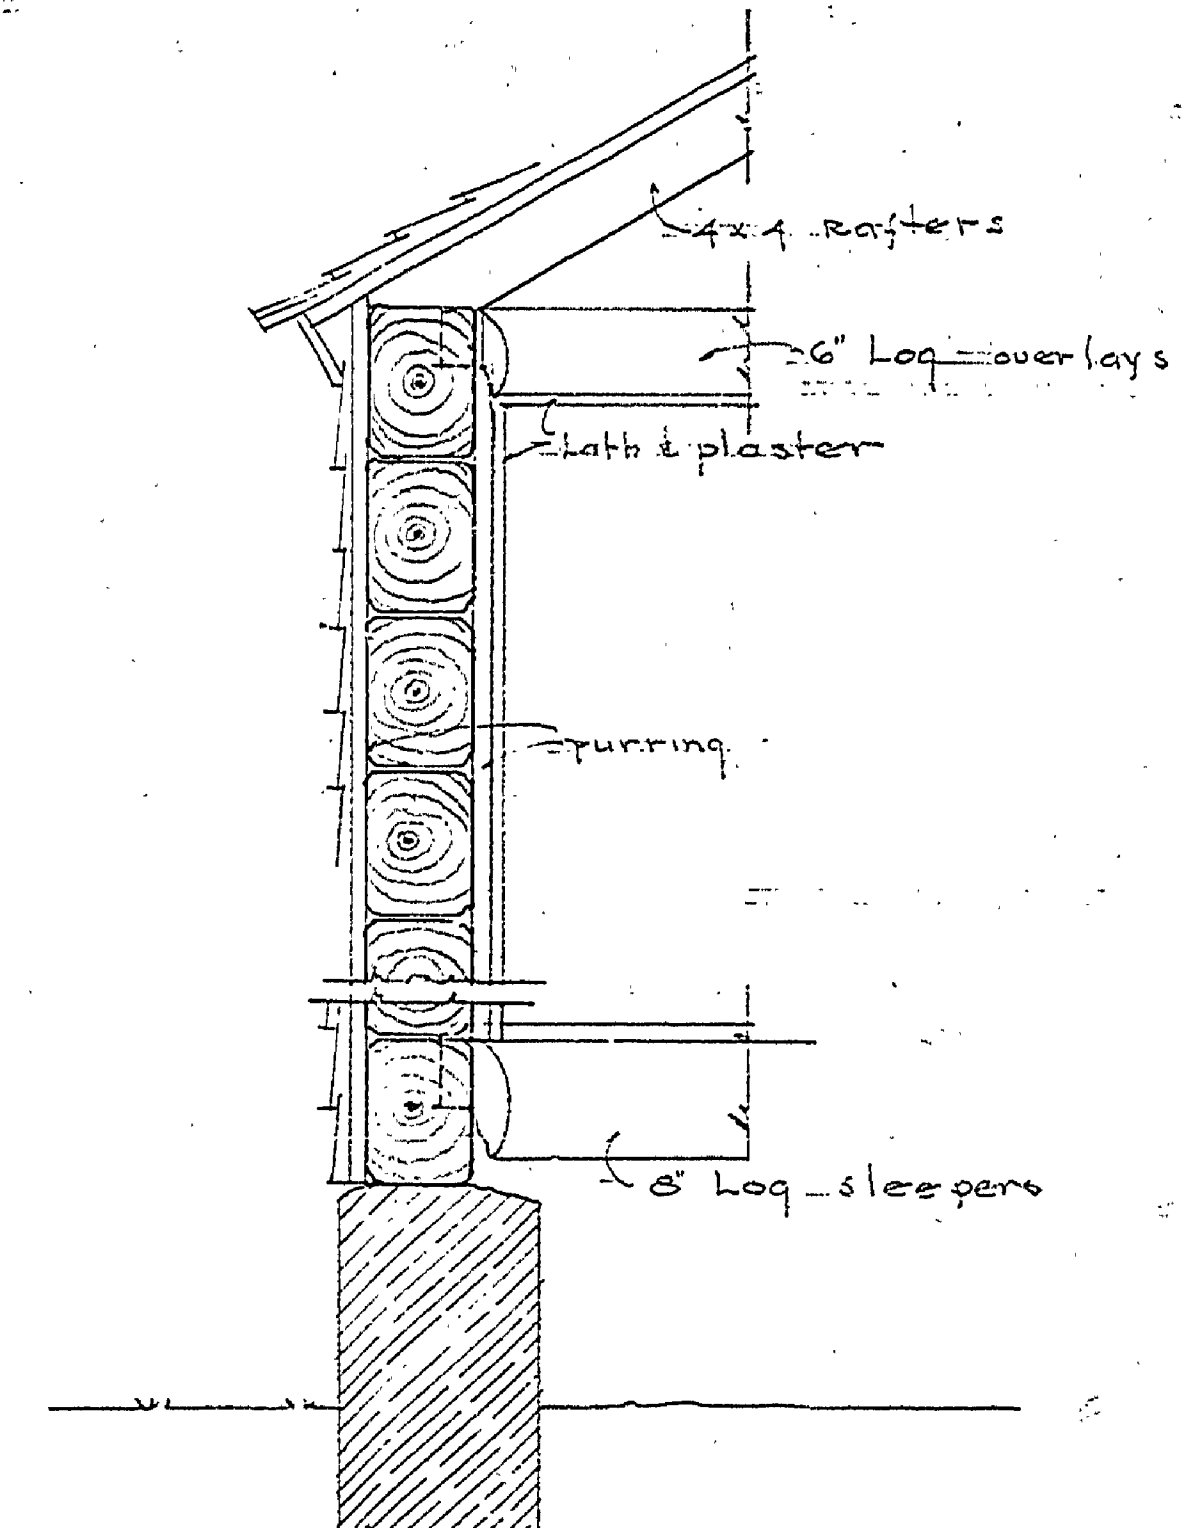


TYPICAL WALL SECTION

NOTE: See plan Bldg. No. 3 for trim & base

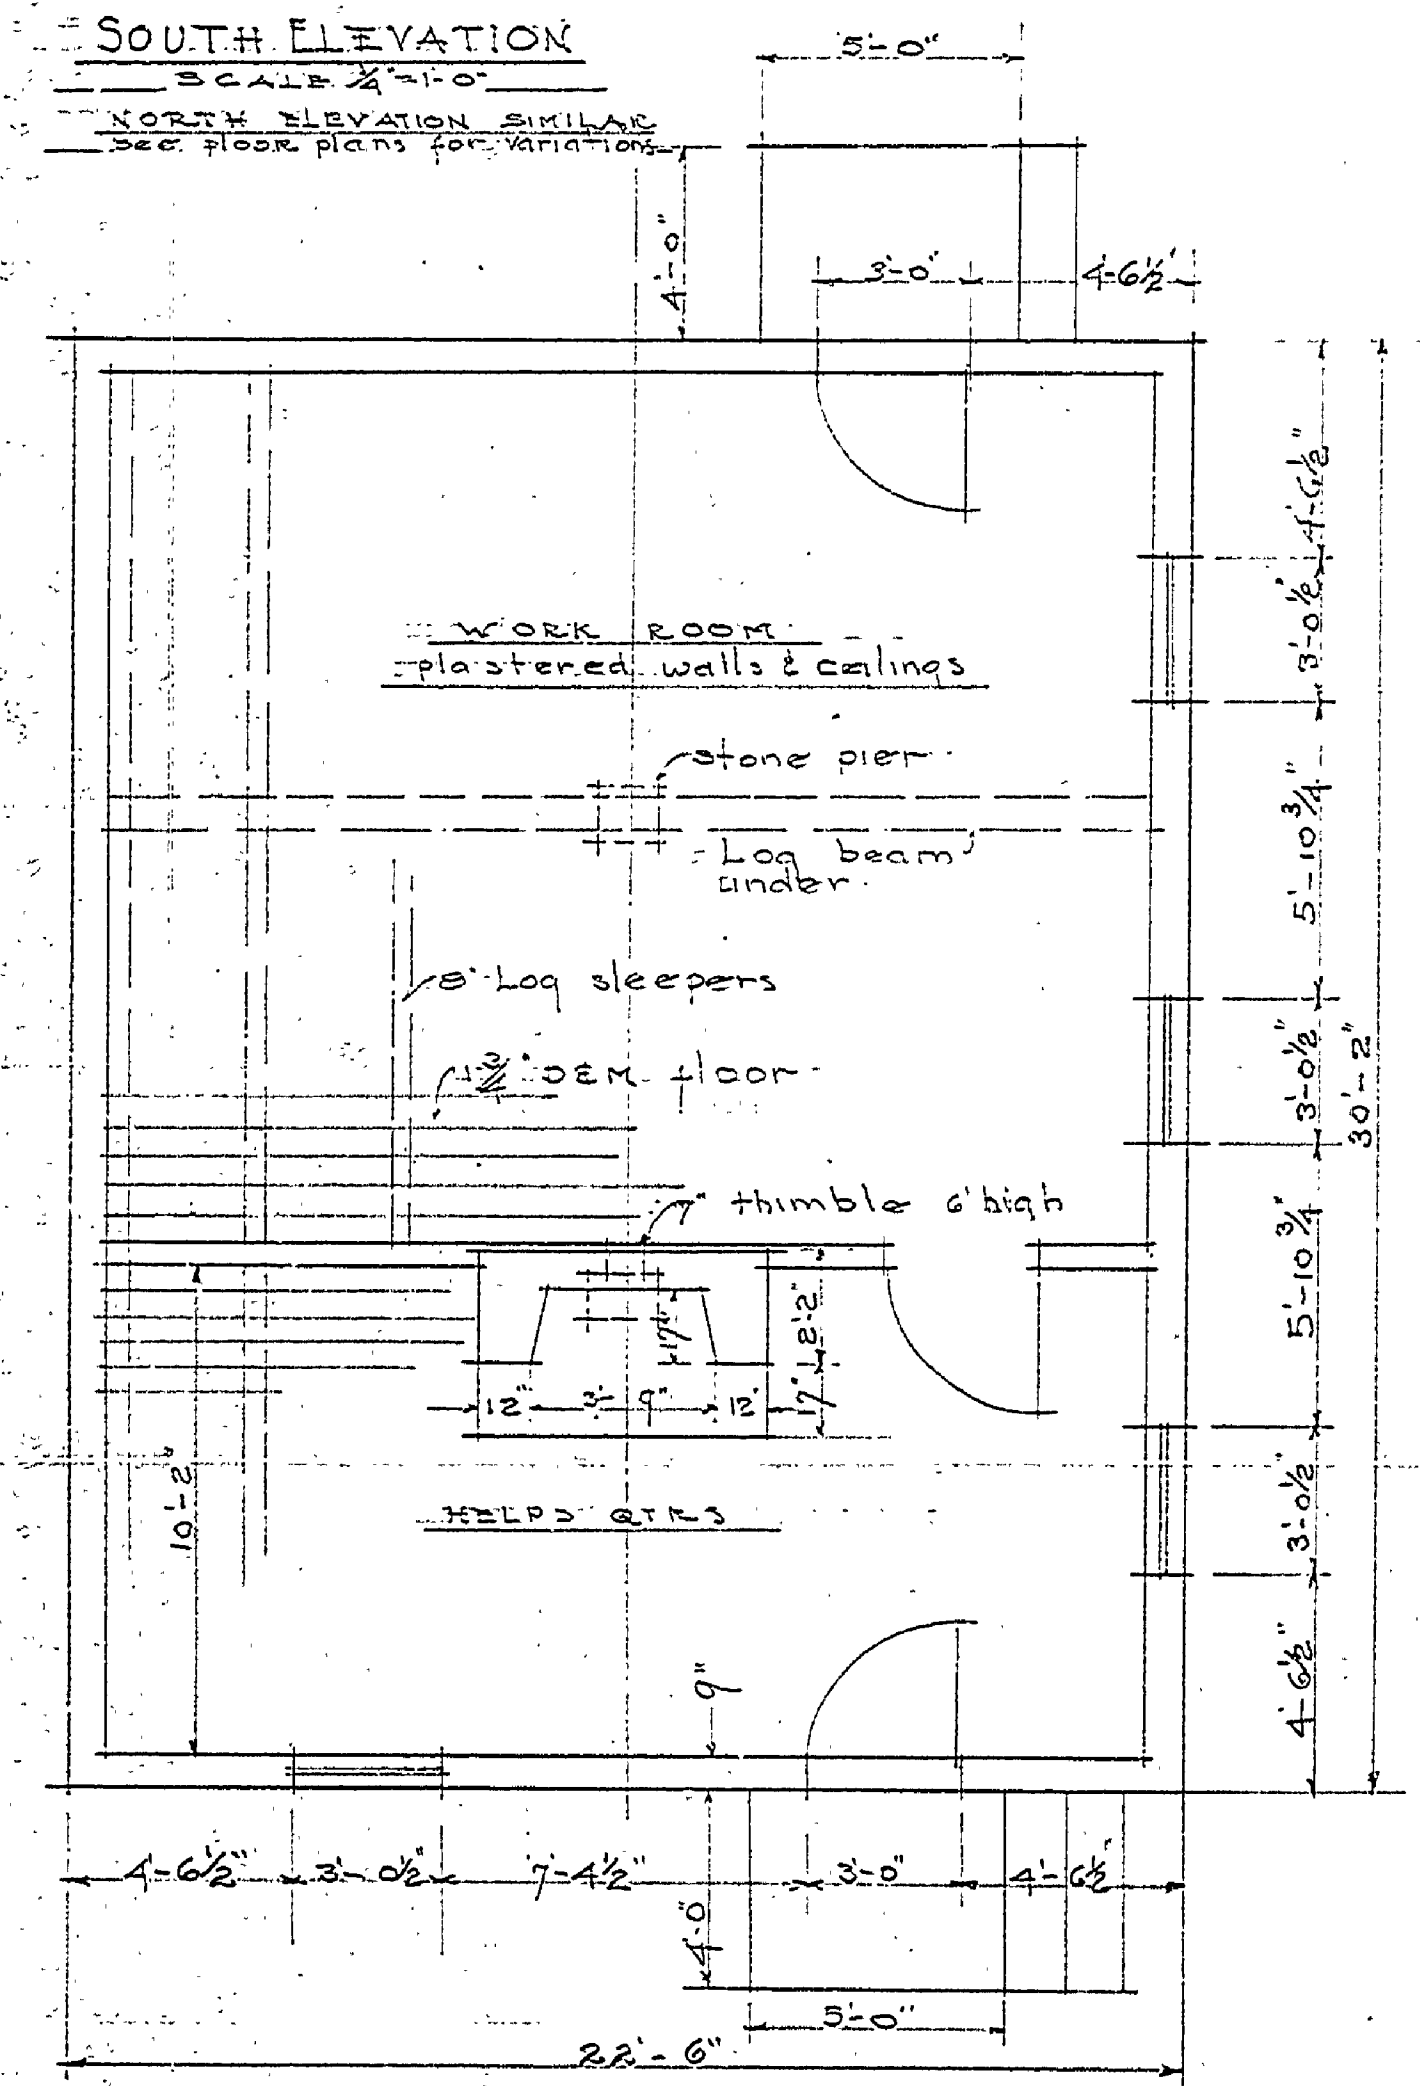

FLOOR PLAN BLDG. NO. 1

SCALE 1/2" = 1'-0"

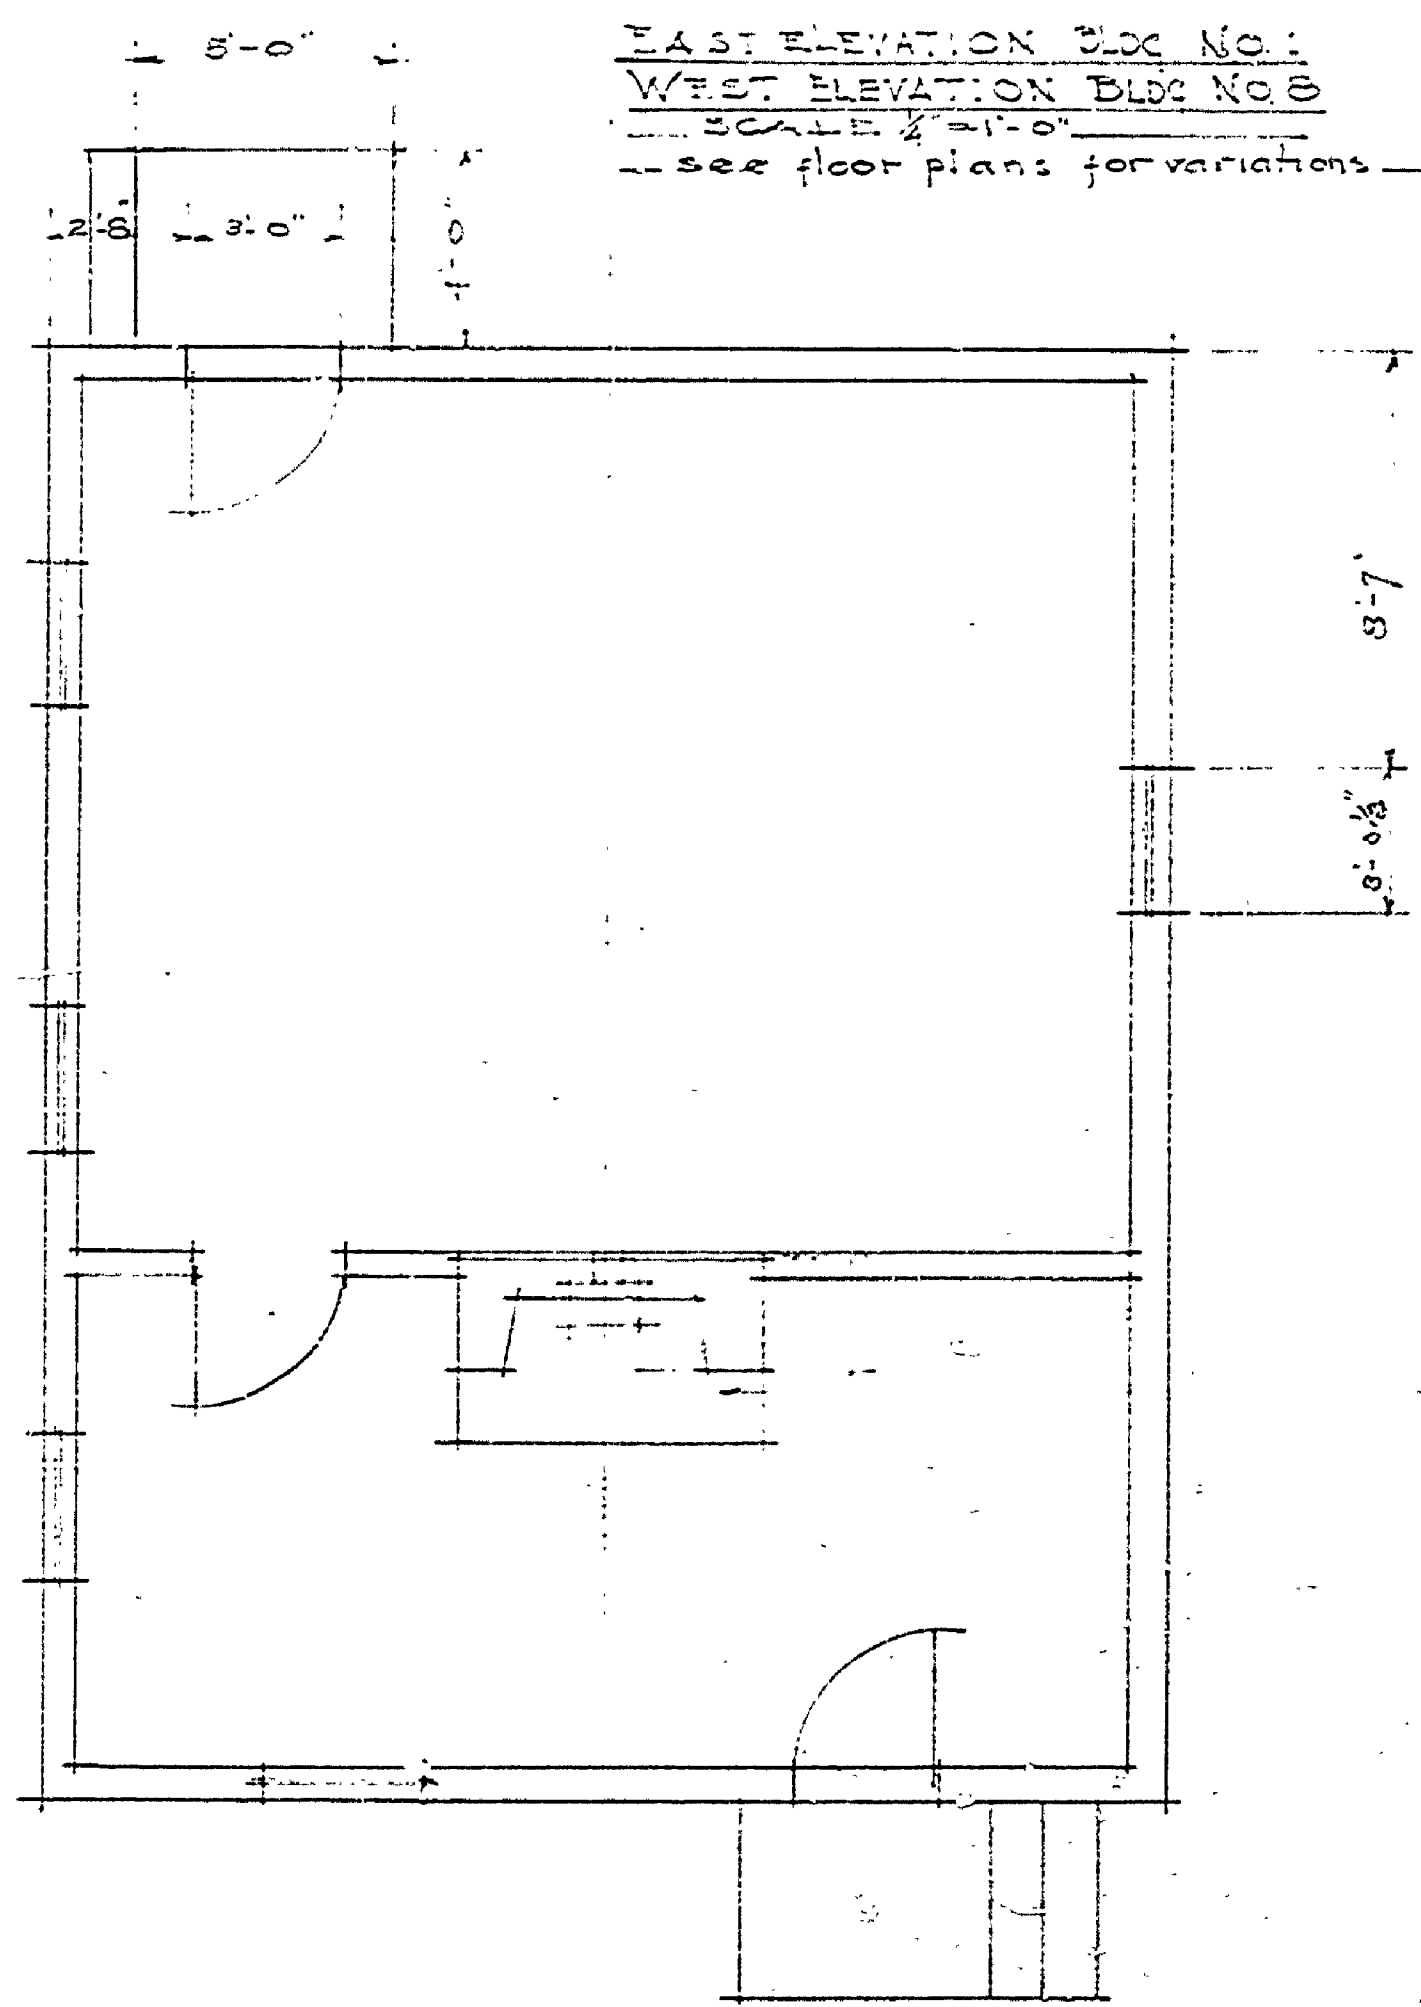

FLOOR PLAN BLDG. NO. 2

SCALE 1/2" = 1'-0"

NOTE: DIMENSIONS SHOWING VARIATIONS ONLY

NOTE: DETAILS OF FIREPLACE
BLDG. PLAN No. 3

FORT ORDERLY BIDS. (2)

INSURANCE No. 11,878

A-108 - a

PLAN OF BLDG. NO. 1 and 2			
MICHIGAN DEPARTMENT OF CONSERVATION			
PARKS DIVISION			
DRAWN BY S.P.H.	MEASURED DRAWINGS KITCHEN & MESS ROOM	DATE 3/25/42	SCALE AS SHOWN
TRACED BY C.P.T.			
APPROVED BY			
APPROVED BY			