



EAST ELEVATION
SCALE 1/4" = 1'-0"

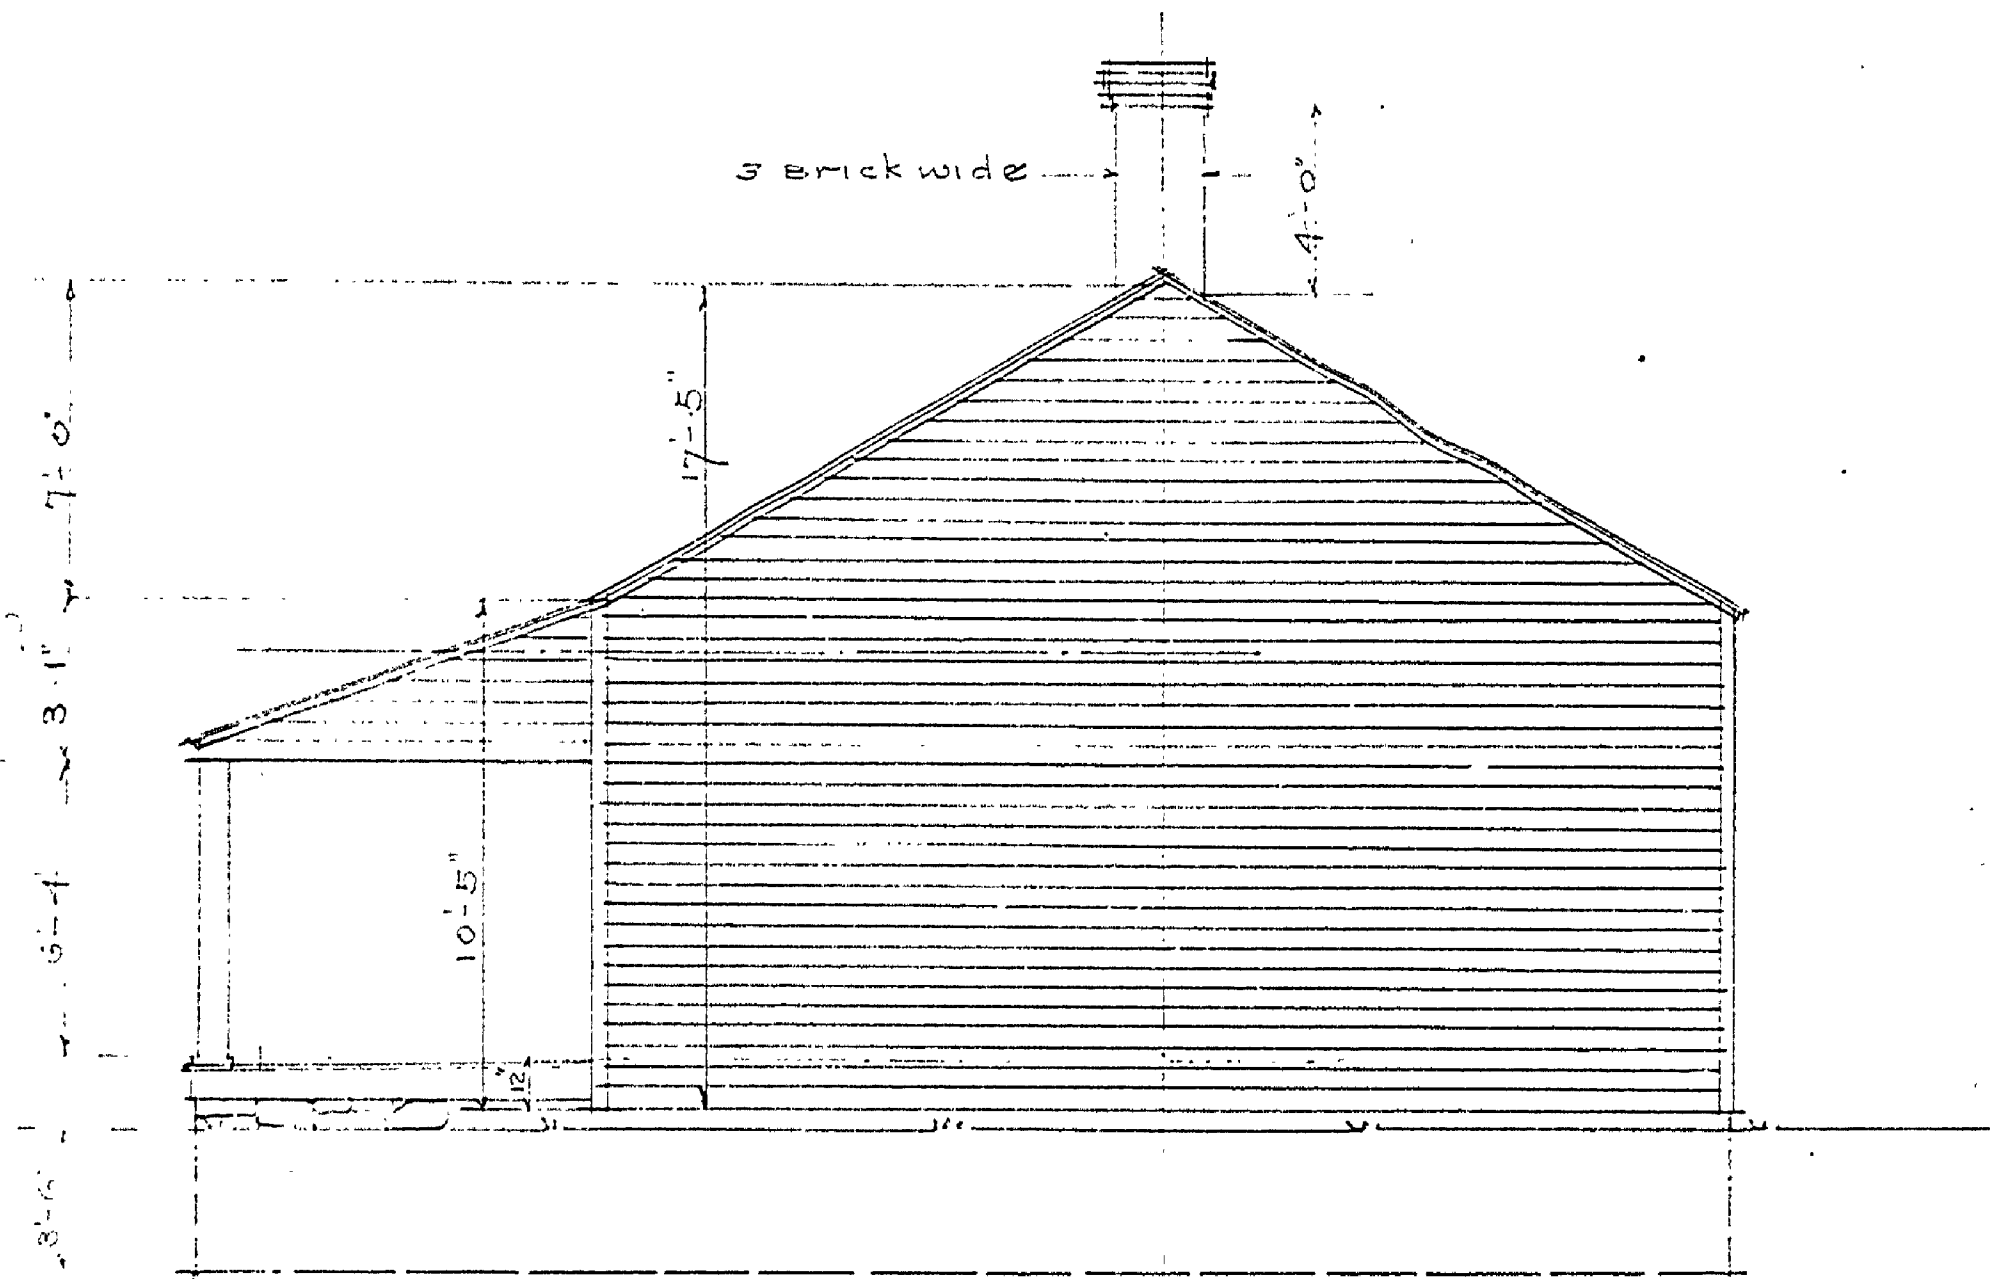

NORTH ELEVATION
SCALE 1/4" = 1'-0"
OPPOSITE ELEVATION SIMILAR

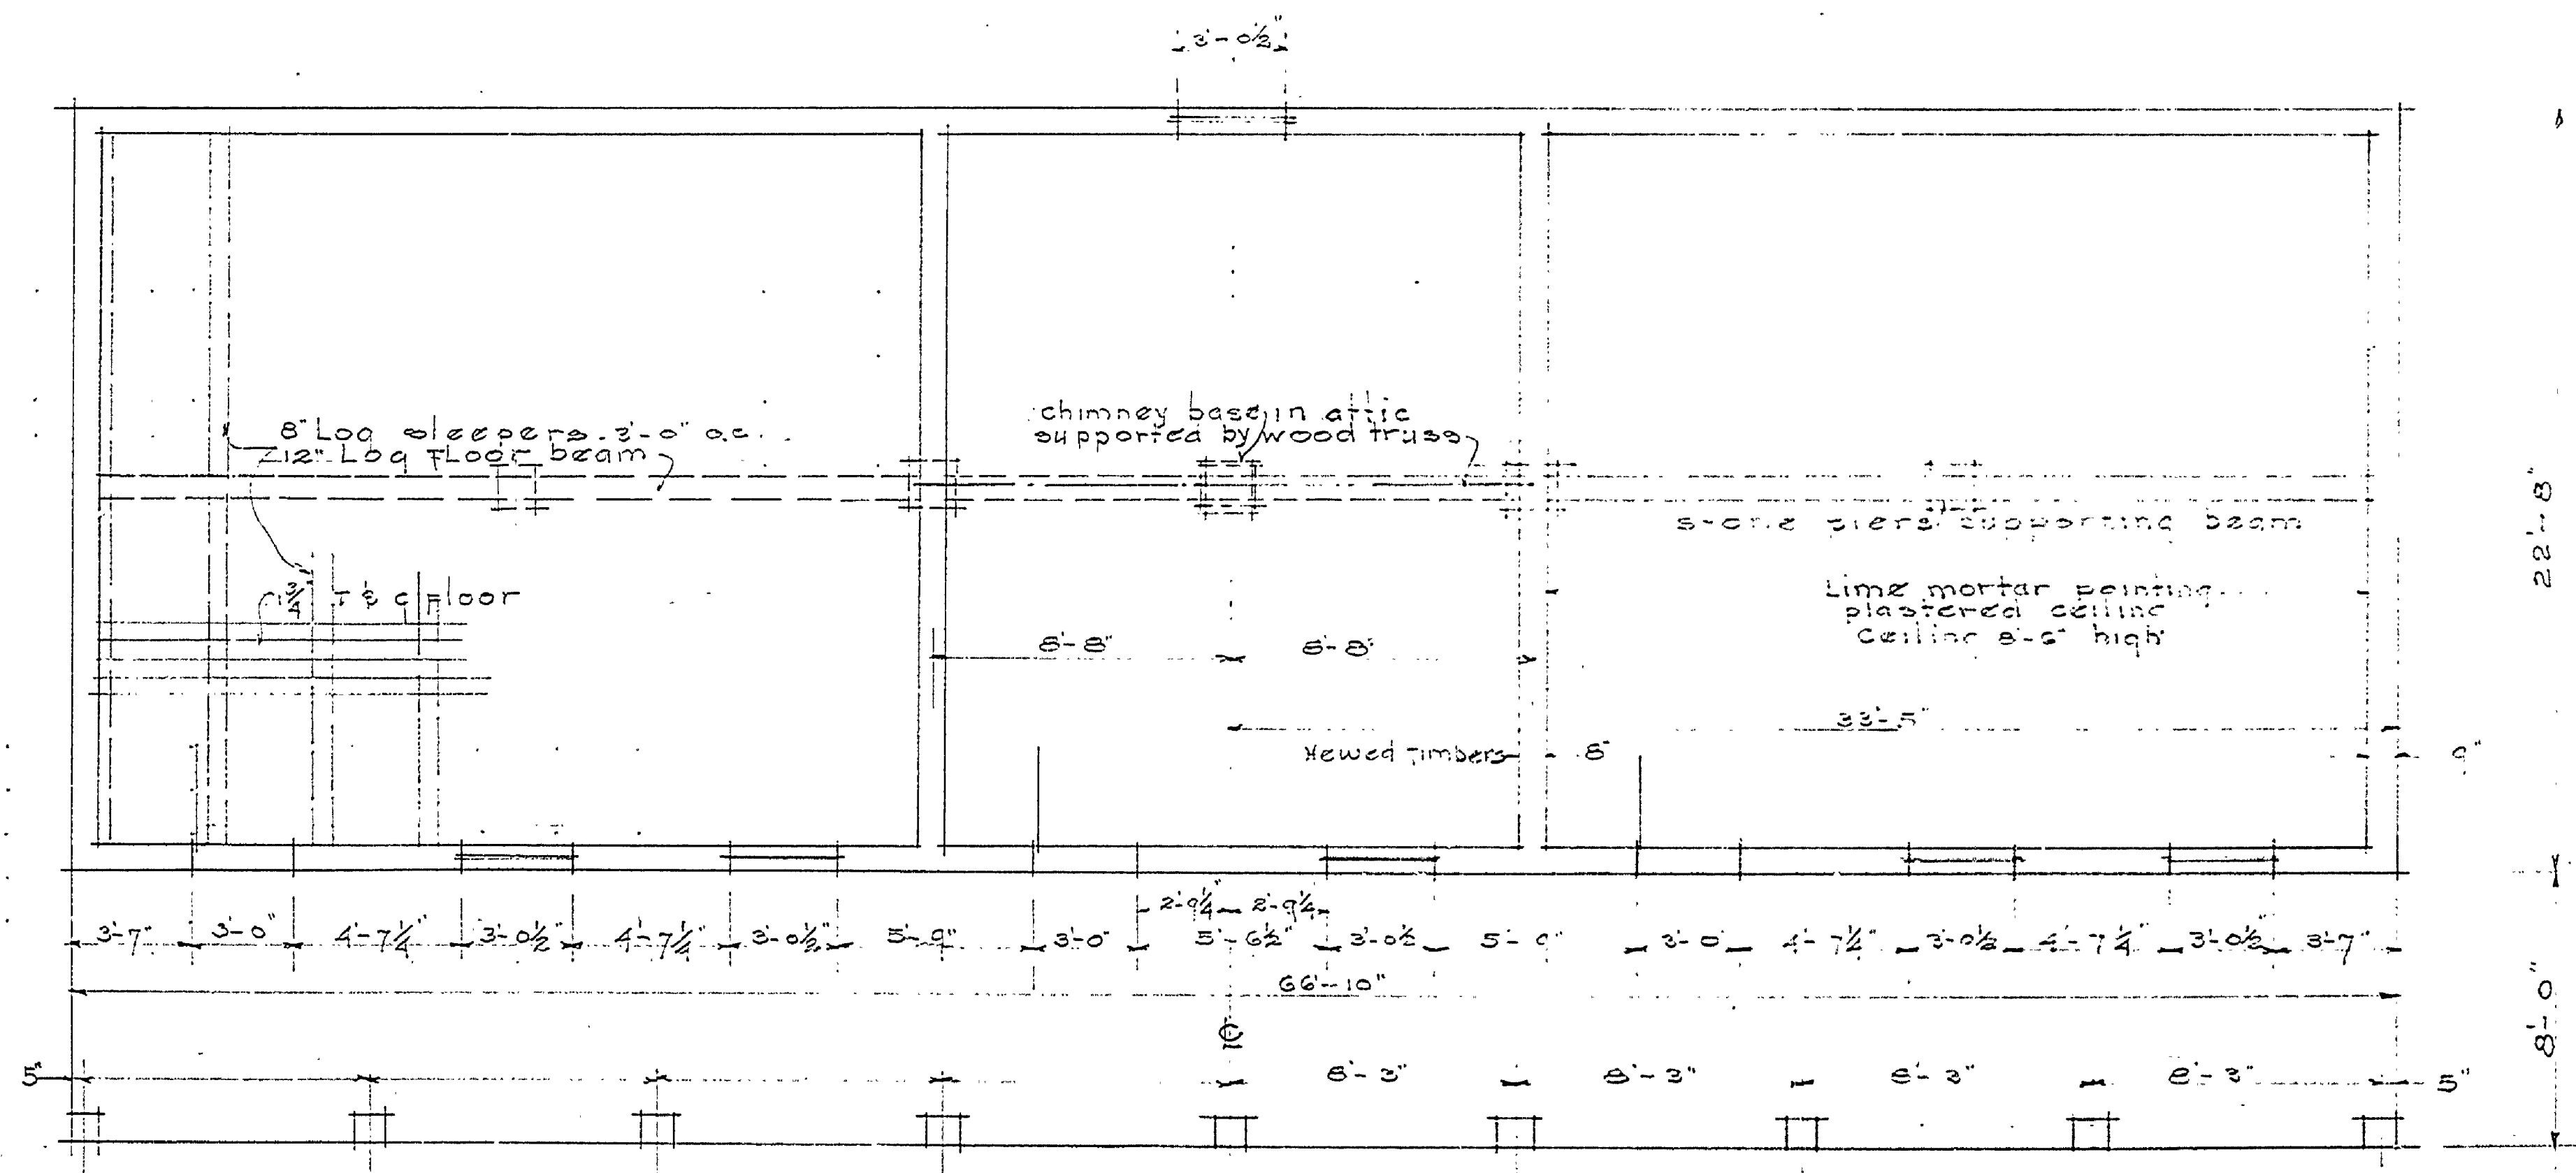

FLOOR PLAN
SCALE 1/4" = 1'-0"

NOTE: Building No 7 to be the same as this plan, except to omit the interior division walls. Building No 7 was used for a mess hall.
EAST ELEVATION on side No 7 would be WEST ELEVATION.

PLAN OF Bldg's No 2 & 7

MICHIGAN DEPARTMENT OF CONSERVATION PARKS DIVISION	
FORT WILKINS MEASURED DRAWINGS COMPANY QUARTERS	PLANS BOOKS SCALE AS SHOWN DATE 4/7/42
DRAWN BY E.F.H.	DATE
APPROVED BY	DATE

INSURANCE No's 12 & 17

A-108 - c